


WALL PANEL - N1

SCALE: 1/6" = 1'-0"

SDR, RI, RB & 5200

(1/4" THK WALL)

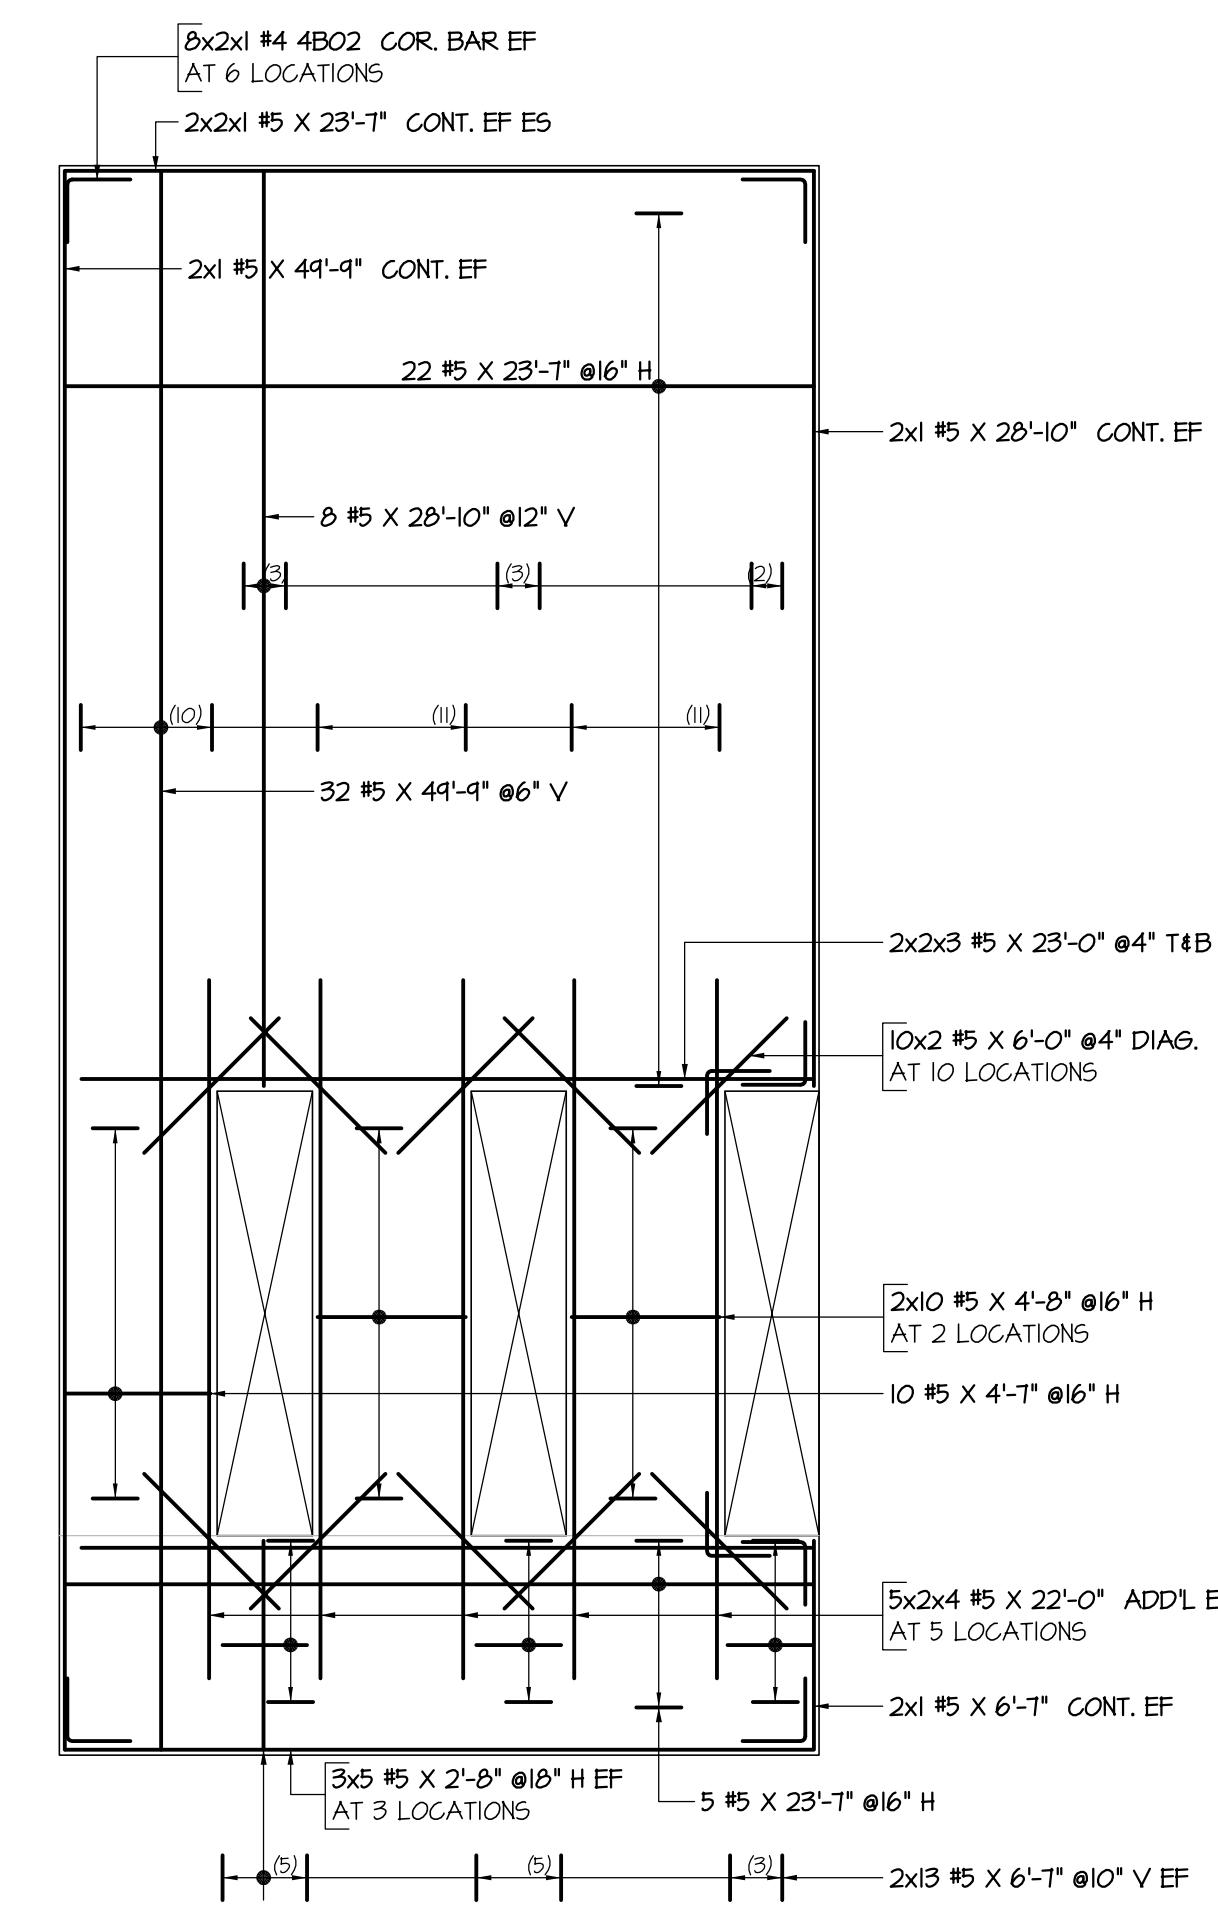


WALL PANEL - N2

SCALE: 1/6" = 1'-0"

SDR, RI, RB & 5200

(1/4" THK WALL)

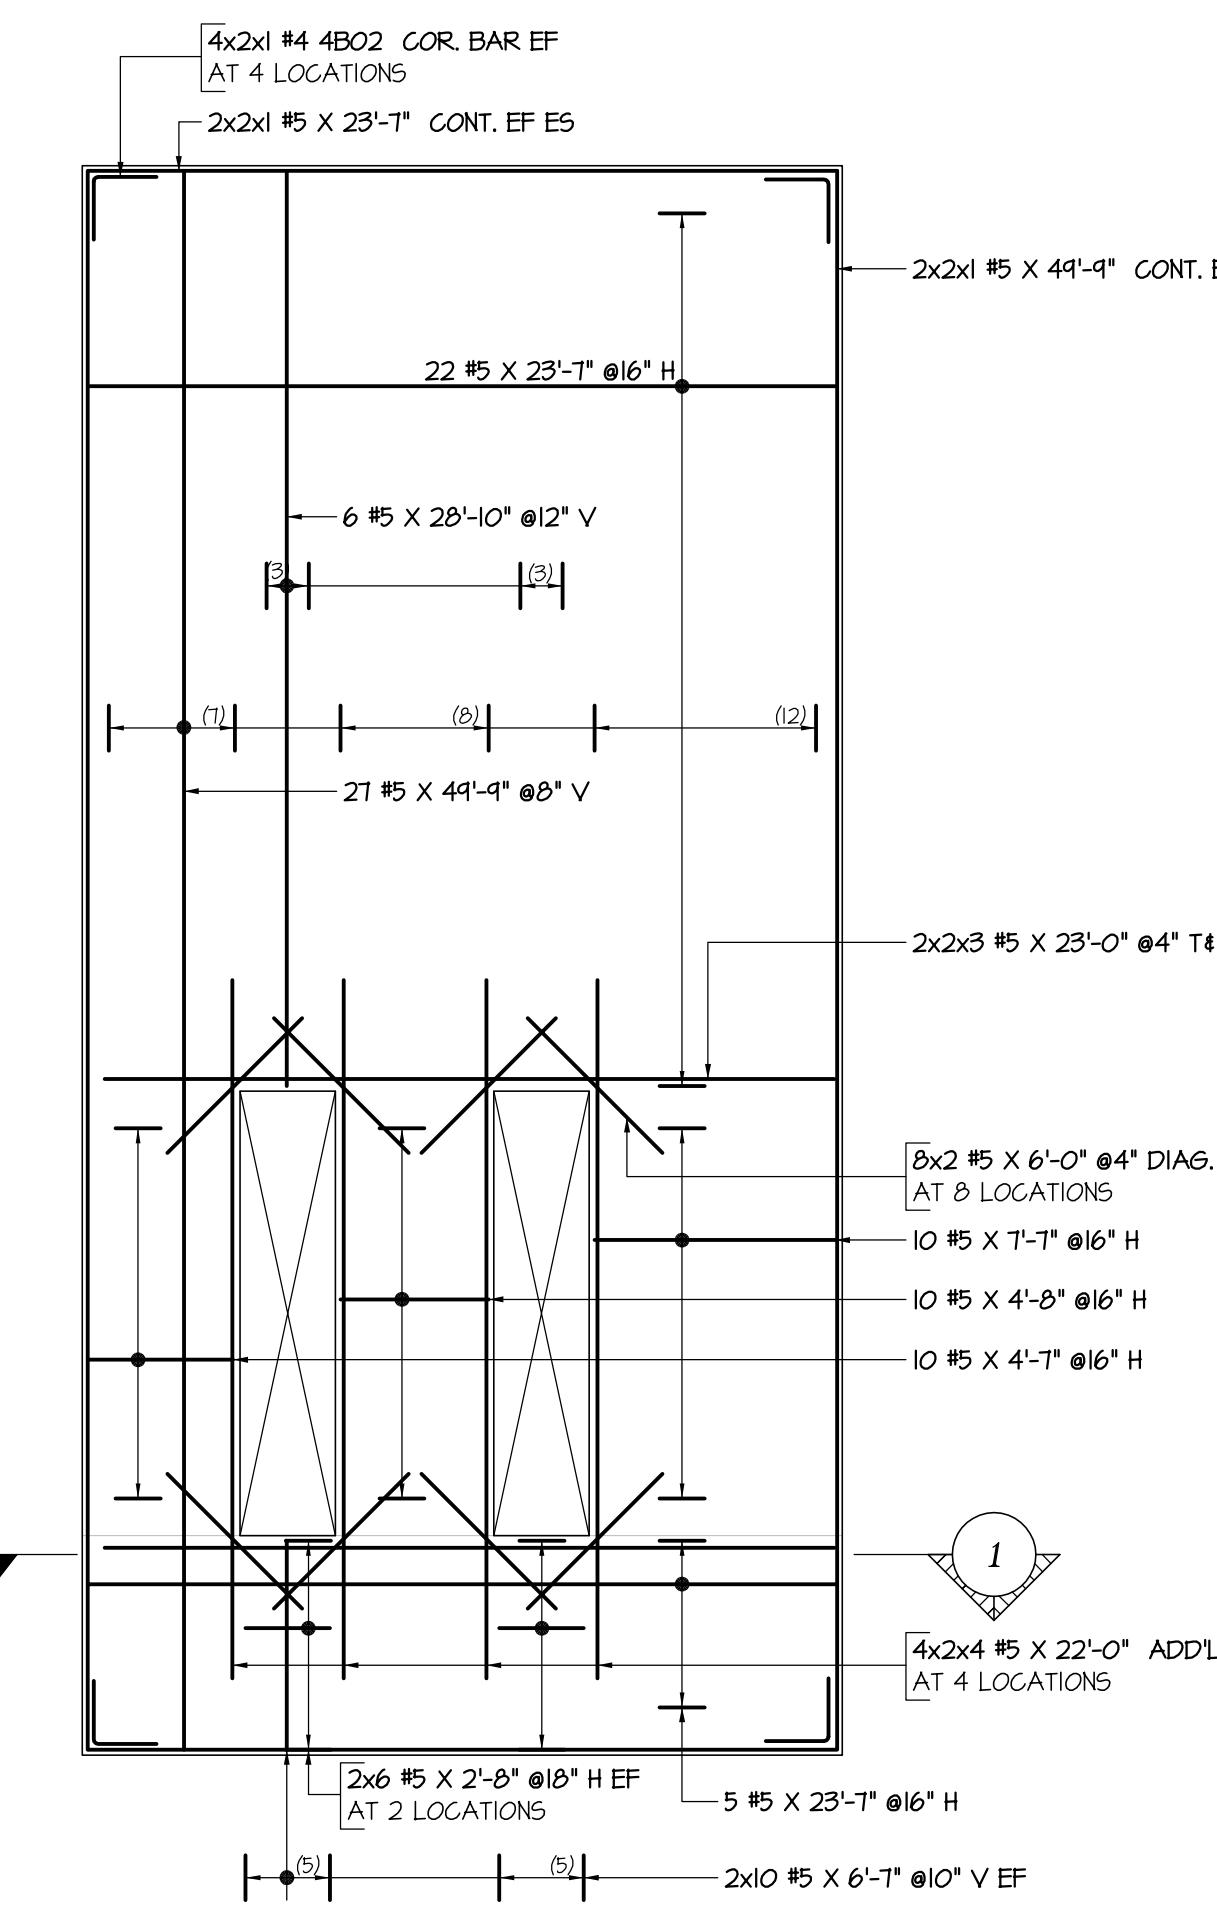


WALL PANEL - N3

SCALE: 1/6" = 1'-0"

SDR, RI, RB & 5200

(1/4" THK WALL)

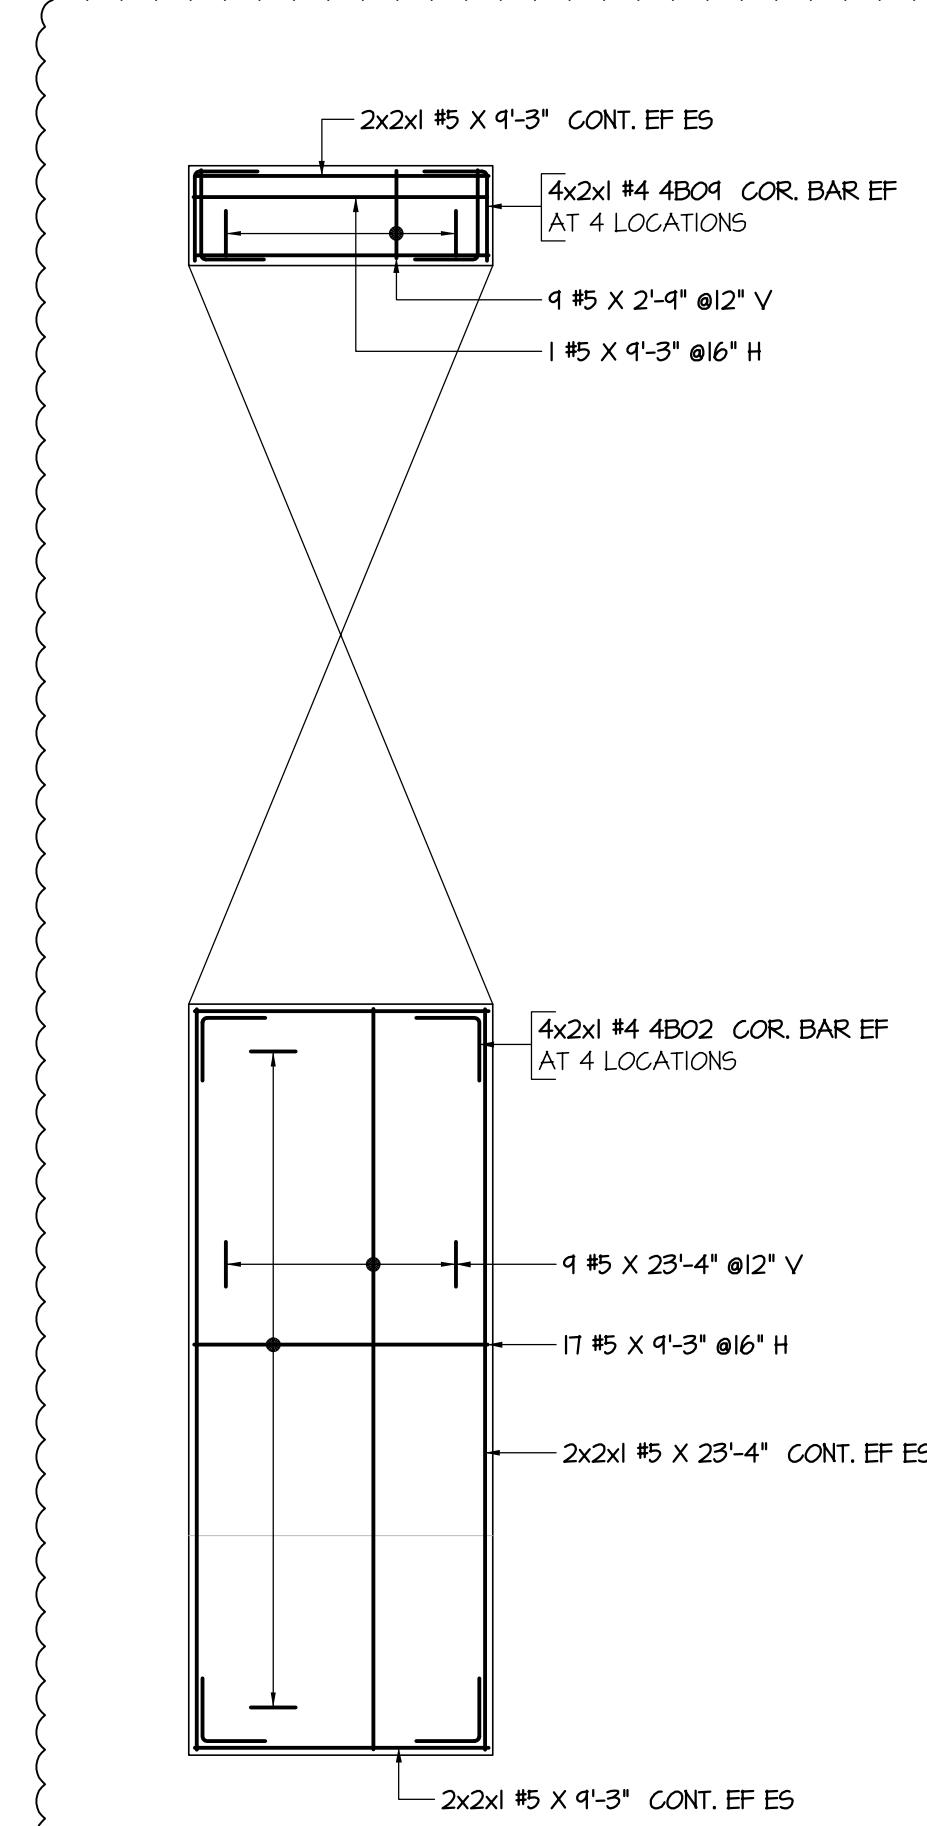


WALL PANEL - N4 & 4A

SCALE: 1/6" = 1'-0"

SDR, RI, RB & 5200

(1/4" THK WALL)

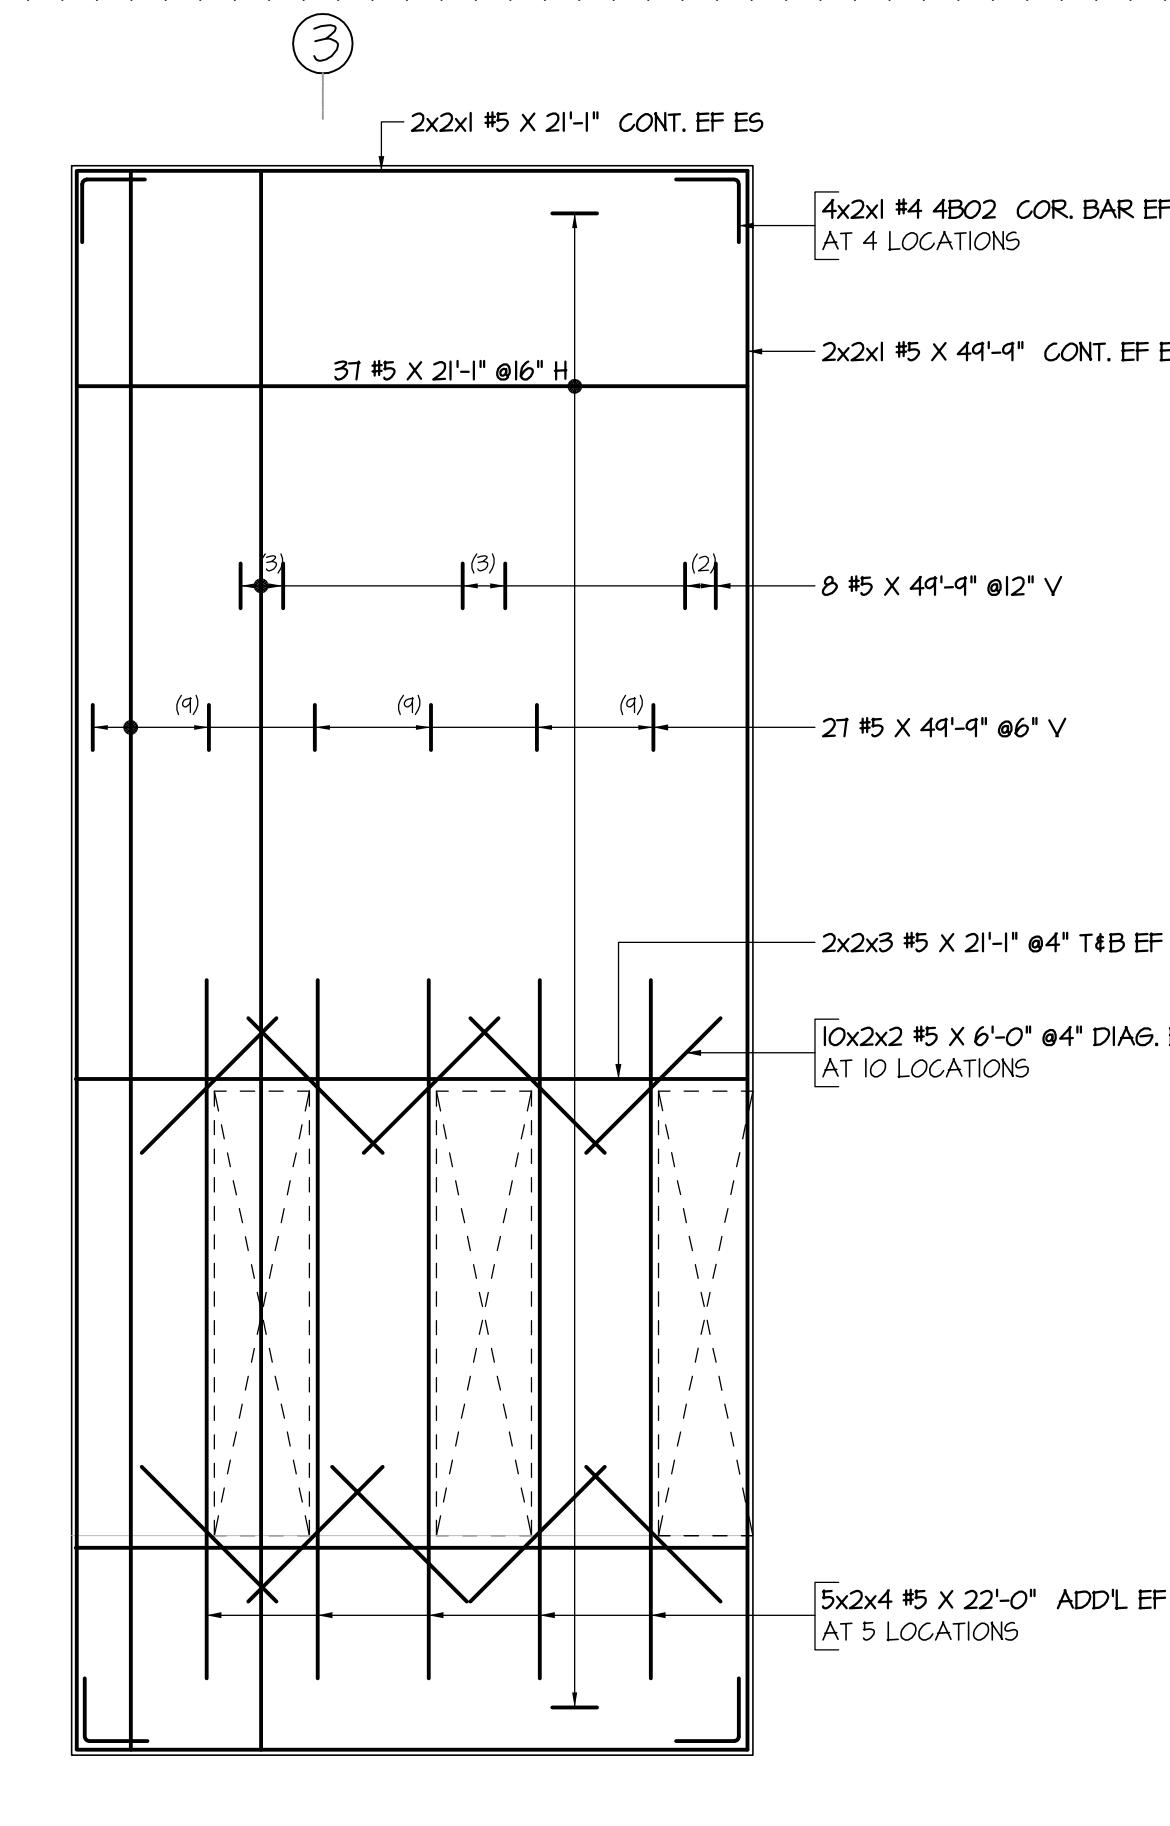


WALL PANEL - N5

SCALE: 1/6" = 1'-0"

SDR, RI, RB & 5200

(1/4" THK WALL)

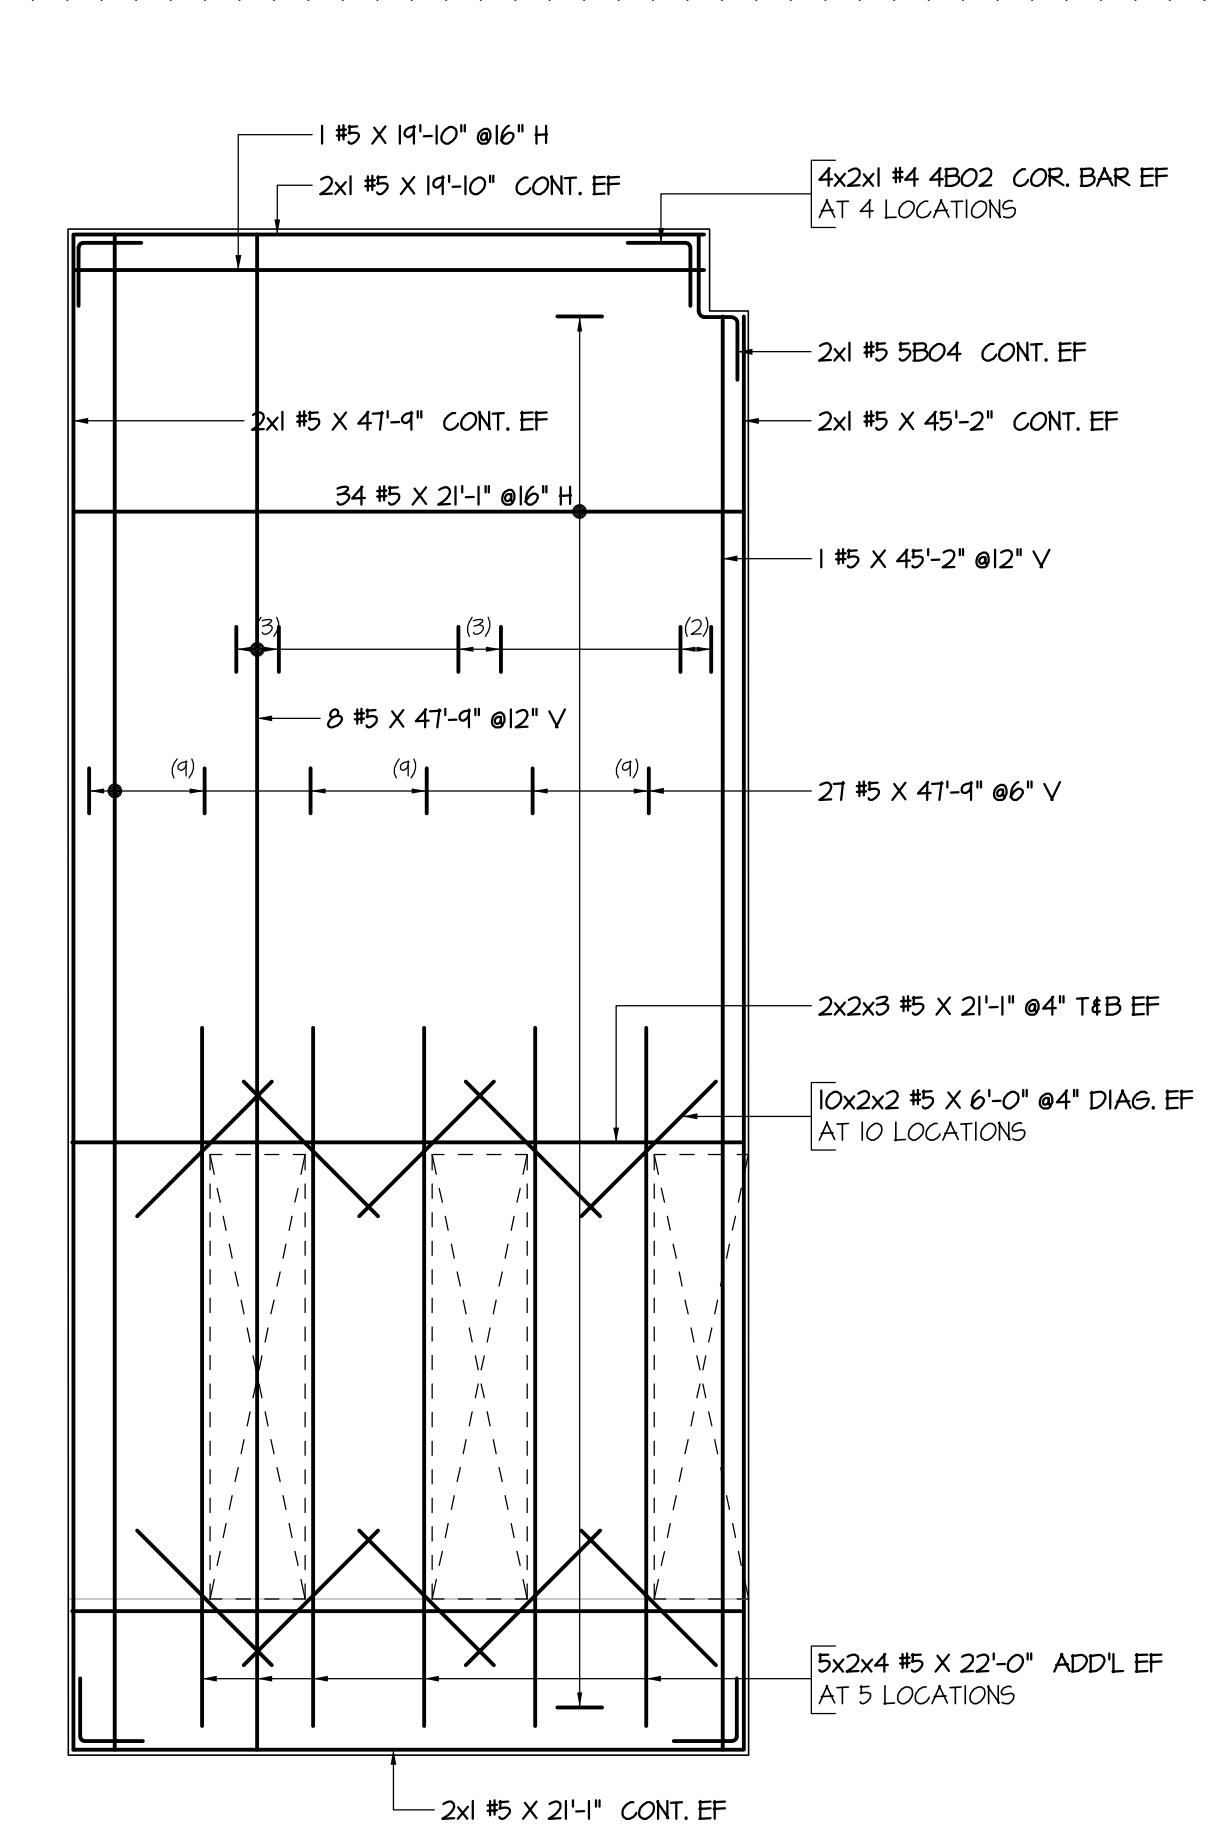


WALL PANEL - N6

SCALE: 1/6" = 1'-0"

SDR, RI, RB & 5200

(1/4" THK WALL)

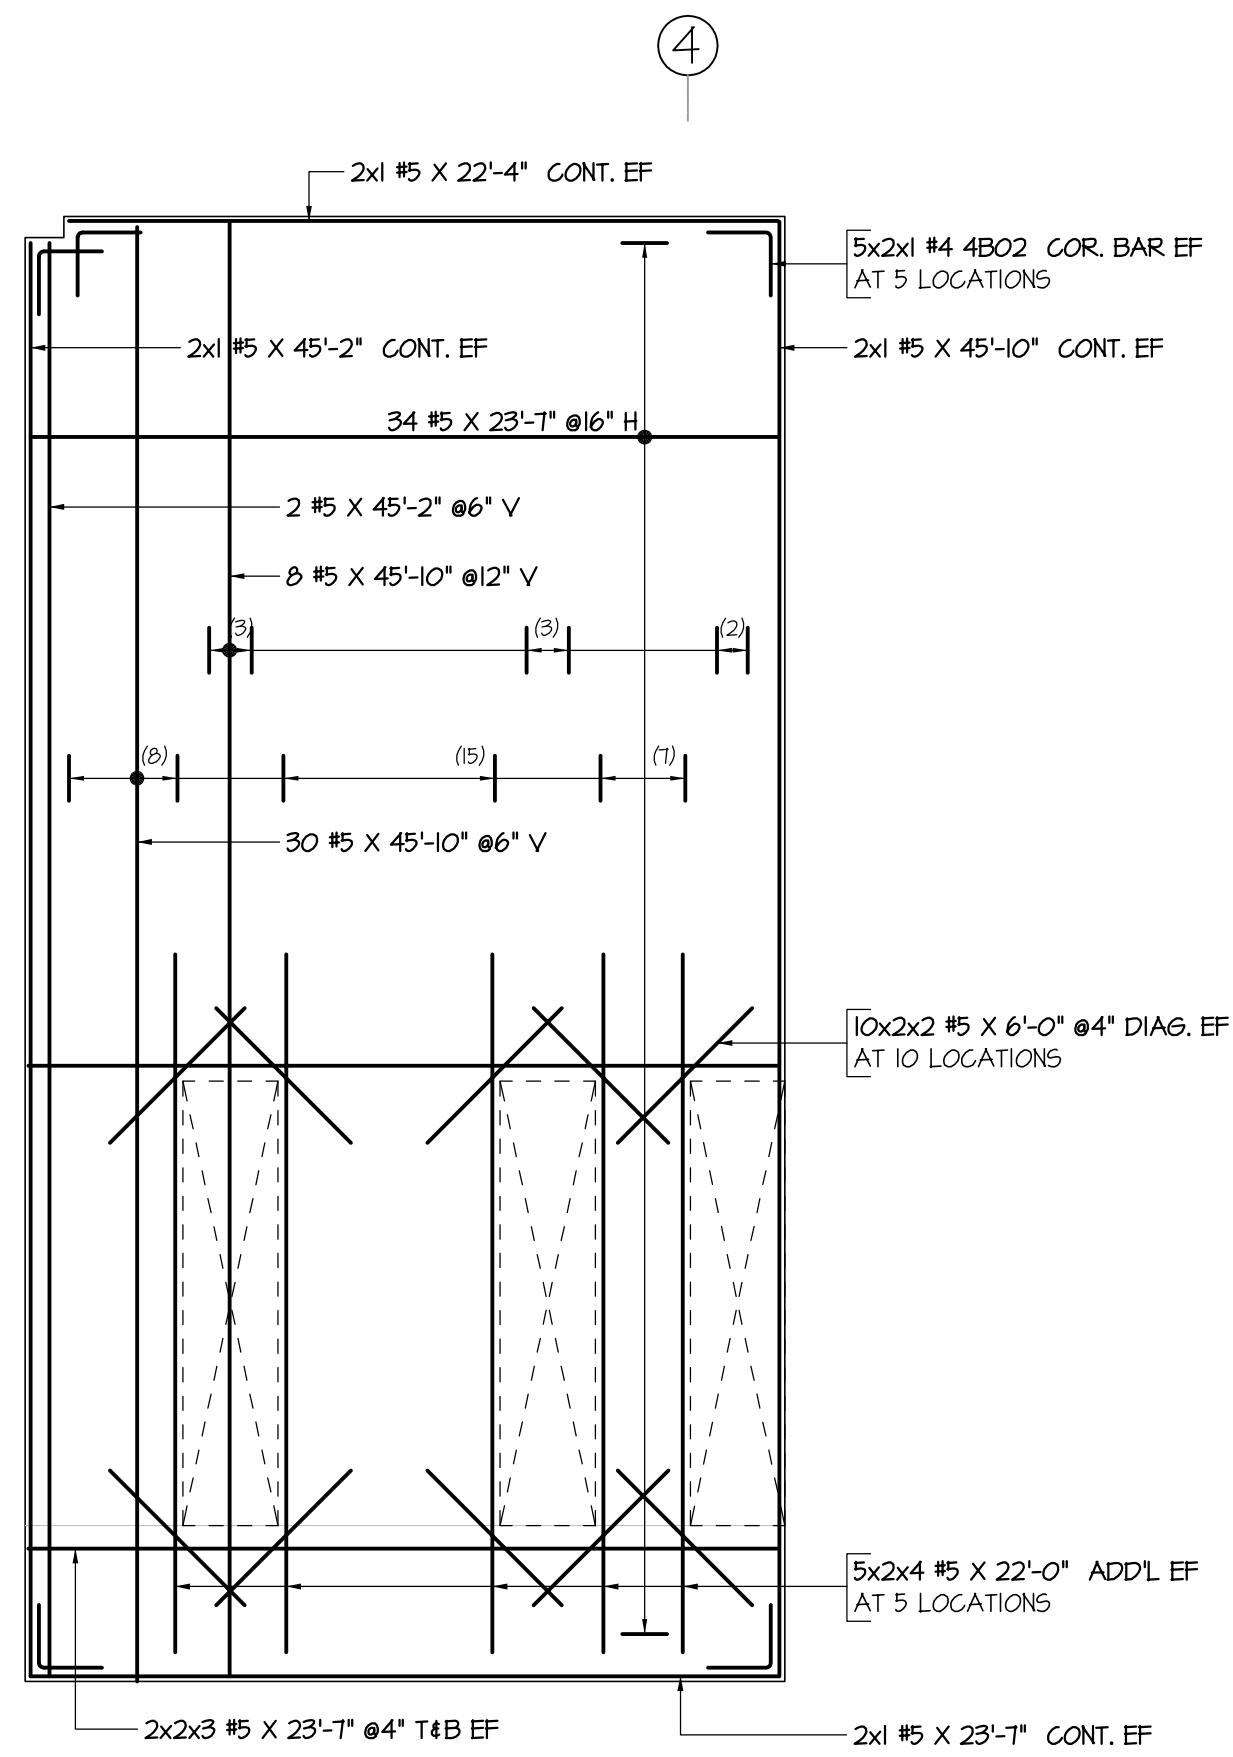


WALL PANEL - N7

SCALE: 1/6" = 1'-0"

SDR, RI, RB & 5200

(1/4" THK WALL)

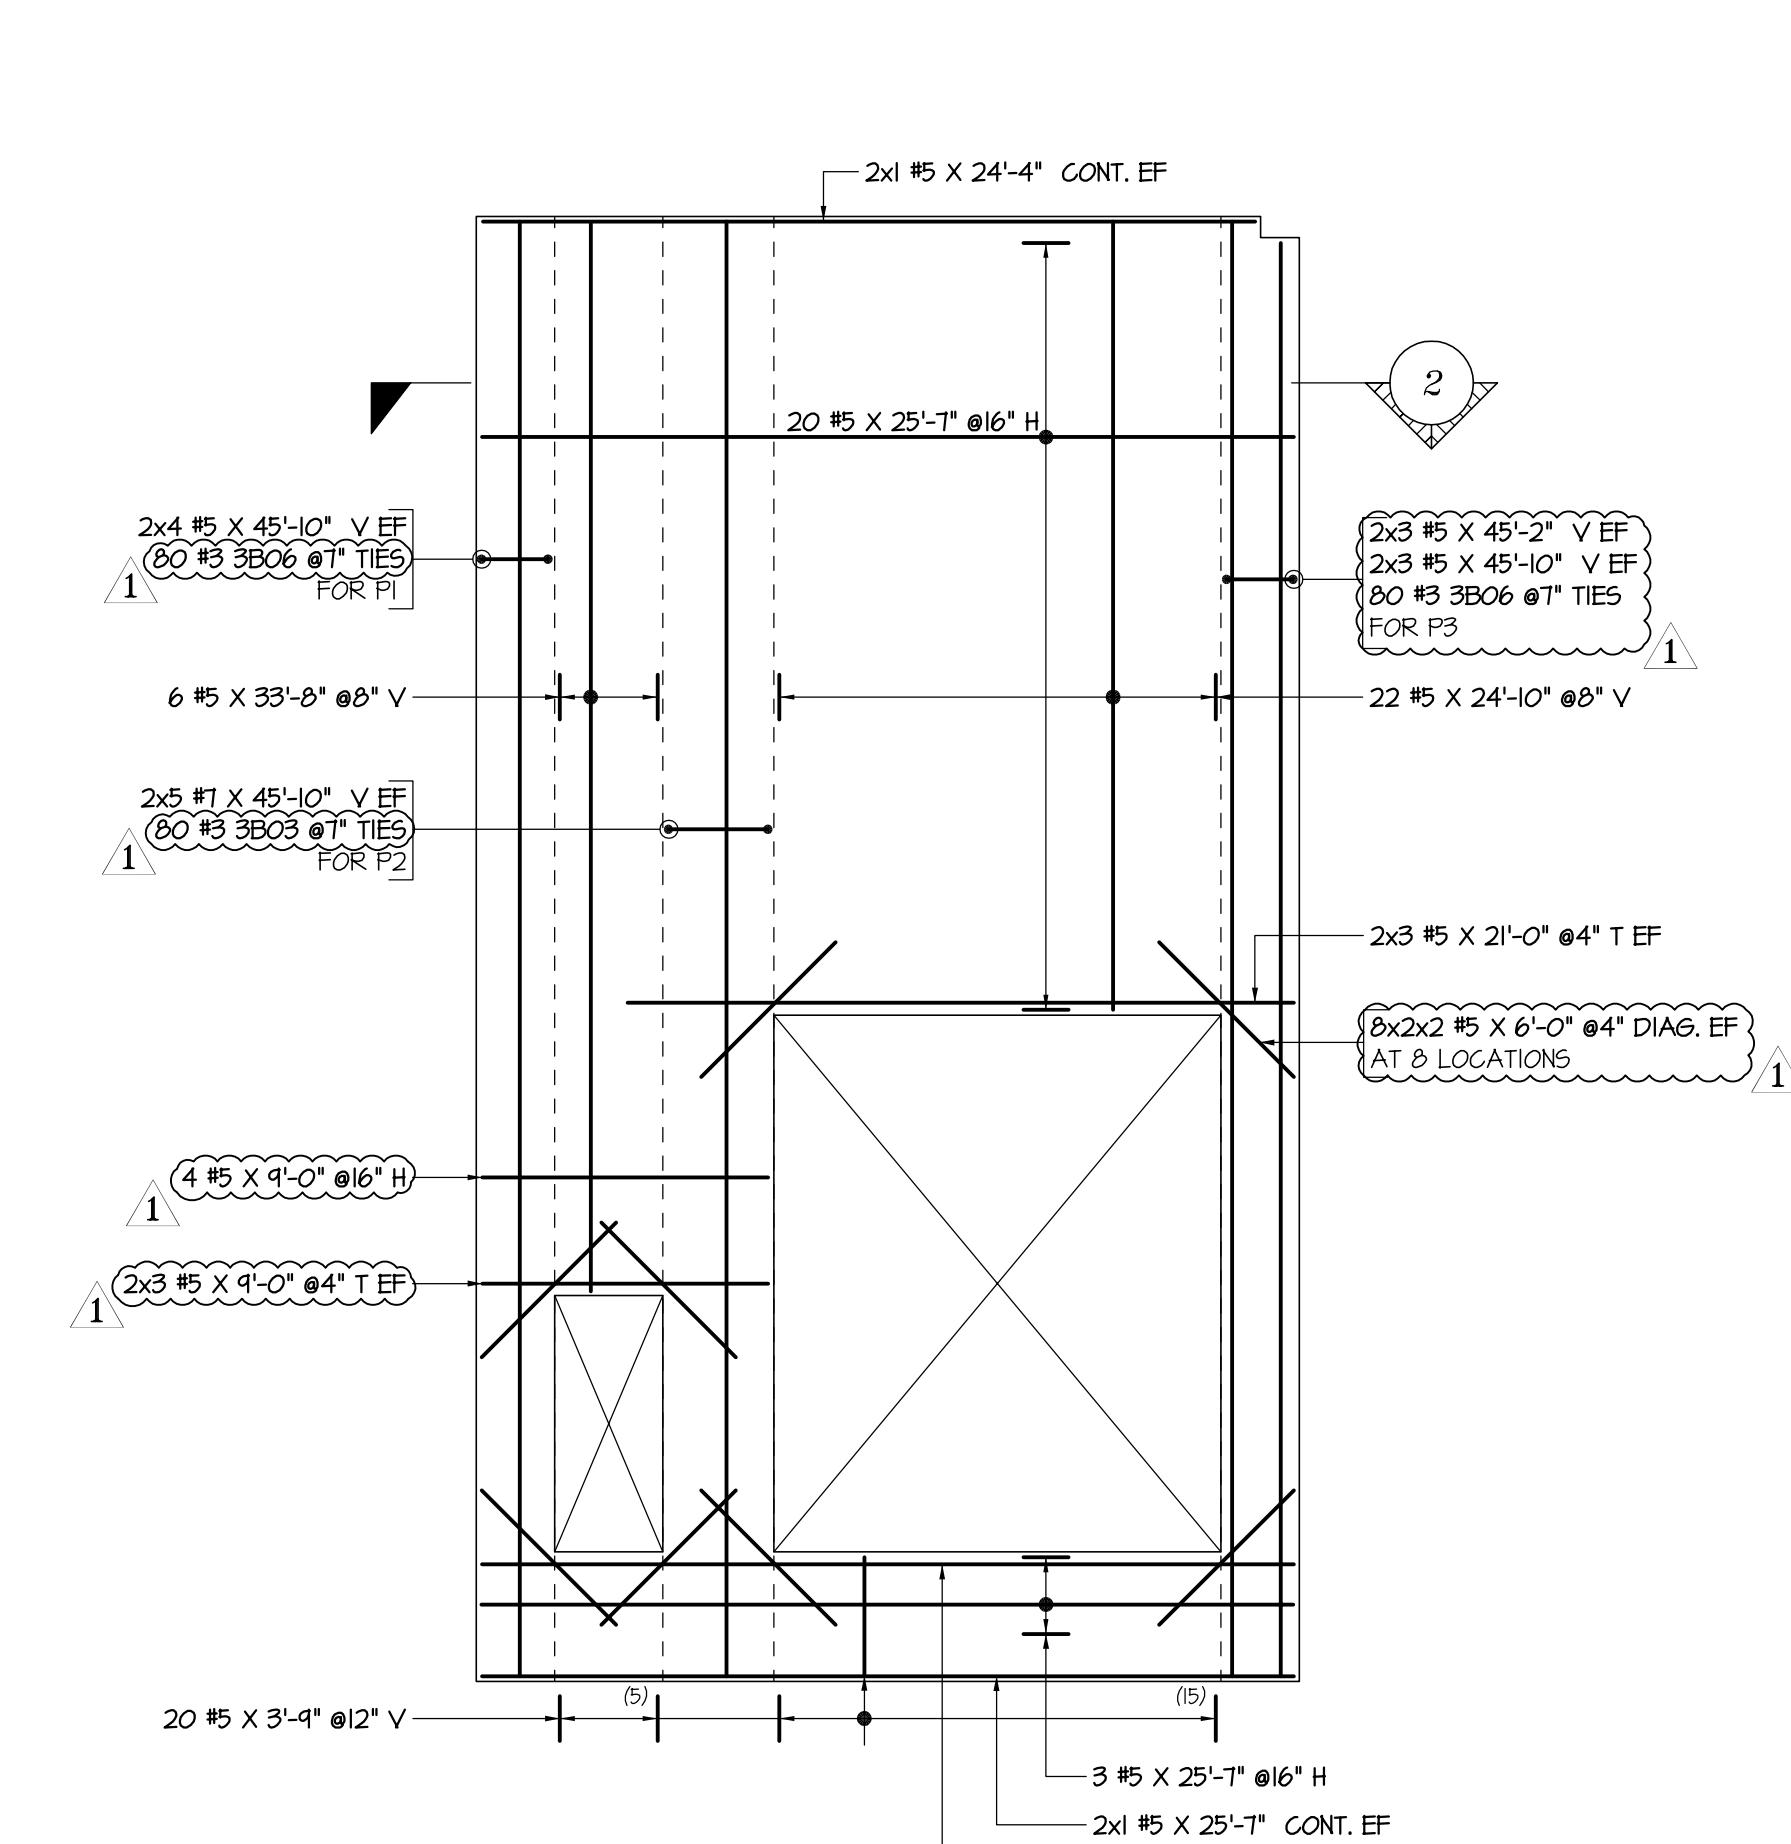


WALL PANEL - N8

SCALE: 1/6" = 1'-0"

SDR, RI, RB & 5200

(1/4" THK WALL)

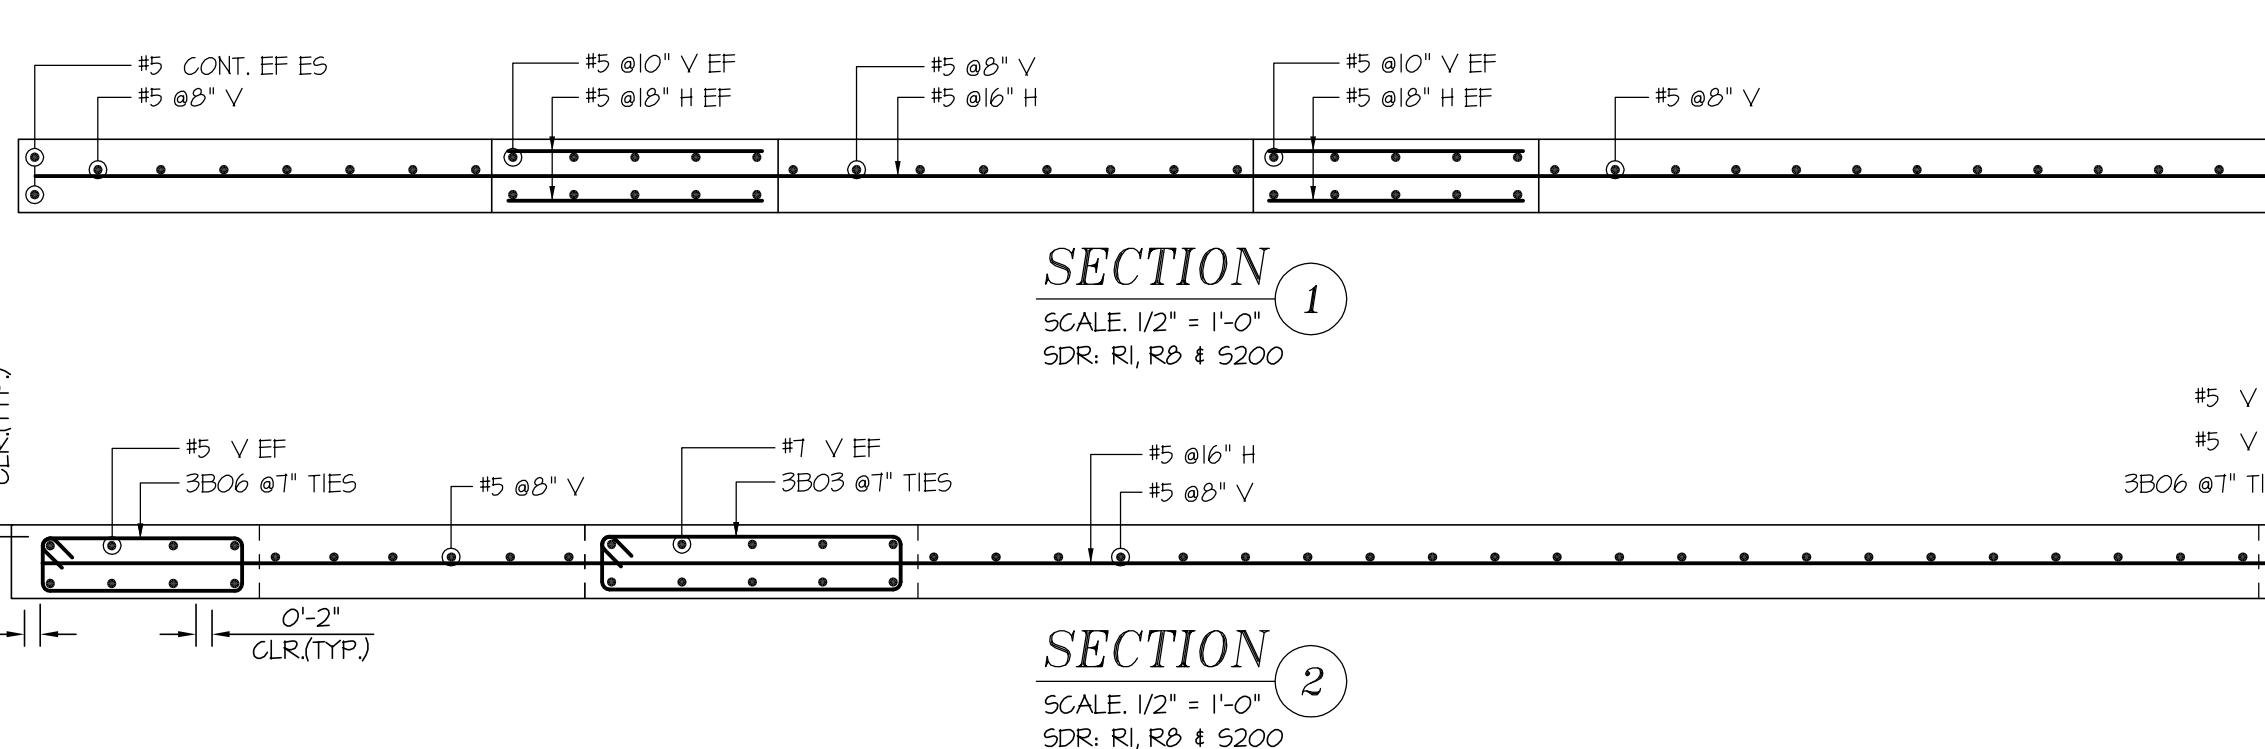

SECTION (1)

SCALE: 1/2" = 1'-0"



SDR, RI, RB & 5200

(1/4" THK WALL)


SECTION (2)

SCALE: 1/2" = 1'-0"

SDR, RI, RB & 5200

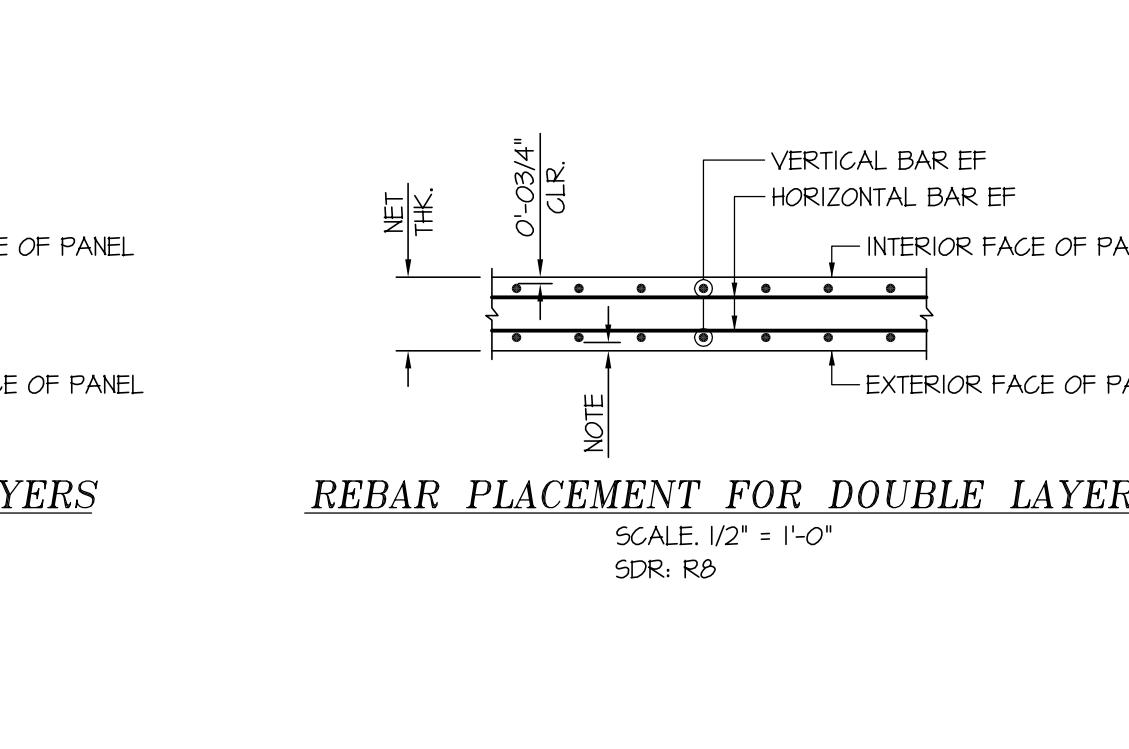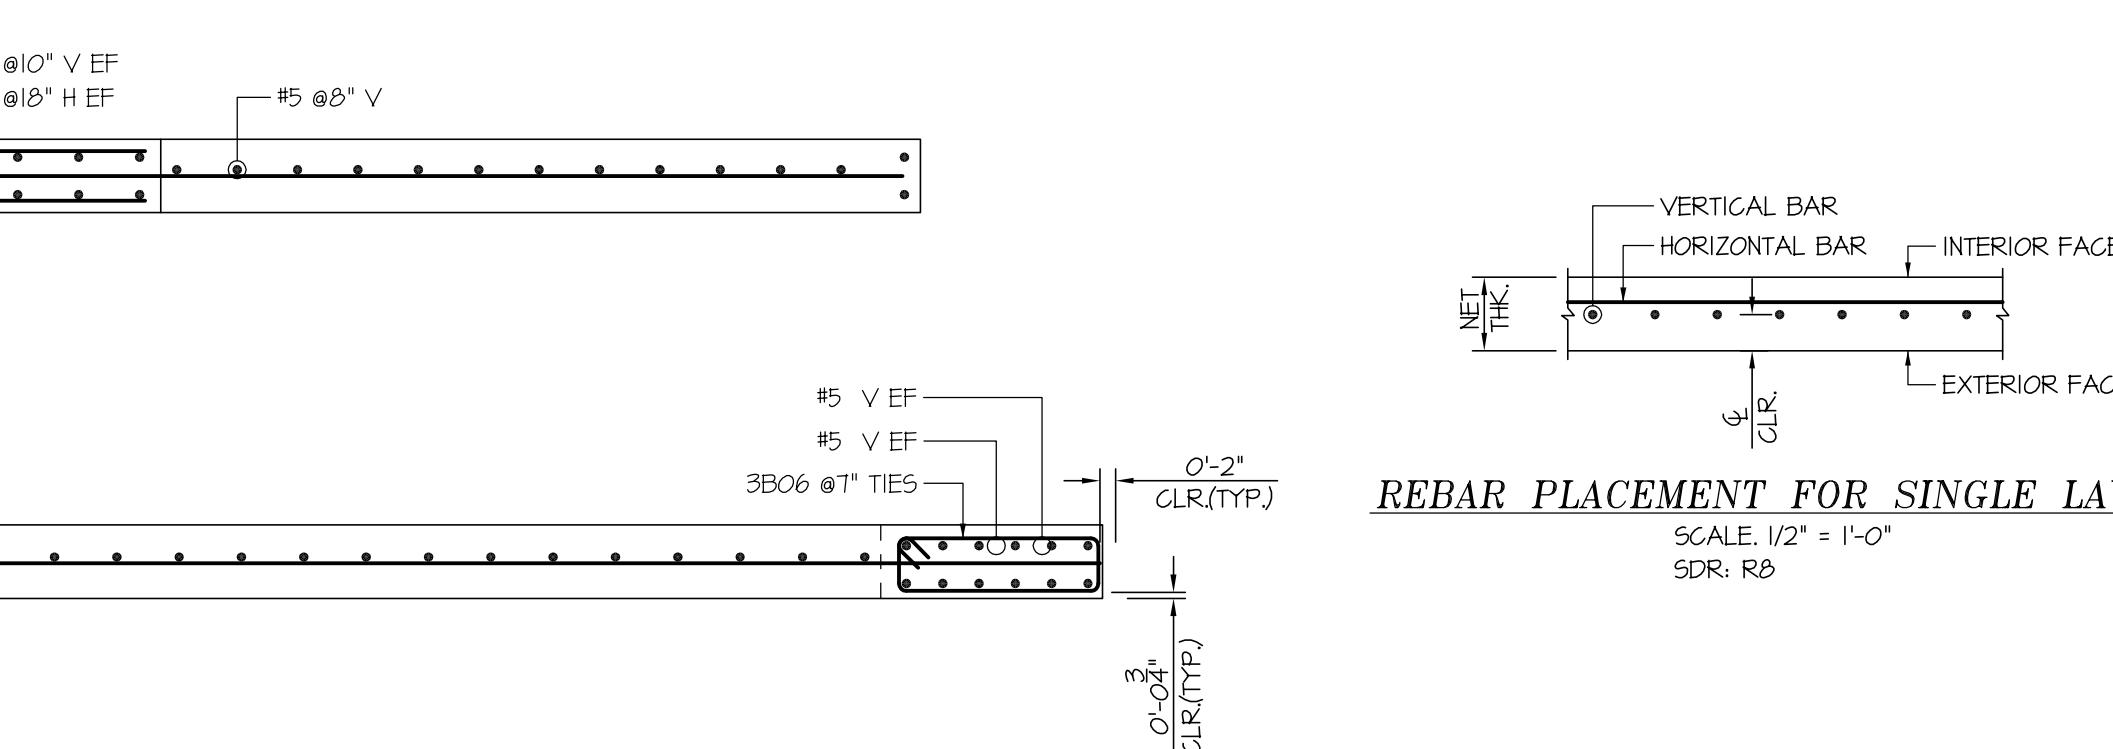

Drawing Sheet : R-4										
Bar Mark	Qty	Size	Total Length	Type	BENDING DETAILS					
					'	'	'	'	'	'
3803	80	#3	8'-2 1/2"	T1	0'-4 1/2"	3'-2"	0'-7"	3'-2"	0'-4 1/2"	0'-4 1/2"
3806	160	#3	6'-1 1/2"	T1	0'-4 1/2"	2'-1 1/2"	0'-7"	2'-1 1/2"	0'-7"	0'-4 1/2"
4802	74	#4	4'-0"	T1	0'-4 1/2"	2'-0"	2'-0"	2'-0"	2'-0"	0'-4 1/2"
4809	8	#4	4'-10"	T1	2'-0"	2'-10"	2'-0"	2'-10"	2'-0"	0'-4 1/2"
5804	2	#5	5'-10"	T20	2'-0"	1'-3 1/2"	2'-6"	2'-6"	2'-6"	0'-4 1/2"

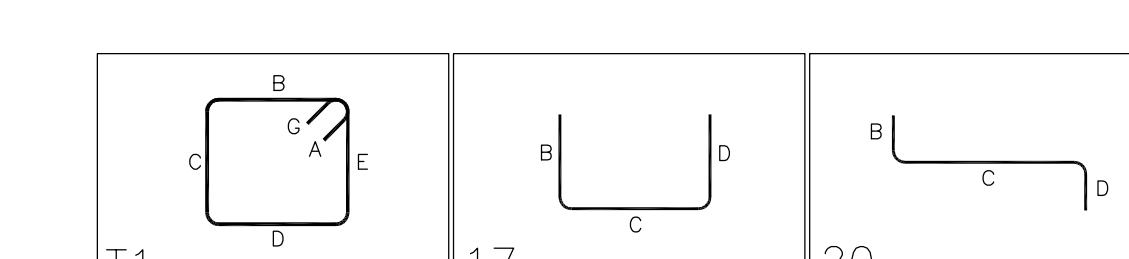

NORTH WALL PANELS
PLACING DRAWING REFERENCE

DWG.NO:	DRAWING DESCRIPTION
R-4	NORTH WALL PANELS N1 TO N-8
R-5	NORTH WALL PANELS N-9 TO N-15
R-6	NORTH WALL PANELS N-16 TO N-22
R-7	NORTH WALL PANELS N-23 TO N-29
R-8	NORTH WALL PANELS N-30 TO N-36
R-9	NORTH WALL PANELS N-37 TO N-43
R-10	NORTH WALL PANELS N-44 TO N-50
R-11	NORTH WALL PANELS N-51 TO N-58
R-12	NORTH WALL PANELS N-59 TO N-66
R-13	NORTH WALL PANELS N-67 TO NT3
R-14	NORTH WALL PANELS N-74 TO N-81

STRUCTURAL NOTES

LEGENDS	LABEL LEGENDS
T - TOP	6x2x6 #4 4C09 @12" B2
B - BOTTOM	NOTES
V - VERTICAL	SPACING
H, HORIZ. - HORIZONTAL	BAR MARK
CLR. - CLEAR COVER	BAR SIZE
SIM. - SIMILAR	NUMBER OF BARS
TYP. - TYPICAL	EACH FACE/ EACH SIDE
TOMAT - TOP OF MAT	NUMBER OF LOCATION
ES - EACH SIDE	
EF - EACH FACE	
CONT. - CONTINUOUS	
COR. - CORNER	
THK. - THICKNESS	
ADDL. - ADDITIONAL	
DIAG. - DIAGONAL	
NTS - NOT TO SCALE	
€ - CENTER LINE	
SDR - STRUCTURAL DRAWING	
REFERENCE	
	DENOTES OPENINGS
	DENOTES KNOCK OUTS
	CLEAR COVER TO REINFORCEMENT
WALL PANEL	
	2" AT ENDS
	1 1/2" #5 @ BELOW AT EXTERIOR FACE
	2" #6 @ ABOVE AT EXTERIOR FACE
	3/4" AT INTERIOR FACE

X Reviewed X Furnished as Corrected

□ Rejected □ Revise and Resubmit


□ Submit Specific Item

This review is only for general conformance with the design concept of the project and general compliance with the information given in the Contract Documents. Corrections in the specific areas indicated by the review are the responsibility of the contractor. This review does not include approval of an assembly or with the item is a complete assembly. Contractor is responsible for dimensions to be followed and correlated at the jobsite to the fabrication process or the methods, techniques, sequences and processes of construction; coordination of his or her work with that of all trades; and for performing all work in a safe and satisfactory manner.

RICHARD ADAMS
ENGINEERS & CONSULTANTS, INC.
CONSULTING ENGINEERS

DATE: 07-09-2019 REVIEWED BY DM

DATE: 05.24.2019 APPROVAL SENT FOR

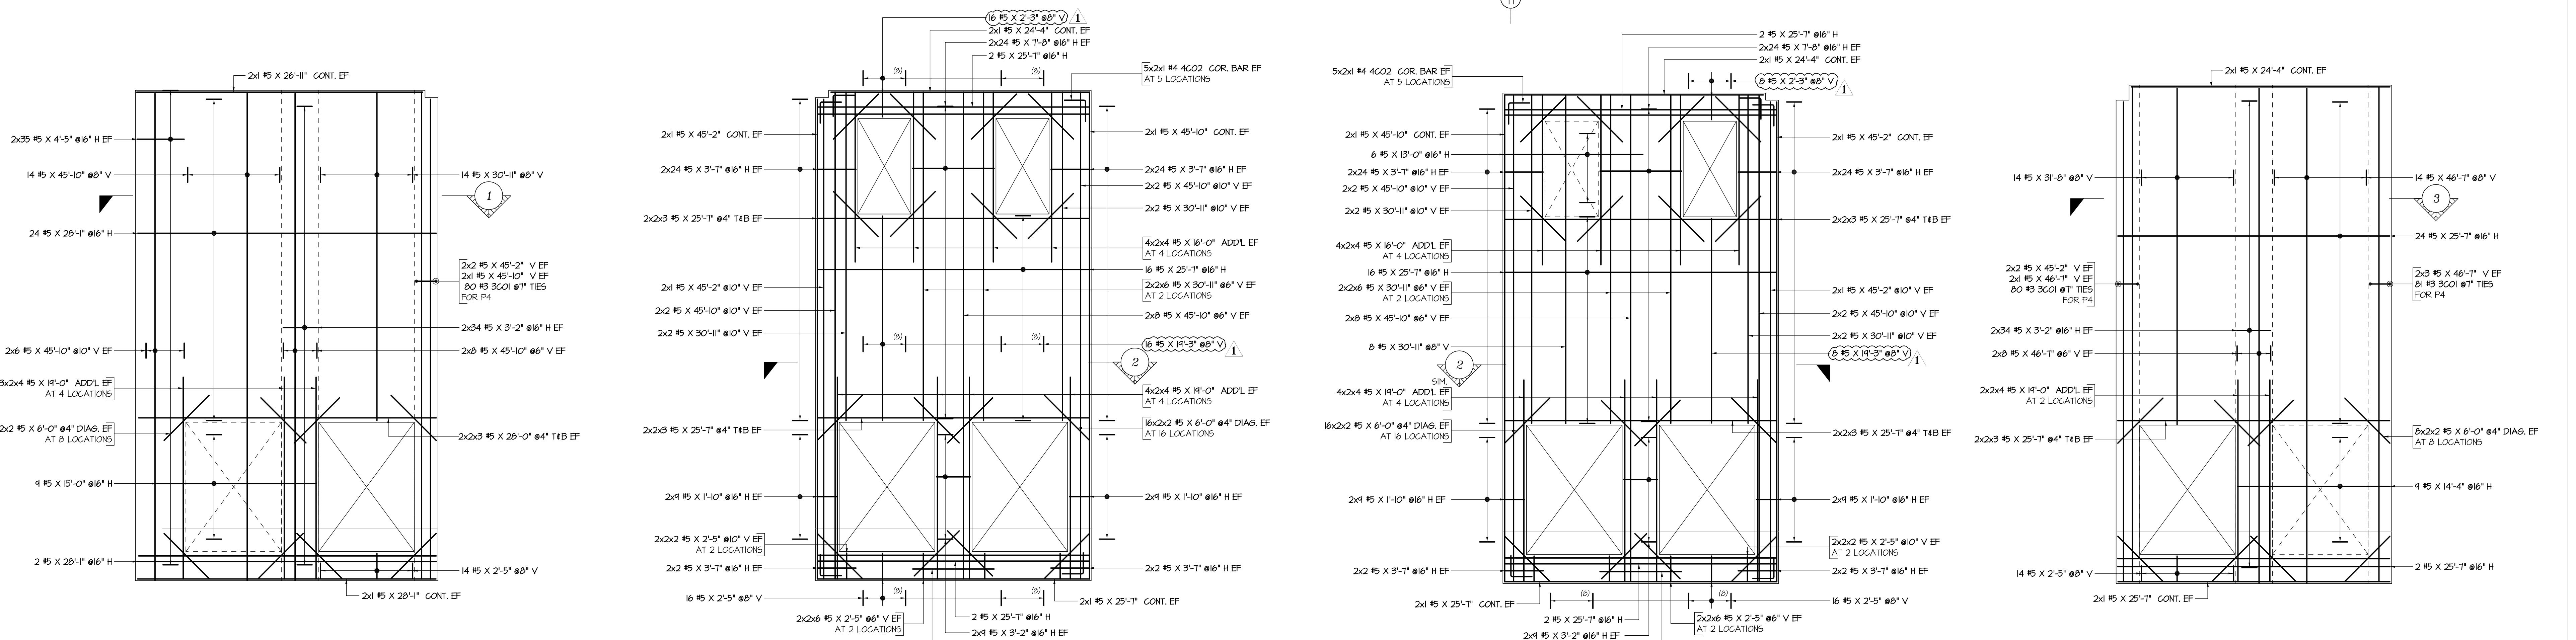

WALL PANEL - N23

SCALE: 1/8" = 1'-0"
SDR: RI, RD & 5200
(9 1/4" THK WALL)

WALL PANEL - 24


SCALE: 1/8" = 1'-0"
SDR: RI, RD & 5200
(9 1/4" THK WALL)

WALL PANEL - N25

SCALE: 1/8" = 1'-0"
SDR: RI, RD & 5200
(9 1/4" THK WALL)

WALL PANEL - N26

SCALE: 1/8" = 1'-0"
SDR: RI, RD & 5200
(9 1/4" THK WALL)

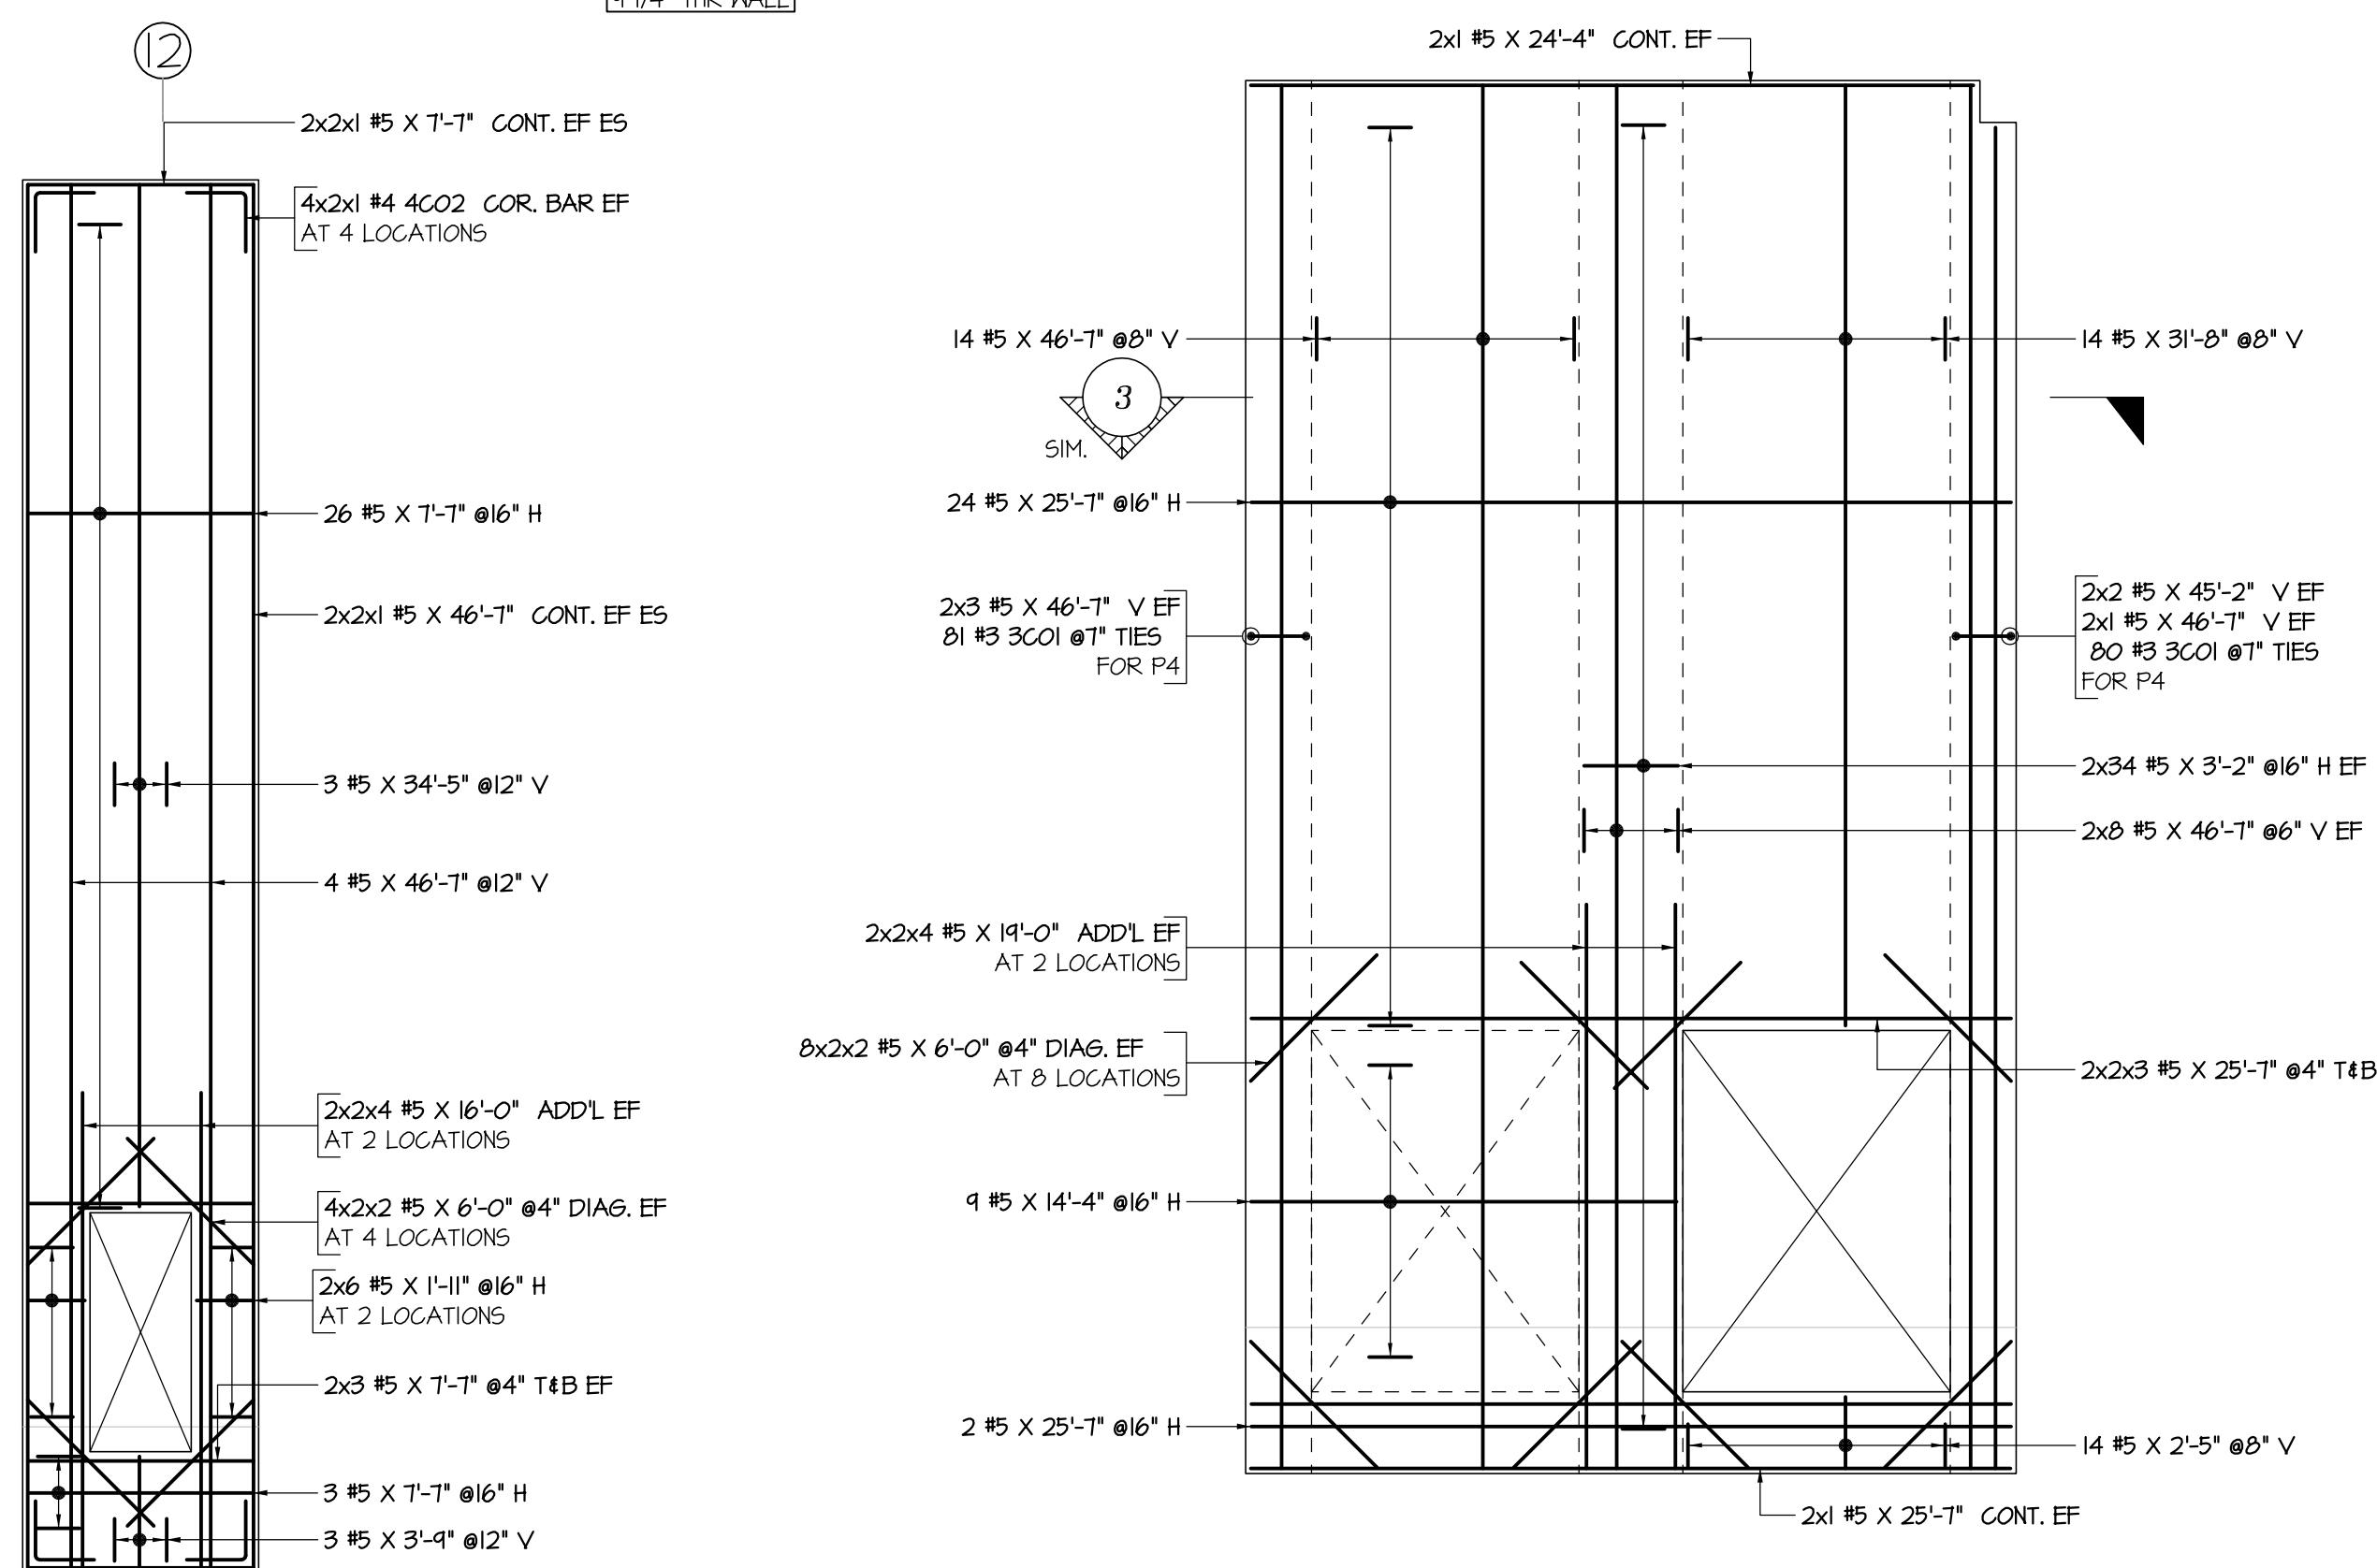

WALL PANEL - N27


SCALE: 1/8" = 1'-0"
SDR: RI, RD & 5200
(9 1/4" THK WALL)

WALL PANEL - N28

SCALE: 1/8" = 1'-0"
SDR: RI, RD & 5200
(9 1/4" THK WALL)


WALL PANEL - N29

SCALE: 1/8" = 1'-0"
SDR: RI, RD & 5200
(9 1/4" THK WALL)

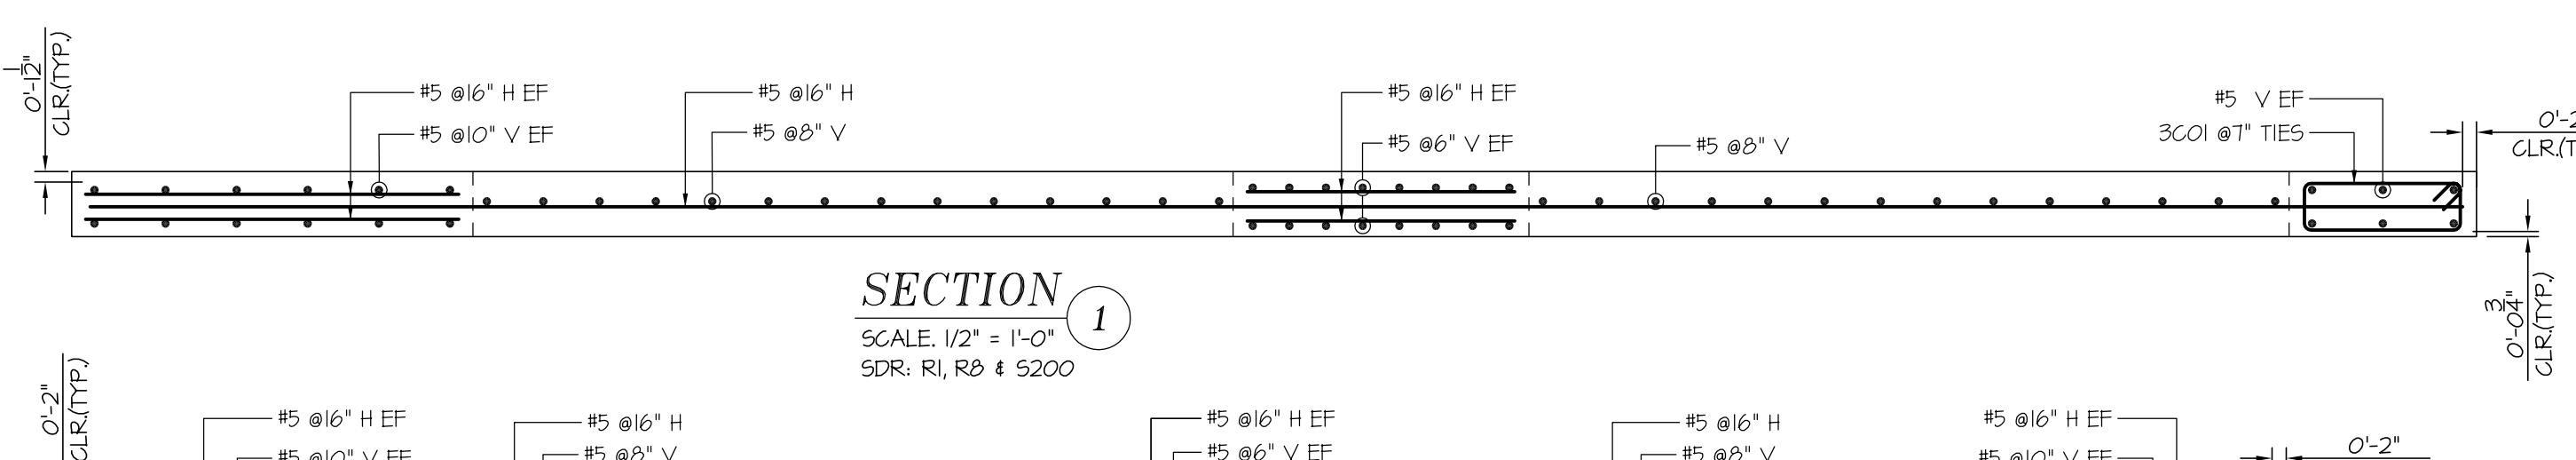

SECTION 1

SCALE: 1/2" = 1'-0"
SDR: RI, RD & 5200

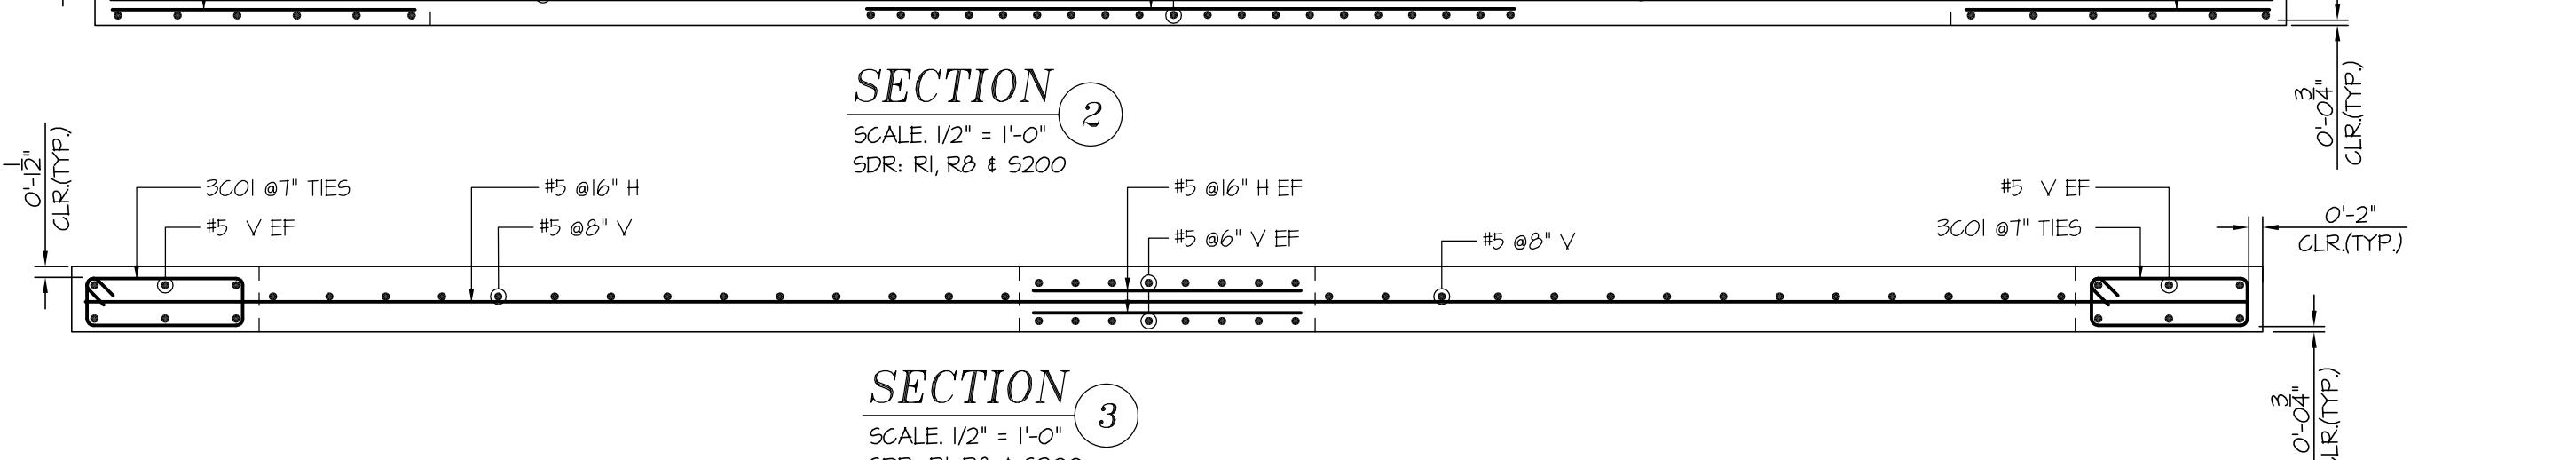



SECTION 2

SCALE: 1/2" = 1'-0"
SDR: RI, RD & 5200

SECTION 3

SCALE: 1/2" = 1'-0"
SDR: RI, RD & 5200

BENDING DETAILS											
Bar Mark	Oty	Size	Total Length	Type	'X'	'Y'	'Z'	'U'	'V'	'W'	'X'
3C01	402	13	5'-7 1/2"	T1	0'-4 X	1'-10 X	0'-7	1'-10 X	0'-7	0'-4 X	
4002	38	14	4'-0 1/2"	T17	2'-0		2'-0				

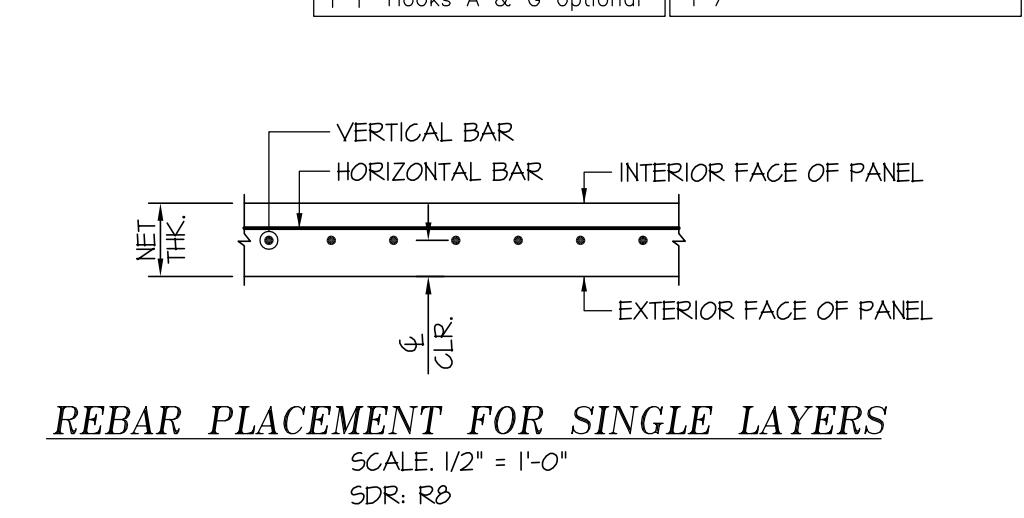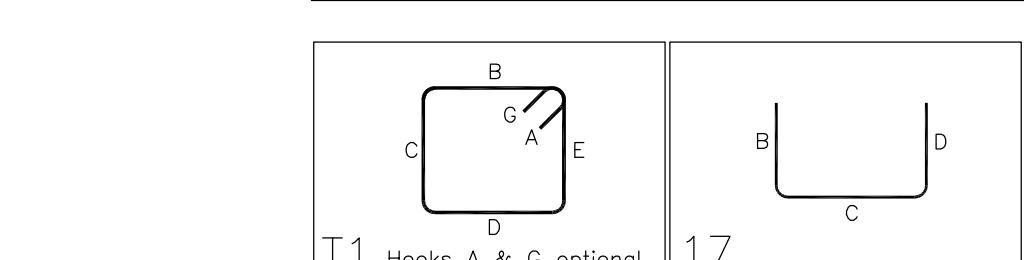

REBAR PLACEMENT FOR SINGLE LAYERS

SCALE: 1/2" = 1'-0"
SDR: RD

REBAR PLACEMENT FOR DOUBLE LAYERS

SCALE: 1/2" = 1'-0"
SDR: RD

STRUCTURAL NOTES	
LEGENDS	LABEL LEGENDS
T - TOP	6x2x6 #4 4C02 @12" B2
B - BOTTOM	NOTES
V, VERT - VERTICAL	SPACING
H, HORIZ - HORIZONTAL	BAR MARK
CLR - CLEAR COVER	BAR SIZE
SIM - SIMILAR	NUMBER OF BARS
TYP - TYPICAL	EACH FACE/ EACH SIDE
T.MAT - TOP OF MAT	NUMBER OF LOCATION
E.S - EACH SIDE	
EF - EACH FACE	
CONT - CONTINUOUS	
COR - CORNER	
THK - THICKNESS	
ADDL - ADDITIONAL	
DIAG - DIAGONAL	
NTS - NOT TO SCALE	
CL - CENTER LINE	
SDR - STRUCTURAL DRAWING	
REFERENCE	
	DRAWING NUMBER
	WALL PANEL
	2"
	1 1/2"
	2"
	3/4"
	AT END
	#5 BELOW AT EXTERIOR FACE
	#6 ABOVE AT EXTERIOR FACE
	AT INTERIOR FACE


REINFORCING STEEL PLACING DRAWING ONLY. USE IN CONJUNCTION WITH CONTRACT DRAWINGS & SPECIFICATIONS. ELEVATIONS & DIMENSIONS SHOWN ON THIS DRAWING ARE FOR DETAILING PURPOSES ONLY AND SHOULD NOT BE USED FOR CONSTRUCTION UNLESS VERIFIED BY ENGINEER OR CONTRACTOR.

7	
6	
5	
4	
3	
2	06.10.2019 RE SUBMITTED FOR APPROVAL
1	05.24.2019 APPROVAL DATE SENT FOR

RE-STEEL SUPPLY CO., INC.
REINFORCING STEEL - WIRE MESH


2000 Eddystone Industrial Park • Eddystone, PA 19022-1588
Phone: 800-876-8216 • Fax: 610-876-8428

Structure	VALLEY VIEW BUSINESS PARK TILT PANELS
Location	JESSUP, PA
Architect	KSS ARCHITECTS
Engineer	RICHARD ADAMS
Customer	T&T CONSTRUCTION
Made by:	PRO Date: 05.24.2019
	CONTRACT NO. U2524
DRAWING COVERS	NORTH WALL PANELS N-23 TO N-29
REV. NO.	06.10.2019
DATE	REvised AS PER LATEST CO'S RECEIVED ON 03.19.19
DESCRIPTION	DRAWING NO. R-7

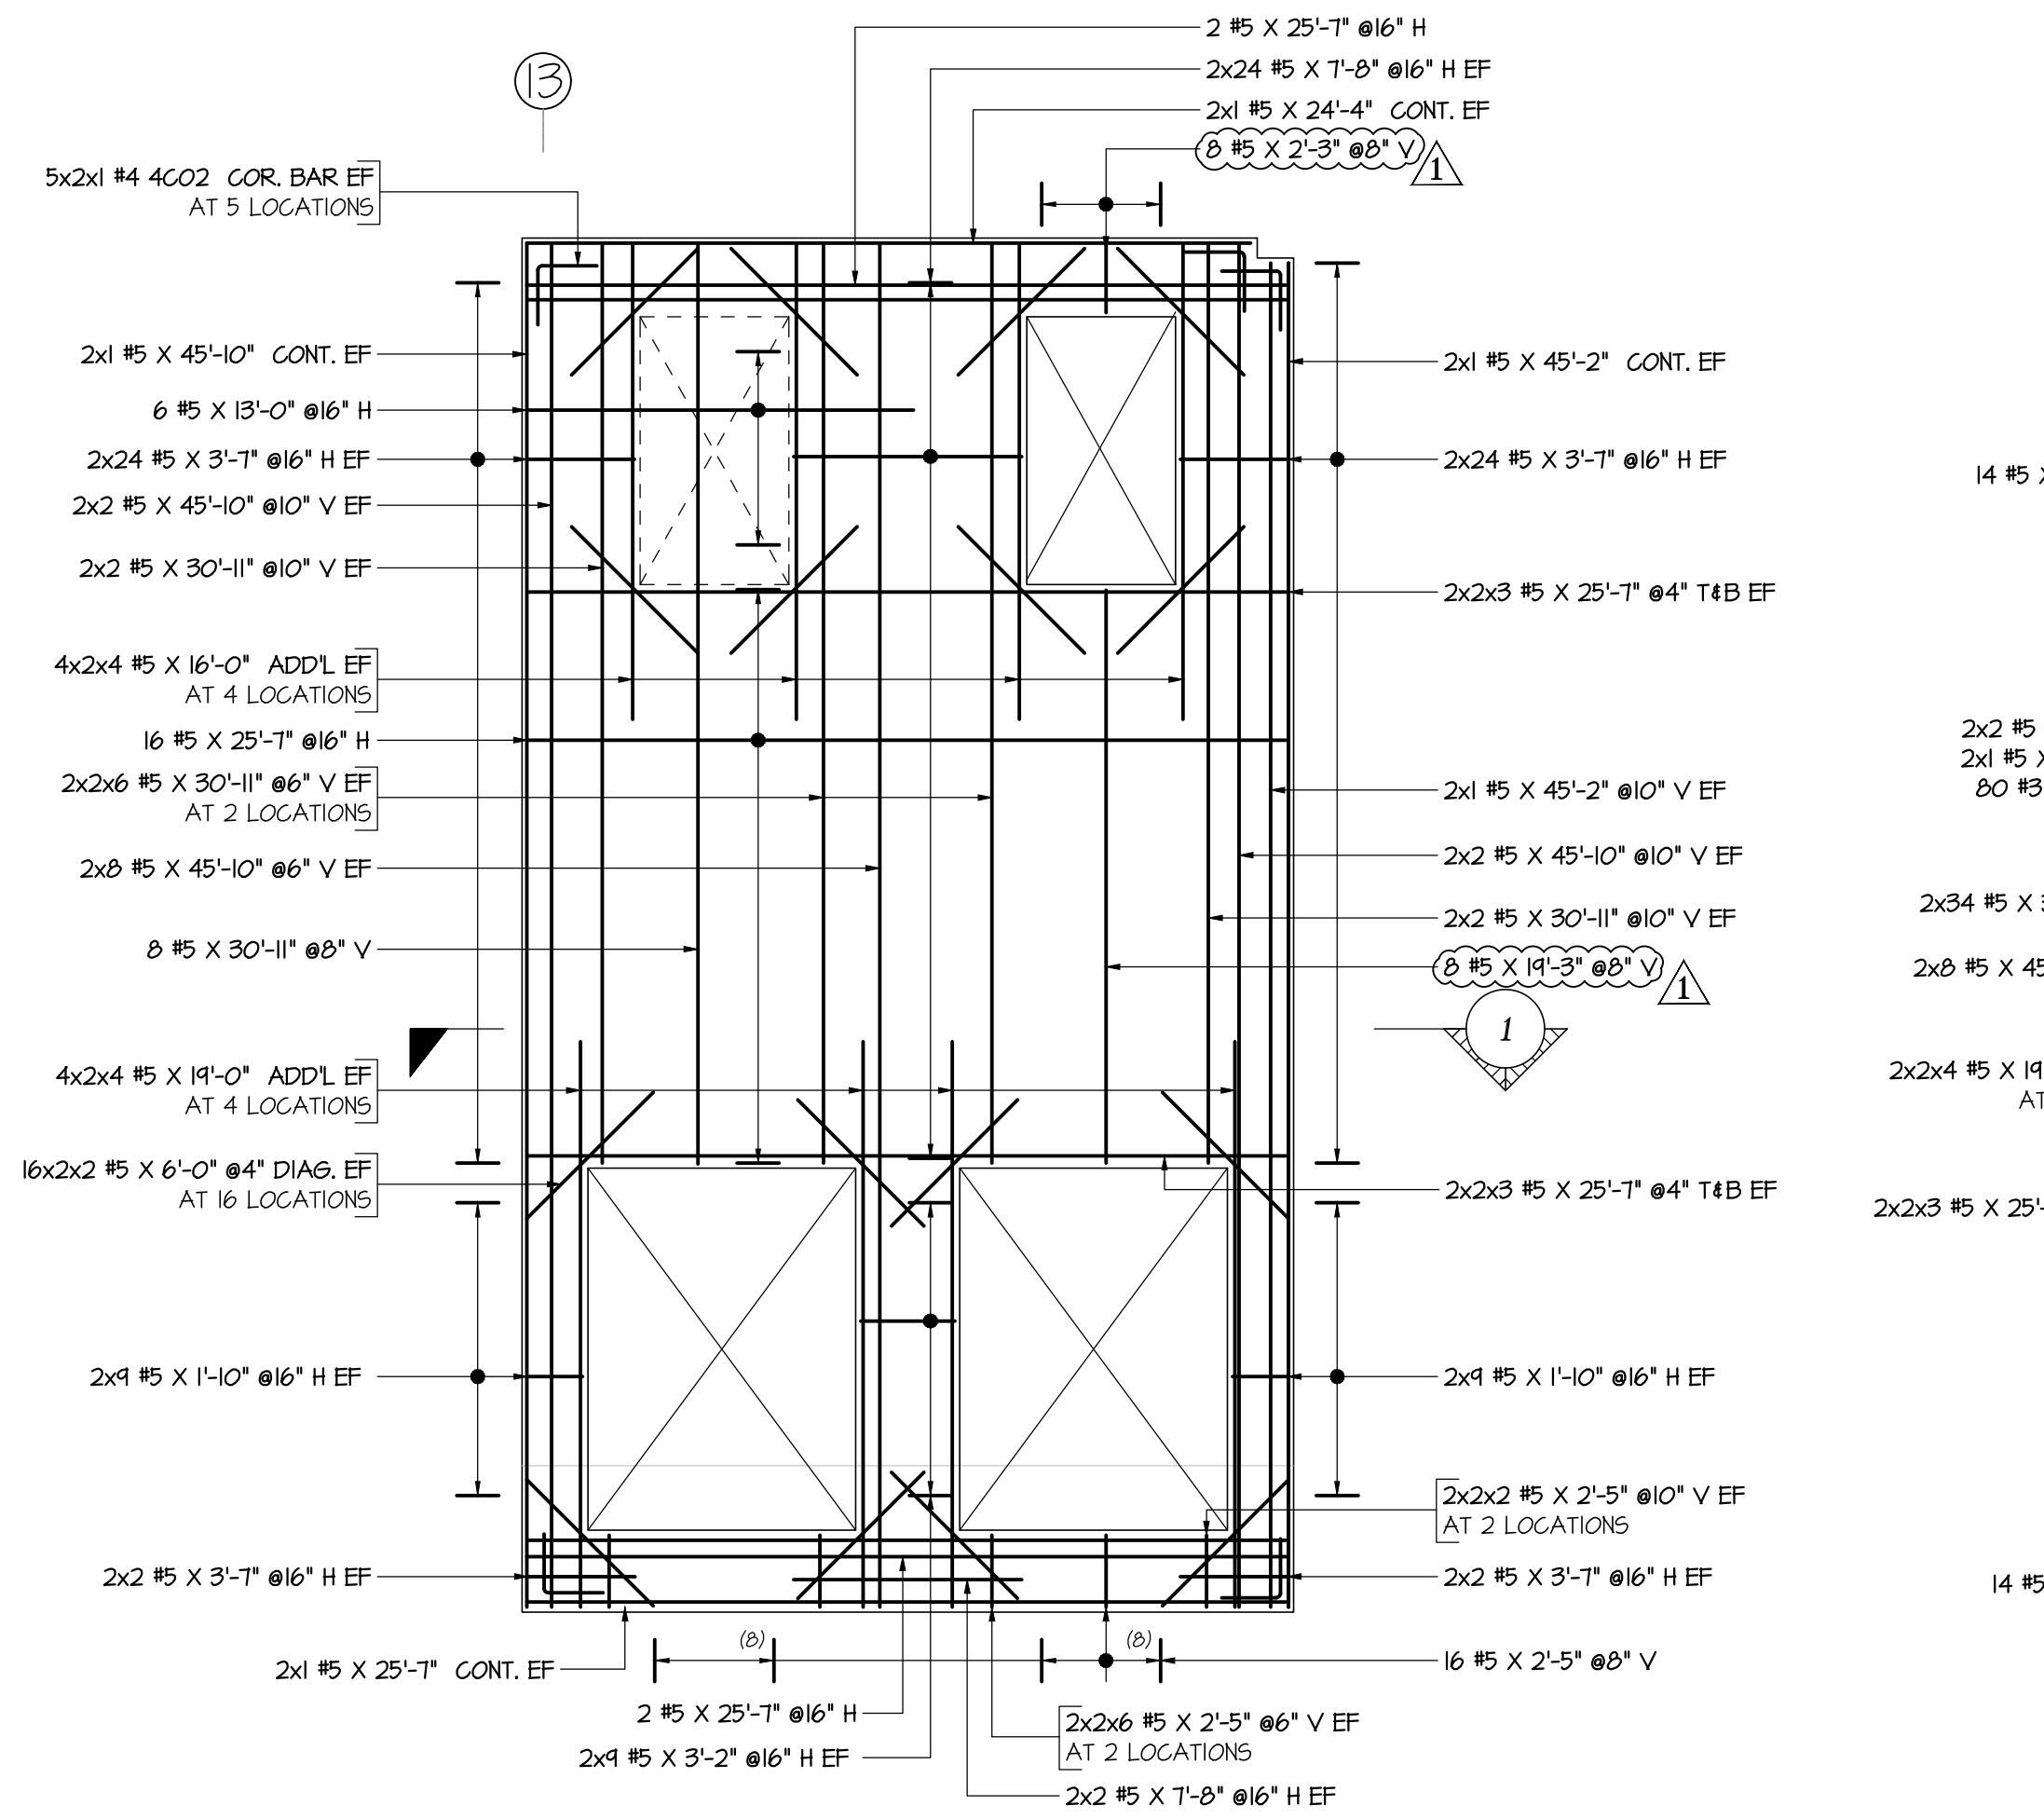


WALL PANEL - N30

SCALE. 1/6" = 1'-0"
SDR: R1, R8 & S200
9 1/4" THK WALL

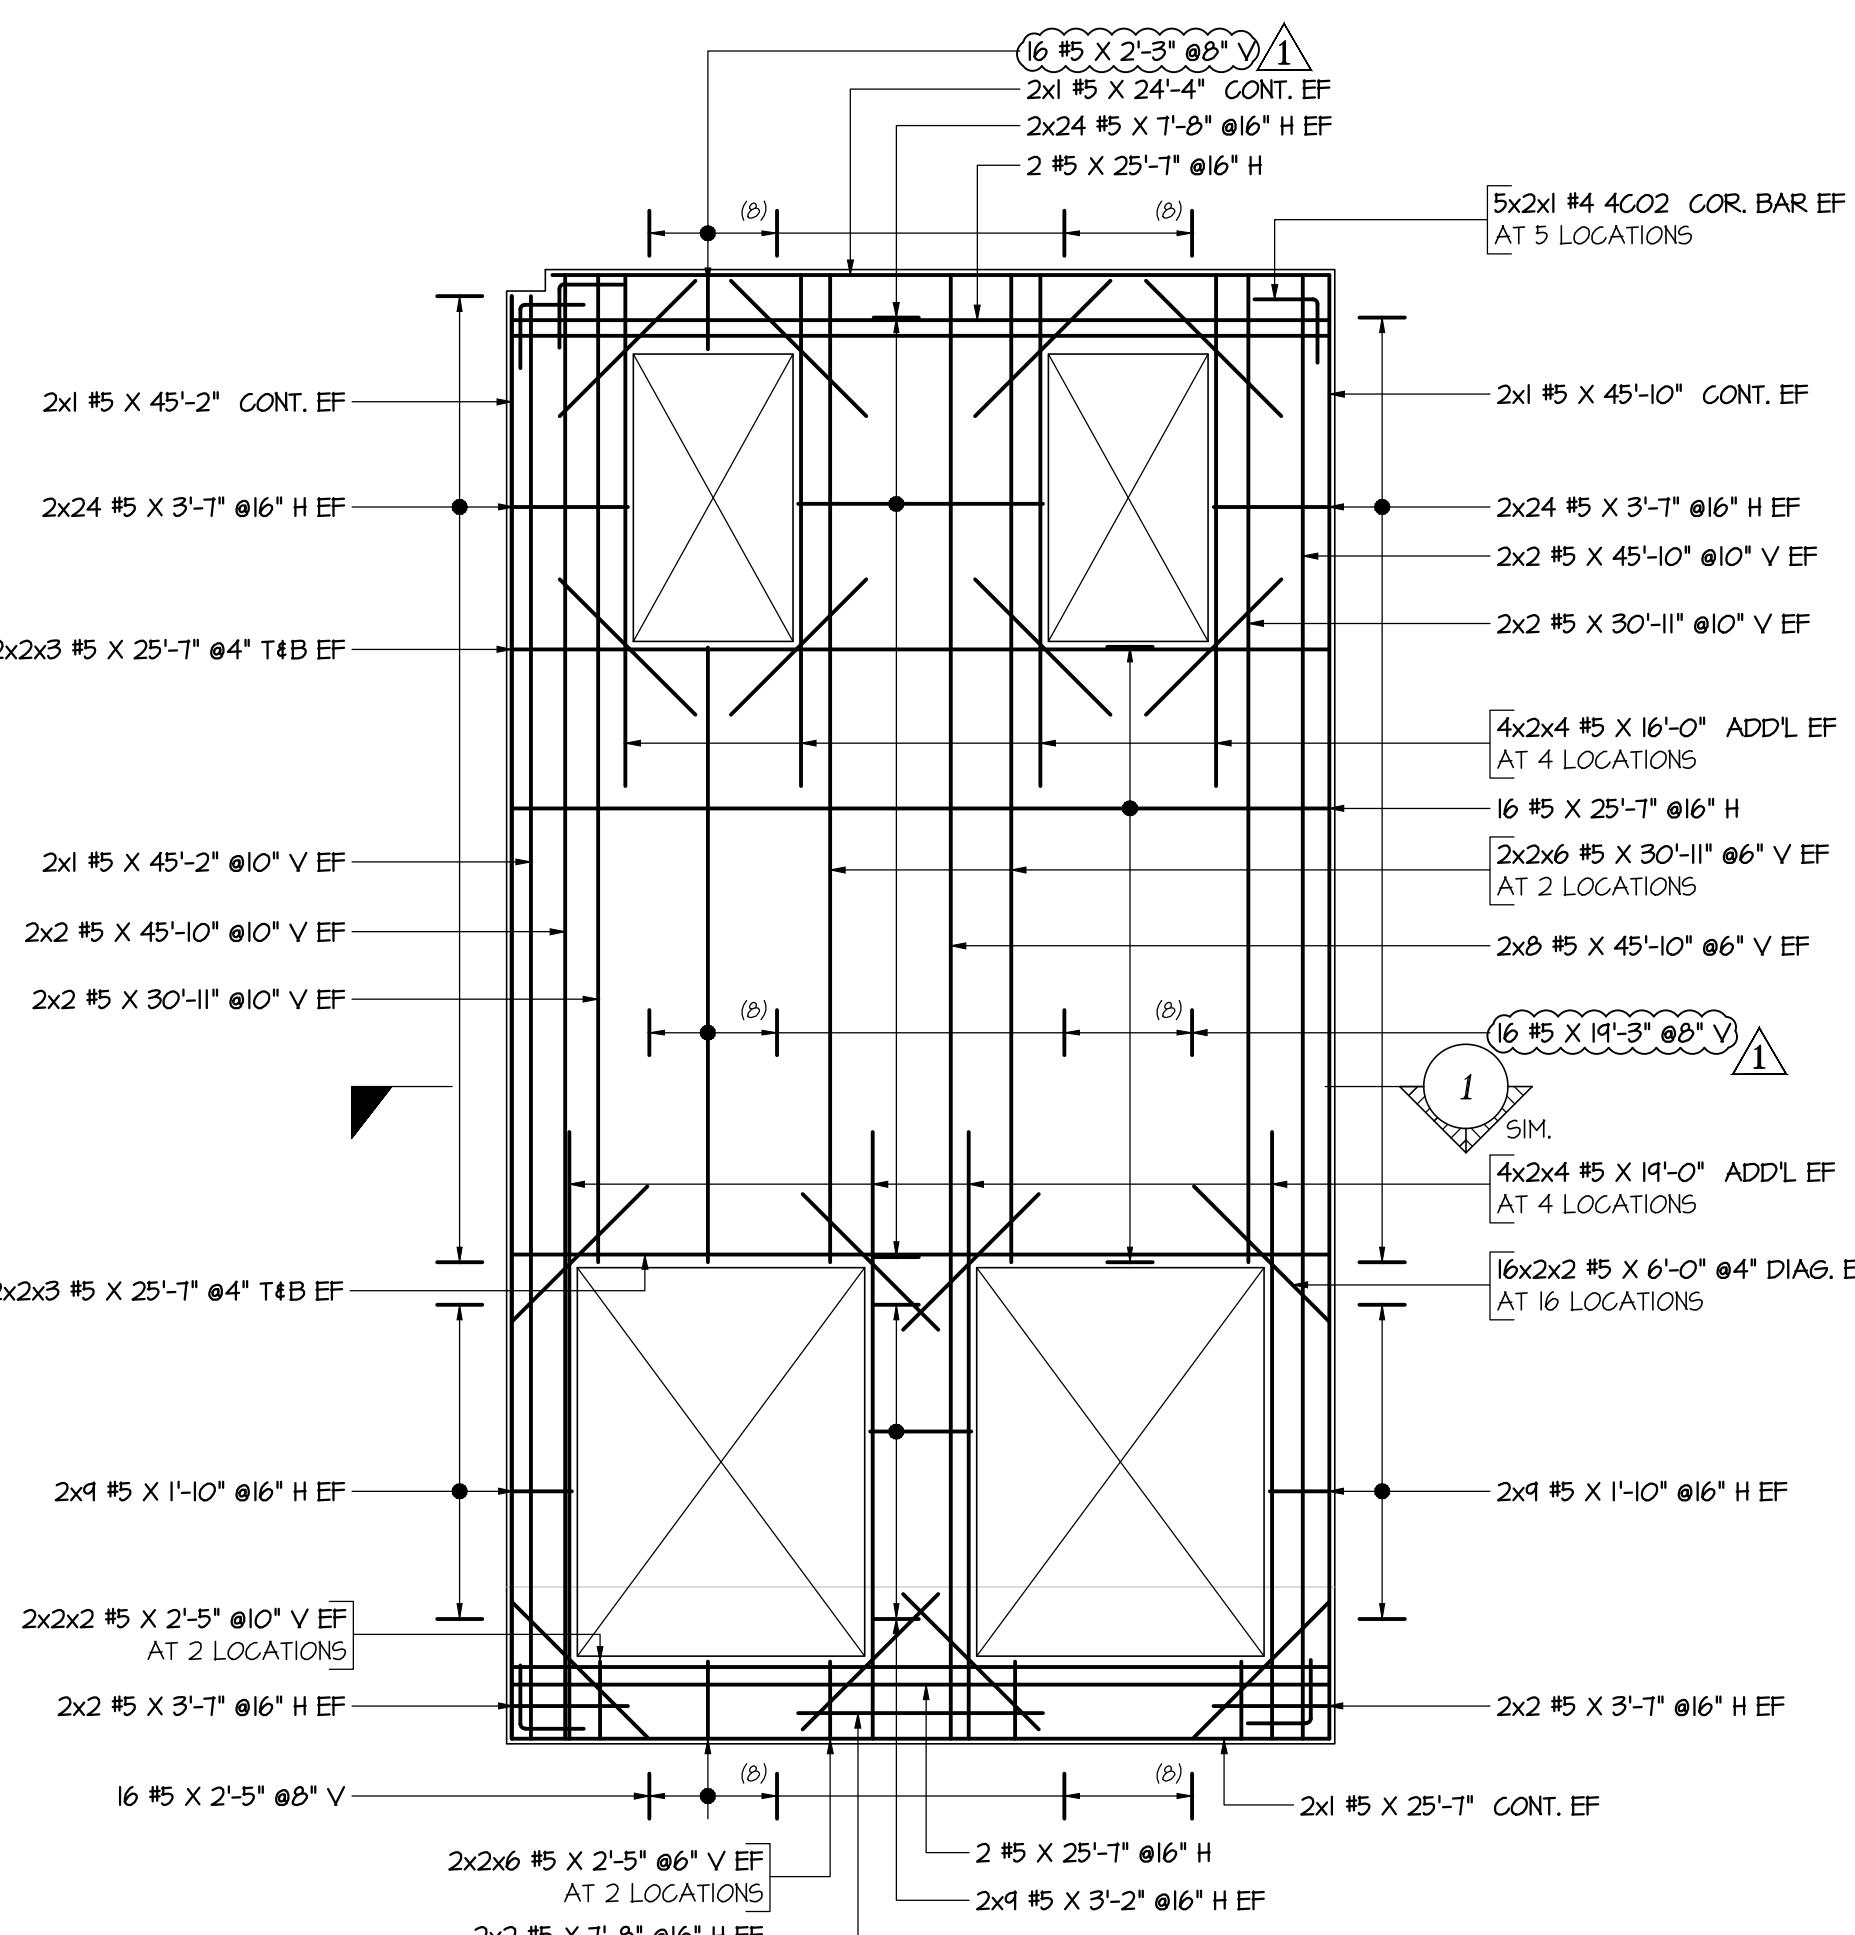

WALL PANEL - 34

SCALE. 1/6" = 1'-0"
SDR: R2, R8 & \$200
9 1/4" THK WALL

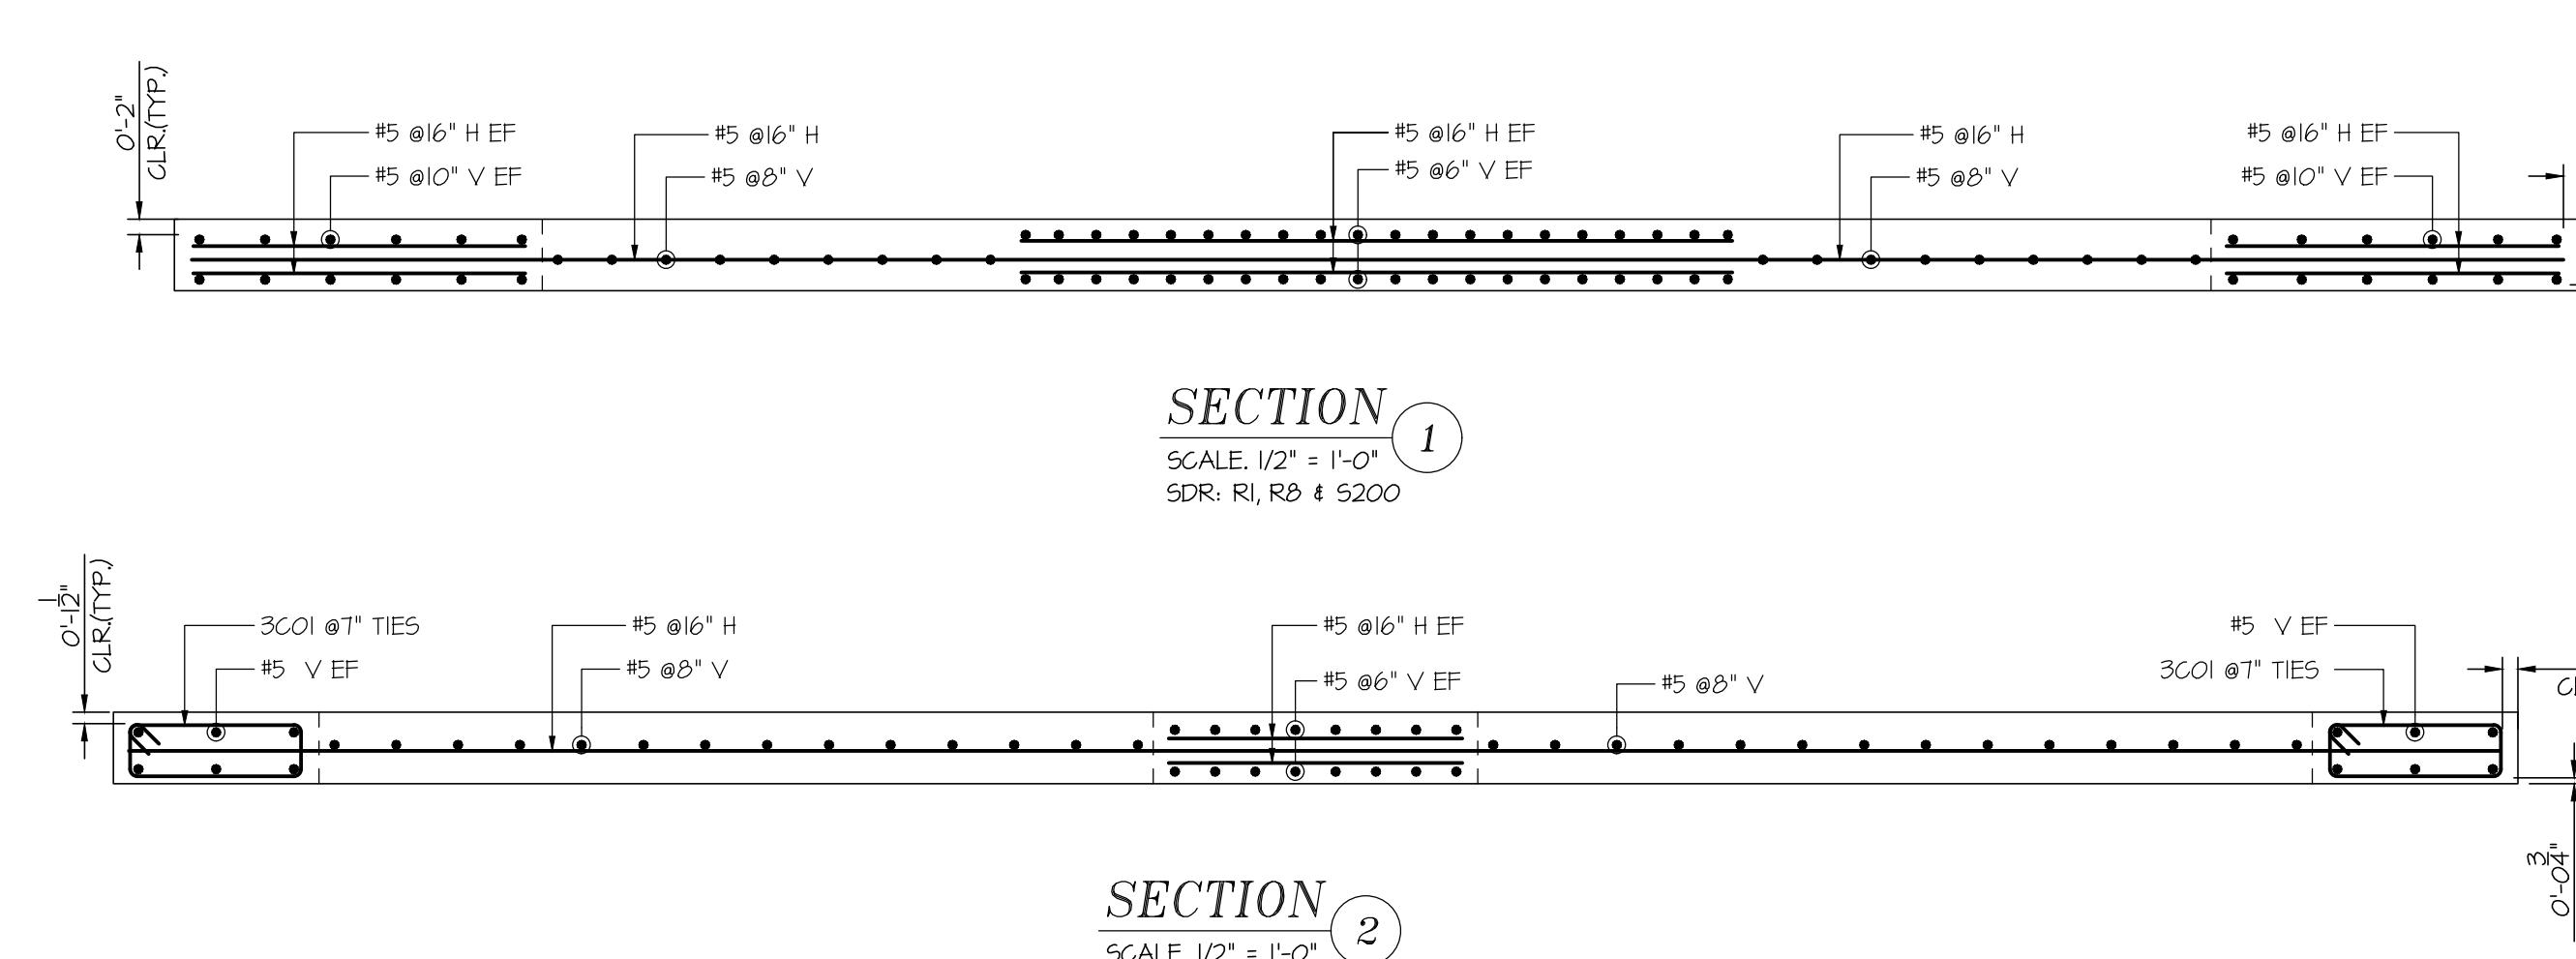


SECTION 1

I
SCALE. 1/2" = 1'-0"
SDR: R1 R8 & S200


SECTION

SCALE. 1/2" = 1'-0" 2

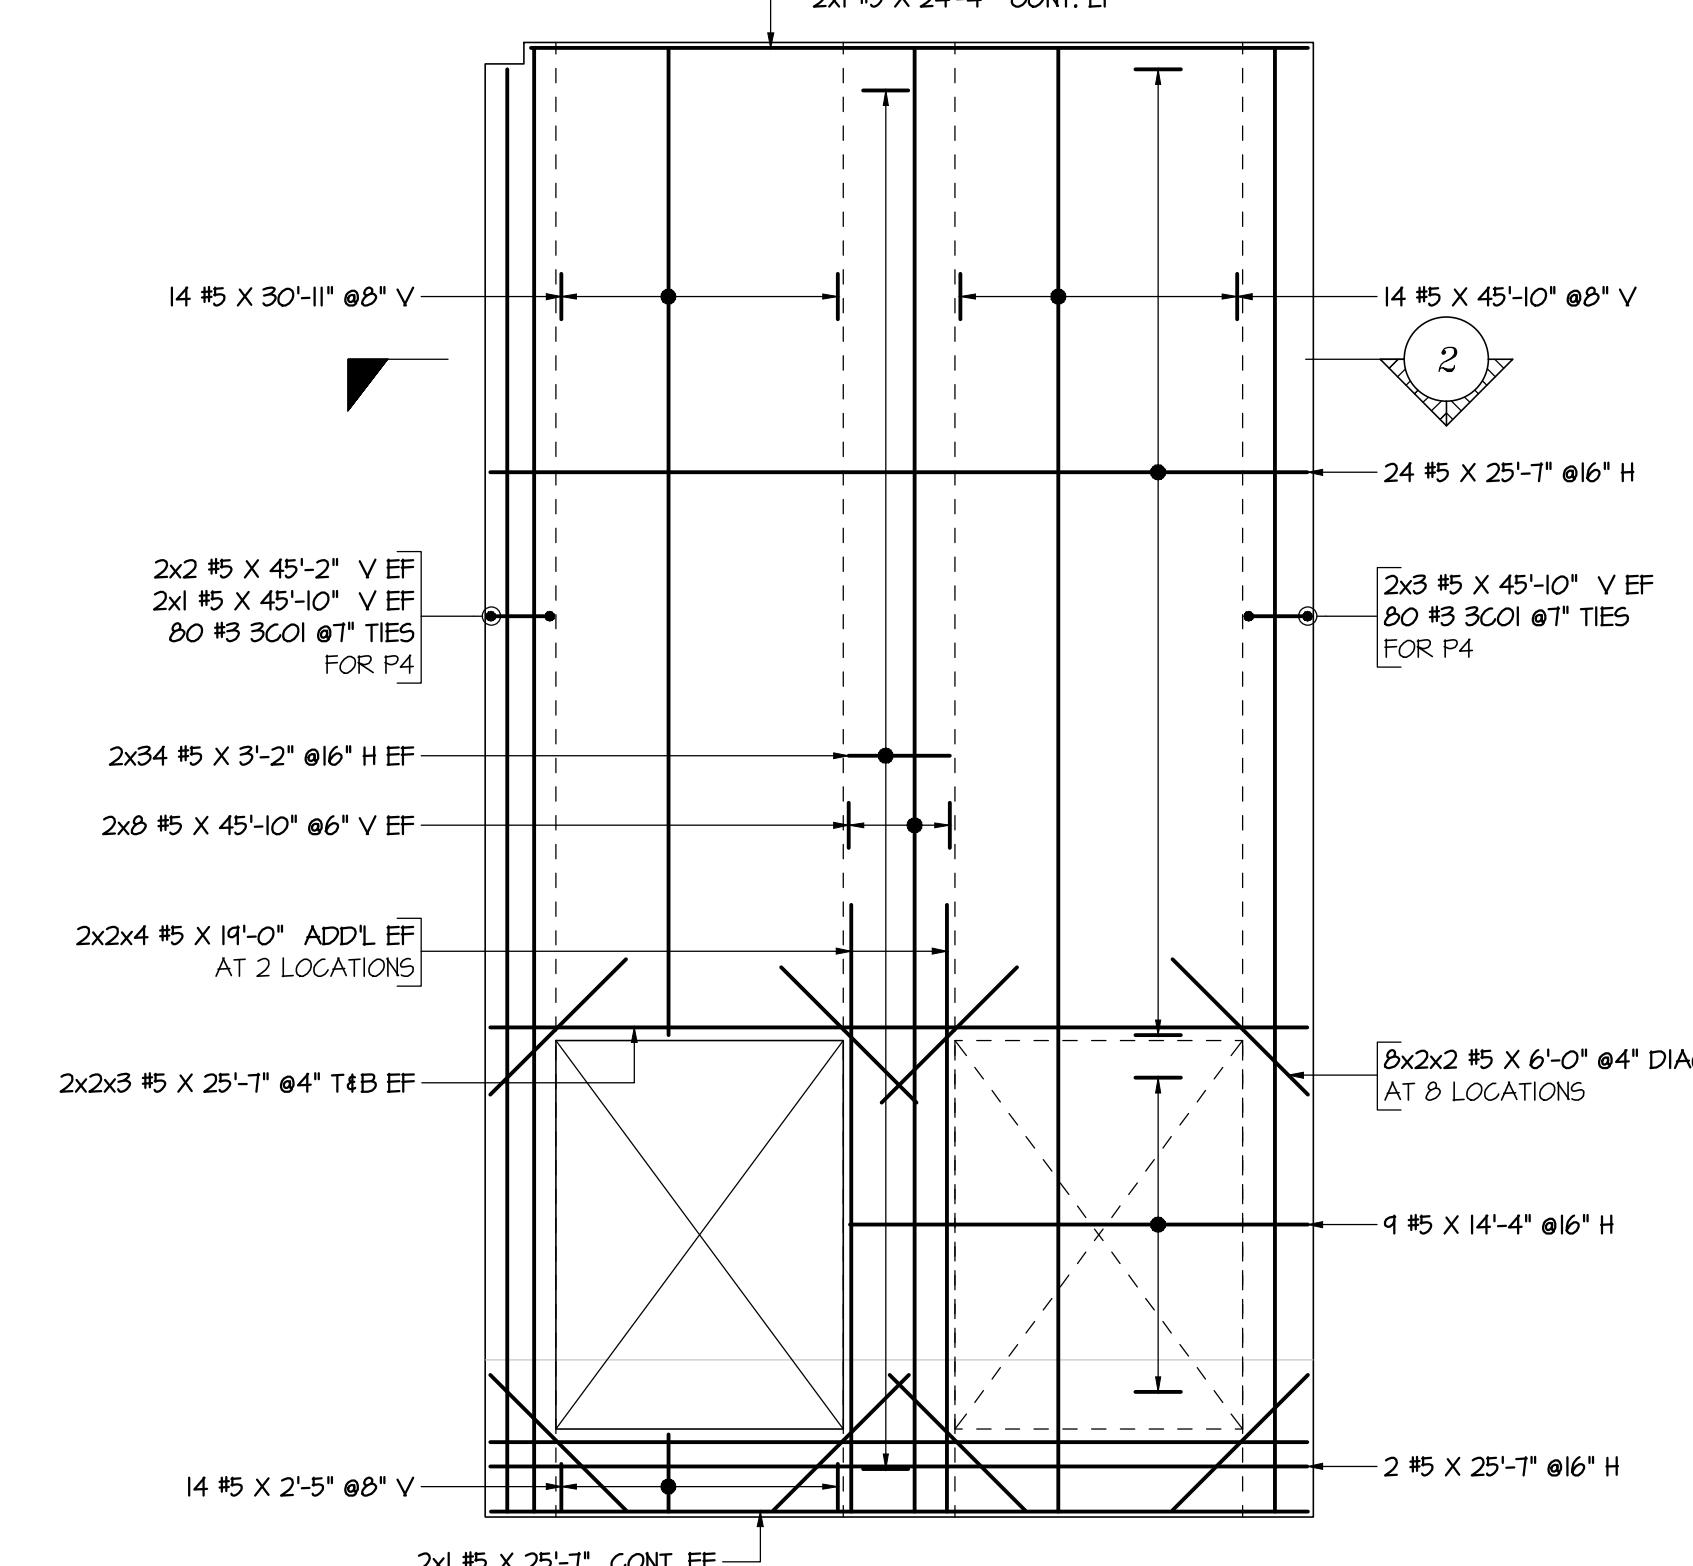


WALL PANEL - N3

SCALE. 1/6" = 1'-0"
SDR: R1, R8 & S200
9 1/4" THK WALL

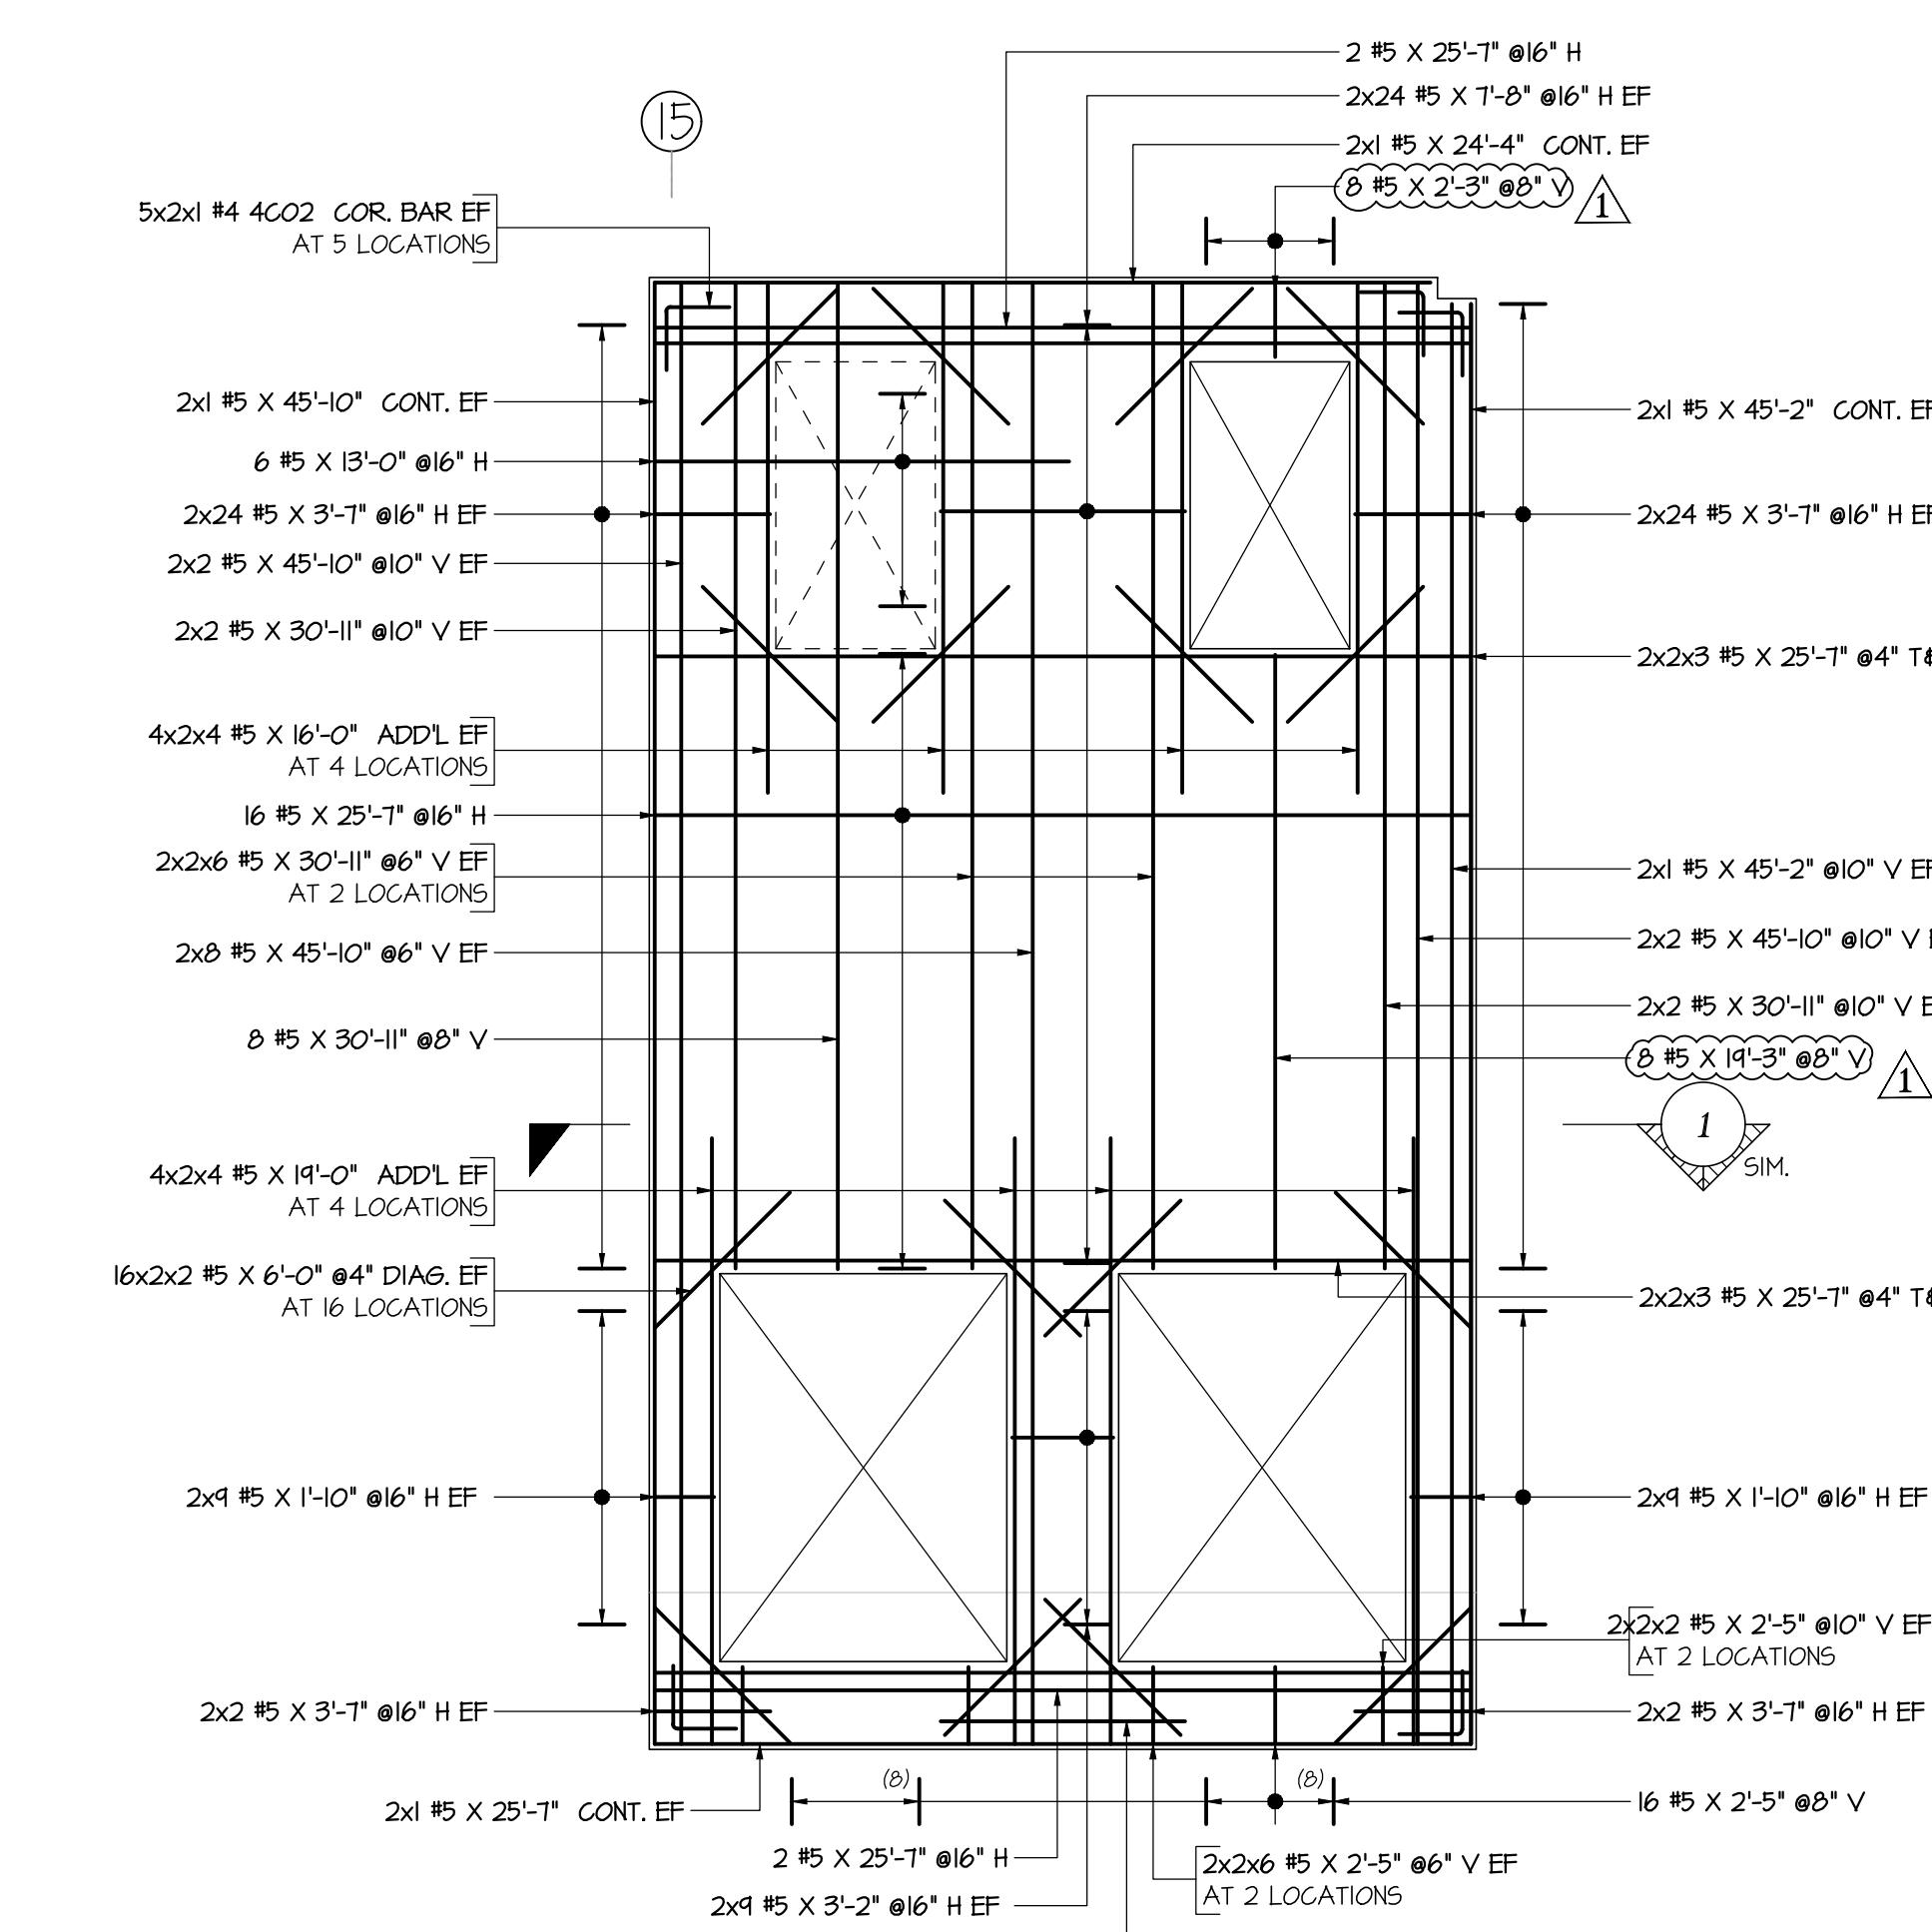


WALL PANEL - N35

SCALE. 1/6" = 1'-0"
SDR: R2, R8 & \$200
9 1/4" THK WALL

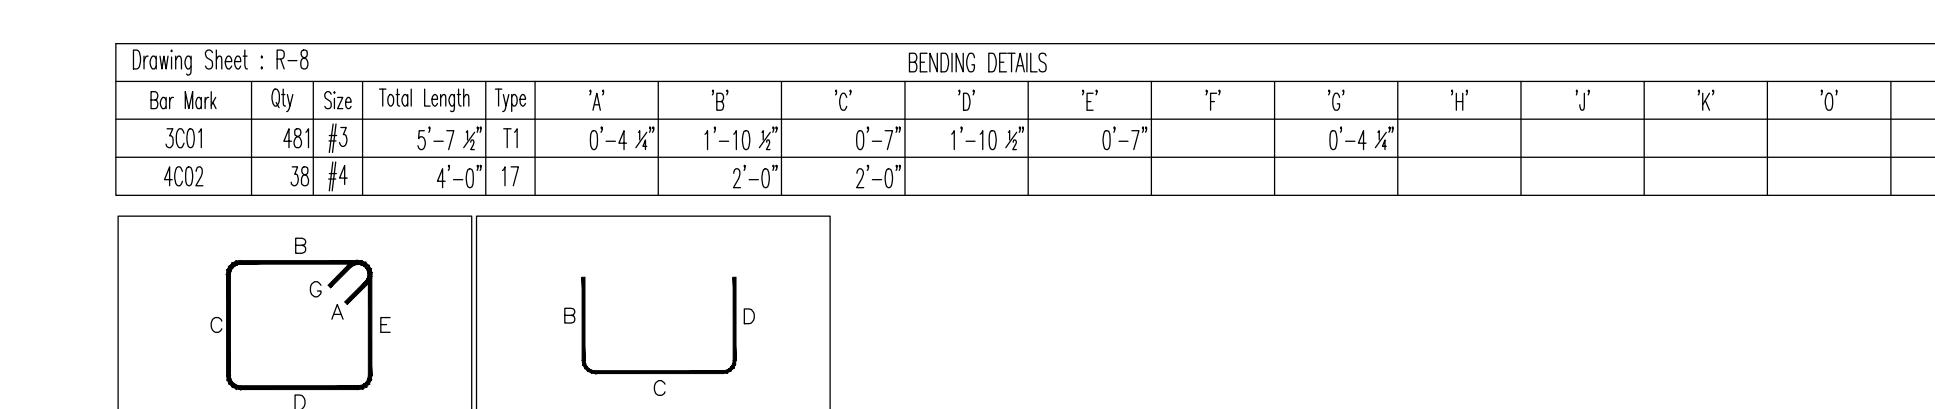


13

SCALE. 1/2" = 1'-0"
S.D.R. P8

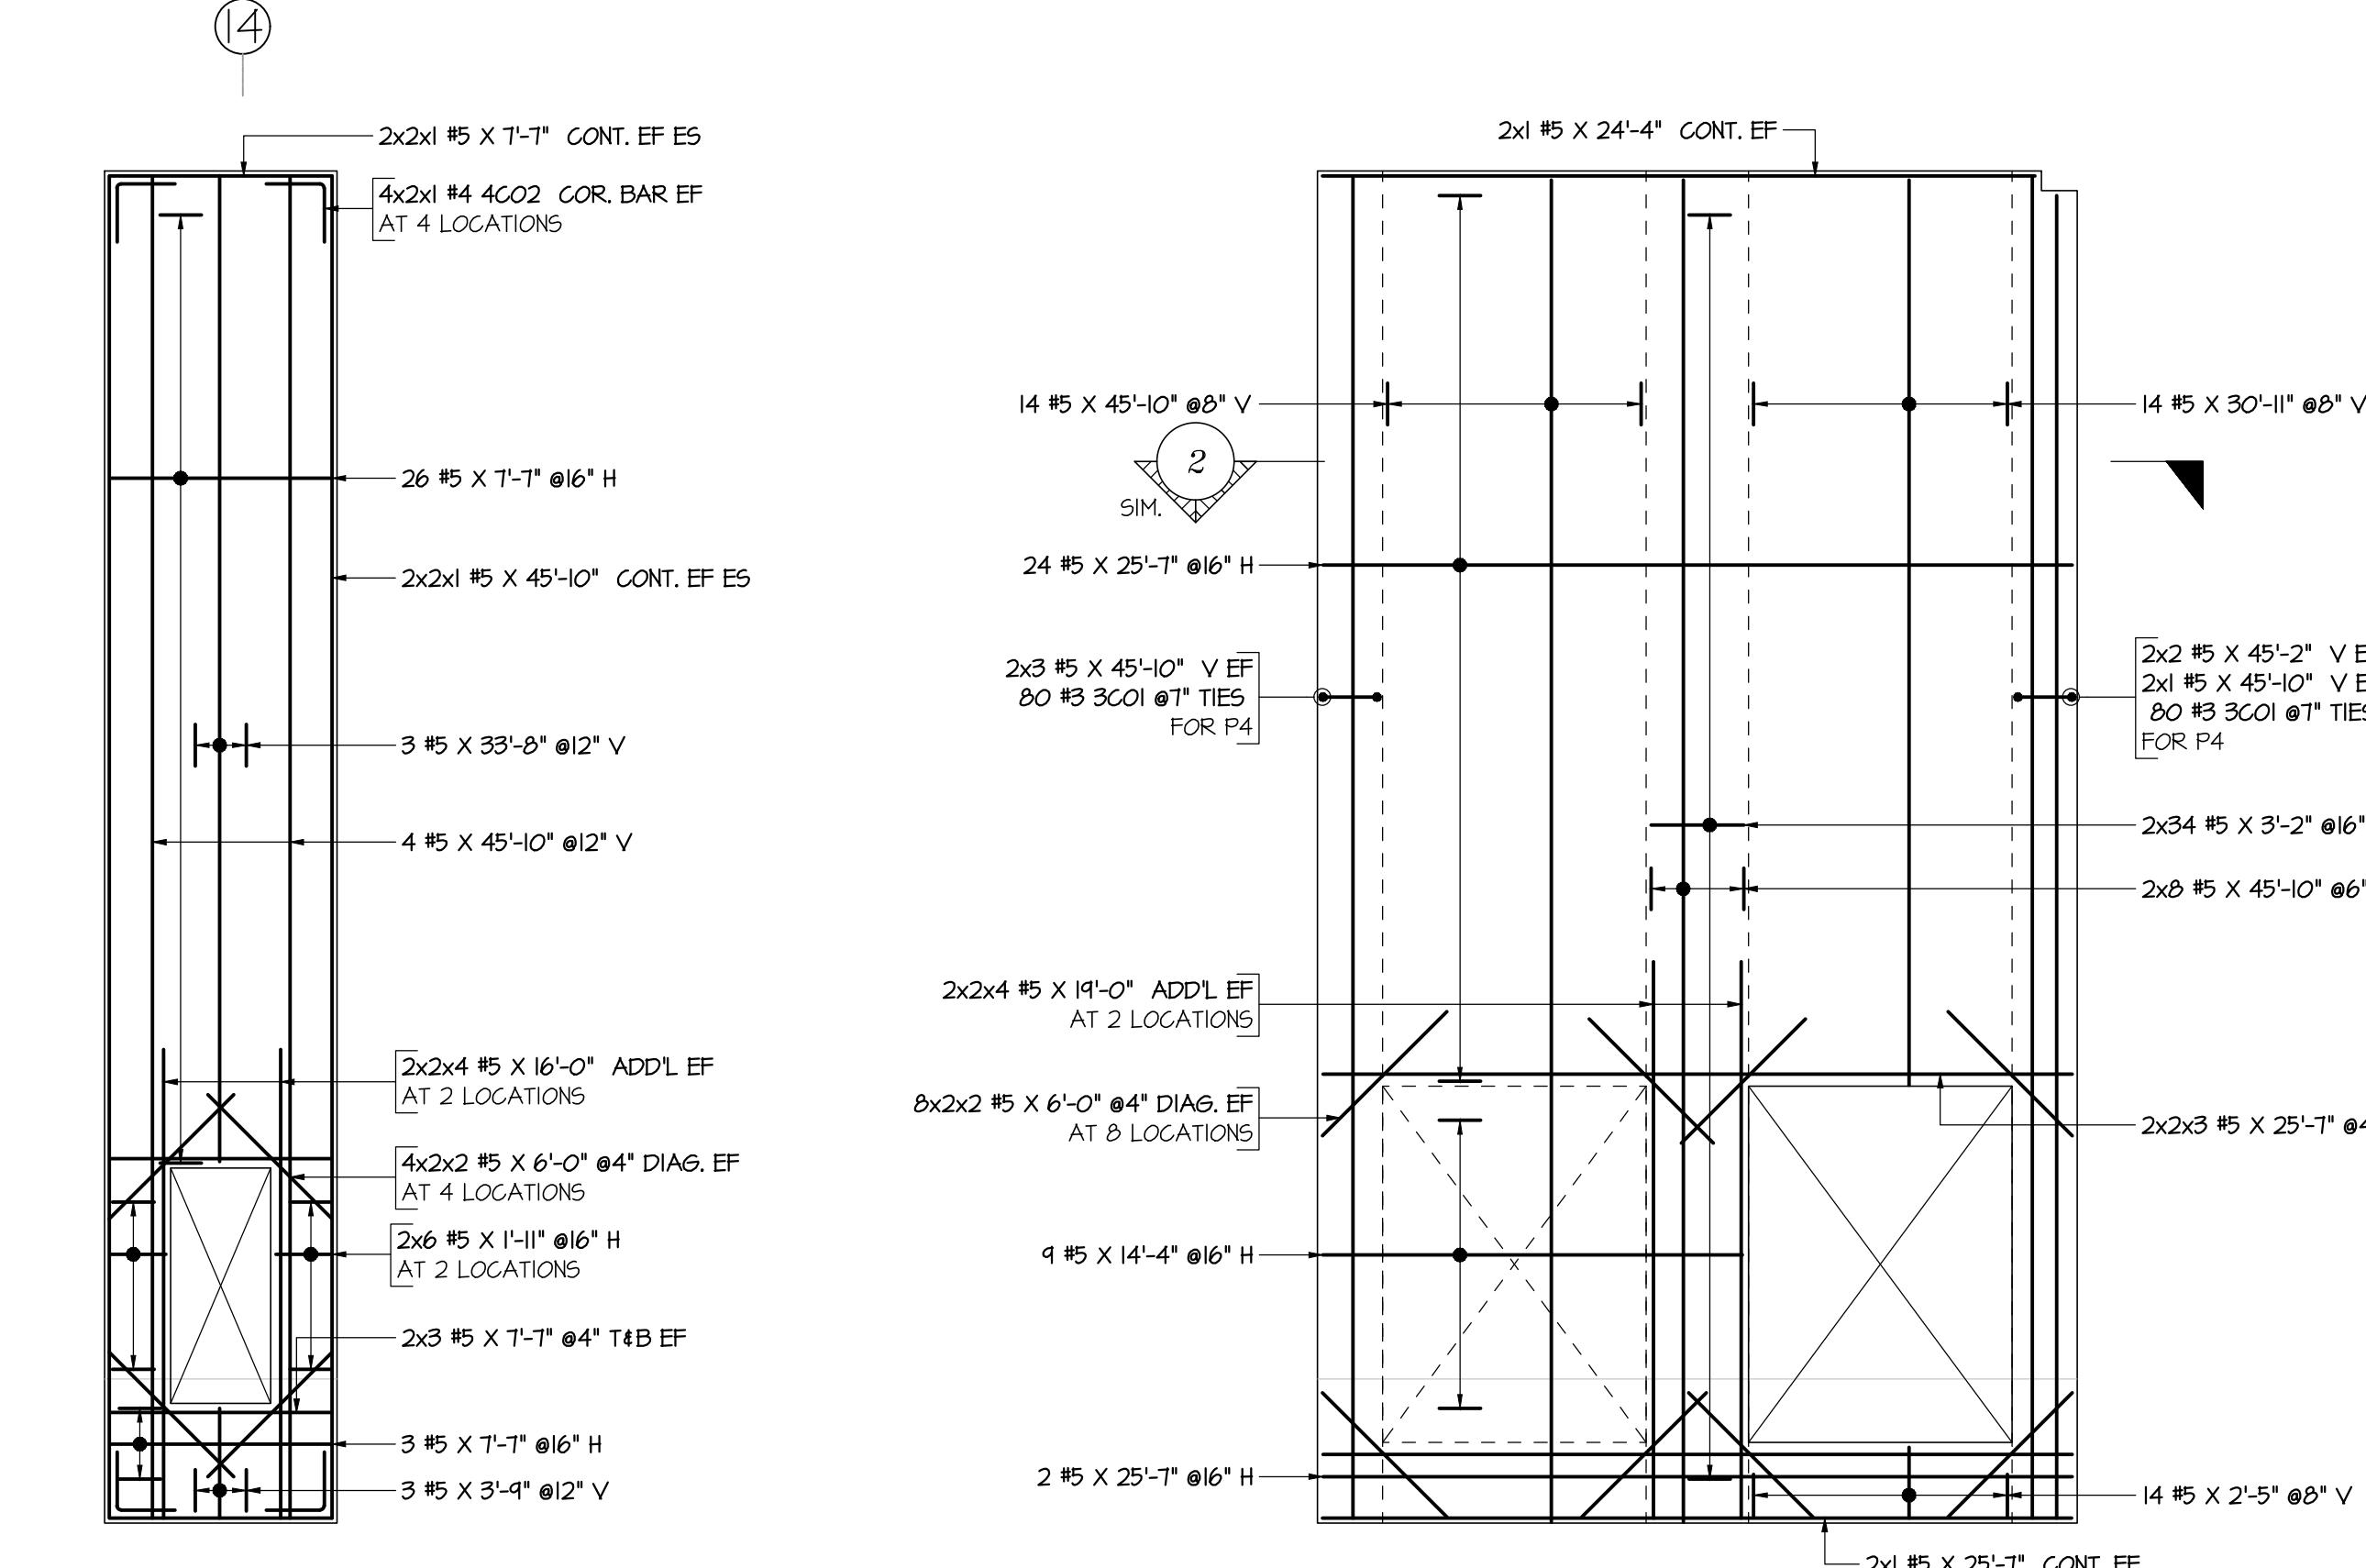


WALL PANEL - N33

SCALE. 1/6" = 1'-0"
SDR: R2, R8 & S200
9 1/4" THK WALL

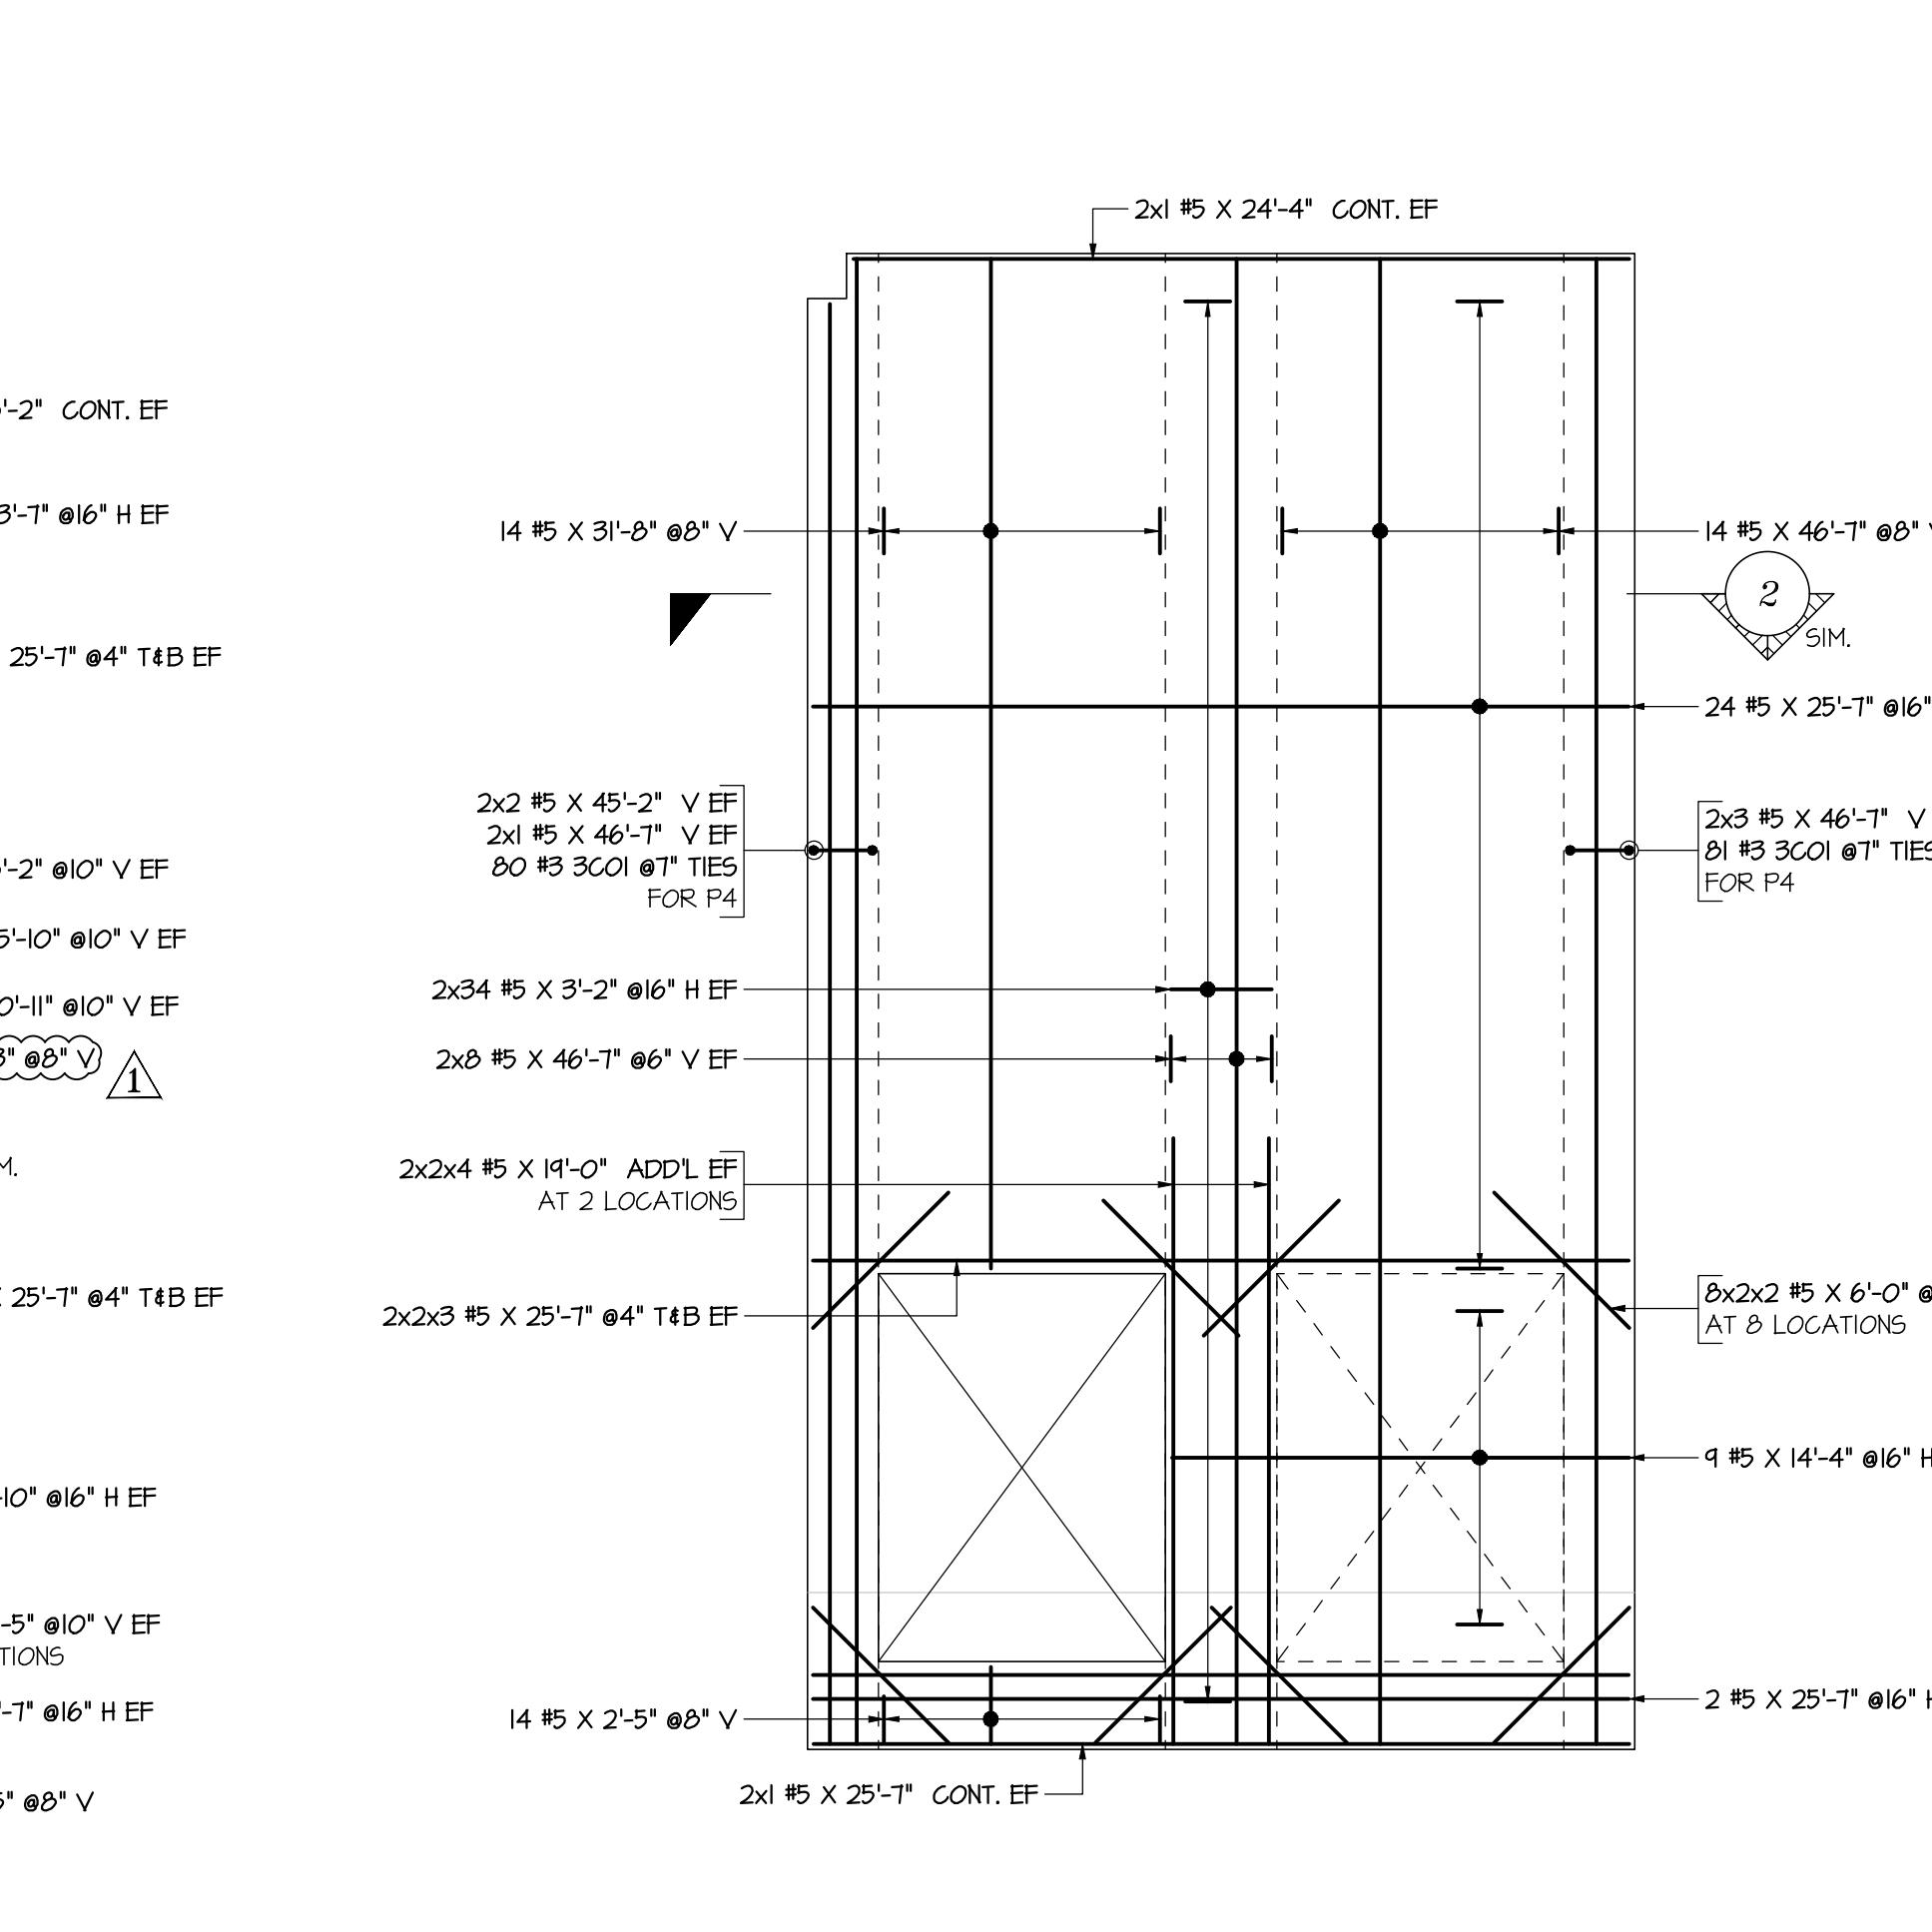

WALL PANEL - N3

SCALE: 1/6" = 1'-0"
SDR: R2, R8 & S200
9 1/4" THK WALL





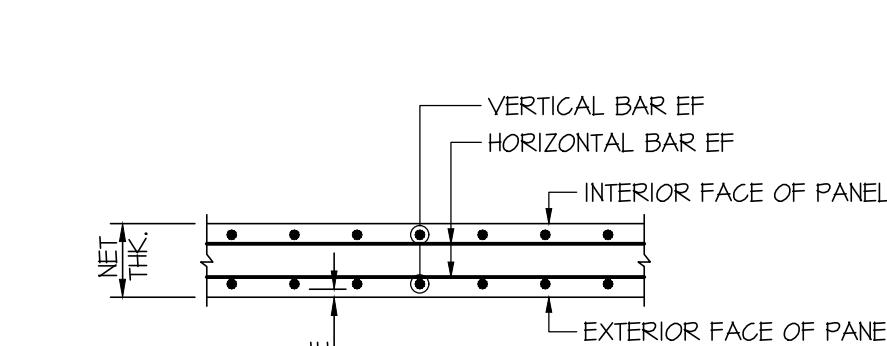



REBAR PLACEMENT FOR DOUBLE LAYER

SCALE. 1/2" = 1'-0"
S.D.P. P.P.

NORTH WALL PANELS
PLACING DRAWING REFERENCE


DWG.NO:	DRAWING DESCRIPTION
R-4	NORTH WALL PANELS N-1 TO N-8
R-5	NORTH WALL PANELS N-9 TO N-15
R-6	NORTH WALL PANELS N-16 TO N-22
R-7	NORTH WALL PANELS N-23 TO N-29
R-8	NORTH WALL PANELS N-30 TO N-36
R-9	NORTH WALL PANELS N-37 TO N-43
R-10	NORTH WALL PANELS N-44 TO N-50
R-11	NORTH WALL PANELS N-51 TO N-58
R-12	NORTH WALL PANELS N-59 TO N-66
R-13	NORTH WALL PANELS N-67 TO N-73
R-14	NORTH WALL PANELS N-74 TO N-81
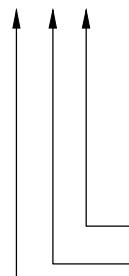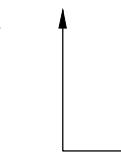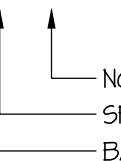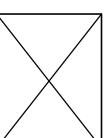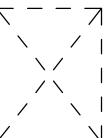
<u>STRUCTURAL NOTES</u>		
<u>LEGENDS</u>	<u>LABEL LEGENDS</u>	
T - TOP		
B - BOTTOM		
V, VERT - VERTICAL		
H, HORIZ - HORIZONTAL		
CLR. - CLEAR COVER	6x2x6 #4 4C09 @12" B2	
SIM. - SIMILAR		
TYP. - TYPICAL		
T.O.MAT - TOP OF MAT		
ES - EACH SIDE		
EF - EACH FACE		
CONT - CONTINUOUS		
COR. - CORNER		
THK. - THICKNESS		
ADD'L - ADDITIONAL		
DIAG. - DIAGONAL		
NTS - NOT TO SCALE		
¢ - CENTER LINE		
SDR - STRUCTURAL DRAWING REFERENCE		
<u>CLEAR COVER TO REINFORCEMENT</u>		
WALL PANEL	2"	AT ENDS
	1 1/2"	#5 & BELOW AT EXTERIOR FACE
	2"	#6 & ABOVE AT EXTERIOR FACE
	3/4"	AT INTERIOR FACE

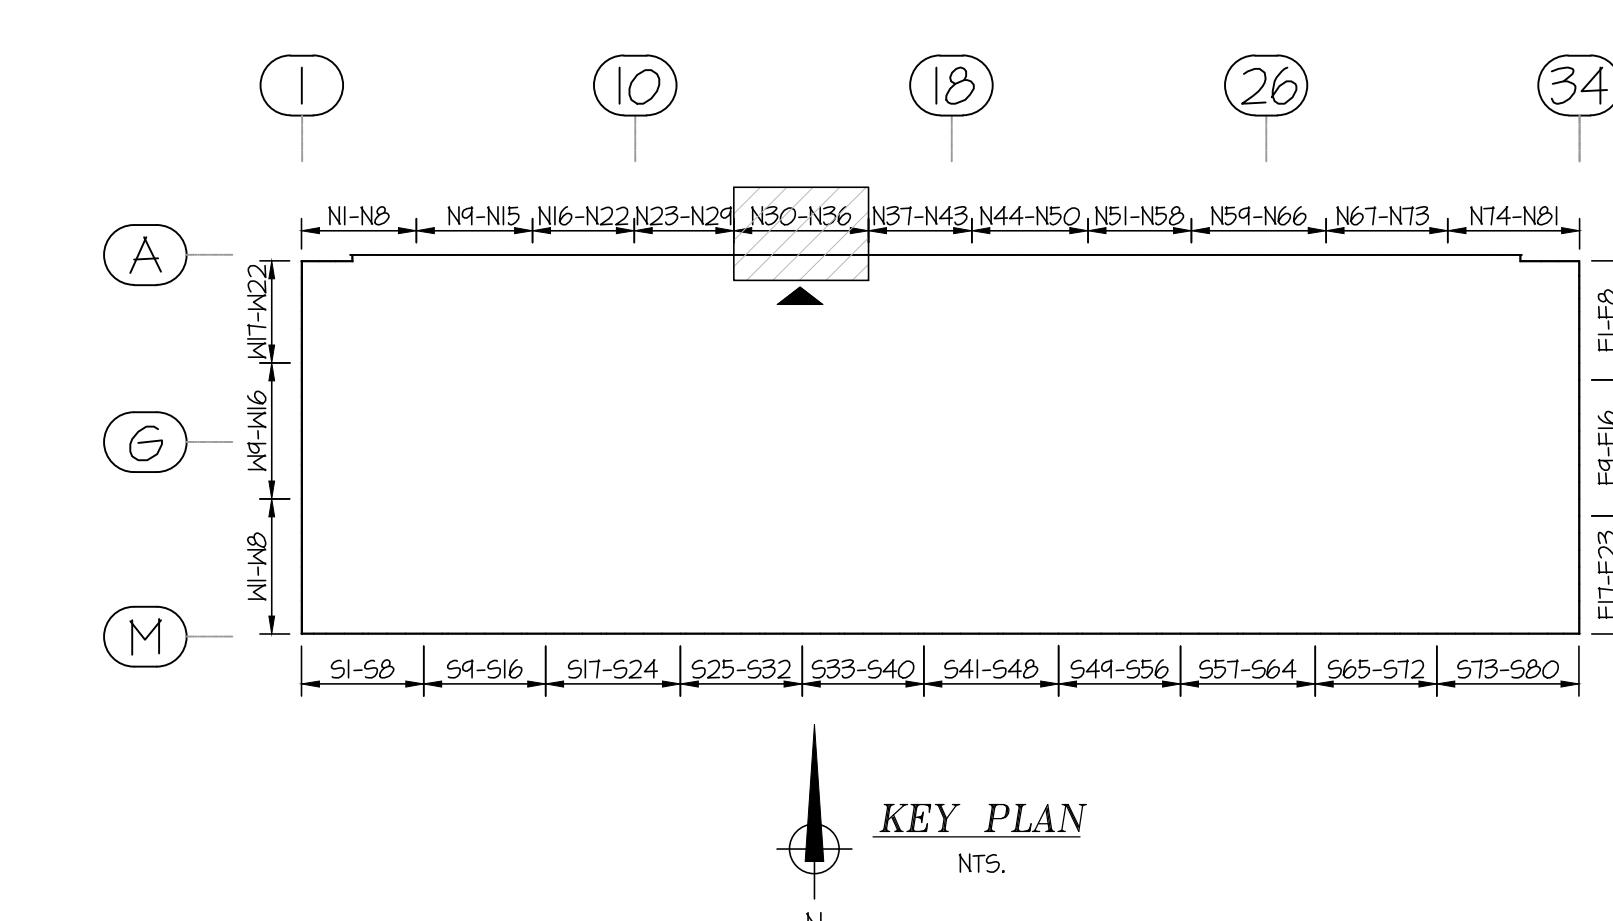

REINFORCING STEEL PLACING DRAWING ONLY. USE IN
CONJUNCTION WITH CONTRACT DRAWINGS & SPECIFICATIONS.
NOTATIONS & DIMENSIONS SHOWN ON THIS DRAWING ARE FOR
DETAILING PURPOSES ONLY AND SHOULD NOT BE USED FOR
CONSTRUCTION UNLESS VERIFIED BY ENGINEER OR CONTRACTOR.


7		
6		
5		
4		
3		
2	06.10.2019	RE SUBMITTED FOR APPROVAL
1	05.24.2019	APPROVAL
	DATE	SENT FOR
RE-STEEL		SUPPLY CO., INC.
REINFORCING STEEL - WIRE MESH		
		
2000 Eddystone Industrial Park • Eddystone, PA 19022-1588		
Phone: 800-876-8216 • Fax: 610-876-8428		
Structure	VALLEY VIEW BUSINESS PARK TILT PANELS	
Location	JESSUP,PA	
Architect	KSS ARCHITECTS	
Engineer	RICHARD ADAMS	
Customer	T&T CONSTRUCTION	
Made by: PRO	Date: 05.24.2019	CONTRACT NO. U2524
DRAWING COVERS NORTH WALL PANELS N-30 TO N-36		DRAWING NO. R-8

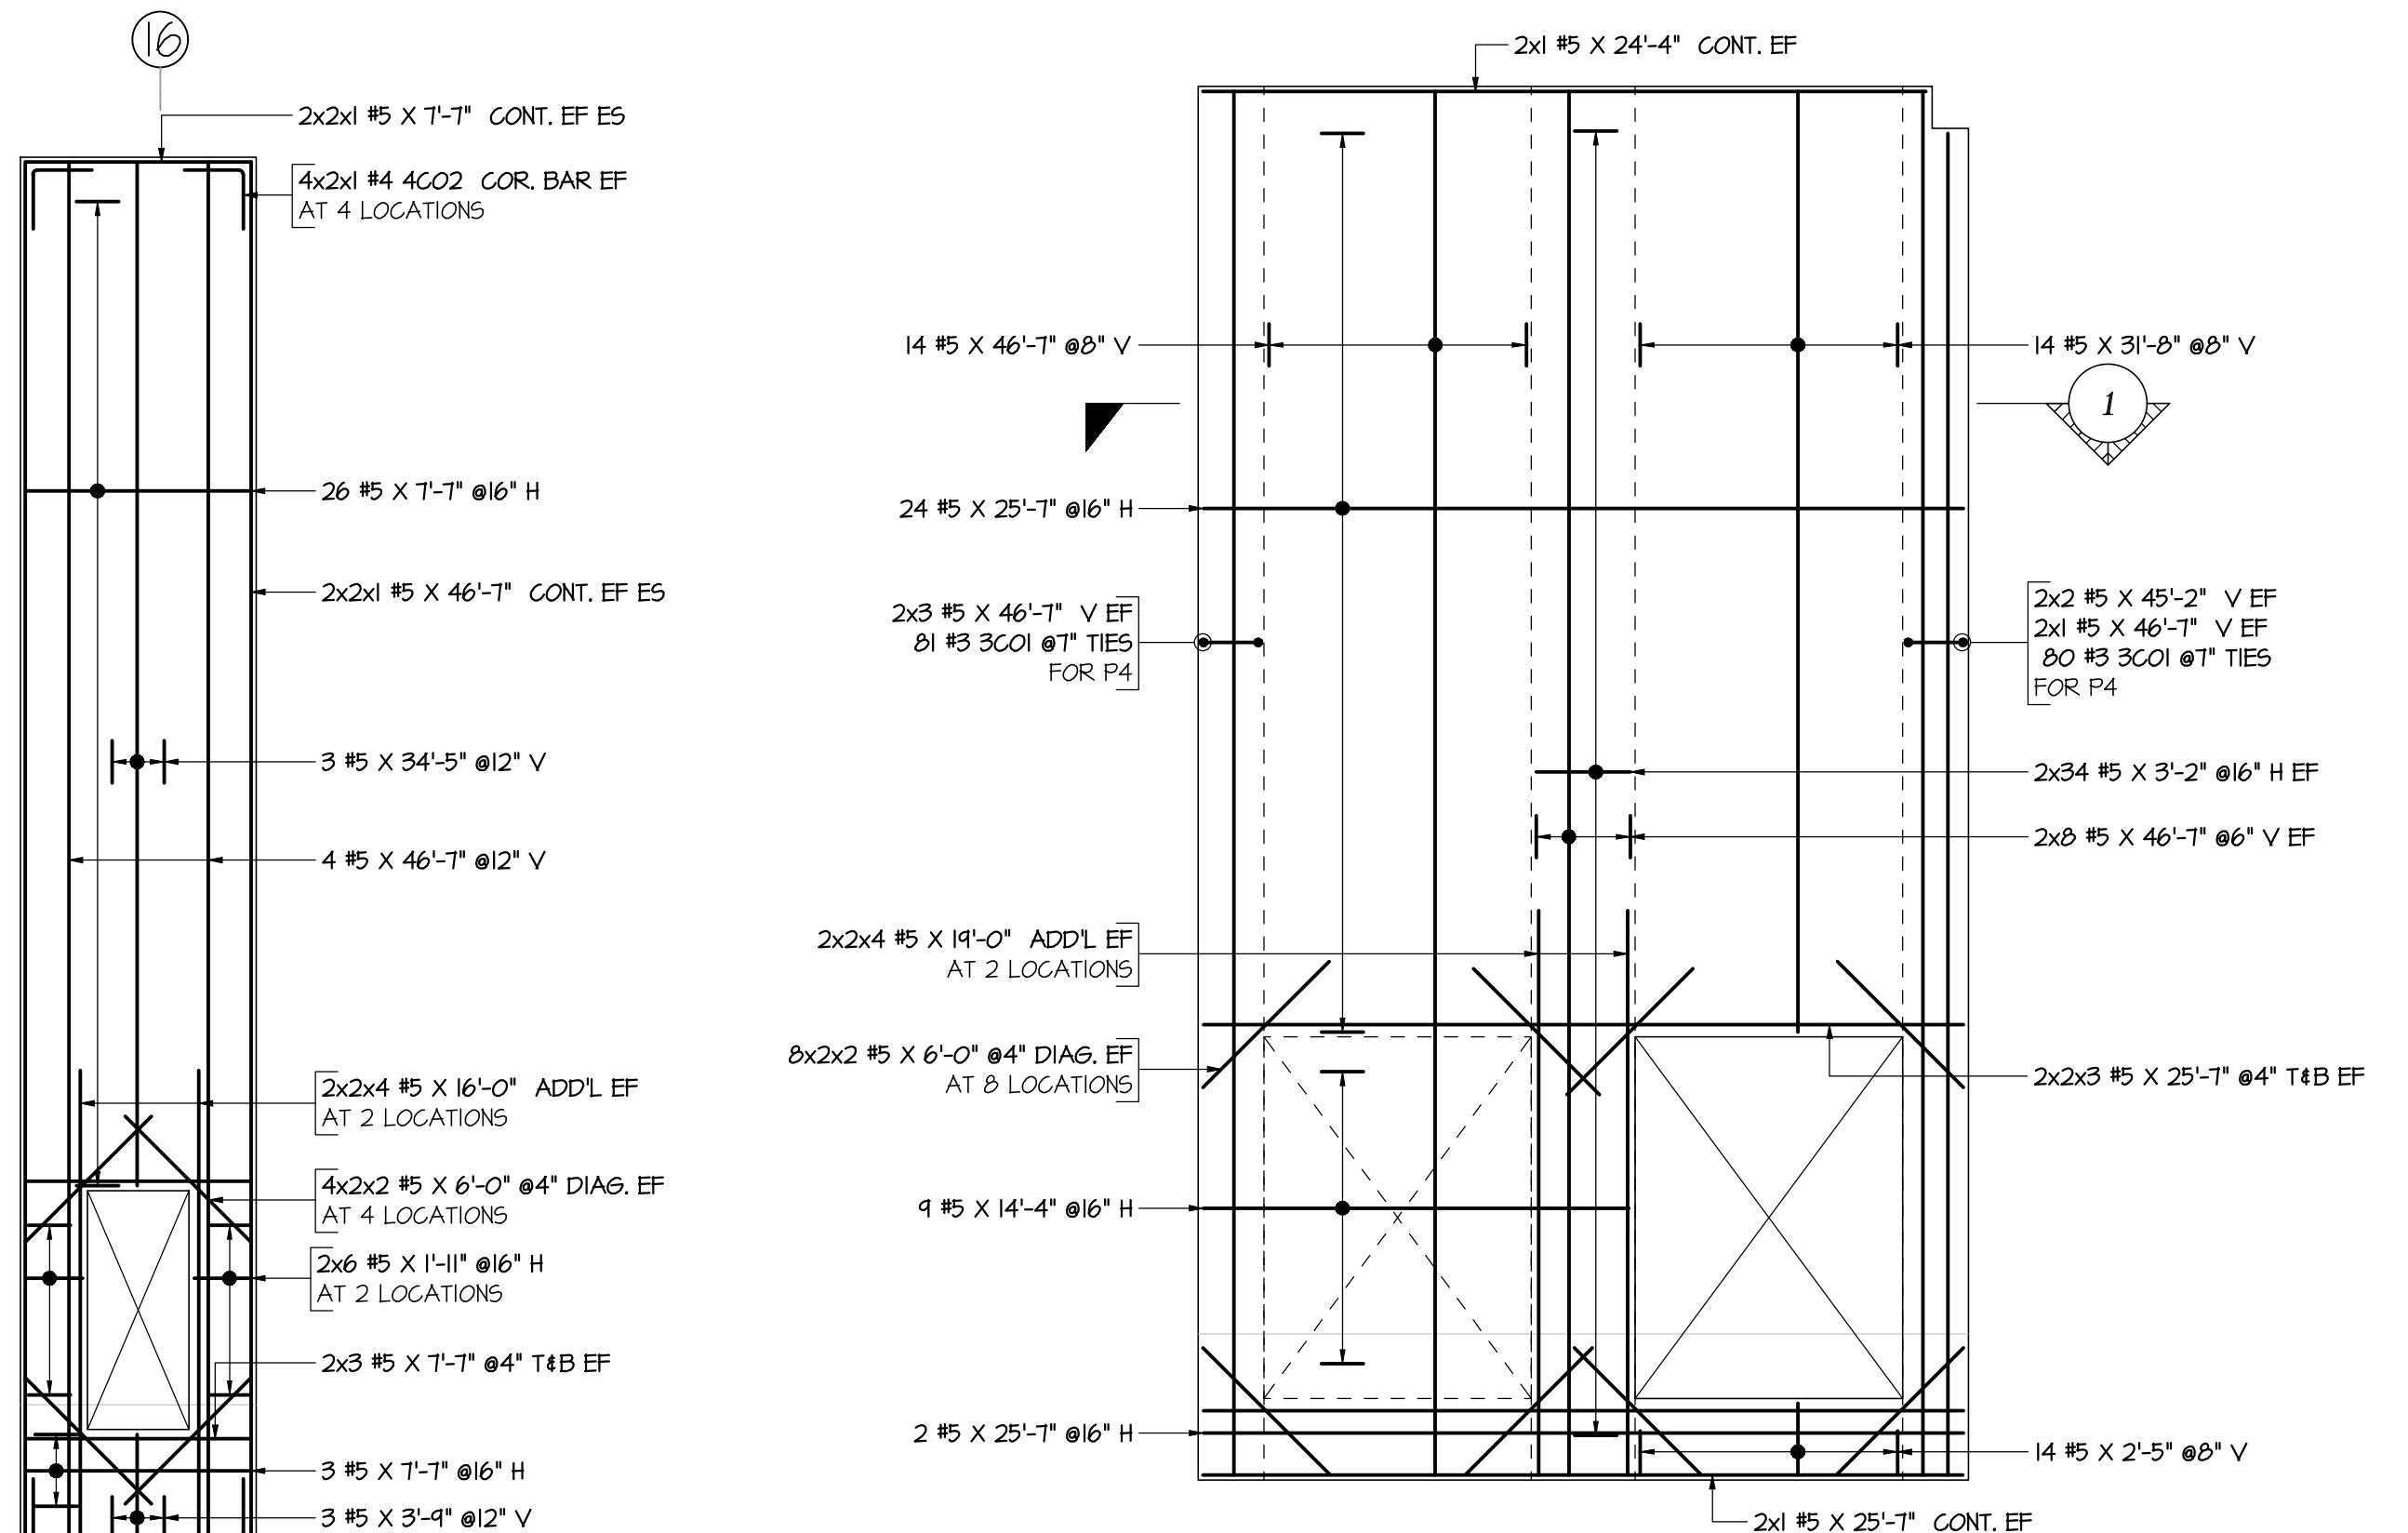

WALL PANEL - N37

SCALE. 1/6" = 1'-0"
SDR: R2, R8 & S200
9 1/4" THK WALL

SCALE. 1/6" = 1'-0"
SDR: R2, R8 & S200
[9 1/4" THK WALL]

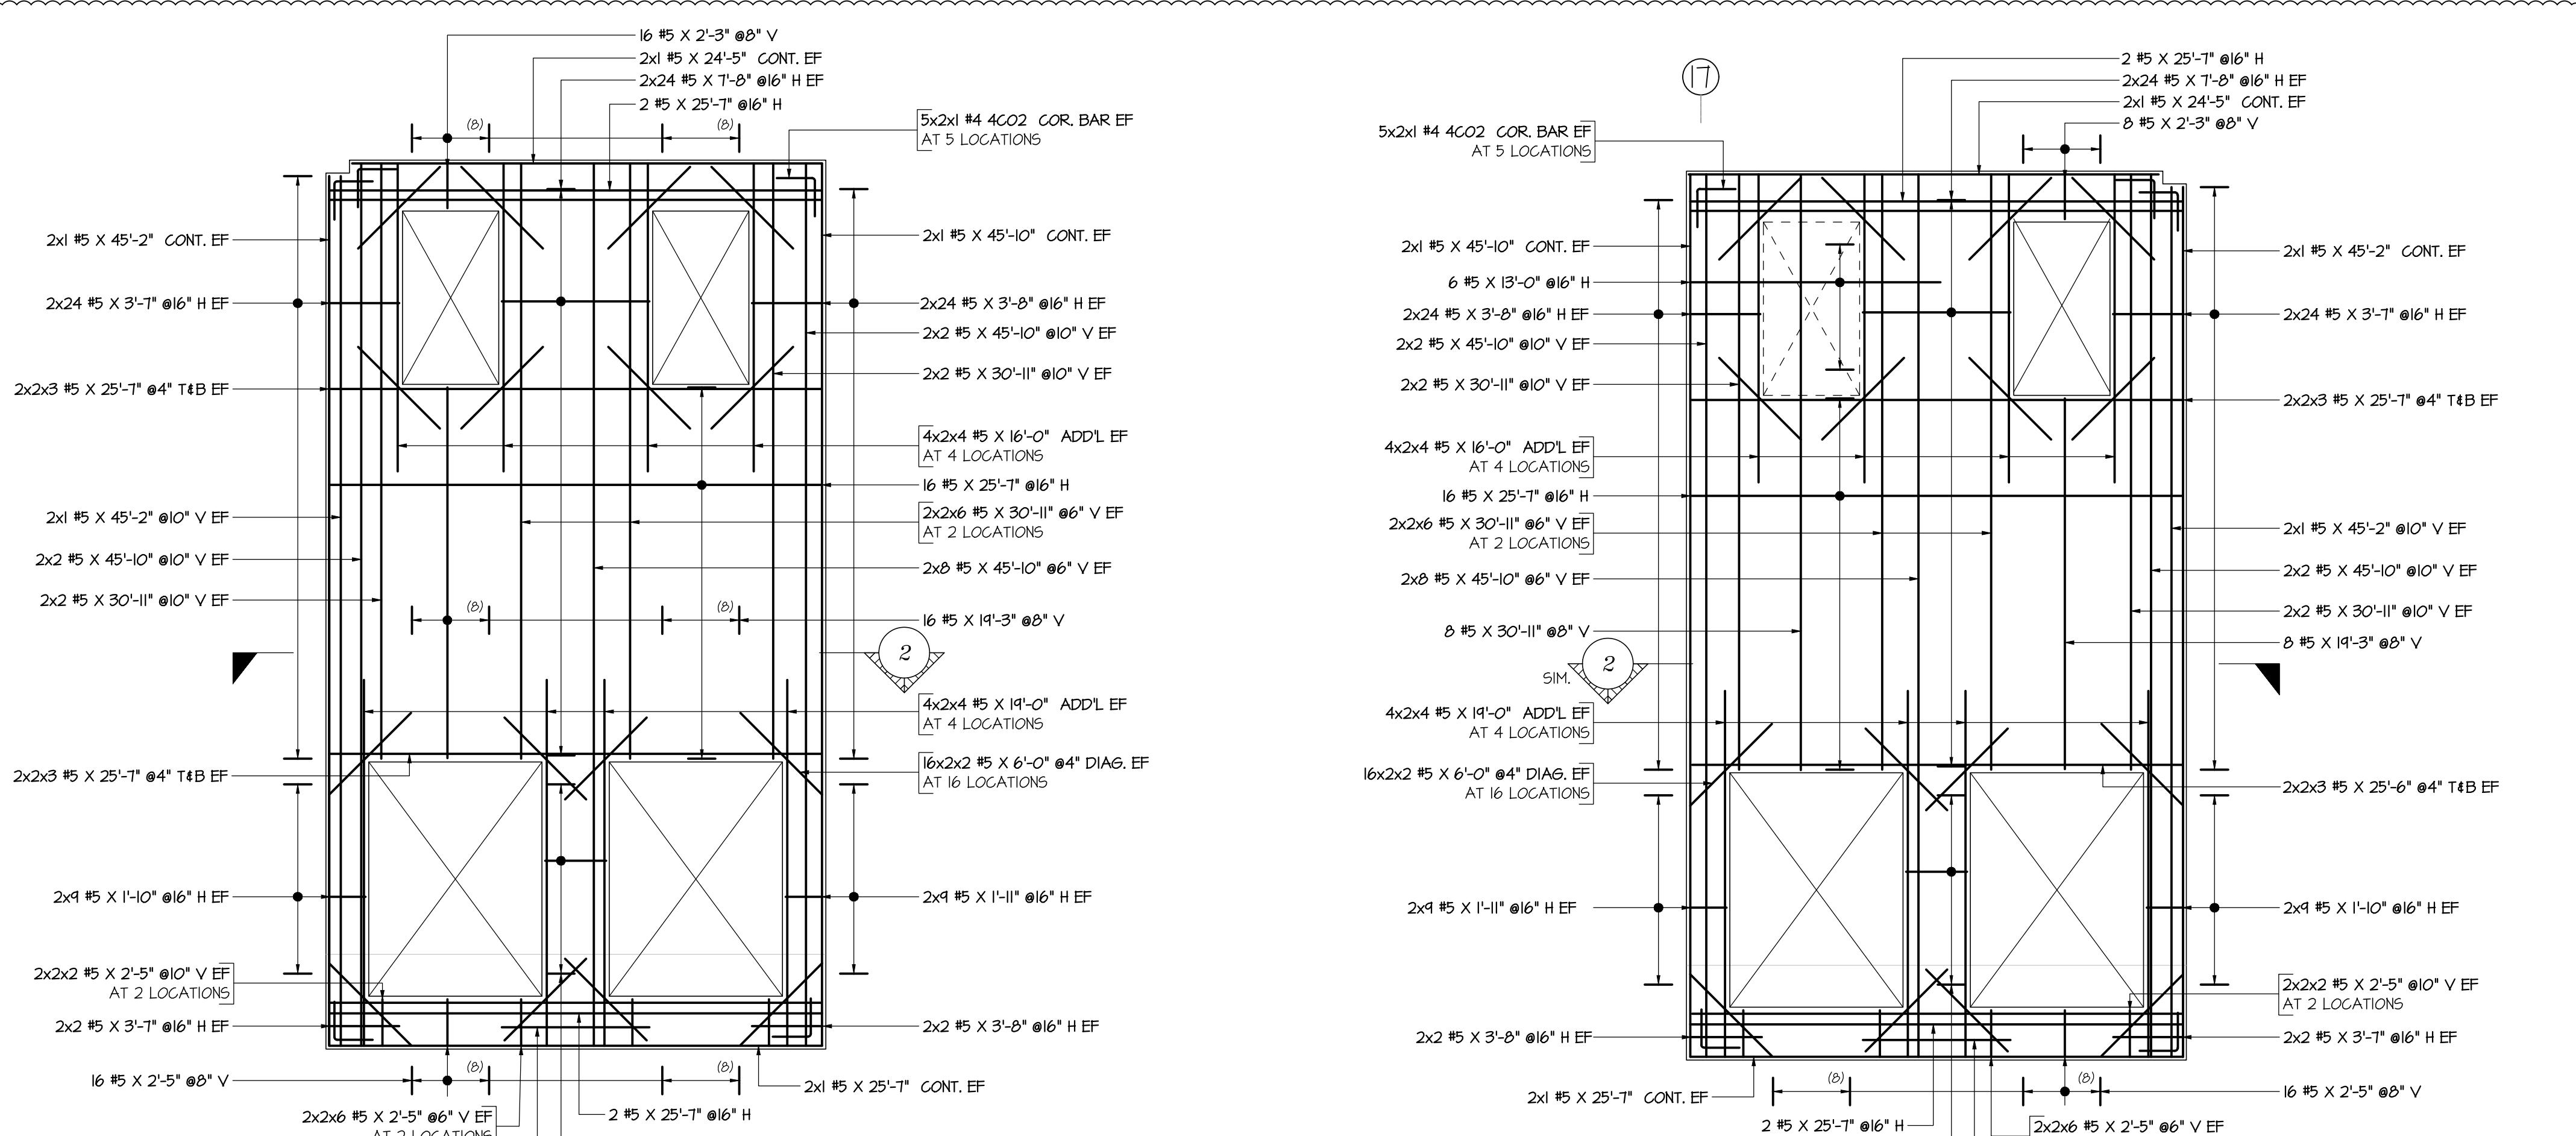


WALL PANEL - N38

SCALE. 1/6" = 1
SDR: R2, R8 & S
[9 1/4" THK WA]



WALL PANEL - N39


SCALE: 1/8" = 1-0
SDR: R2, R8 & \$200
9 1/4" THK WALL

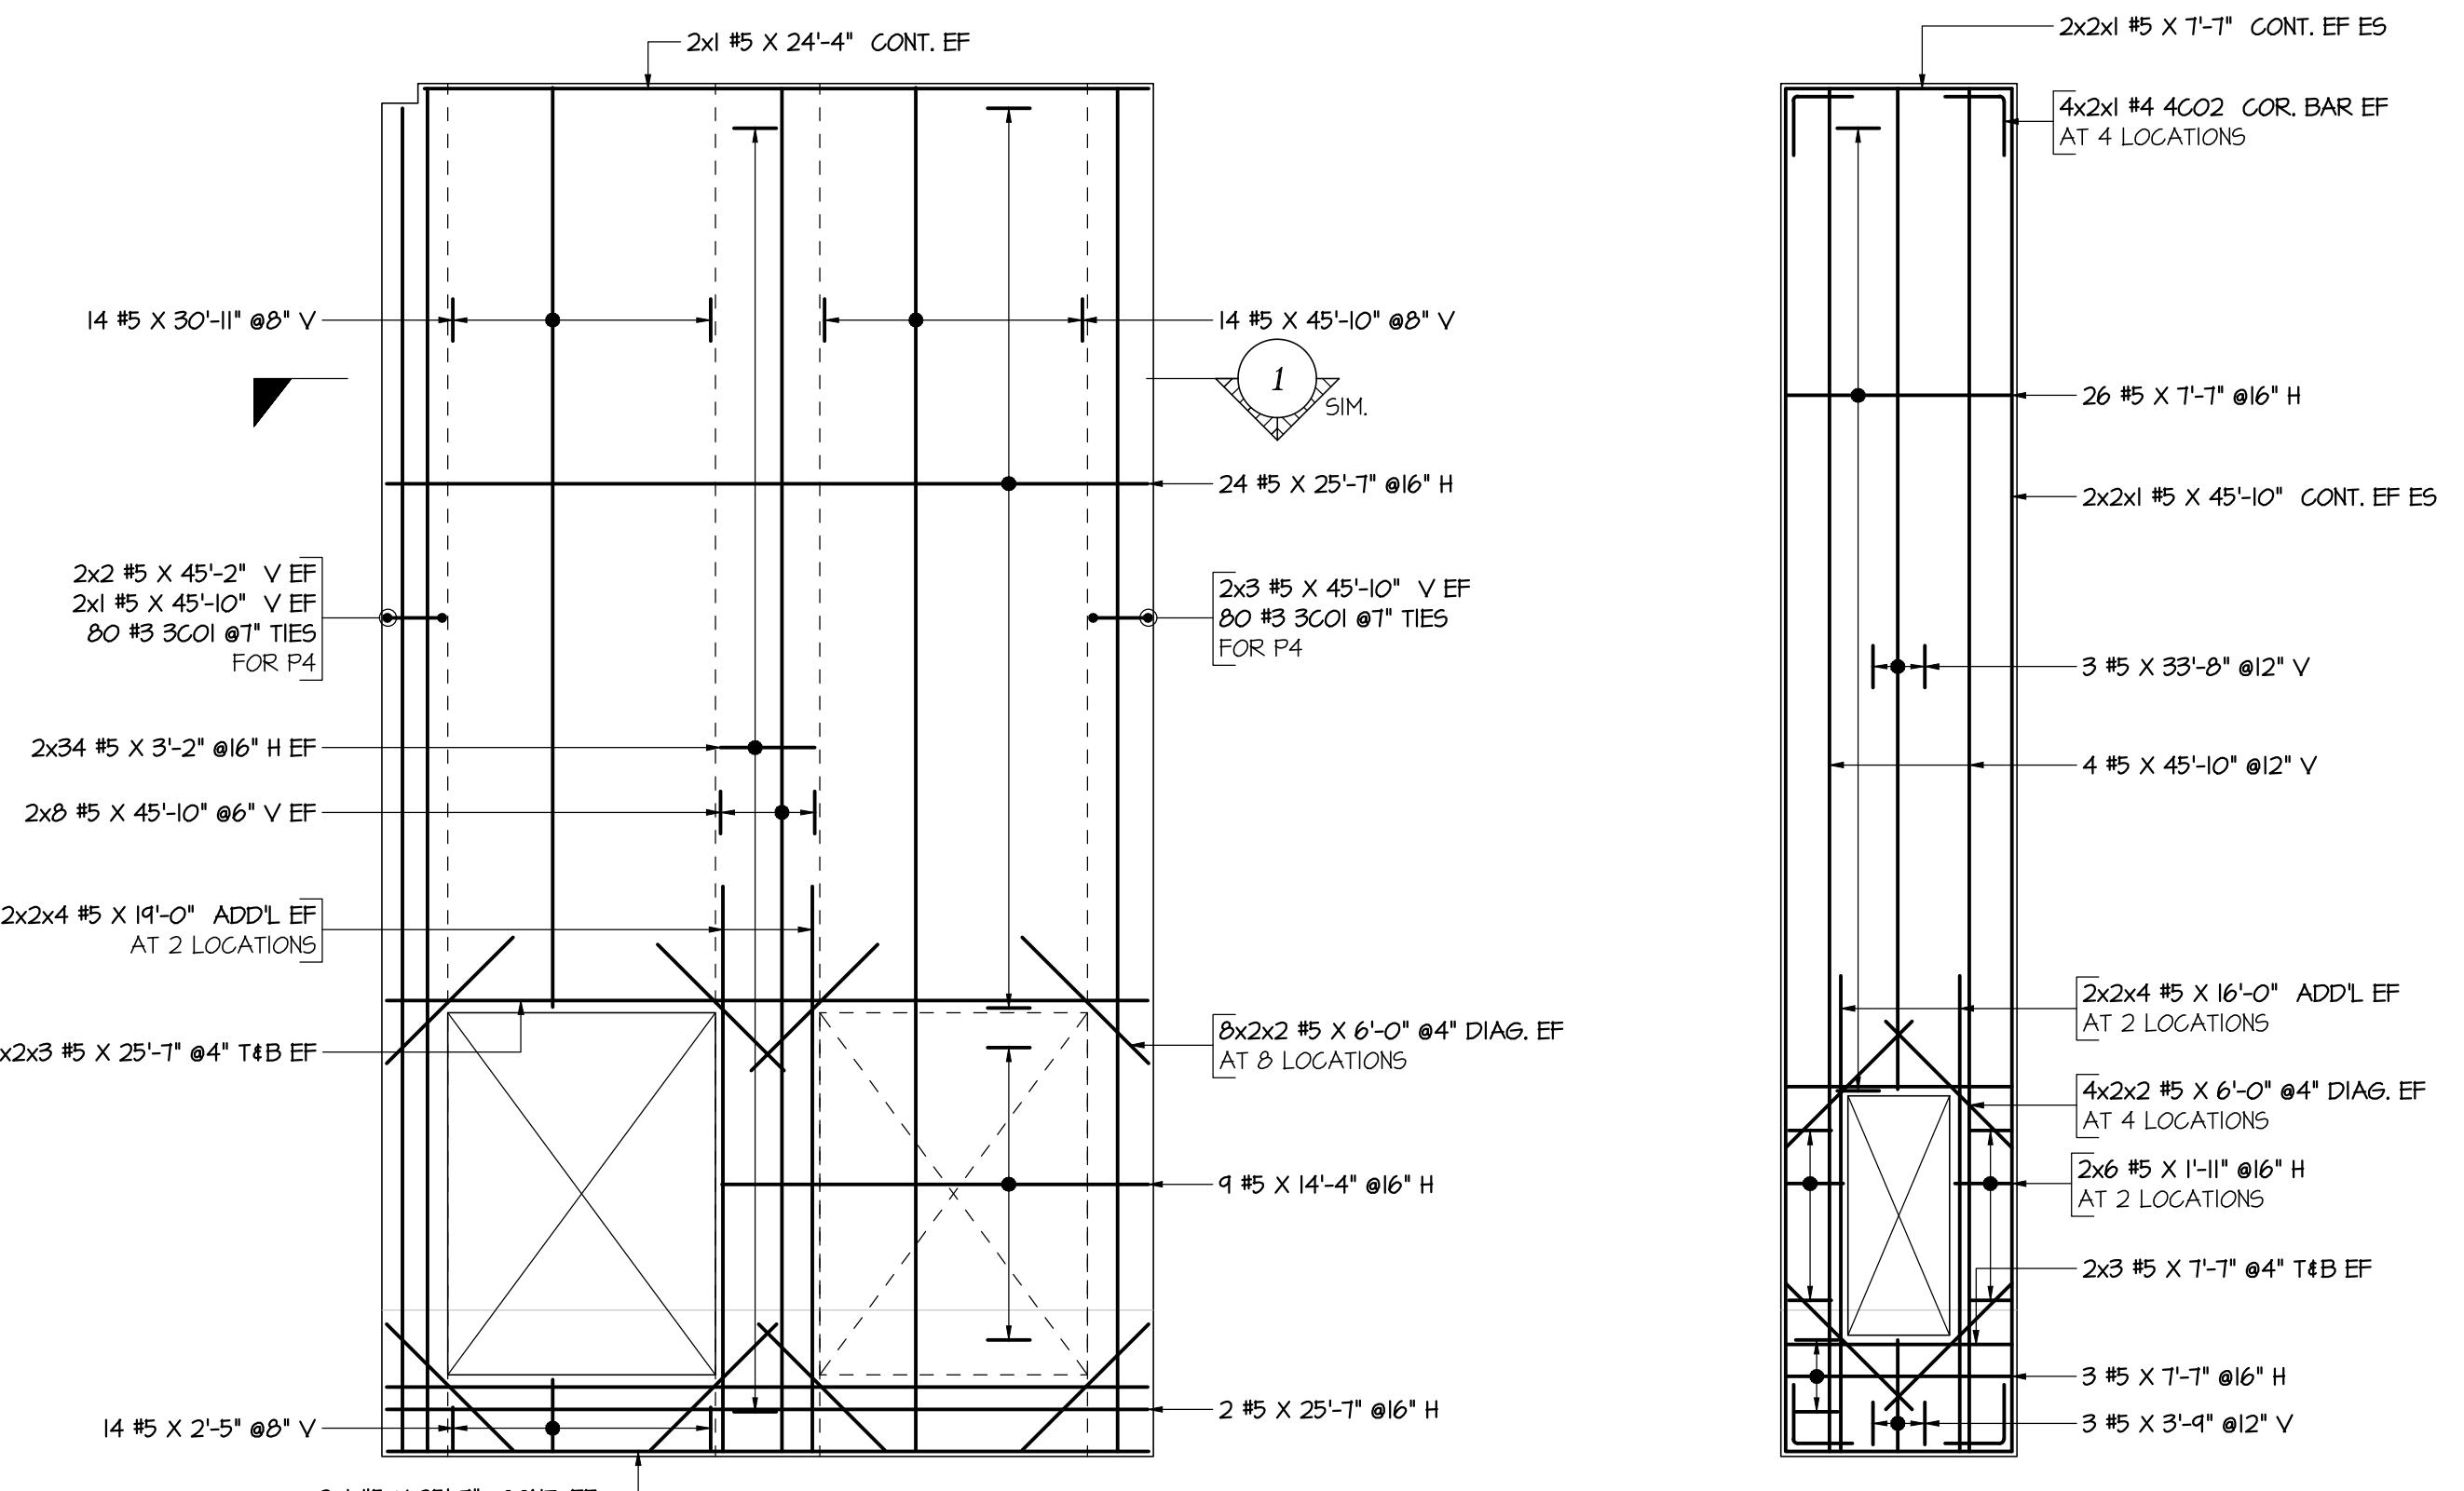

WALL PANEL - N41


SCALE. 1/6" = 1'-0"
SDR: R2, R8 \$ 5200
[9 1/4" THK WALL]

**SDR: R2, R8 & S200
9 1/4" THK WALL**

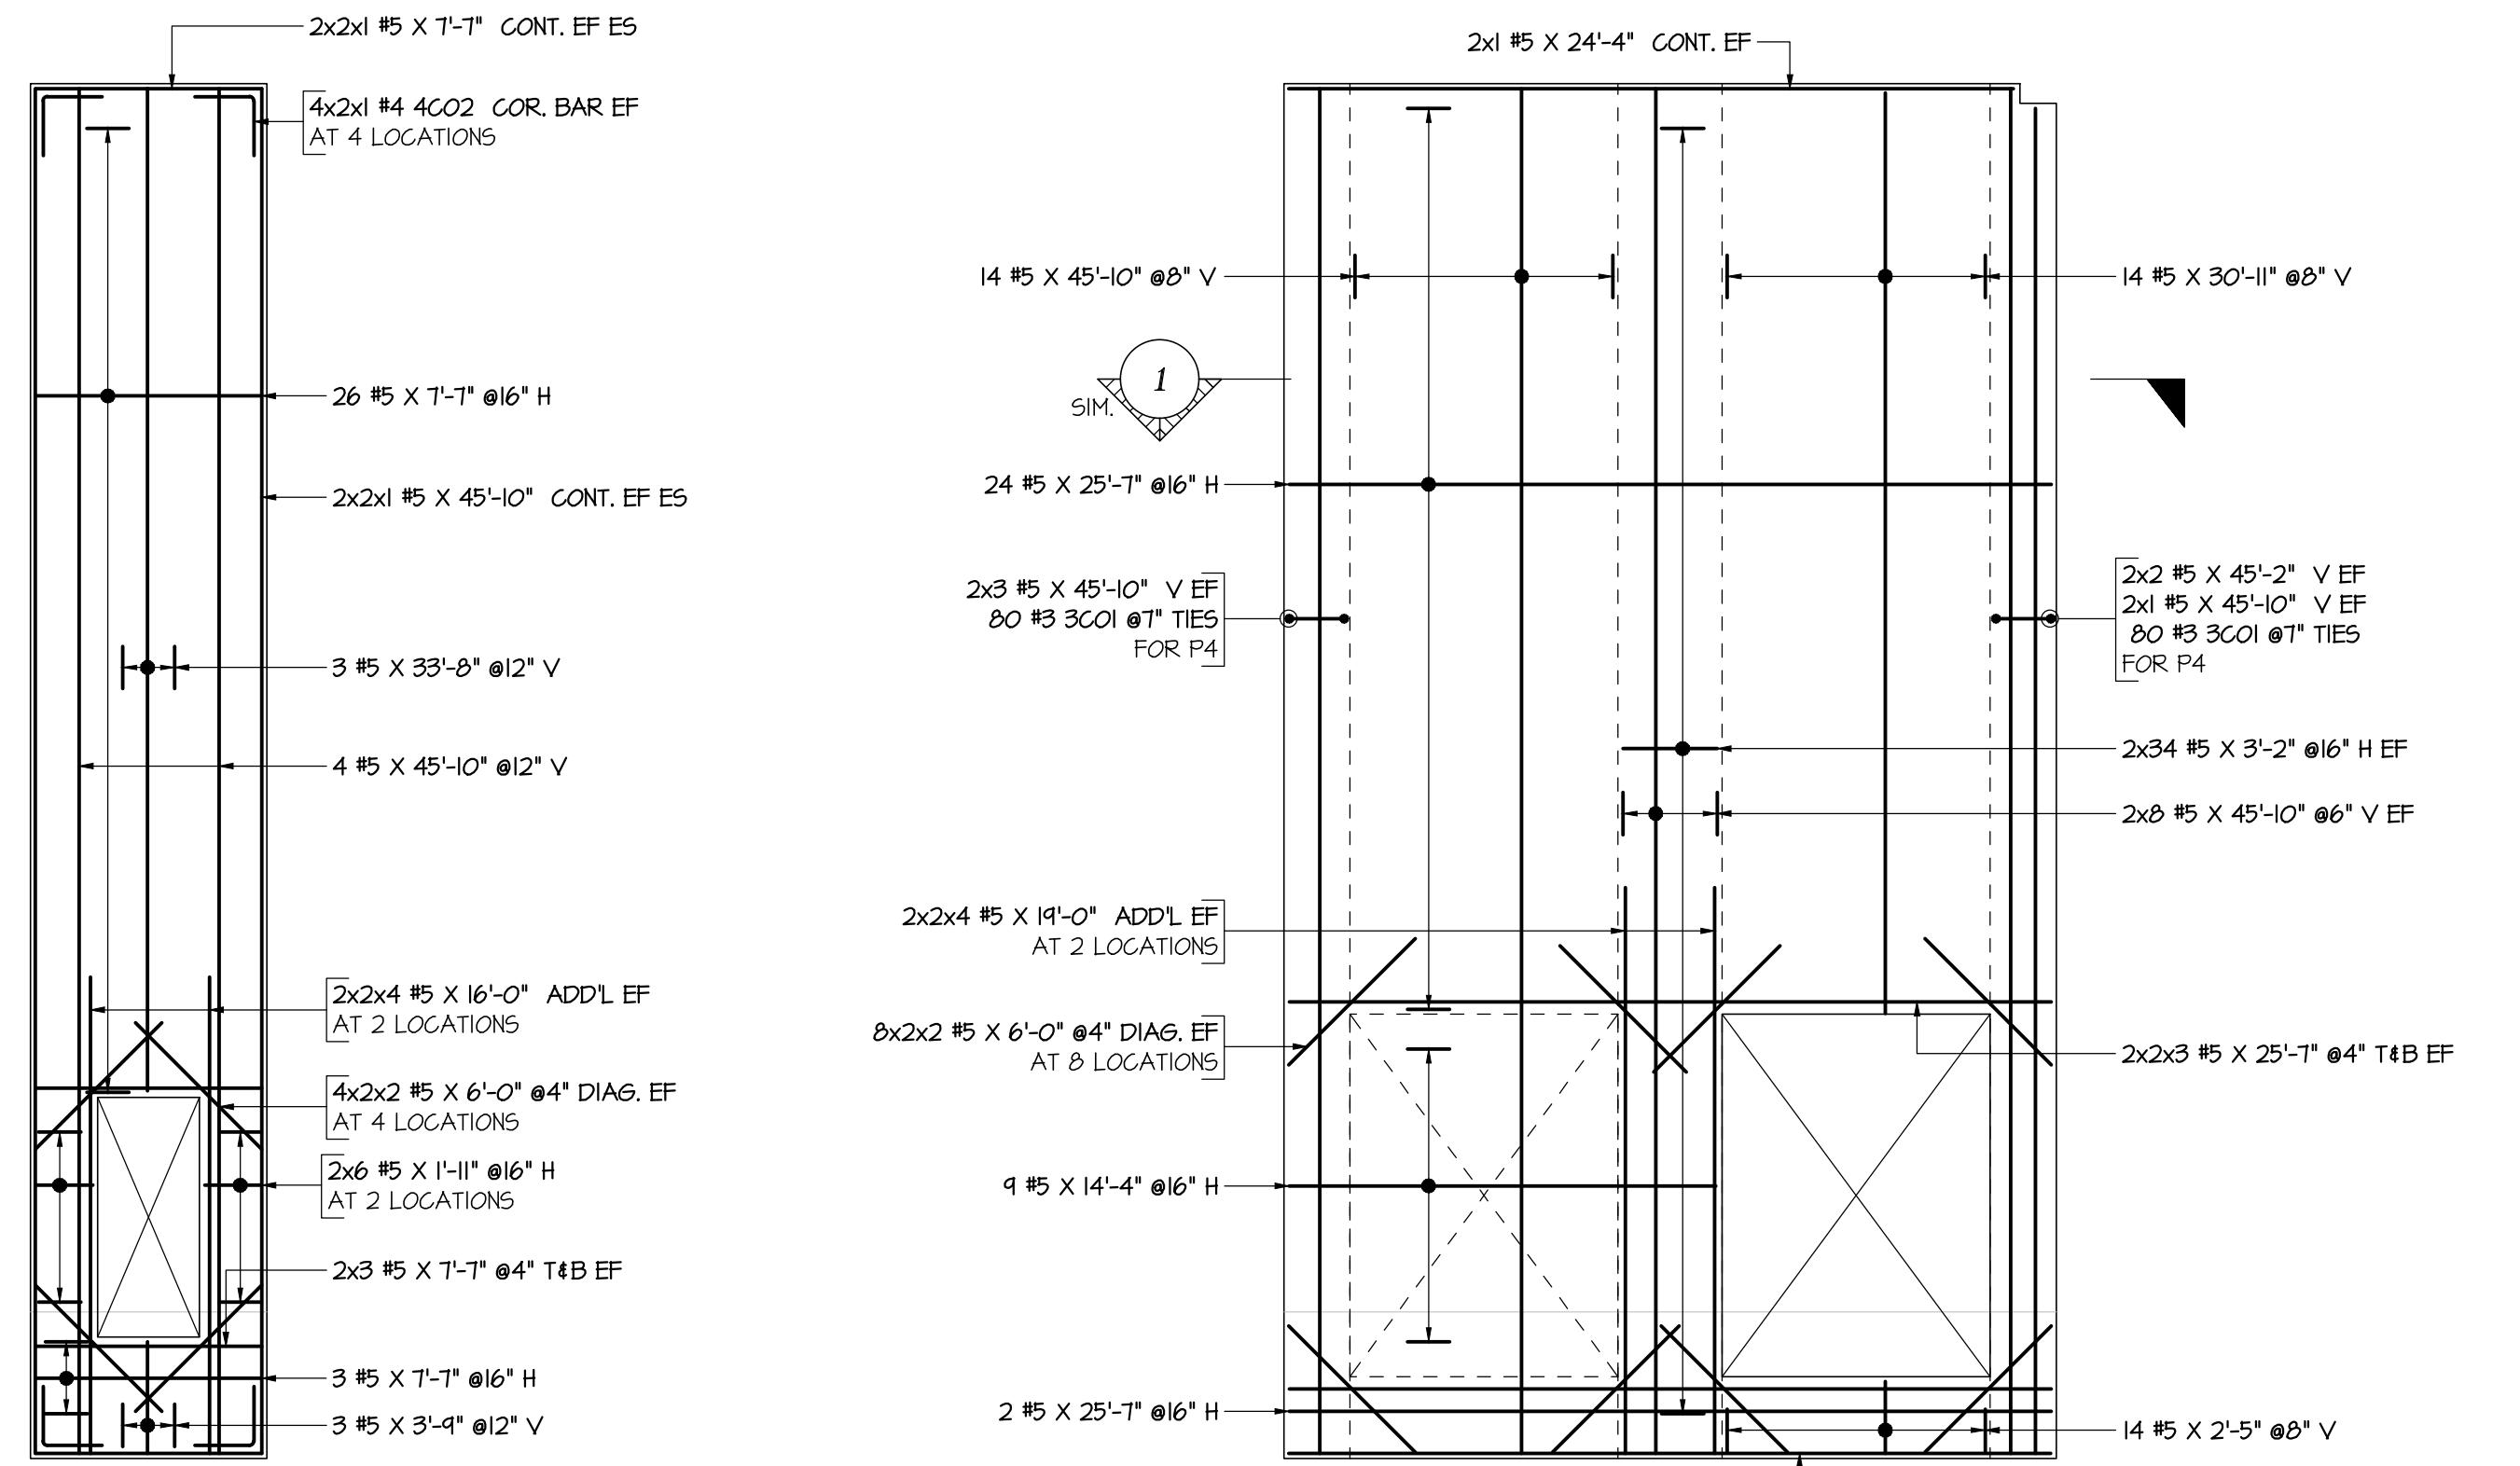

WALL PANEL - N43

SCALE. 1/6" = 1'-0"
SDR: R2, R8 & S200
[9 1/4" THK WALL]

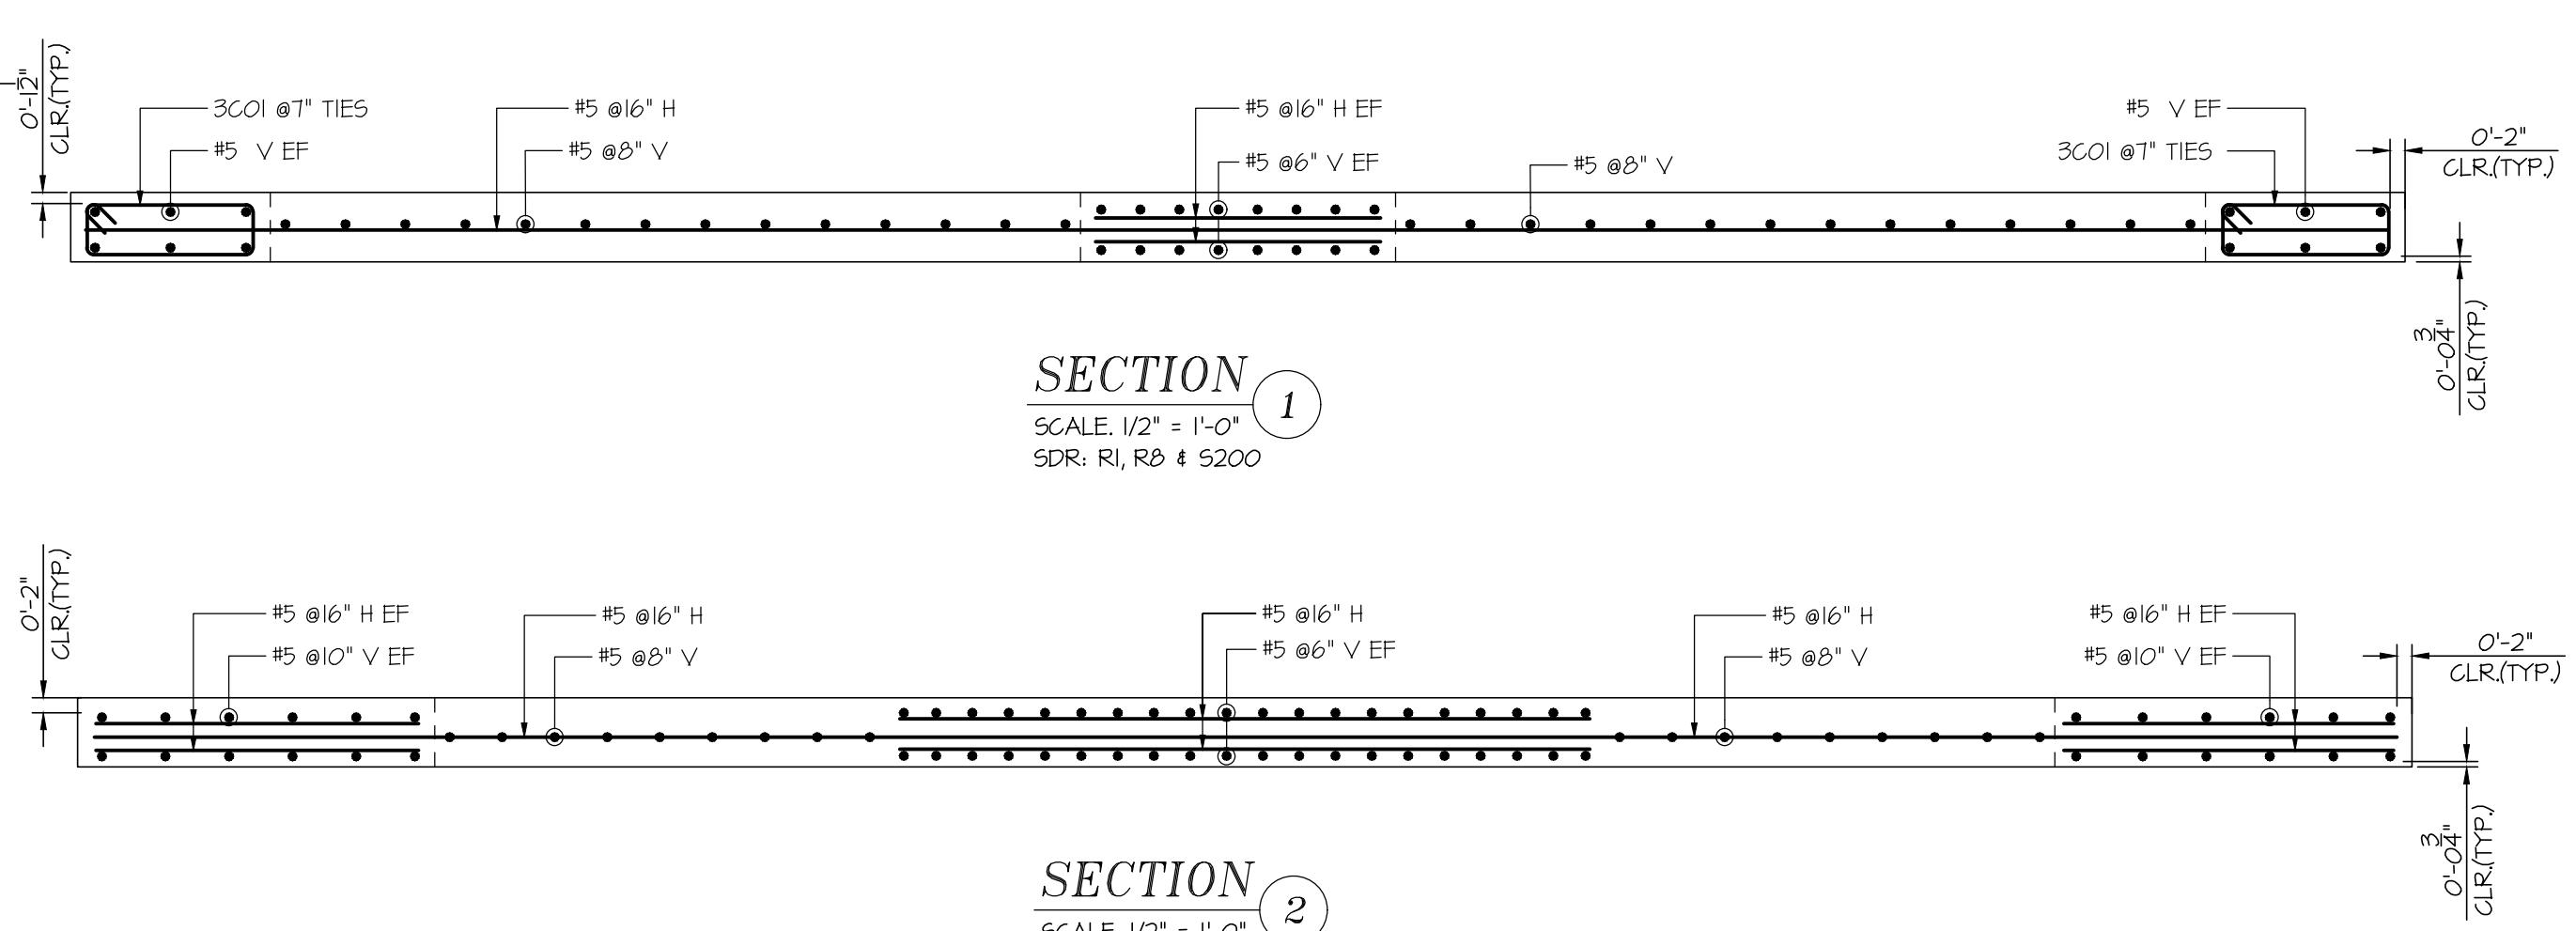


SECTION

SCALE. 1/2" = 1'-0" 1
SDR: RI, RB & S200


SDR: RI, R8 \$ 5200

SECTION 2

SECTION 2

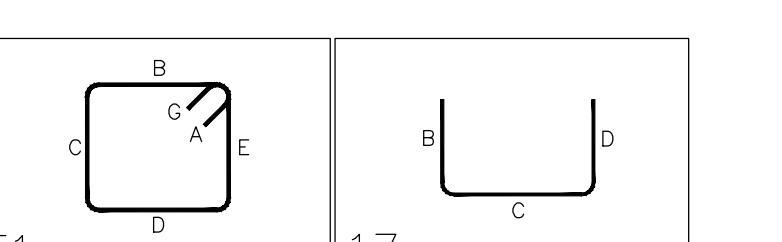


EBAR PLACEMENT FOR SINGLE LAYERS

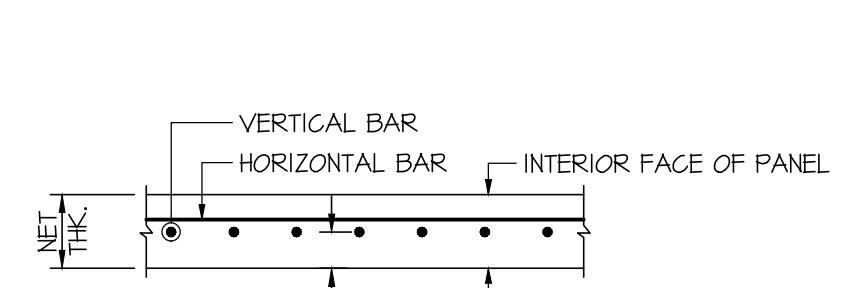

REBAR PLACEMENT FOR DOUBLE LAYERS




SCALE. 1/2" = 1'-0"
SDR: RB

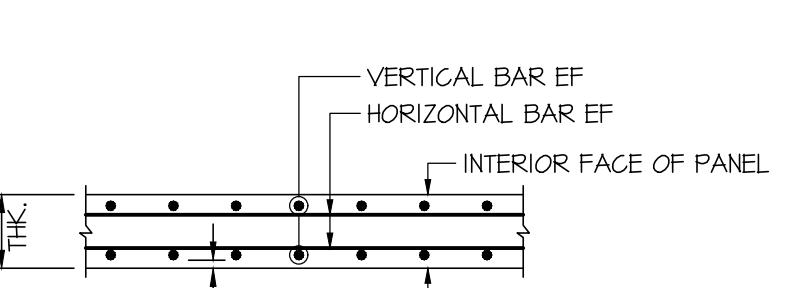

REBAR PLACEMENT FOR DOUBLE LAYERS


<u>NORTH WALL PANELS</u> <u>PLACING DRAWING REFERENCE</u>	
WG.NO:	DRAWING DESCRIPTION
R-4	NORTH WALL PANELS N-1 TO N-8
R-5	NORTH WALL PANELS N-9 TO N-15
R-6	NORTH WALL PANELS N-16 TO N-22
R-7	NORTH WALL PANELS N-23 TO N-29
R-8	NORTH WALL PANELS N-30 TO N-36
R-9	NORTH WALL PANELS N-37 TO N-43
R-10	NORTH WALL PANELS N-44 TO N-50
R-11	NORTH WALL PANELS N-51 TO N-58
R-12	NORTH WALL PANELS N-59 TO N-66
R-13	NORTH WALL PANELS N-67 TO N-73
R-14	NORTH WALL PANELS N-74 TO N-81

NORTH WALL PANELS
PLACING DRAWING REFERENCE
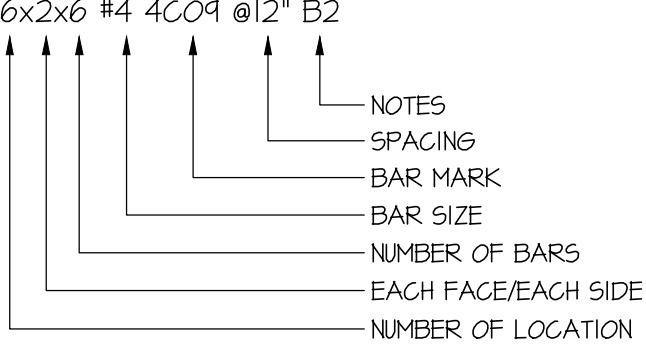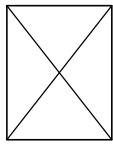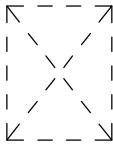
<u>STRUCTURAL NOTES</u>		
<u>LEGENDS</u>	<u>LABEL LEGENDS</u>	
T - TOP		
B - BOTTOM		
V, VERT - VERTICAL		
H, HORIZ - HORIZONTAL		
CLR. - CLEAR COVER		
SIM. - SIMILAR		
TYP. - TYPICAL		
T.O.MAT - TOP OF MAT		
ES - EACH SIDE		
EF - EACH FACE		
CONT - CONTINUOUS		
COR. - CORNER		
THK. - THICKNESS		
ADD'L - ADDITIONAL		
DIAG. - DIAGONAL		
NTS - NOT TO SCALE		
¢ - CENTER LINE		
SDR - STRUCTURAL DRAWING REFERENCE		
	6x2x6 #4 4C09 @12" B2	
		
		
		
CLEAR COVER TO REINFORCEMENT		
WALL PANEL	2"	AT ENDS
	1 1/2"	#5 & BELOW AT EXTERIOR FACE
	2"	#6 & ABOVE AT EXTERIOR FACE


REINFORCING STEEL PLACING DRAWING ONLY. USE IN CONJUNCTION WITH CONTRACT DRAWINGS & SPECIFICATIONS. ELEVATIONS & DIMENSIONS SHOWN ON THIS DRAWING ARE FOR DETAILING PURPOSES ONLY AND SHOULD NOT BE USED FOR CONSTRUCTION UNLESS VERIFIED BY ENGINEER OR CONTRACTOR.

	06.10.2019	RE SUBMITTED FOR APPROVAL
	05.24.2019	APPROVAL
	DATE	SENT FOR
RE-STEEL SUPPLY CO., INC. REINFORCING STEEL - WIRE MESH 		
2000 Eddystone Industrial Park • Eddystone, PA 19022-1588 Phone: 800-876-8216 • Fax: 610-876-8428		
structure	VALLEY VIEW BUSINESS PARK TILT PANELS	
cation	JESSUP,PA	
chitect	KSS ARCHITECTS	
gineer	RICHARD ADAMS	
stomer	T&T CONSTRUCTION	
Made by:	Date:	CONTRACT NO.
PRO	05.24.2019	U2524
DRAWING COVERS NORTH WALL PANELS N-37 TO N-43		DRAWING NO. R-9

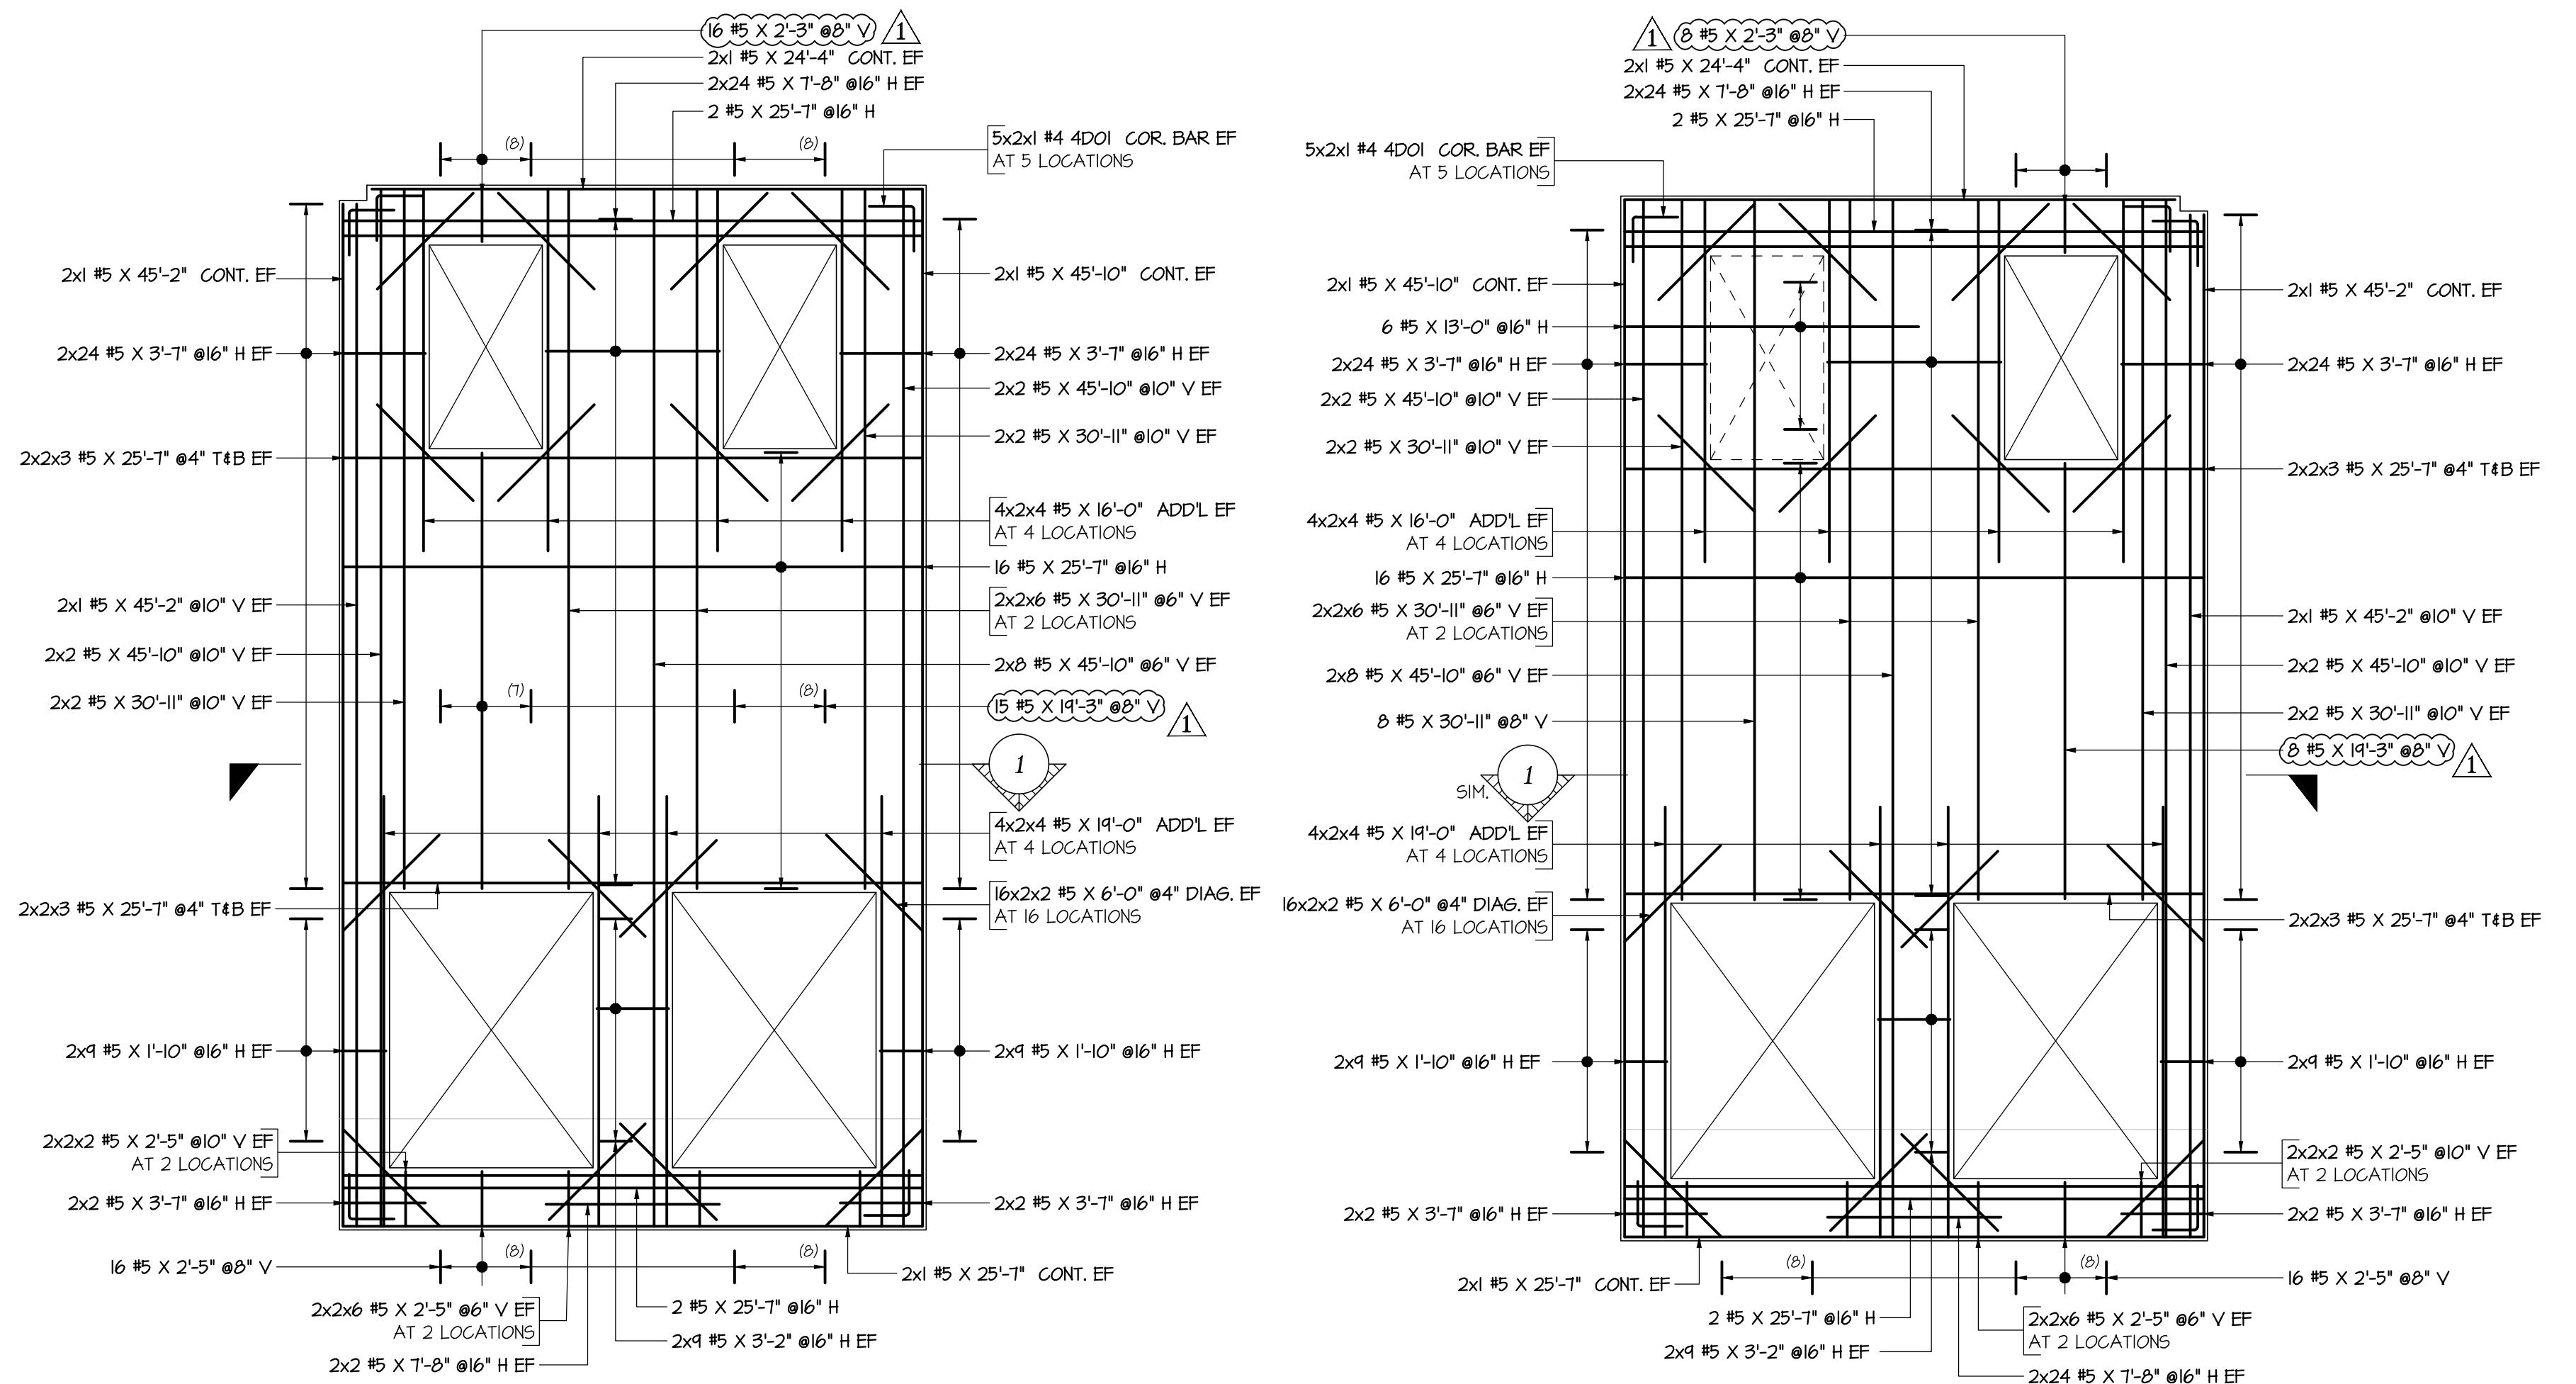


WALL PANEL - N44

SCALE: 1/6" = 1'-0"
SDR: R2, R8 & S200
(1/4" THK WALL)

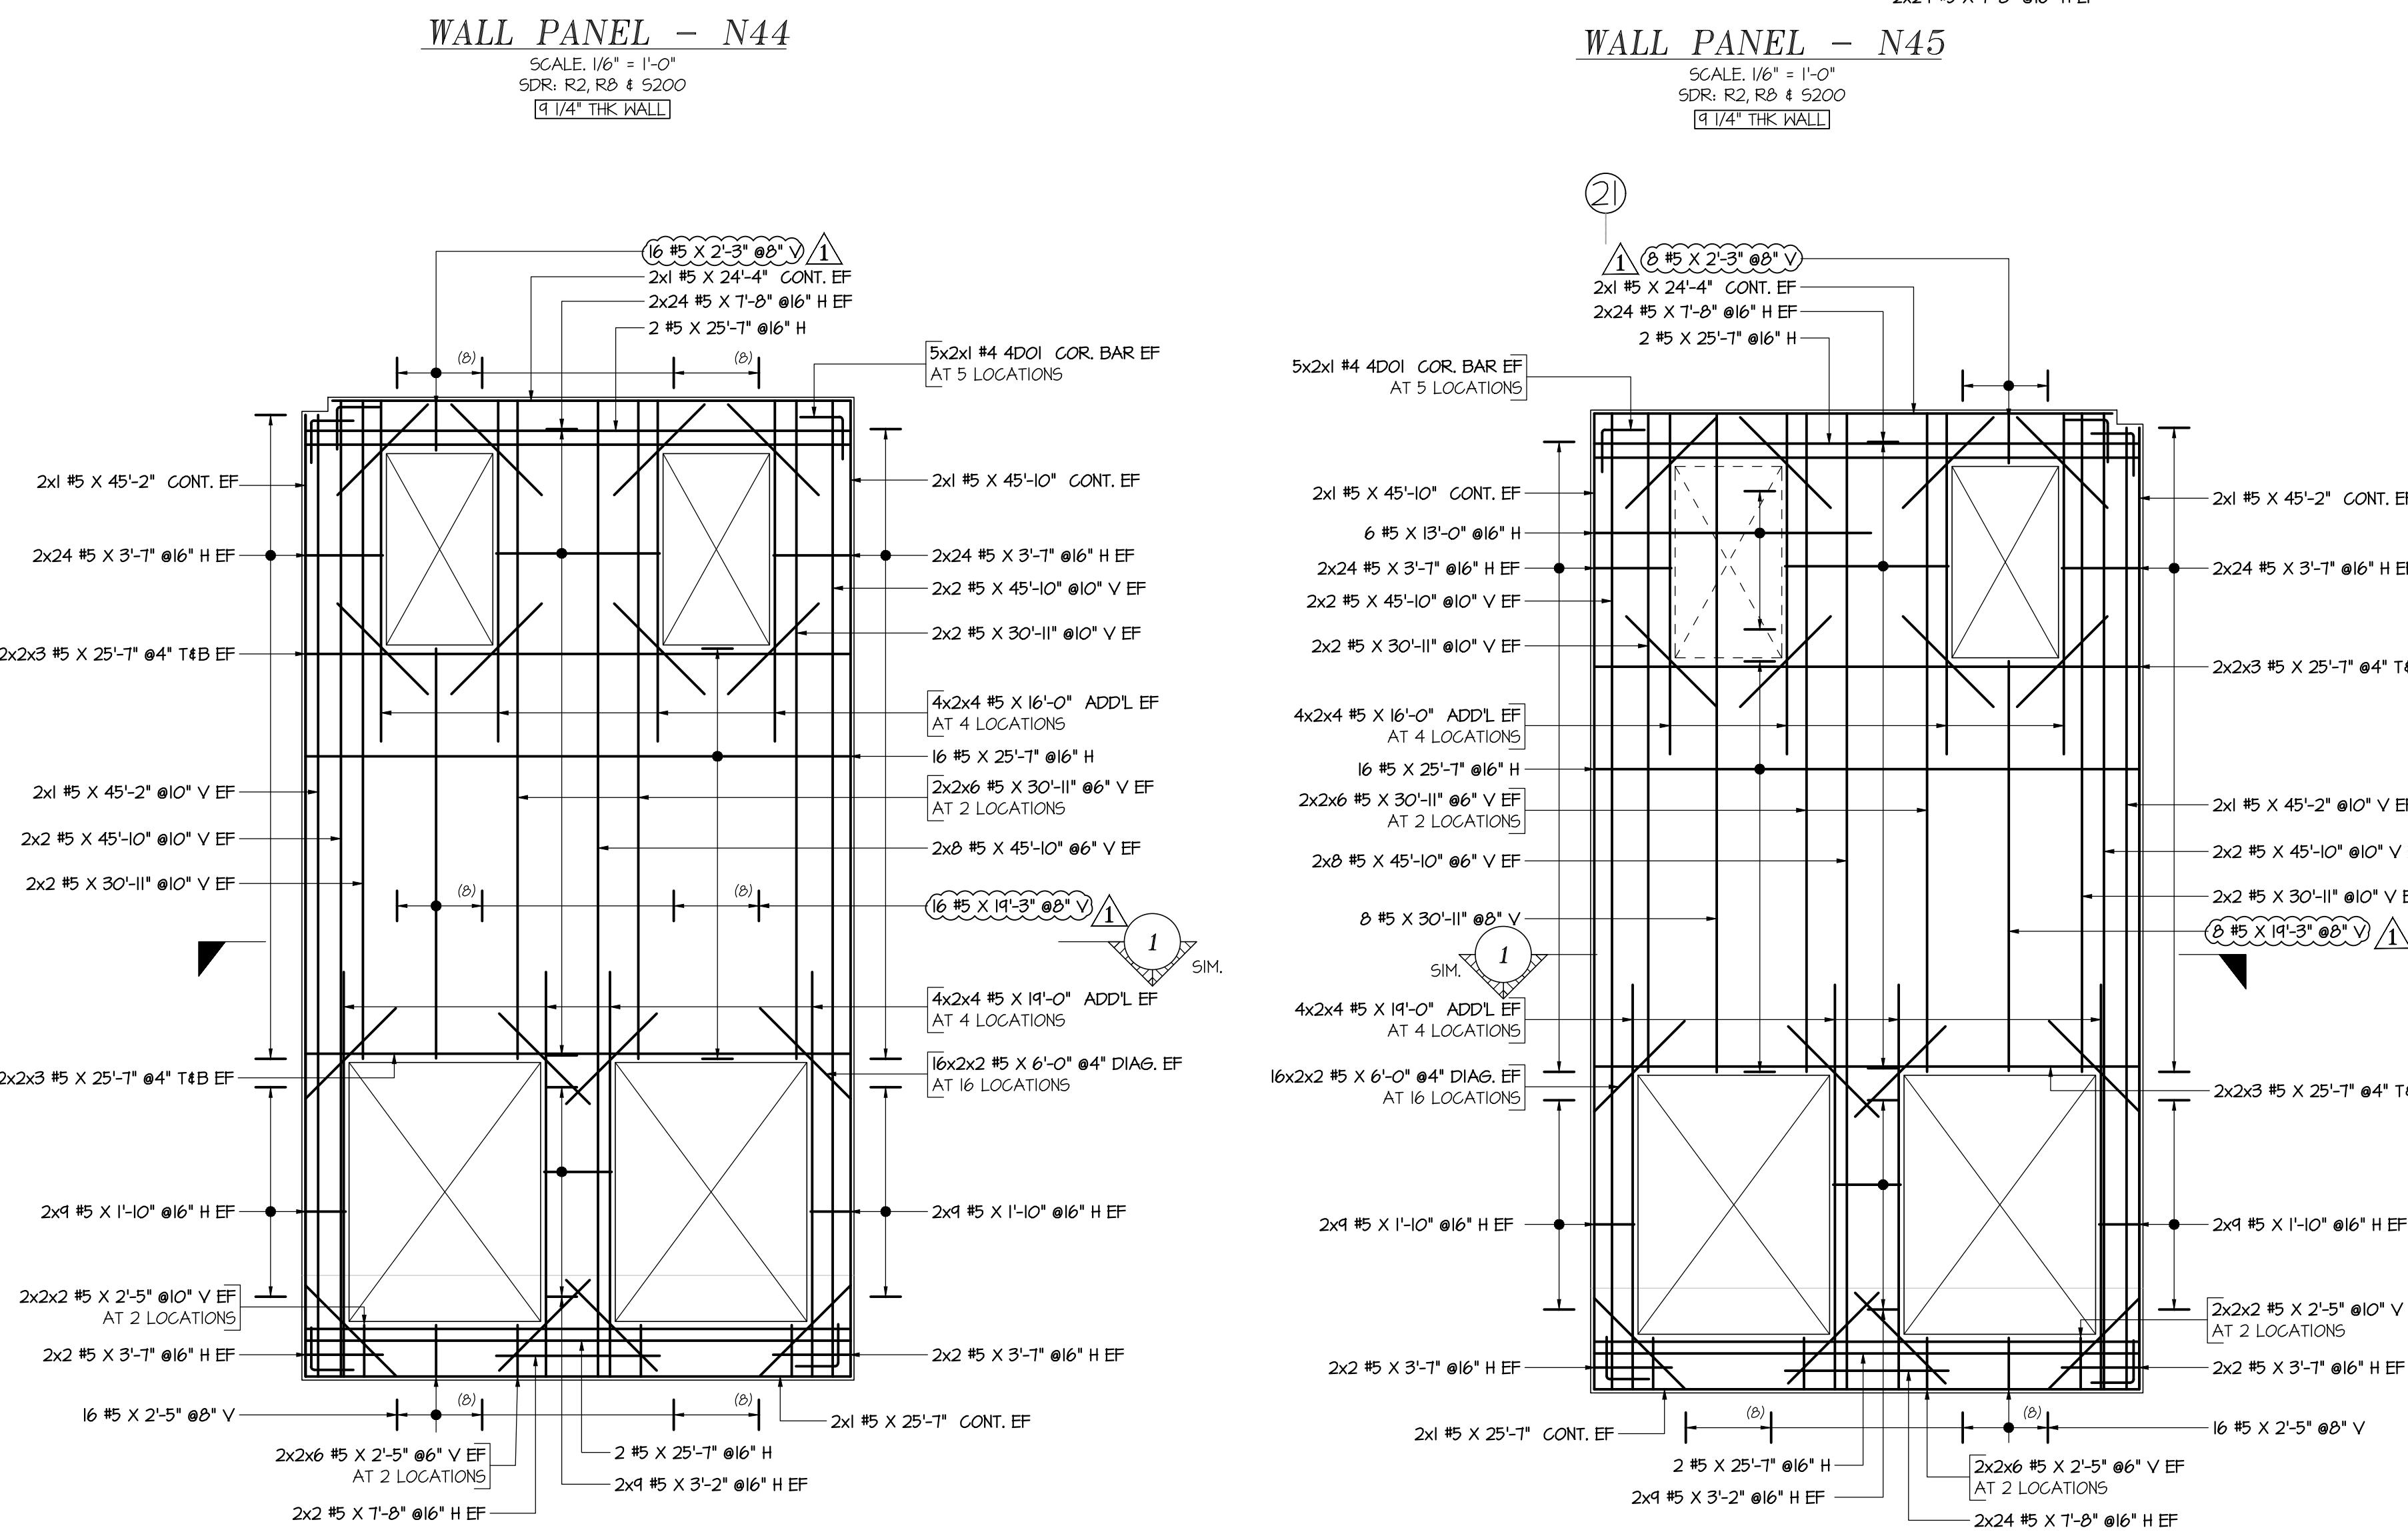

WALL PANEL - N45

SCALE: 1/6" = 1'-0"
SDR: R2, R8 & S200
(1/4" THK WALL)

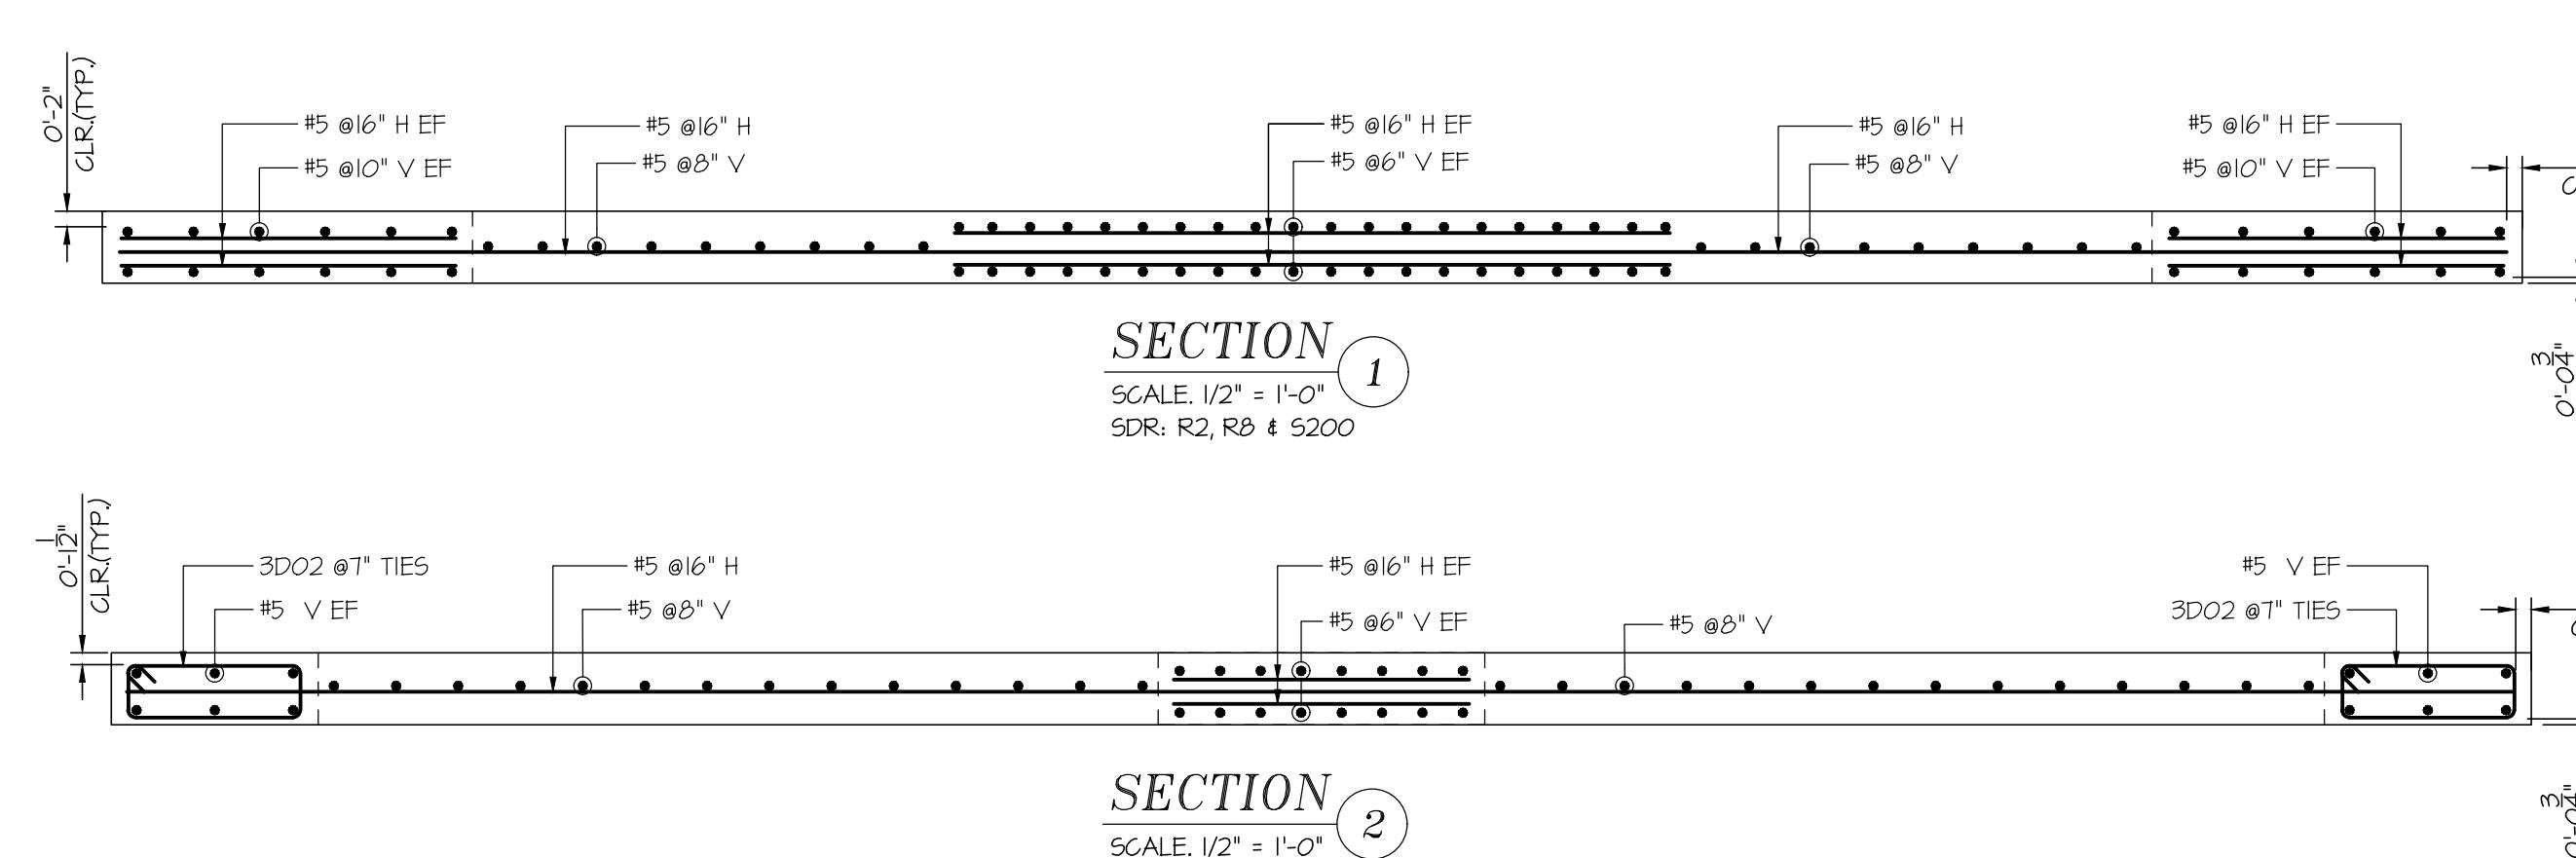

WALL PANEL - N45

SCALE: 1/6" = 1'-0"
SDR: R2, R8 & S200
(1/4" THK WALL)

WALL PANEL - N46

SCALE: 1/6" = 1'-0"
SDR: R2, R8 & S200
(1/4" THK WALL)

WALL PANEL - N47

SCALE: 1/6" = 1'-0"
SDR: R2, R8 & S200
(1/4" THK WALL)

WALL PANEL - N48

SCALE: 1/6" = 1'-0"
SDR: R2, R8 & S200
(1/4" THK WALL)

Drawing Sheet : R-10											
BENDING DETAILS											
Bor Work	Oy	Size	Total Length	Type	X'	Y'	Z'	U'	V'	W'	Y'
3D02	372	#3	5'-7 1/2"	T1	0'-4 X'	1'-10 X'	0'-7"	1'-10 X'	0'-7"	0'-4 X'	
4001	48	#4	4'-0 1/2"	T1	2'-0"						

T1 Hooks A & G optional

B C G A E D

STRUCTURAL NOTES


LEGENDS		LABEL LEGENDS	
T	- TOP	6x2x6 #4 4C09 @12" B2	
B	- BOTTOM		NOTES
V, VERT	- VERTICAL		SPACING
H, HORIZ	- HORIZONTAL		BAR MARK
CLR.	- CLEAR COVER		BAR SIZE
SIM.	- SIMILAR		NUMBER OF BARS
TYP.	- TYPICAL		EACH FACE/ EACH SIDE
T.O.MAT	- TOP OF MAT		NUMBER OF LOCATIONS
E5	- EACH SIDE		
EF	- EACH FACE		
CONT	- CONTINUOUS		
COR.	- CORNER		
THK.	- THICKNESS		
ADDL.	- ADDITIONAL		
DIAG.	- DIAGONAL		
NTS	- NOT TO SCALE		
€	- CENTER LINE		
SDR	- STRUCTURAL DRAWING		
	REFERENCE		
CLEAR COVER TO REINFORCEMENT		DENOTES OPENINGS	
WALL PANEL			
	2"	AT ENDS	
	1 1/2"	#5 @ 6" BELOW AT EXTERIOR FACE	
	2"	#6 @ ABOVE AT EXTERIOR FACE	
	3/4"	AT INTERIOR FACE	


NORTH WALL PANELS	
PLACING DRAWING REFERENCE	
DWG.NO:	DRAWING DESCRIPTION
R-4	NORTH WALL PANELS N-1 TO N-8
R-5	NORTH WALL PANELS N-9 TO N-15
R-6	NORTH WALL PANELS N-16 TO N-22
R-7	NORTH WALL PANELS N-23 TO N-29
R-8	NORTH WALL PANELS N-30 TO N-36
R-9	NORTH WALL PANELS N-37 TO N-43
R-10	NORTH WALL PANELS N-44 TO N-50
R-11	NORTH WALL PANELS N-51 TO N-58
R-12	NORTH WALL PANELS N-59 TO N-66
R-13	NORTH WALL PANELS N-67 TO NT3
R-14	NORTH WALL PANELS N-74 TO N-81

REINFORCING STEEL PLACING DRAWING ONLY. USE IN CONJUNCTION WITH CONTRACT DRAWINGS & SPECIFICATIONS. ELEVATIONS & DIMENSIONS SHOWN ON THIS DRAWING ARE FOR DETAILING PURPOSES ONLY AND SHOULD NOT BE USED FOR CONSTRUCTION UNLESS VERIFIED BY ENGINEER OR CONTRACTOR.

7	
6	
5	
4	
3	
2	06.10.2019 RE SUBMITTED FOR APPROVAL
1	05.24.2019 APPROVAL DATE SENT FOR

RE-STEEL SUPPLY CO., INC.	
REINFORCING STEEL • WIRE MESH	
2000 Eddystone Industrial Park • Eddystone, PA 19022-1588	
Phone: 800-876-8216 • Fax: 610-876-8428	
VALLEY VIEW BUSINESS PARK TILT PANELS	
Structure	JESSUP, PA
Location	KSS ARCHITECTS
Architect	RICHARD ADAMS
Engineer	T&T CONSTRUCTION
Made by:	Date:
PRO	05.24.2019
CONTRACT NO. U2524	
DRAWING COVERS	
NORTH WALL PANELS N-44 TO N-50	
REV. NO.	DRAWING NO.
DATE	R-10
DESCRIPTION	

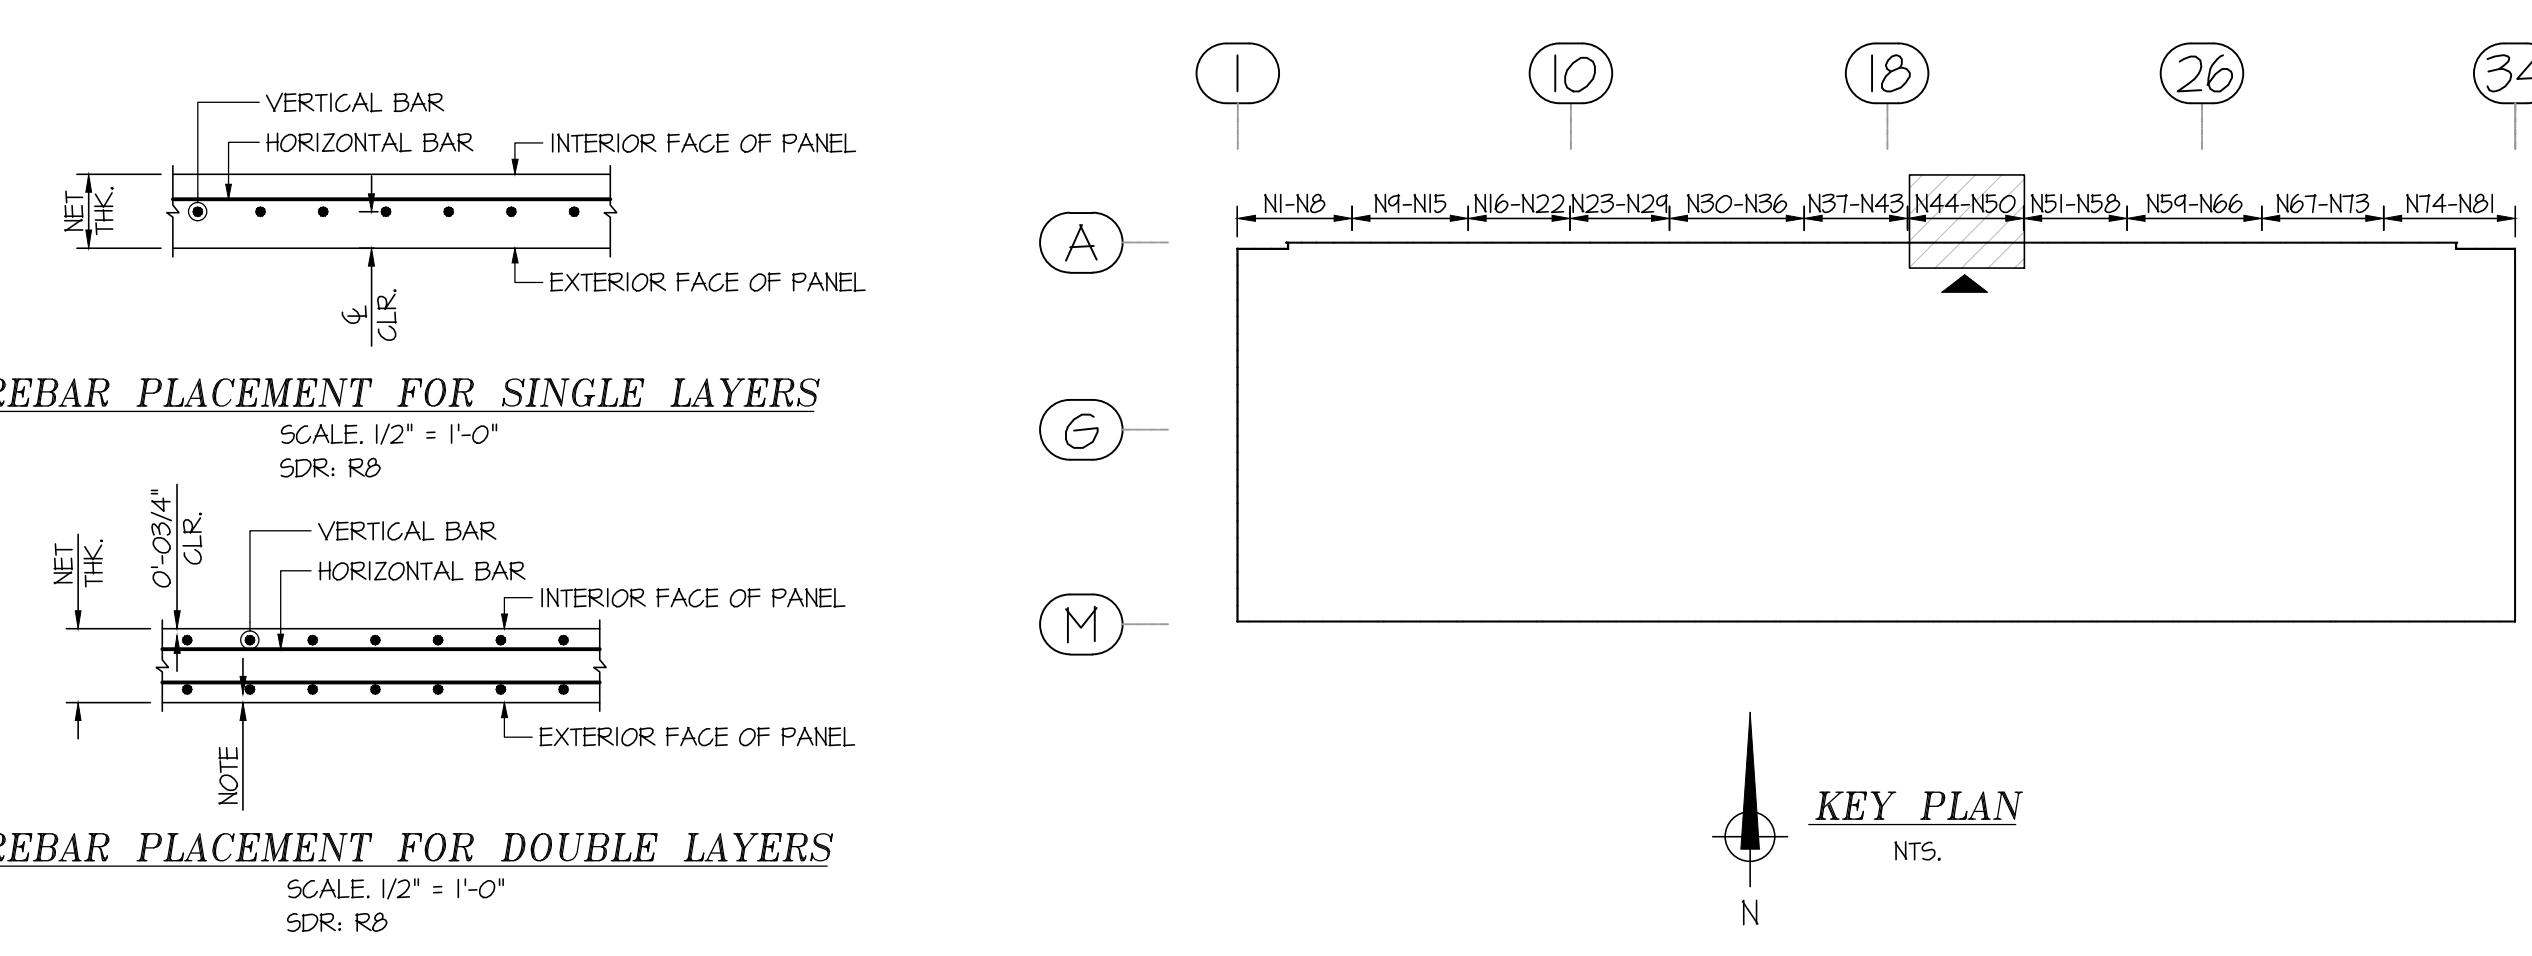

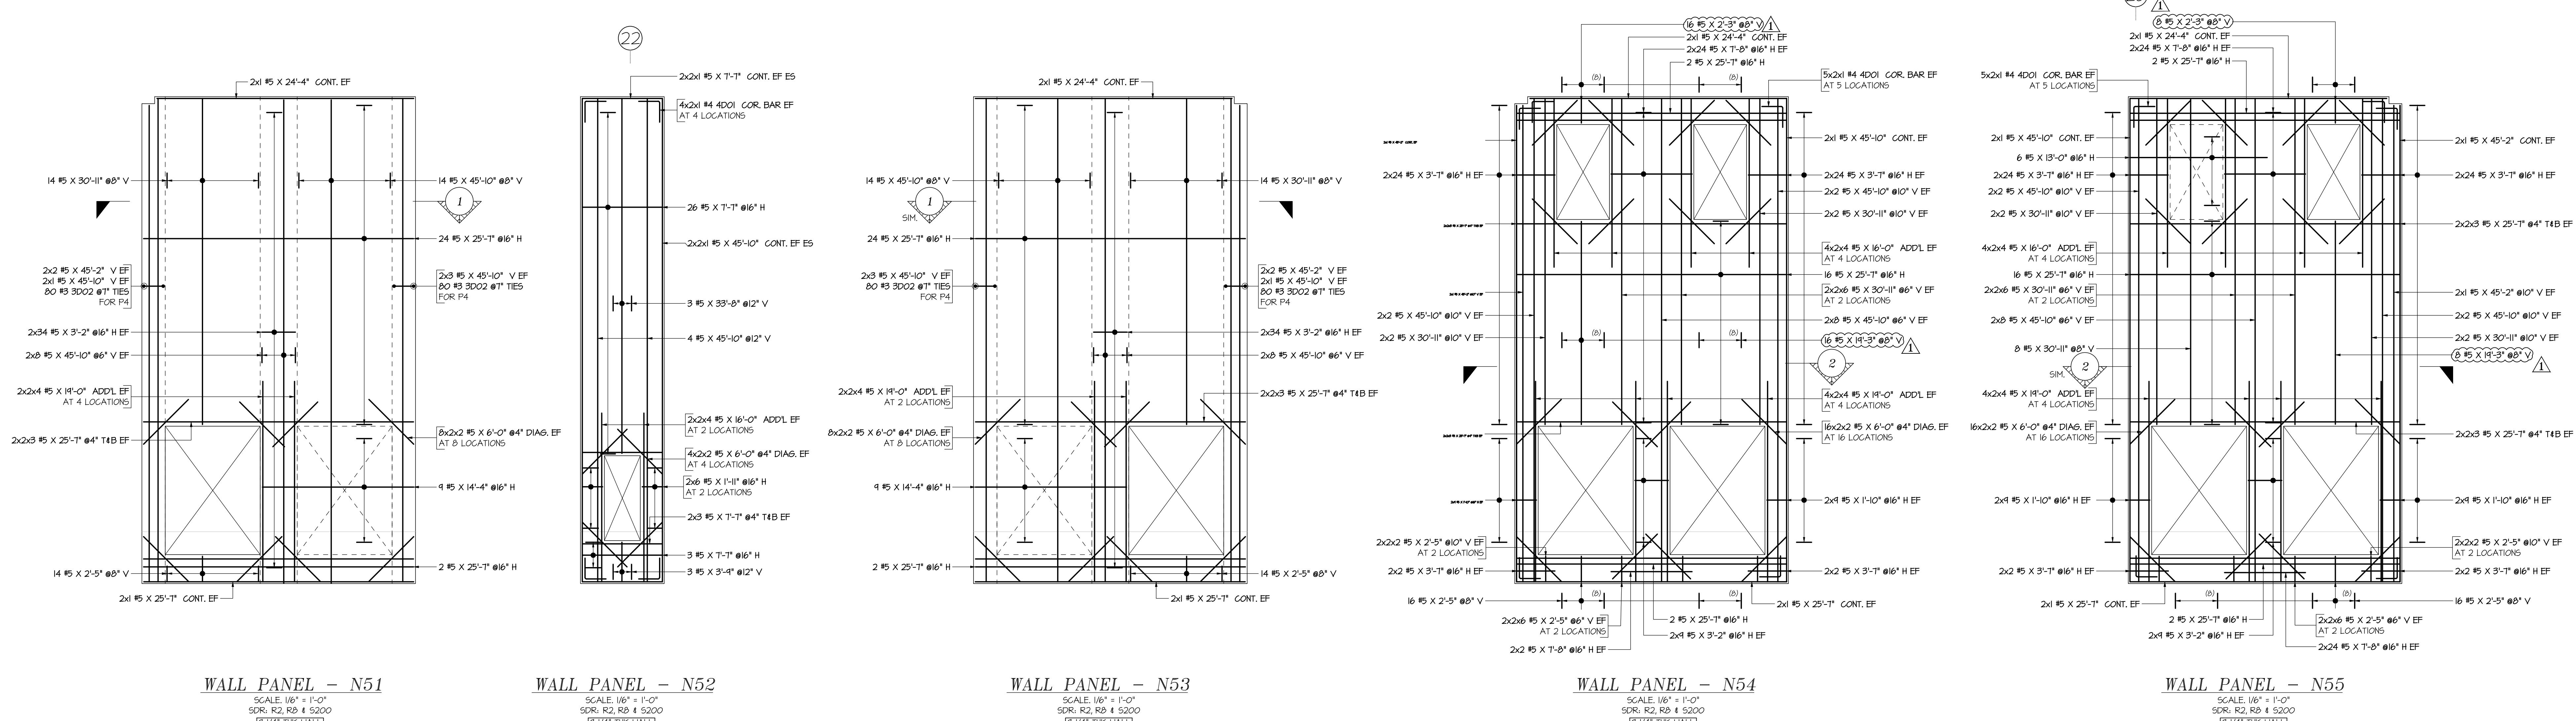

WALL PANEL - N51

SDR: R2, R8 & S200
9 1/4" THK WALL

WALL PANEL - N52
SCALE. 1/6" = 1'-0"
SPR: R2 R8 & S200

SDR: R2, R8 & S200
9 1/4" THK WALL

WALL PANEL - N53


SDR: R2, R8 \$
[9 1/4" THK W]

WALL PANEL - N54

SDR: R2, R8
9 1/4" THK W

WALL PANEL - N55

SDR: R2, R8 & S
9 1/4" THK WAL

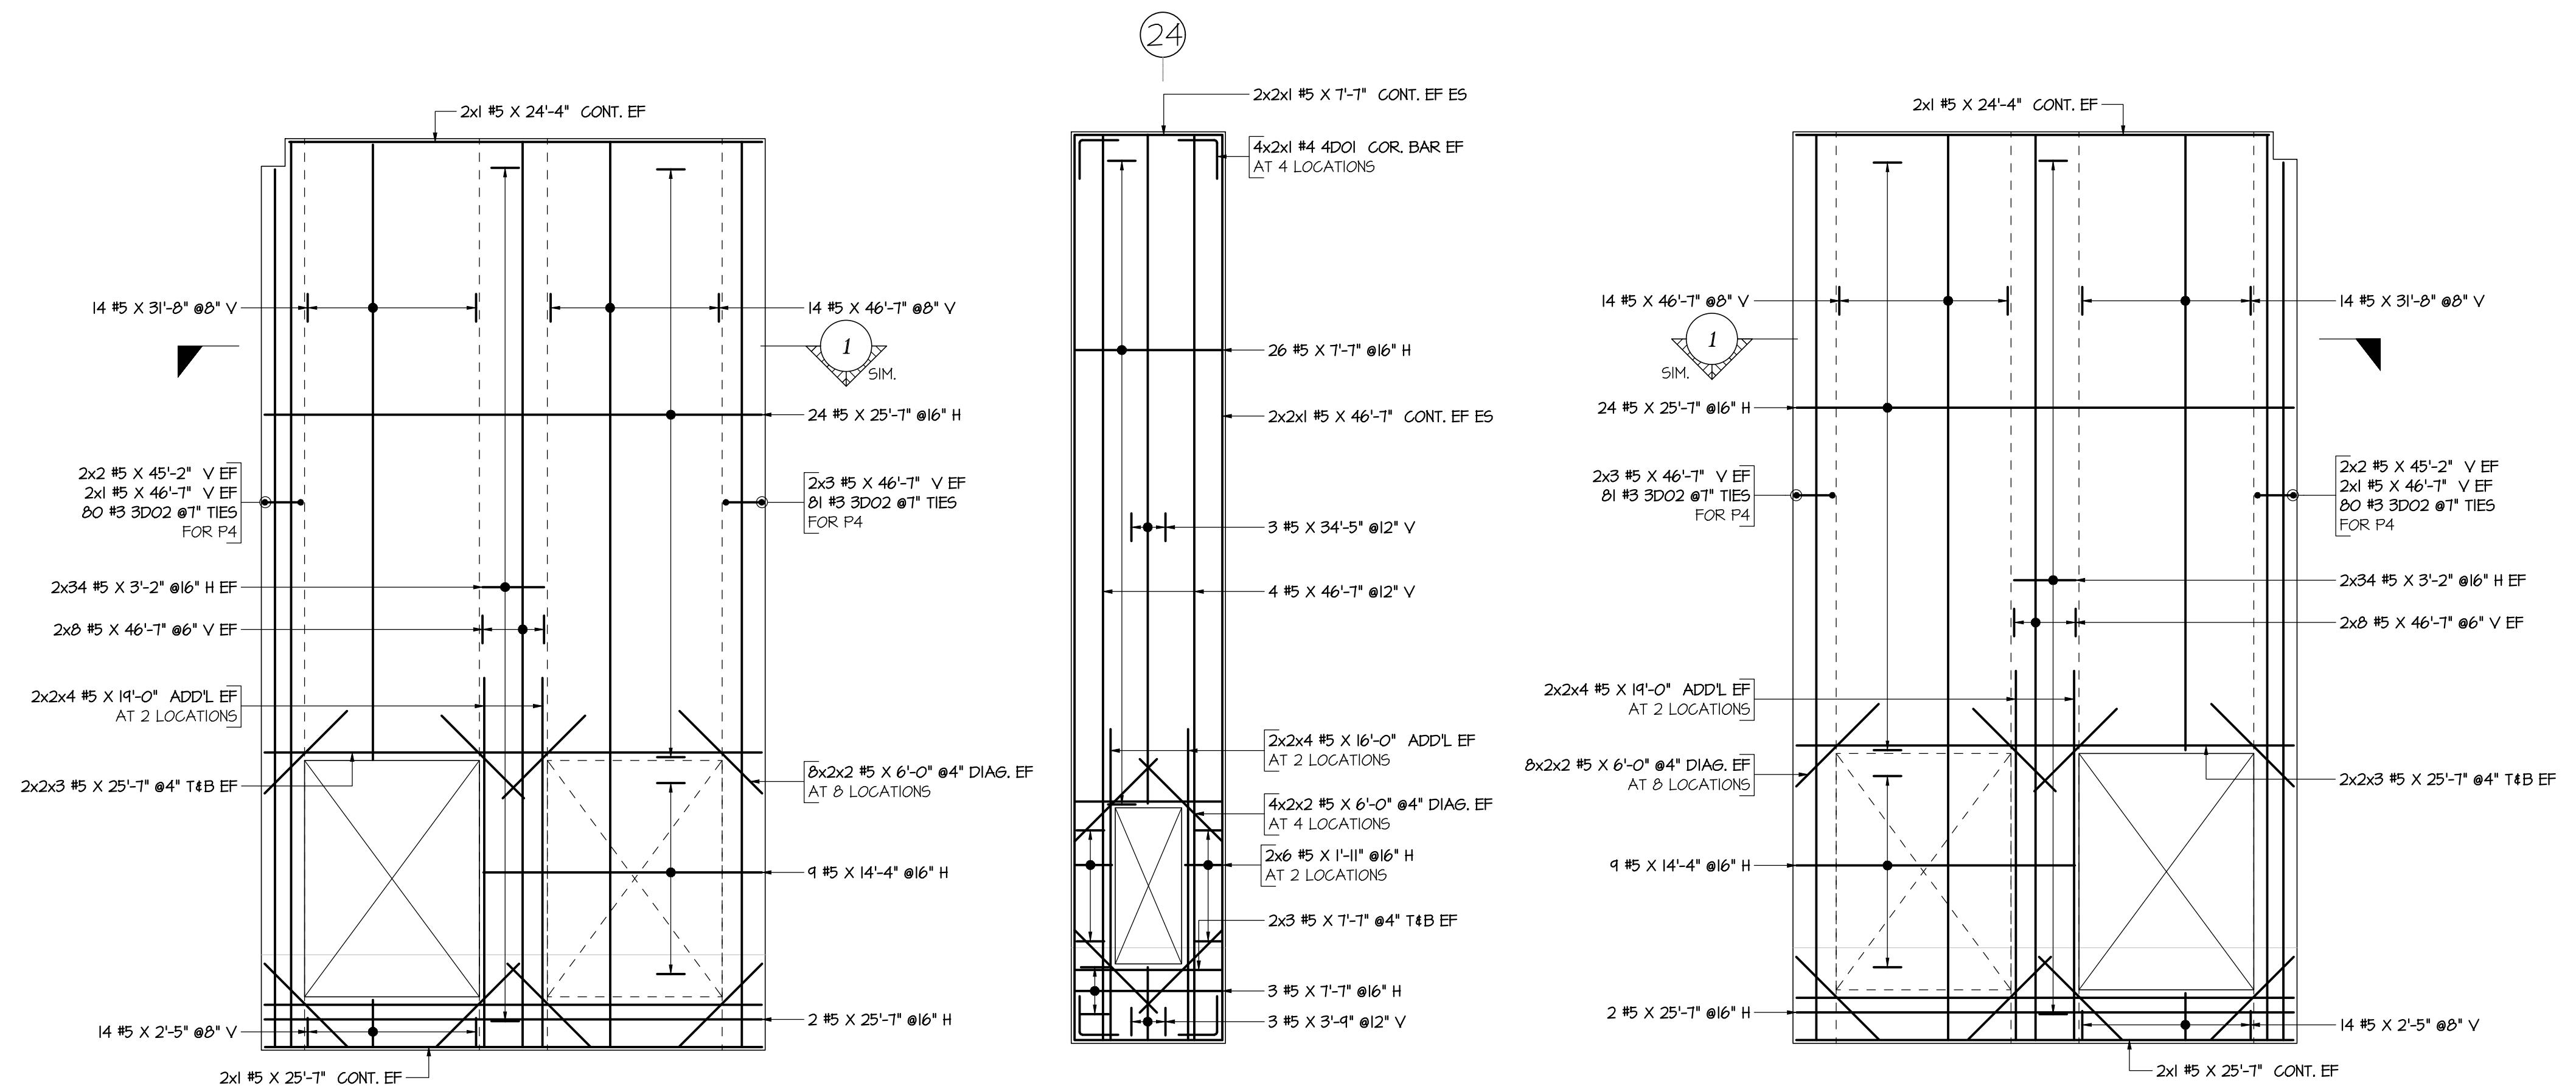

WALL PANEL - N56

SDR: R2, R8 & S200


9 1/4" THK WALL

WALL PANEL - N57

SDR: R2, R8 & S200
9 1/4" THK WALL



WALL PANEL - N58

SDR: R2, R8 &
9 1/4" THK W

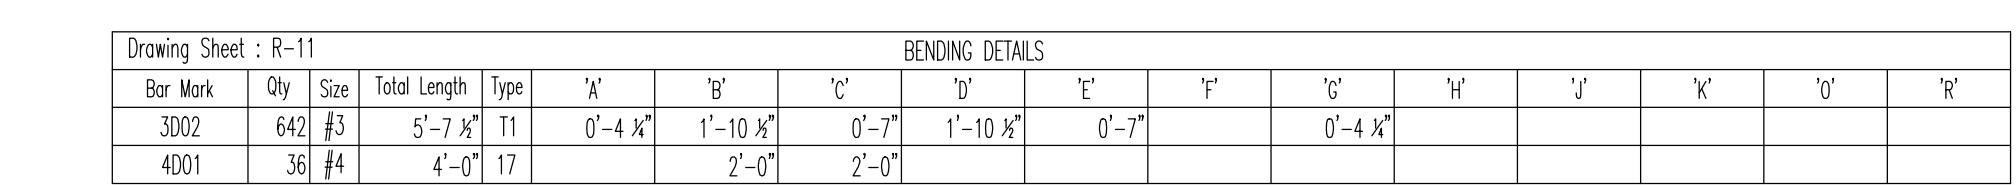

STRUCTURAL NOTES


<u>LEGENDS</u>		<u>LABEL LEGENDS</u>
T	- TOP	
B	- BOTTOM	
V, VERT	- VERTICAL	
H, HORIZ	- HORIZONTAL	
CLR.	- CLEAR COVER	
SIM.	- SIMILAR	
TYP.	- TYPICAL	
T.O.MAT	- TOP OF MAT	
ES	- EACH SIDE	
		$6 \times 2 \times 6 \ #4\ 4C09 @12''\ B2$
		
		NOTES
		SPACING
		BAR MARK
		BAR SIZE
		NUMBER OF BARS
		EACH FACE/EACH SIDE
		NUMBER OF LOCATION

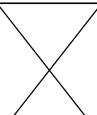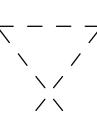EF	- EACH FACE	
CONT	- CONTINUOUS	
COR.	- CORNER	
THK.	- THICKNESS	
ADD'L	- ADDITIONAL	
DIAG.	- DIAGONAL	
NTS	- NOT TO SCALE	
¢	- CENTER LINE	
SDR	- STRUCTURAL DRAWING REFERENCE	
		
		
		DENOTES OPENINGS
		DENOTES KNOCK OUTS
CLEAR COVER TO REINFORCEMENT		
WALL PANEL	2"	AT ENDS
	1 1/2"	#5 & BELOW AT EXTERIOR FACE
	2"	#6 & ABOVE AT EXTERIOR FACE
	3/4"	AT INTERIOR FACE

NORTH WALL PANELS
PLACING DRAWING REFERENCE

DWG.NO:	DRAWING DESCRIPTION
R-4	NORTH WALL PANELS N-1 TO N-8
R-5	NORTH WALL PANELS N-9 TO N-15
R-6	NORTH WALL PANELS N-16 TO N-22
R-7	NORTH WALL PANELS N-23 TO N-29
R-8	NORTH WALL PANELS N-30 TO N-36
R-9	NORTH WALL PANELS N-37 TO N-43
R-10	NORTH WALL PANELS N-44 TO N-50
R-11	NORTH WALL PANELS N-51 TO N-58
R-12	NORTH WALL PANELS N-59 TO N-66
R-13	NORTH WALL PANELS N-67 TO N-73
R-14	NORTH WALL PANELS N-74 TO N-81

REINFORCING STEEL PLACING DRAWING ONLY. USE IN CONJUNCTION WITH CONTRACT DRAWINGS & SPECIFICATIONS. ELEVATIONS & DIMENSIONS SHOWN ON THIS DRAWING ARE FOR DETAILING PURPOSES ONLY AND SHOULD NOT BE USED FOR CONSTRUCTION UNLESS VERIFIED BY ENGINEER OR CONTRACTOR.

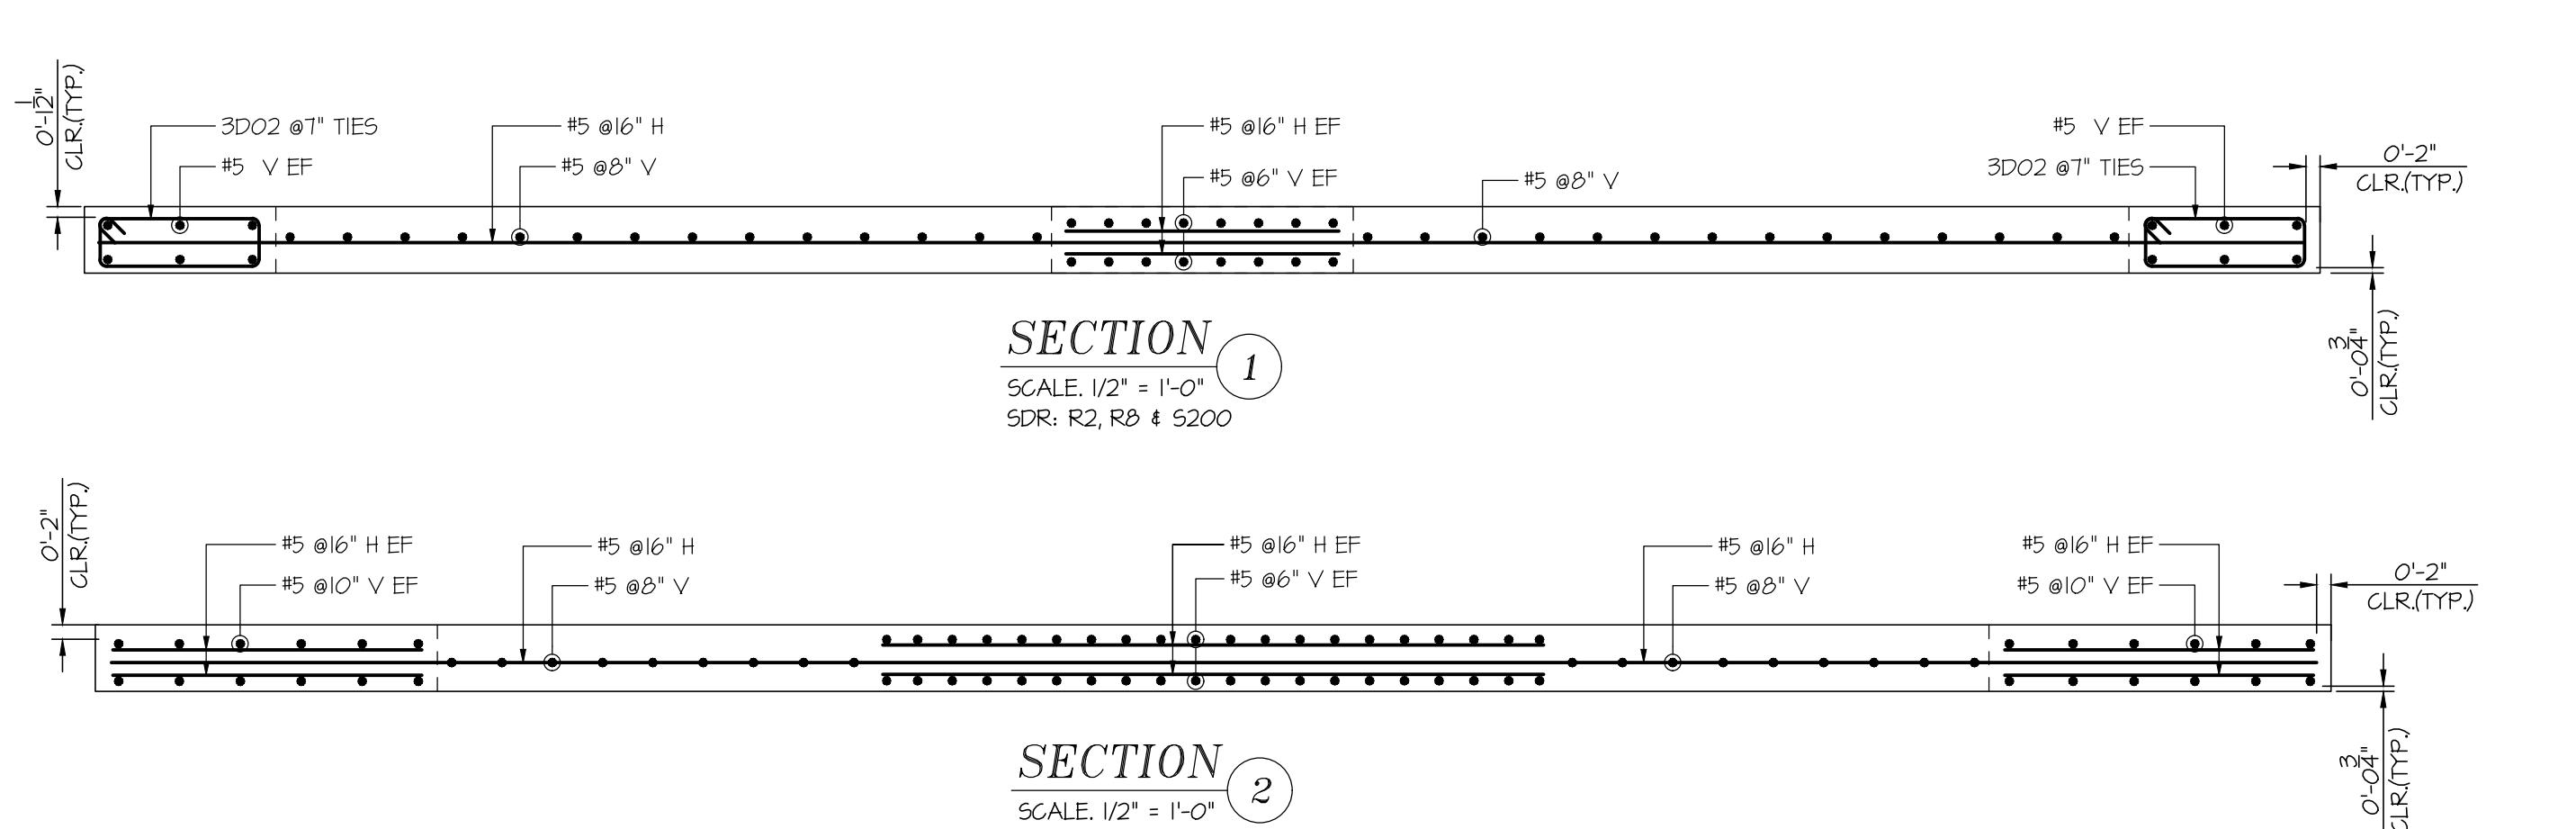

ALL PANEL - N58


9 1/4" THK WALL

CLÉ



REBAR PLATE

REBAR PLACEMENT FOR DOUBLE LAYER

WEDDING PLANNERS

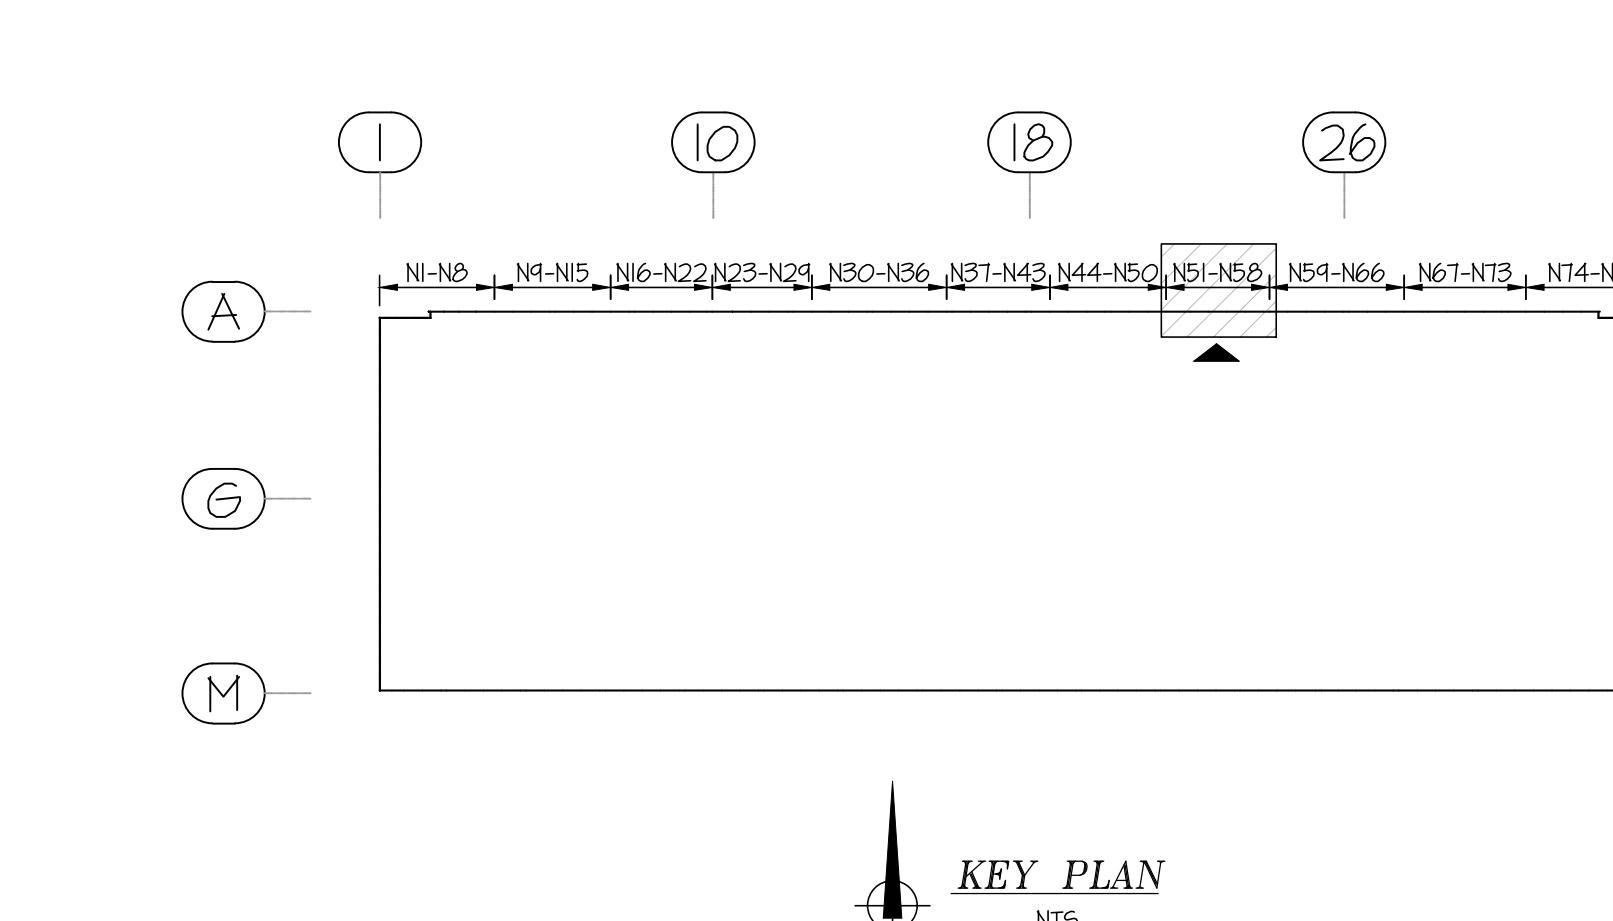

KEY

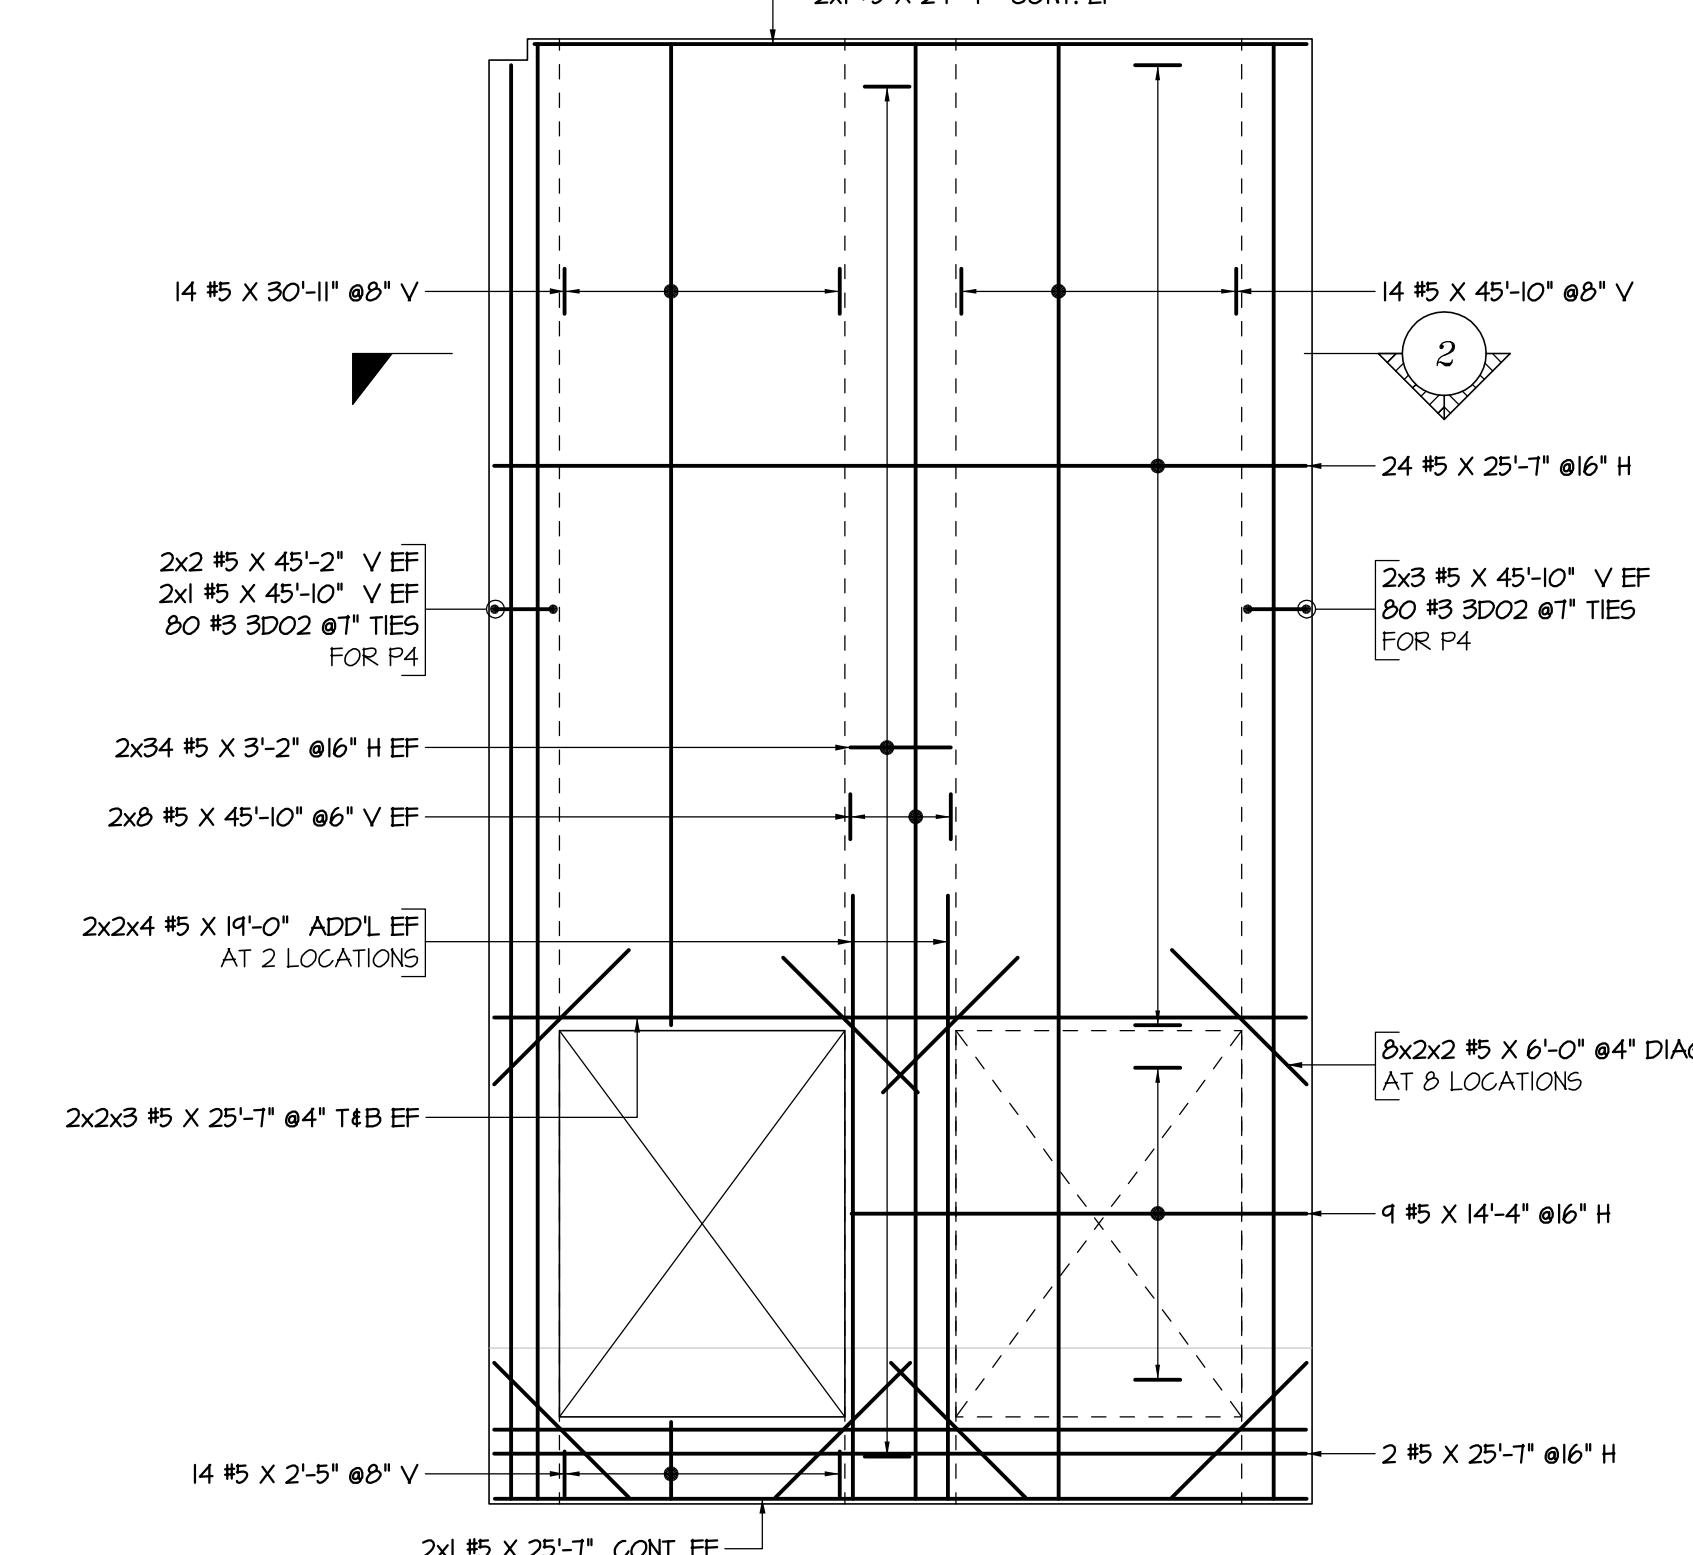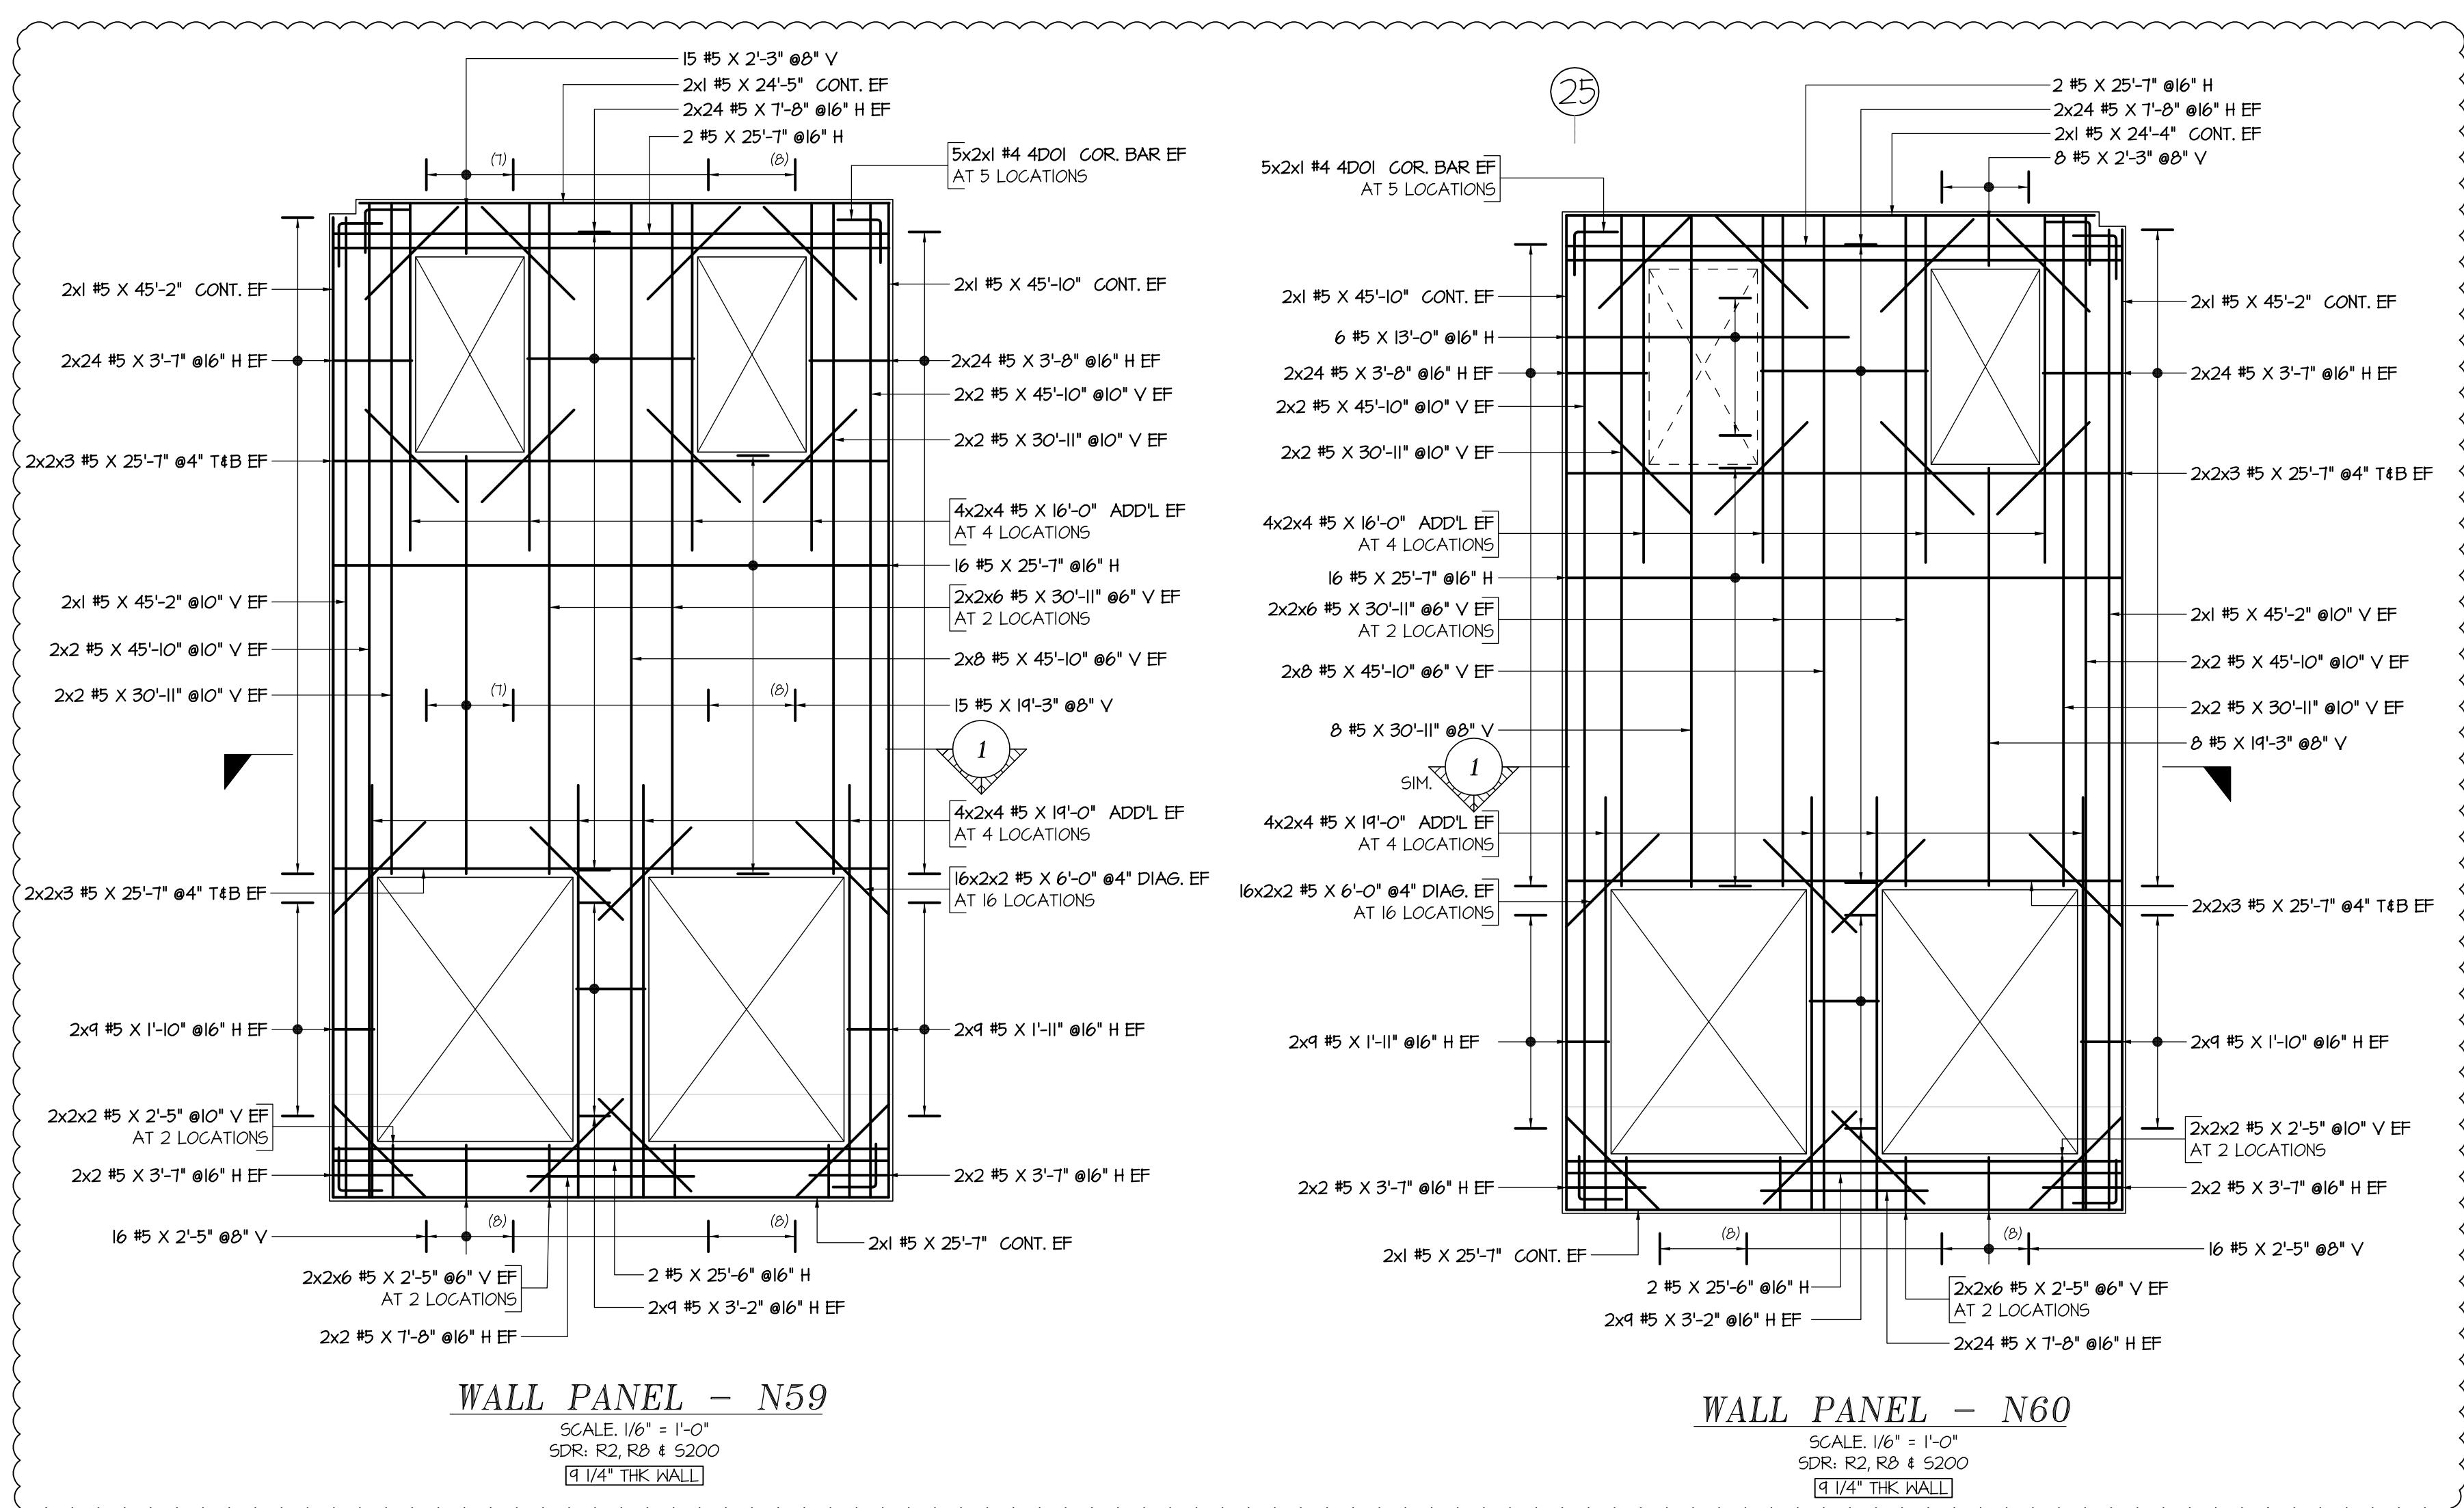

WALL PANEL - N61



SCALE: 1/8" = 1'-0"
SDR: R2, R3 & 5200
(1/4" THK WALL)

WALL PANEL - N62

SCALE: 1/8" = 1'-0"
SDR: R2, R3 & 5200
(1/4" THK WALL)





WALL PANEL - N63

SCALE: 1/8" = 1'-0"
SDR: R2, R3 & 5200
(1/4" THK WALL)

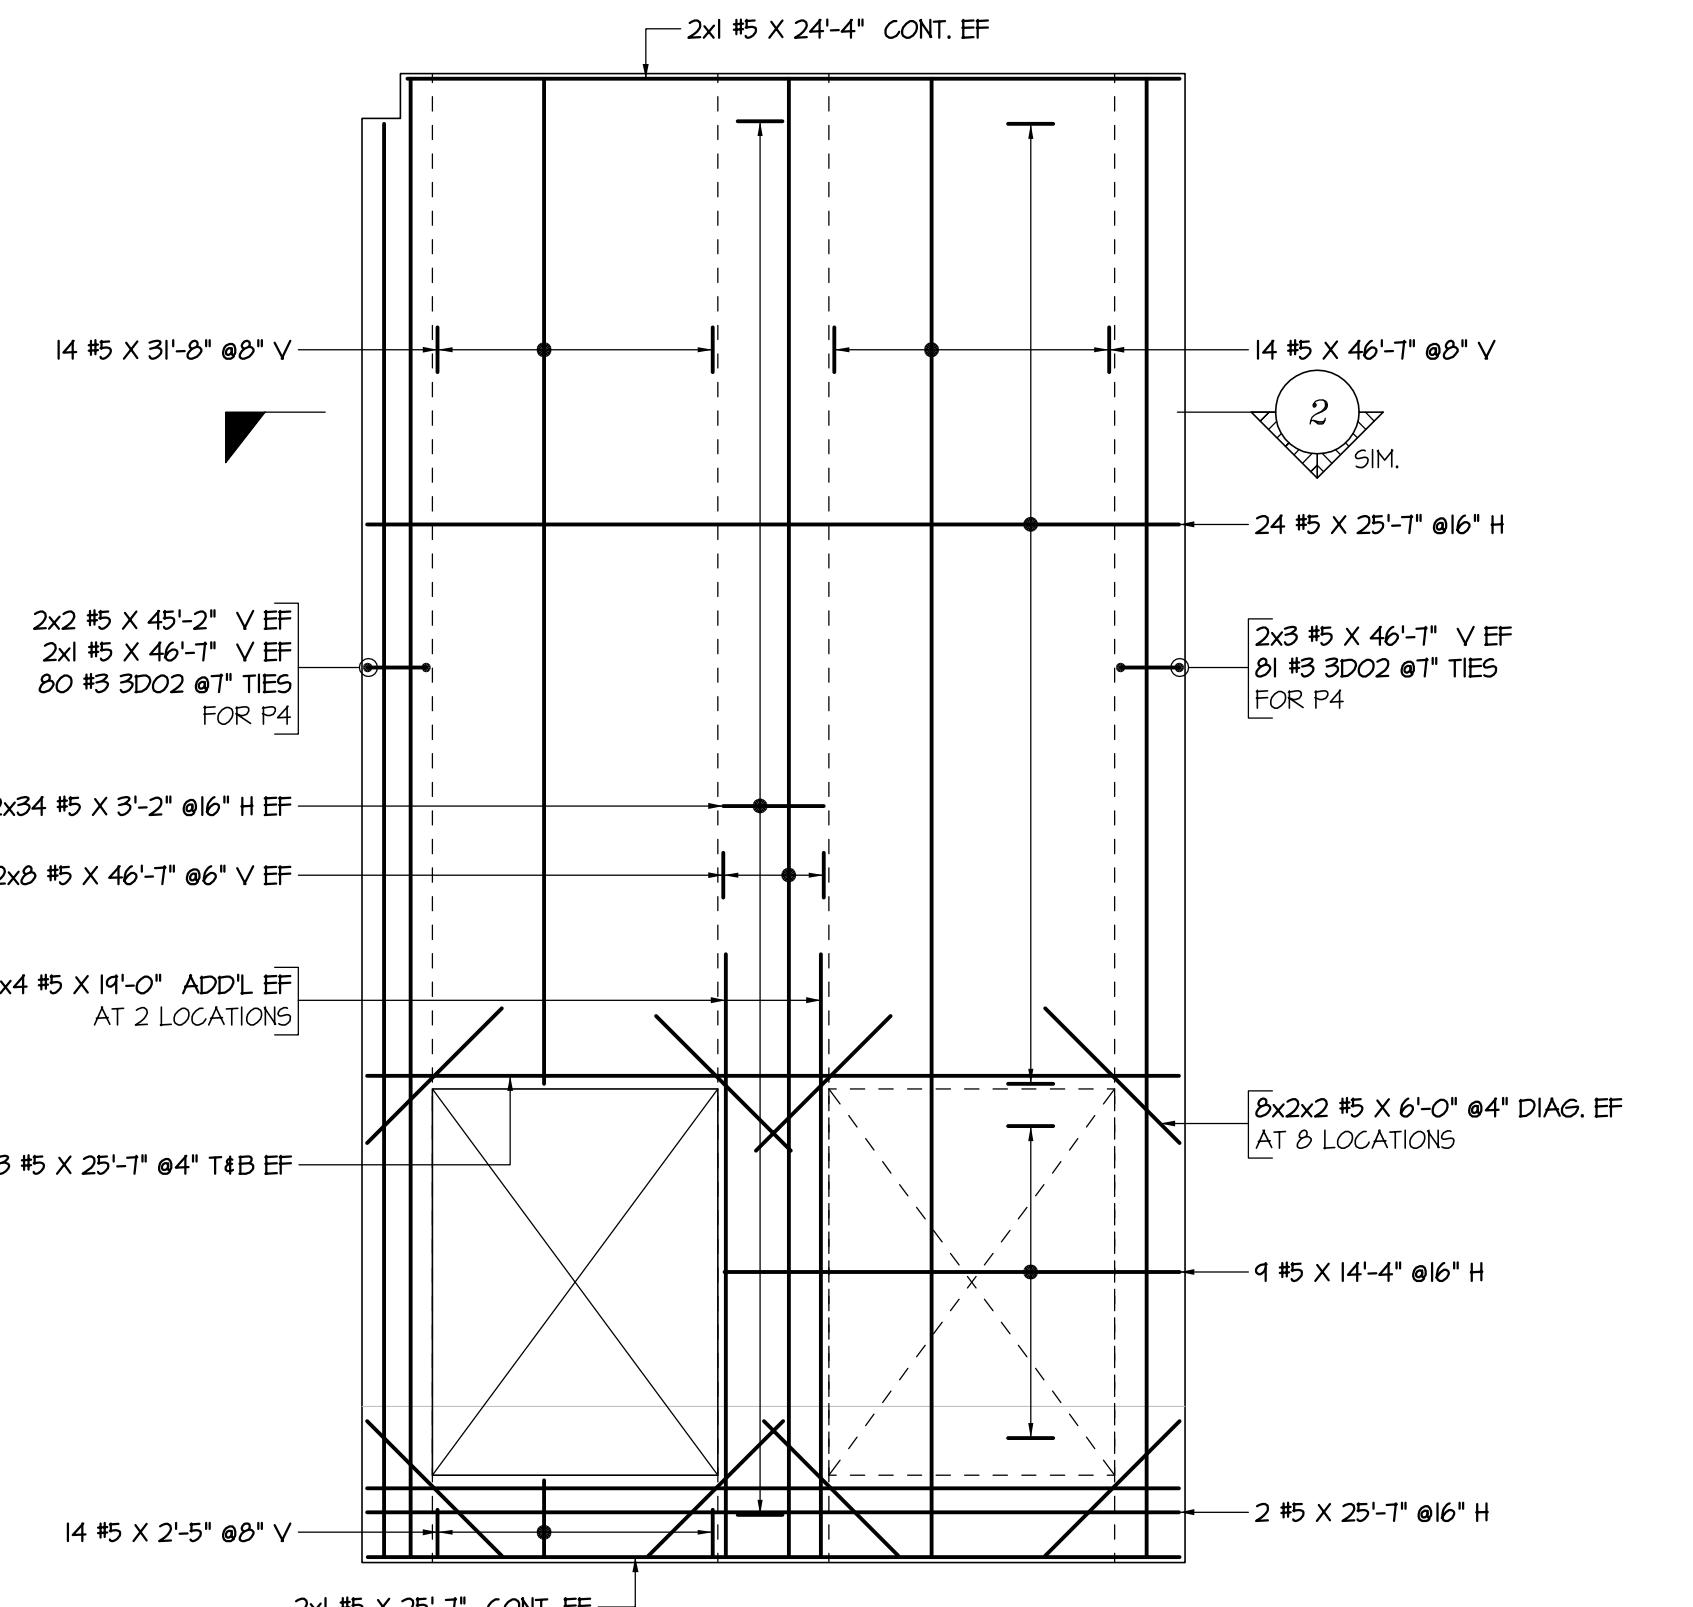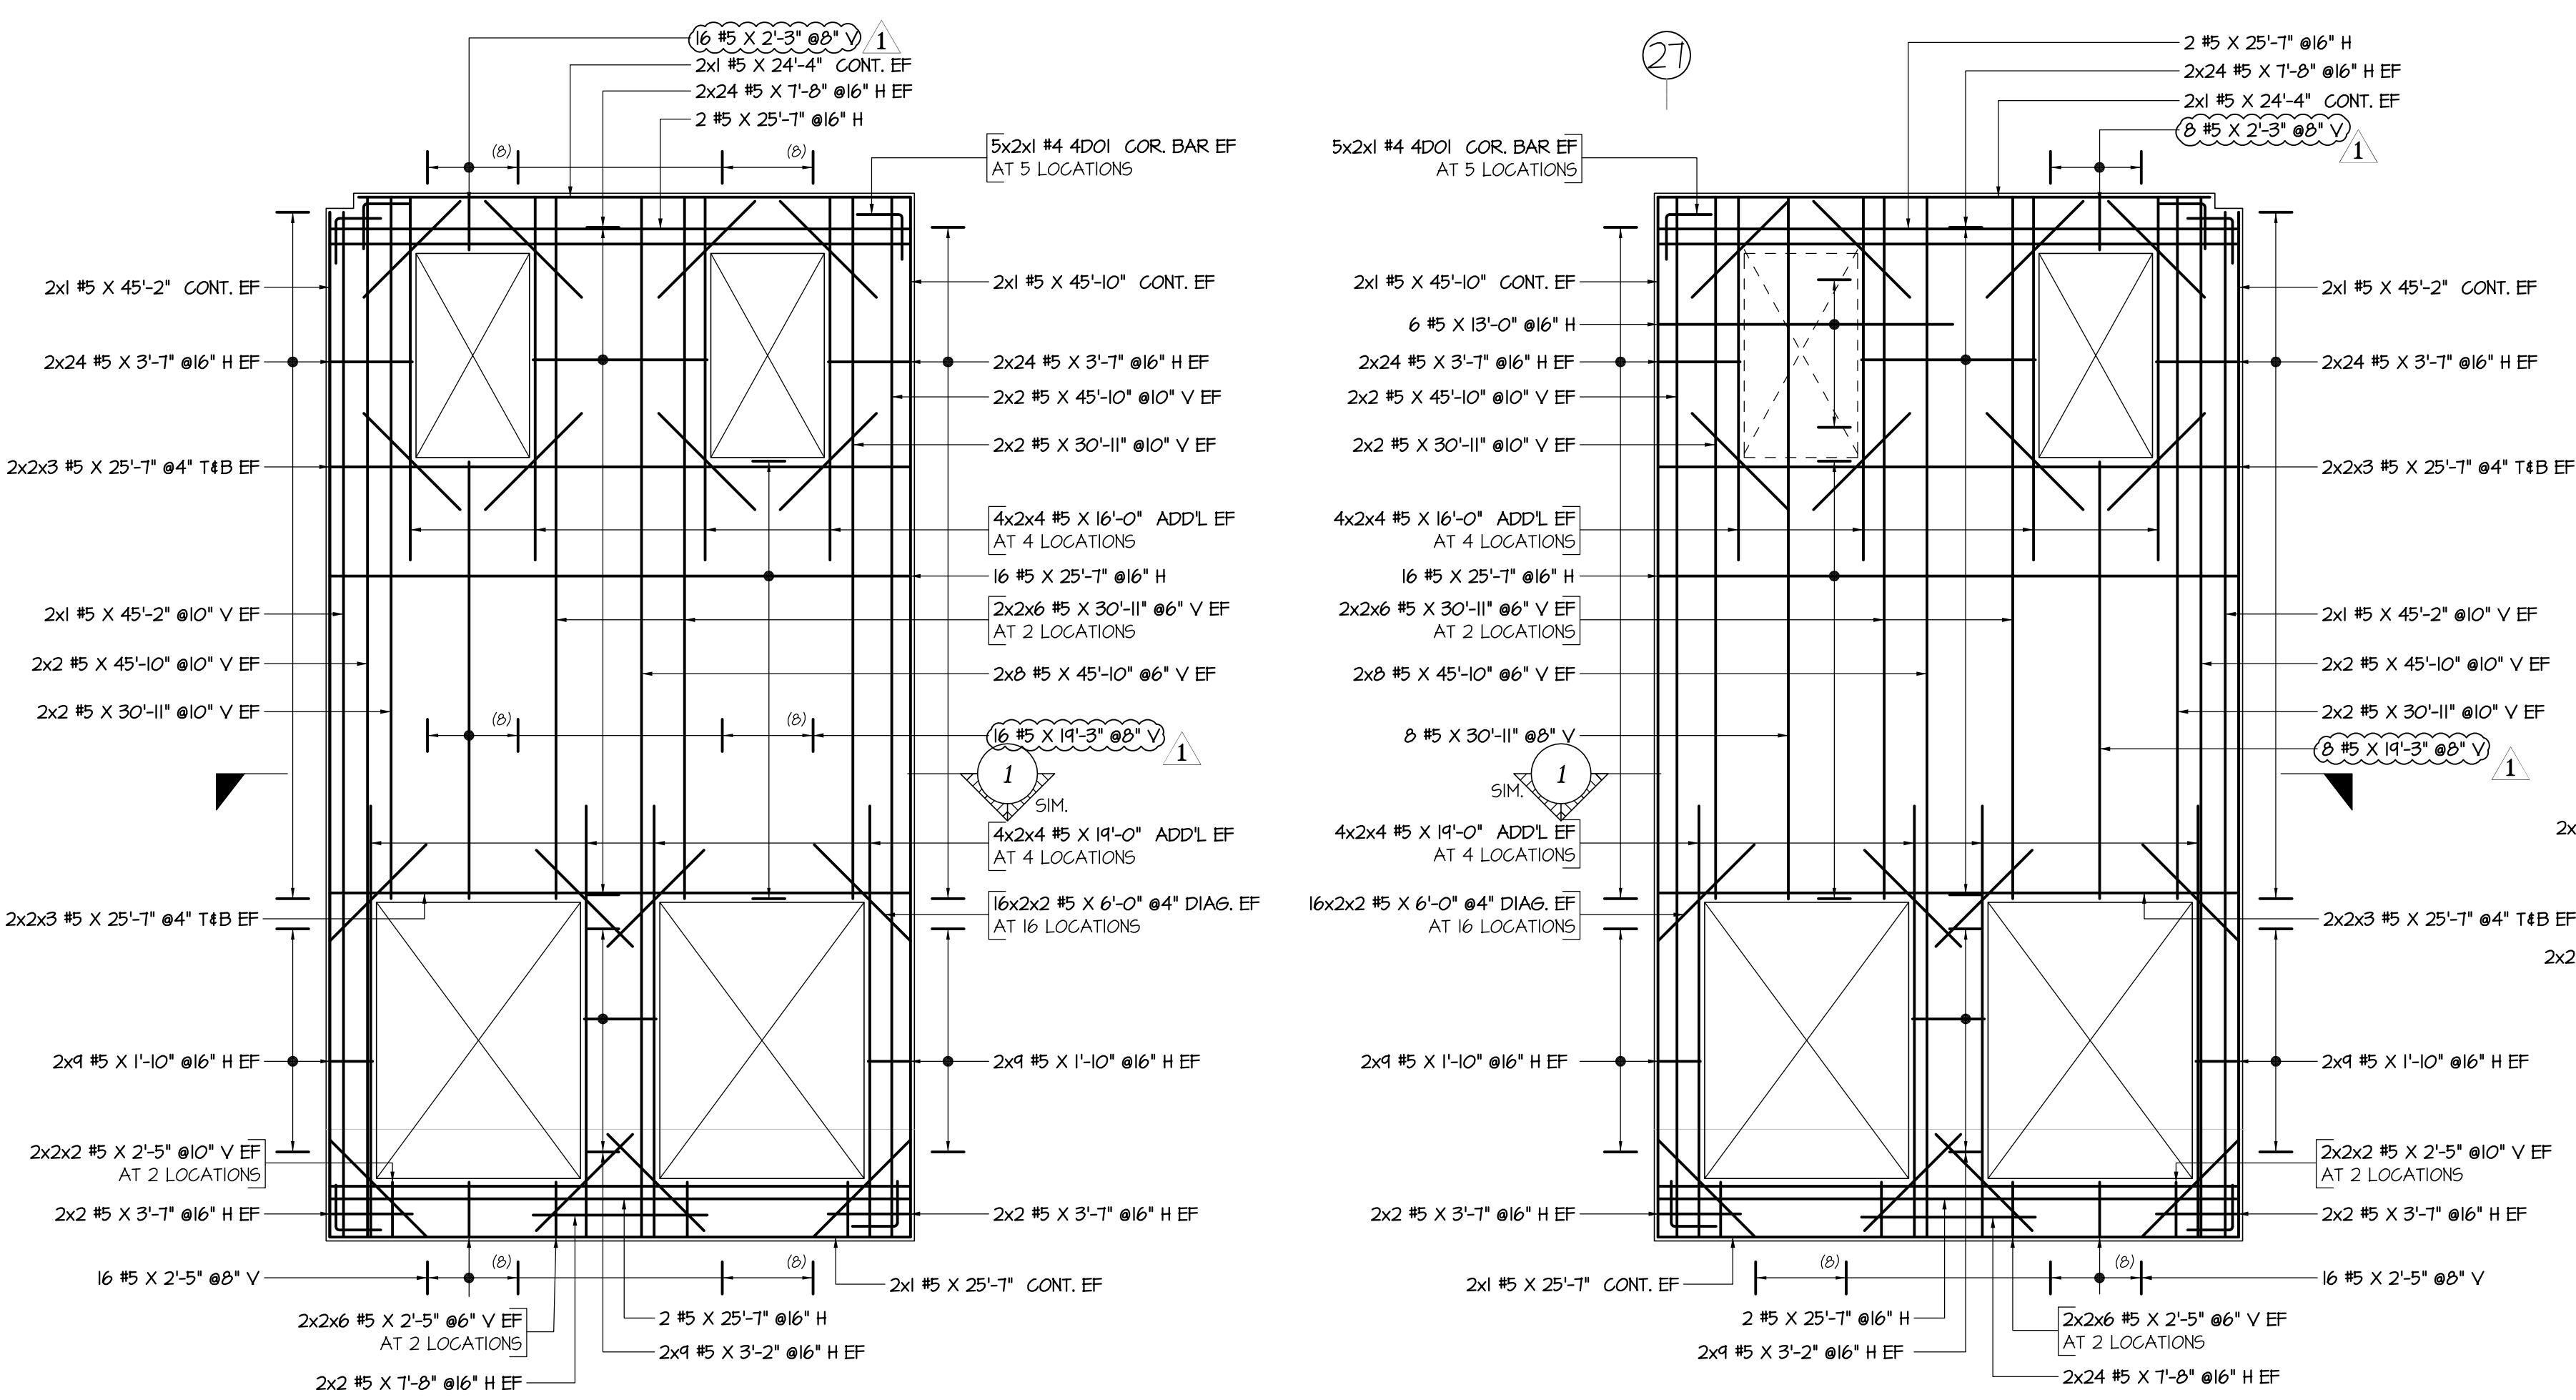


WALL PANEL - N66

SCALE: 1/8" = 1'-0"
SDR: R2, R3 & 5200
(1/4" THK WALL)

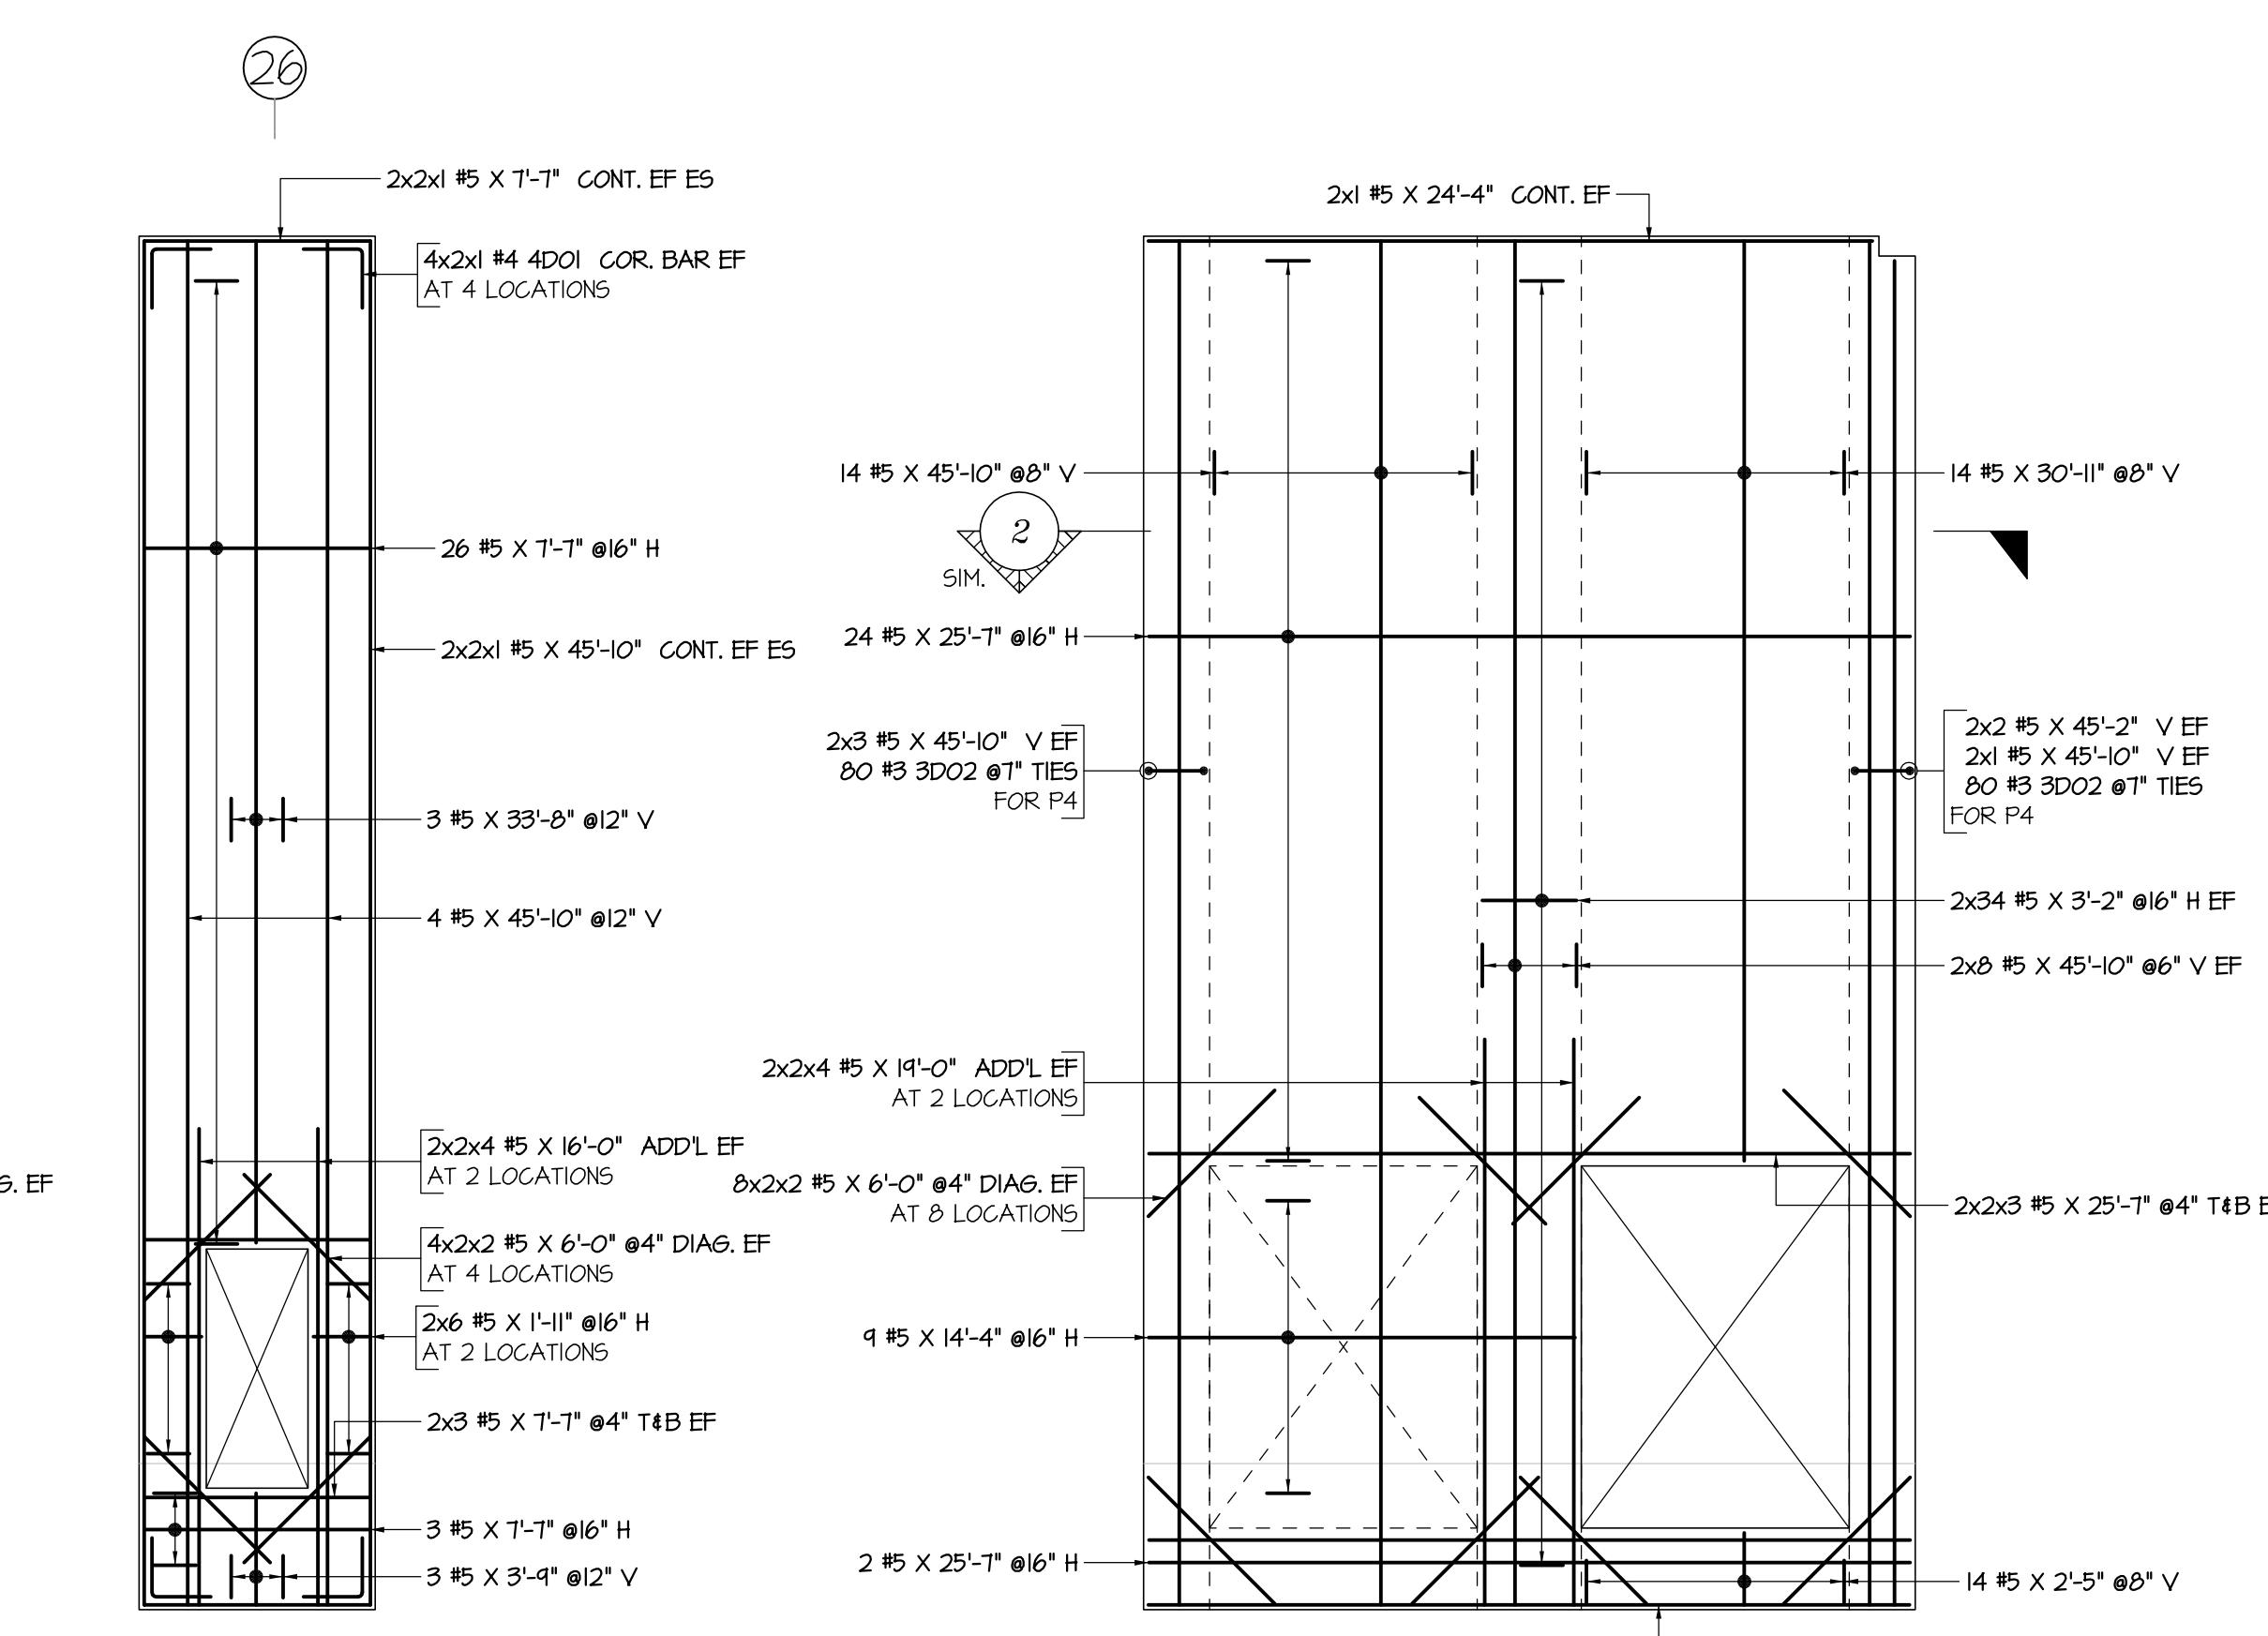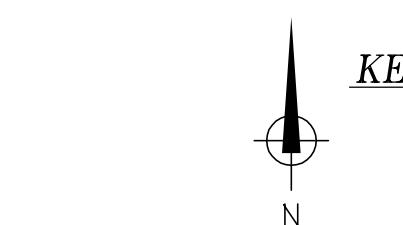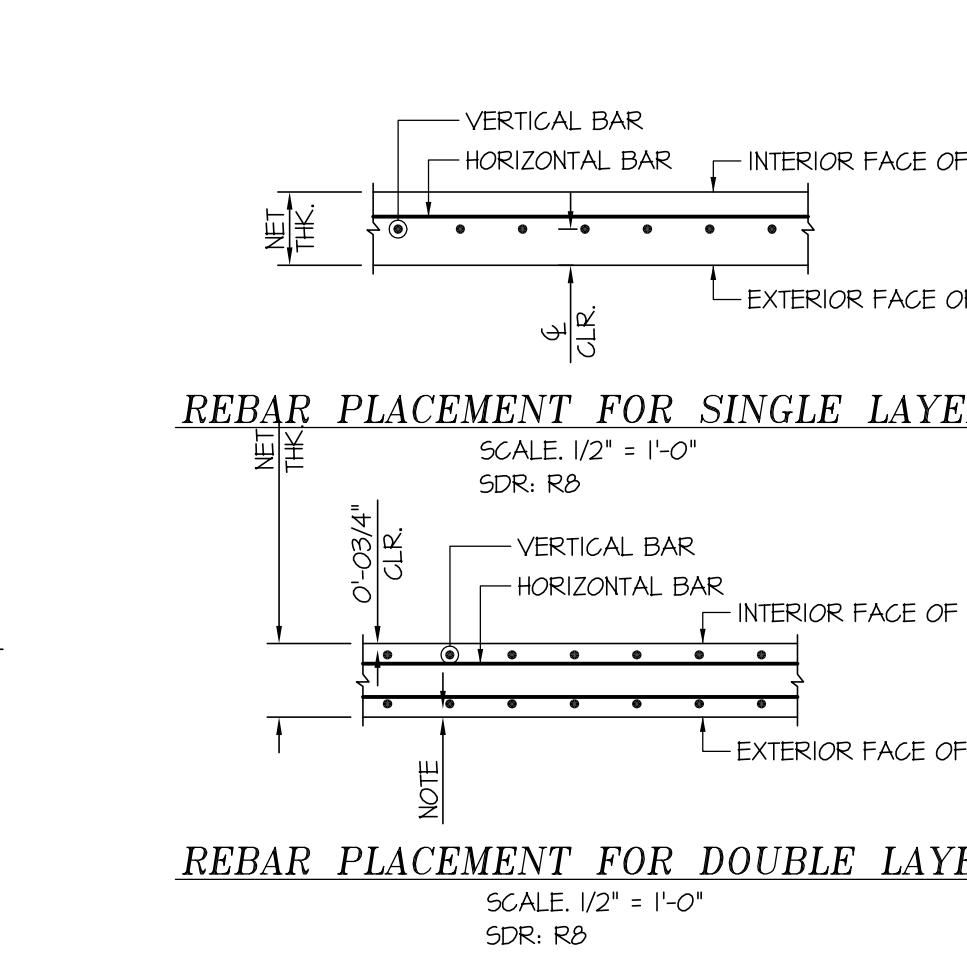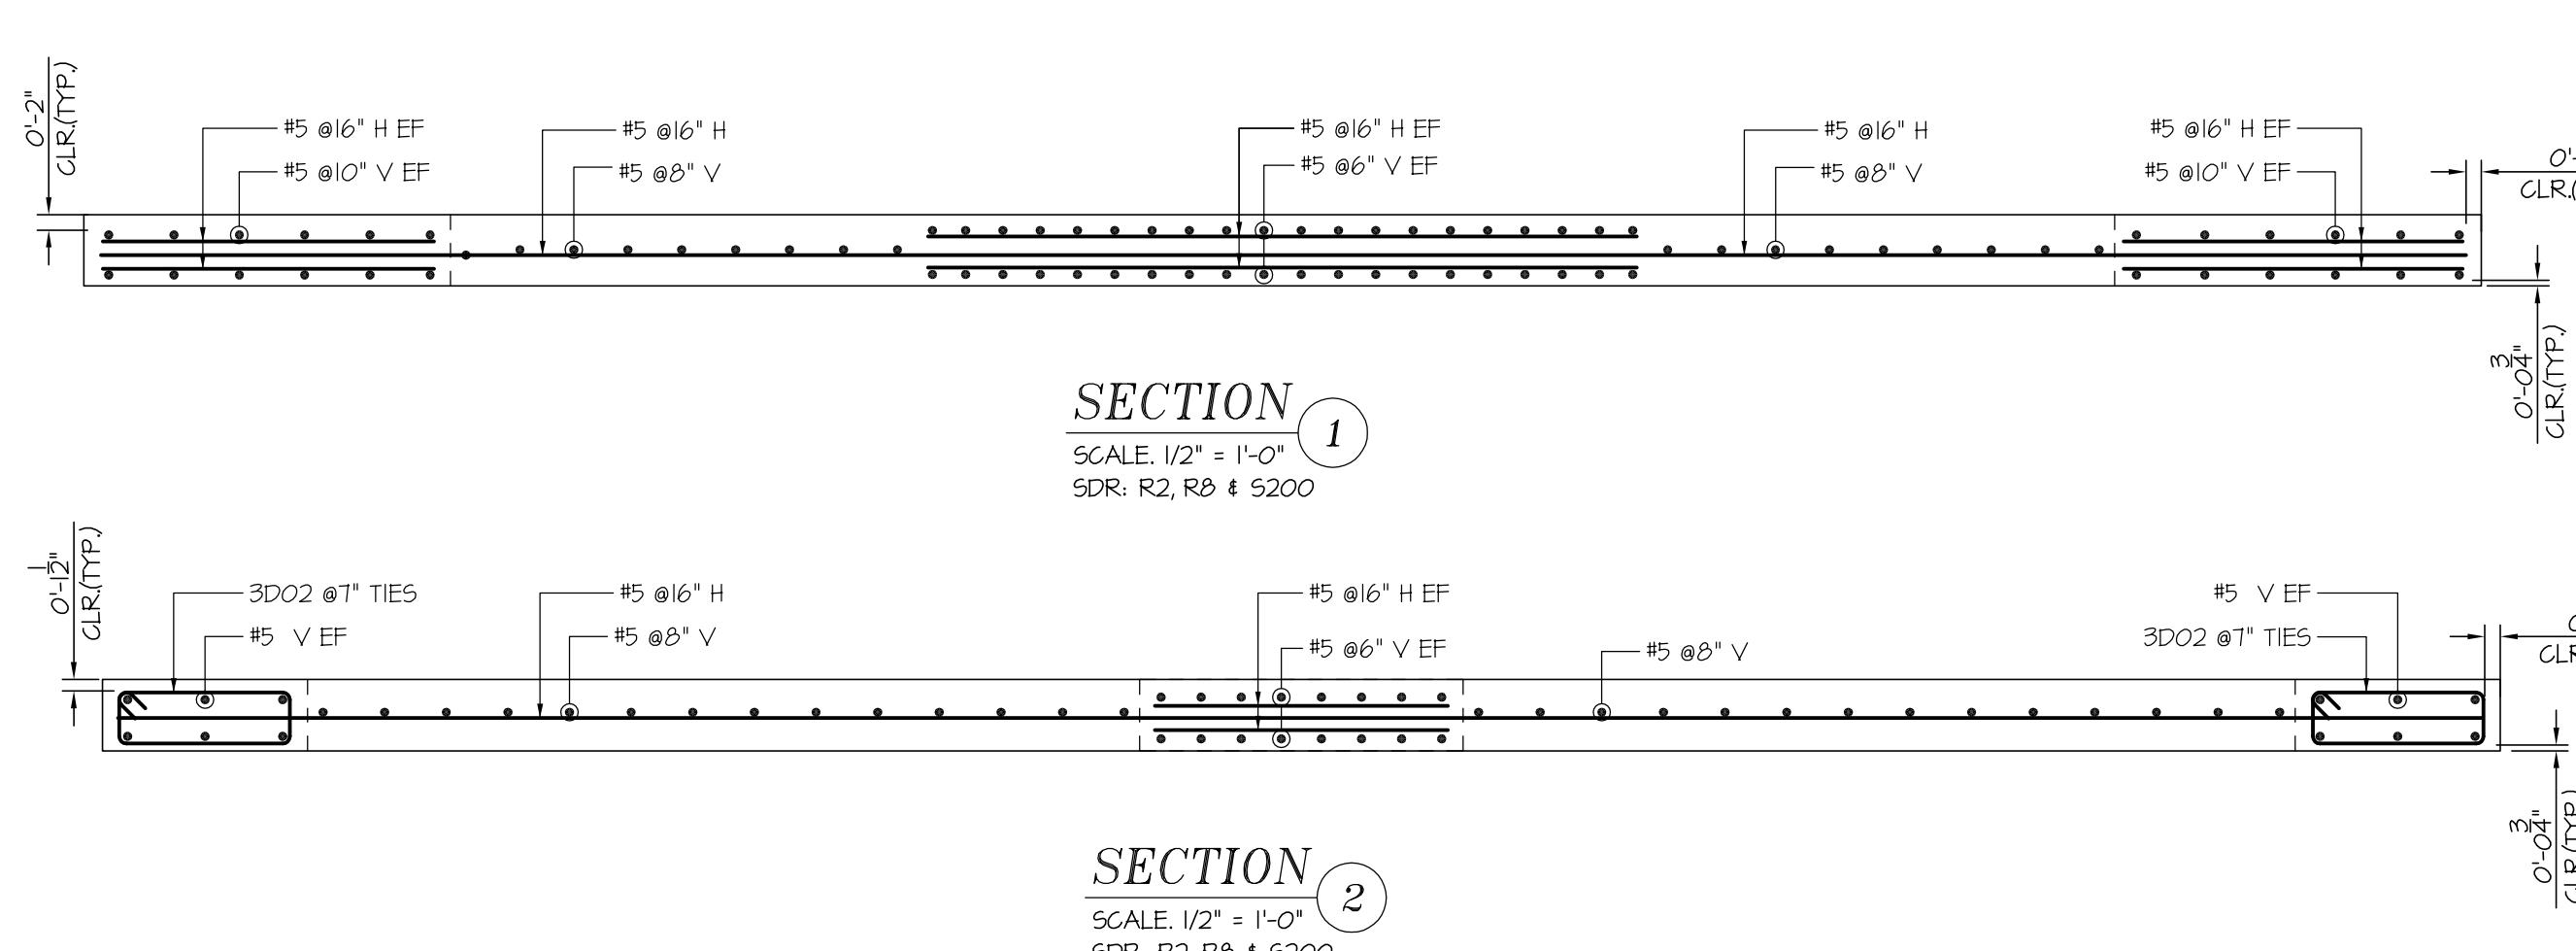

Drawing Sheet : R-12
BENDING DETAILS

Bar Work	Obj	Size	Total Length	Type	X'	Y'	Z'	T'	U'	V'	W'	X'	Y'	Z'	T'	U'	V'	W'
3002	48	f3	5'-7 1/8"	11	0'-4 X'	1'-10 X'	0'-7"	1'-10 X'	0'-7"	1'-10 X'	0'-7"	0'-4 X'	1'-10 X'	0'-7"	1'-10 X'	0'-7"	1'-10 X'	0'-7"
4001	48	f4	4'-9 1/8"	17	2'-0"	2'-0"	2'-0"	2'-0"	2'-0"	2'-0"	2'-0"	2'-0"	2'-0"	2'-0"	2'-0"	2'-0"	2'-0"	2'-0"

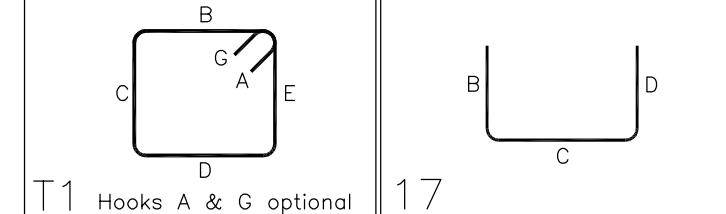


STRUCTURAL NOTES

LEGENDS	LABEL LEGENDS
T - TOP	6x2x6 #4 4C04 @12" B2
B - BOTTOM	NOTES
V, VERT - VERTICAL	SPACING
H, HORIZ - HORIZONTAL	BAR MARK
CLR, CLR - CLEAR COVER	BAR SIZE
SIM, SIM - SIMILAR	NUMBER OF BARS
Typ, Typ - TYPICAL	EACH FACE
T.O.MAT, T.O.MAT - TOP OF MAT	CONTINUOUS
E5, E5 - EACH SIDE	CORNER
Cont, Cont - CONTINUOUS	THICKNESS
Thk, Thk - ADDITIONAL	ADDITIONAL
Addl, Addl - ADDITIONAL	DIAGONAL
Nts, Nts - NOT TO SCALE	-NOT TO SCALE
SDR, SDR - STRUCTURAL DRAWING	REFERENCE
	DENOTES OPENINGS
	DENOTES KNOCK OUTS
	CLEAR COVER TO REINFORCEMENT
	WALL PANEL
	2" AT ENDS
	1 1/2" #5 @ BELOW EXTERIOR FACE
	2" #6 @ ABOVE EXTERIOR FACE
	3/4" AT INTERIOR FACE


NORTH WALL PANELS PLACING DRAWING REFERENCE	
DWG.NO:	DRAWING DESCRIPTION
R-4	NORTH WALL PANELS N-1 TO N-8
R-5	NORTH WALL PANELS N-9 TO N-15
R-6	NORTH WALL PANELS N-16 TO N-22
R-7	NORTH WALL PANELS N-23 TO N-29
R-8	NORTH WALL PANELS N-30 TO N-36
R-9	NORTH WALL PANELS N-37 TO N-43
R-10	NORTH WALL PANELS N-44 TO N-50
R-11	NORTH WALL PANELS N-51 TO N-58
R-12	NORTH WALL PANELS N-59 TO N-66
R-13	NORTH WALL PANELS N-67 TO N-73
R-14	NORTH WALL PANELS N-74 TO N-81

REINFORCING STEEL PLACING DRAWING ONLY. USE IN CONJUNCTION WITH CONTRACT DRAWINGS & SPECIFICATIONS. ELEVATIONS & DIMENSIONS SHOWN ON THIS DRAWING ARE FOR DETAILING PURPOSES ONLY AND SHOULD NOT BE USED FOR CONSTRUCTION UNLESS VERIFIED BY ENGINEER OR CONTRACTOR.


7	
6	
5	
4	
3	
2	06.10.2019 RE SUBMITTED FOR APPROVAL
1	05.24.2019 APPROVAL DATE
	SENT FOR
	RE-STEEL SUPPLY CO., INC.
	REINFORCING STEEL - WIRE MESH
	2000 Eddystone Industrial Park • Eddystone, PA 19022-1588
	Phone: 800-876-8216 • Fax: 610-876-8428
	STRUCTURE VALLEY VIEW BUSINESS PARK TILT PANELS
	LOCATION JESSUP,PA
	ARCHITECT KSS ARCHITECTS
	ENGINEER RICHARD ADAMS
	CUSTOMER T&T CONSTRUCTION
Made by:	Date:
PRO	05.24.2019
	CONTRACT NO. U2524
	DRAWING COVERS NORTH WALL PANELS N-59 TO N-66
	DRAWING NO. R-12
REV. NO.	DATE
06.10.2019	REVISED AS PER LATEST CDS RECEIVED ON 05.31.19
REV. NO.	DESCRIPTION

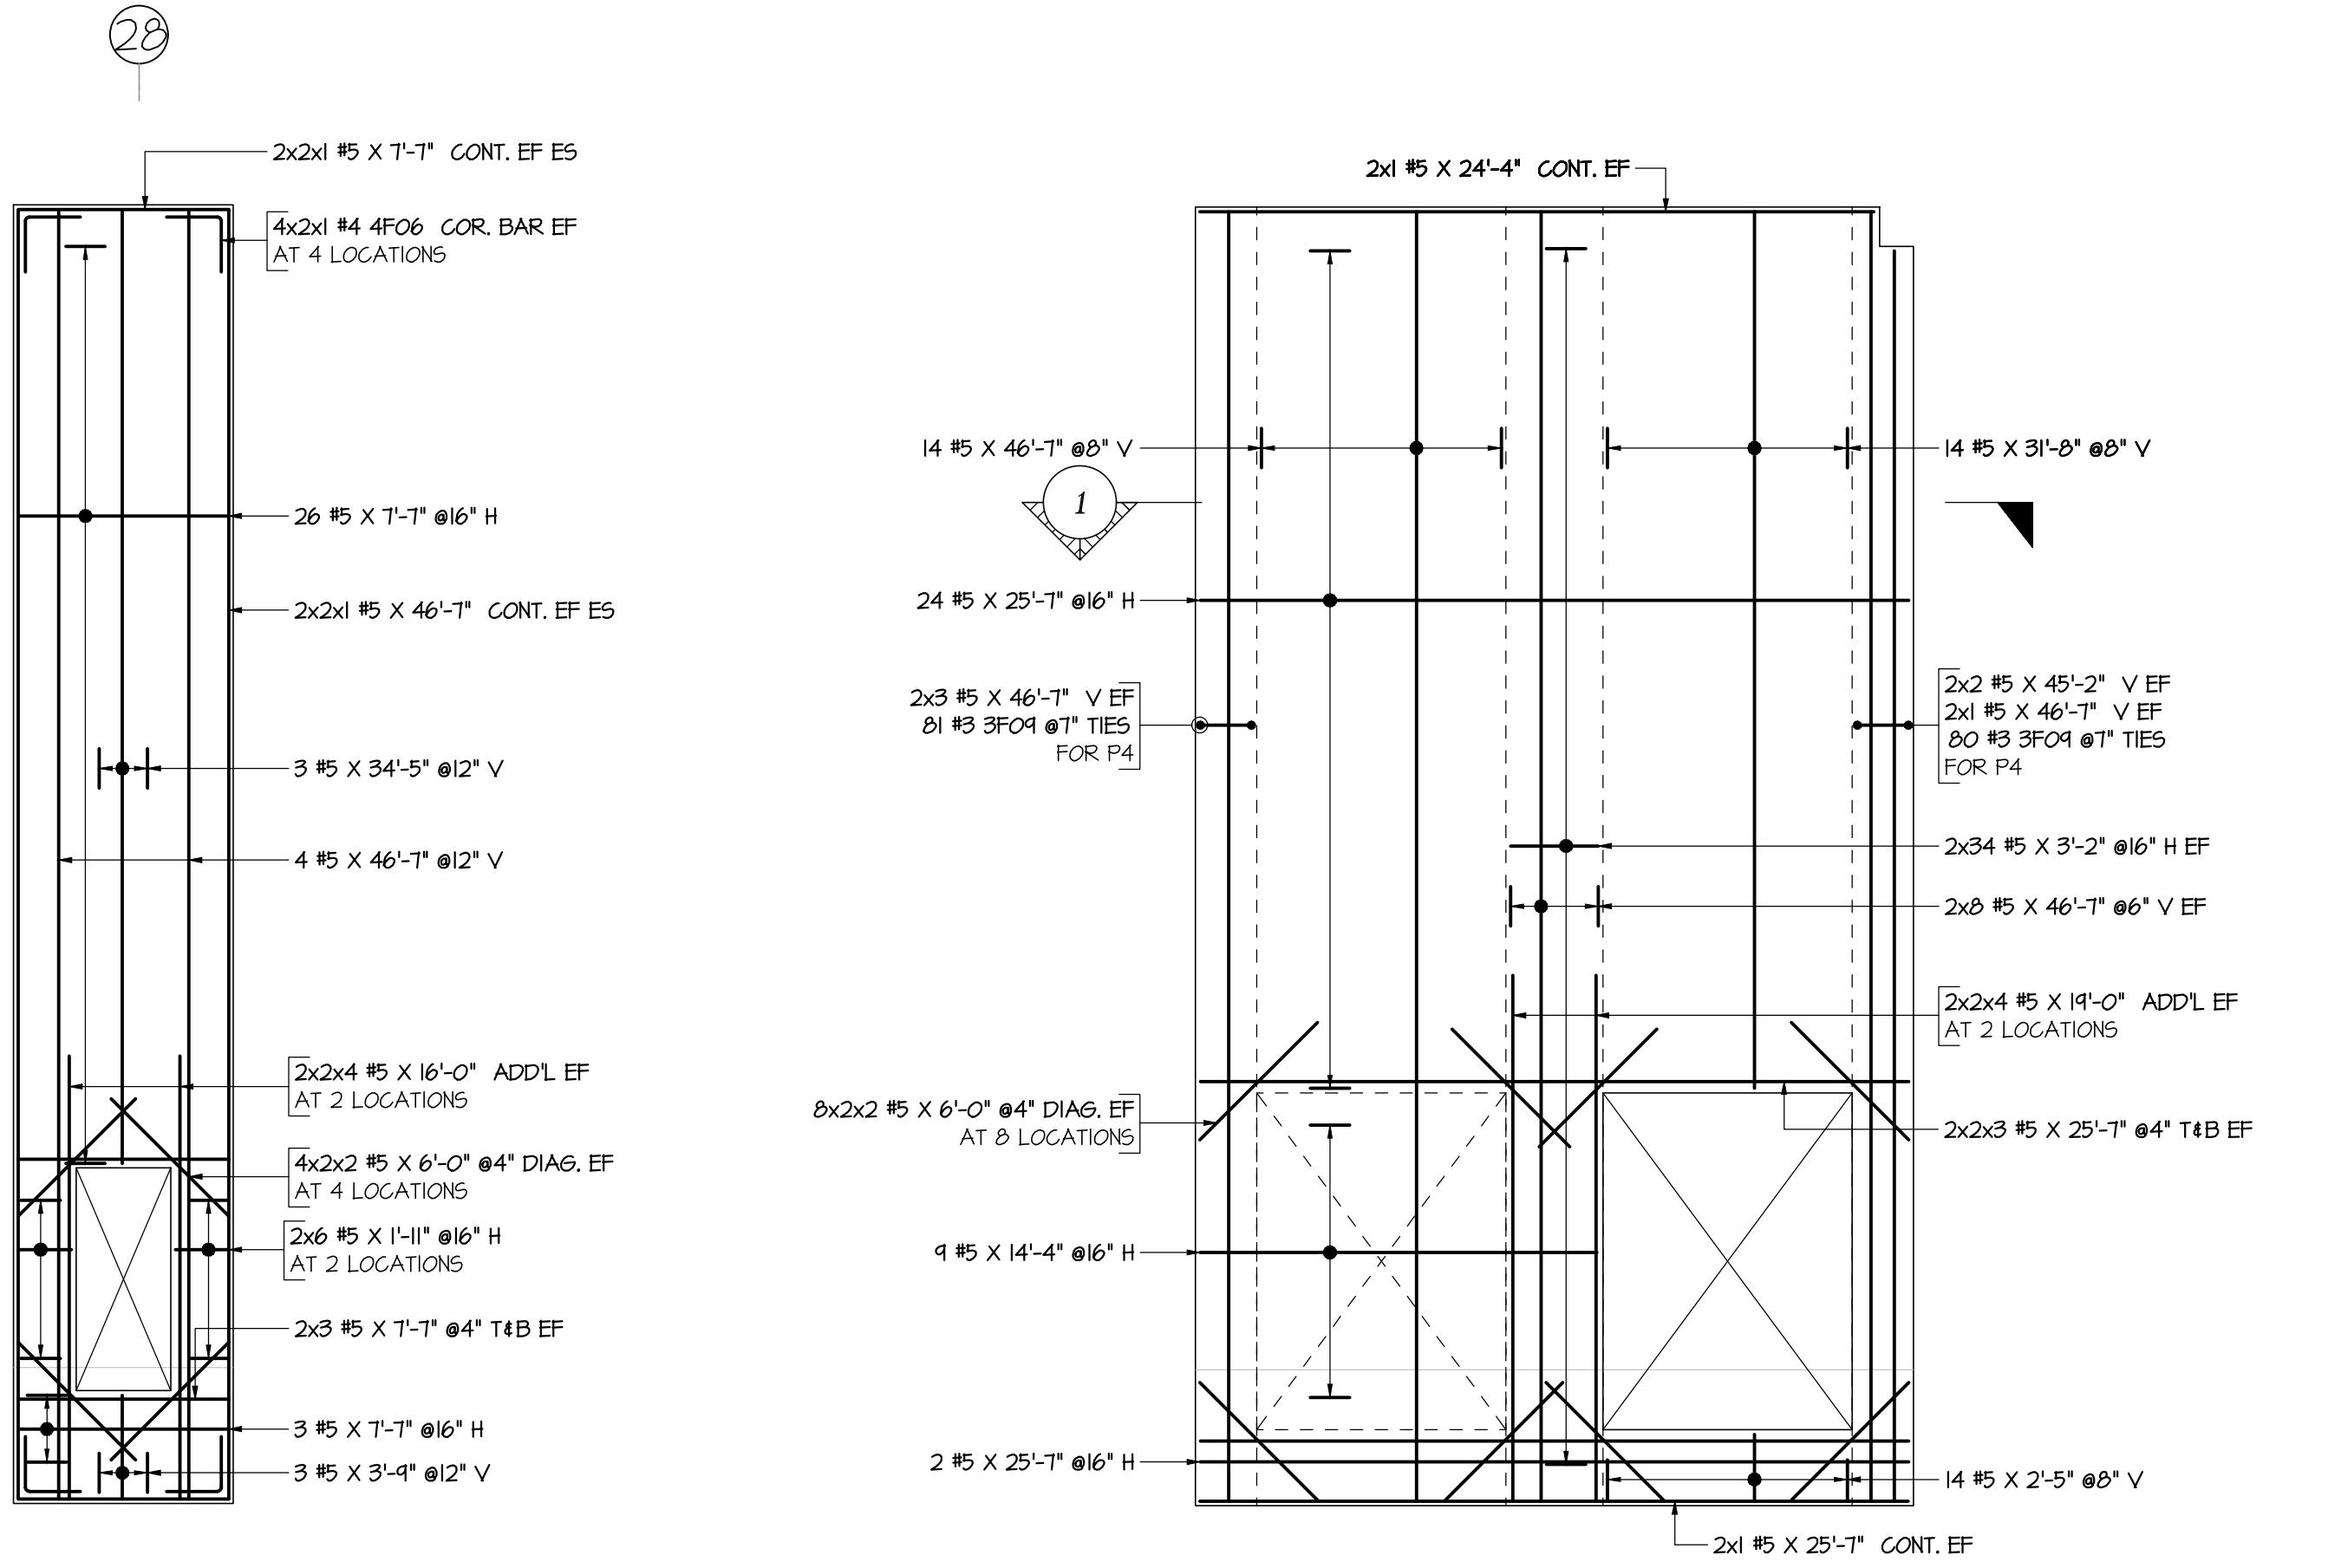

WALL PANEL - N67
SCALE: 1/6" = 1'-0"
SDR: R3, R2 & S200
4 1/4" THK WALL

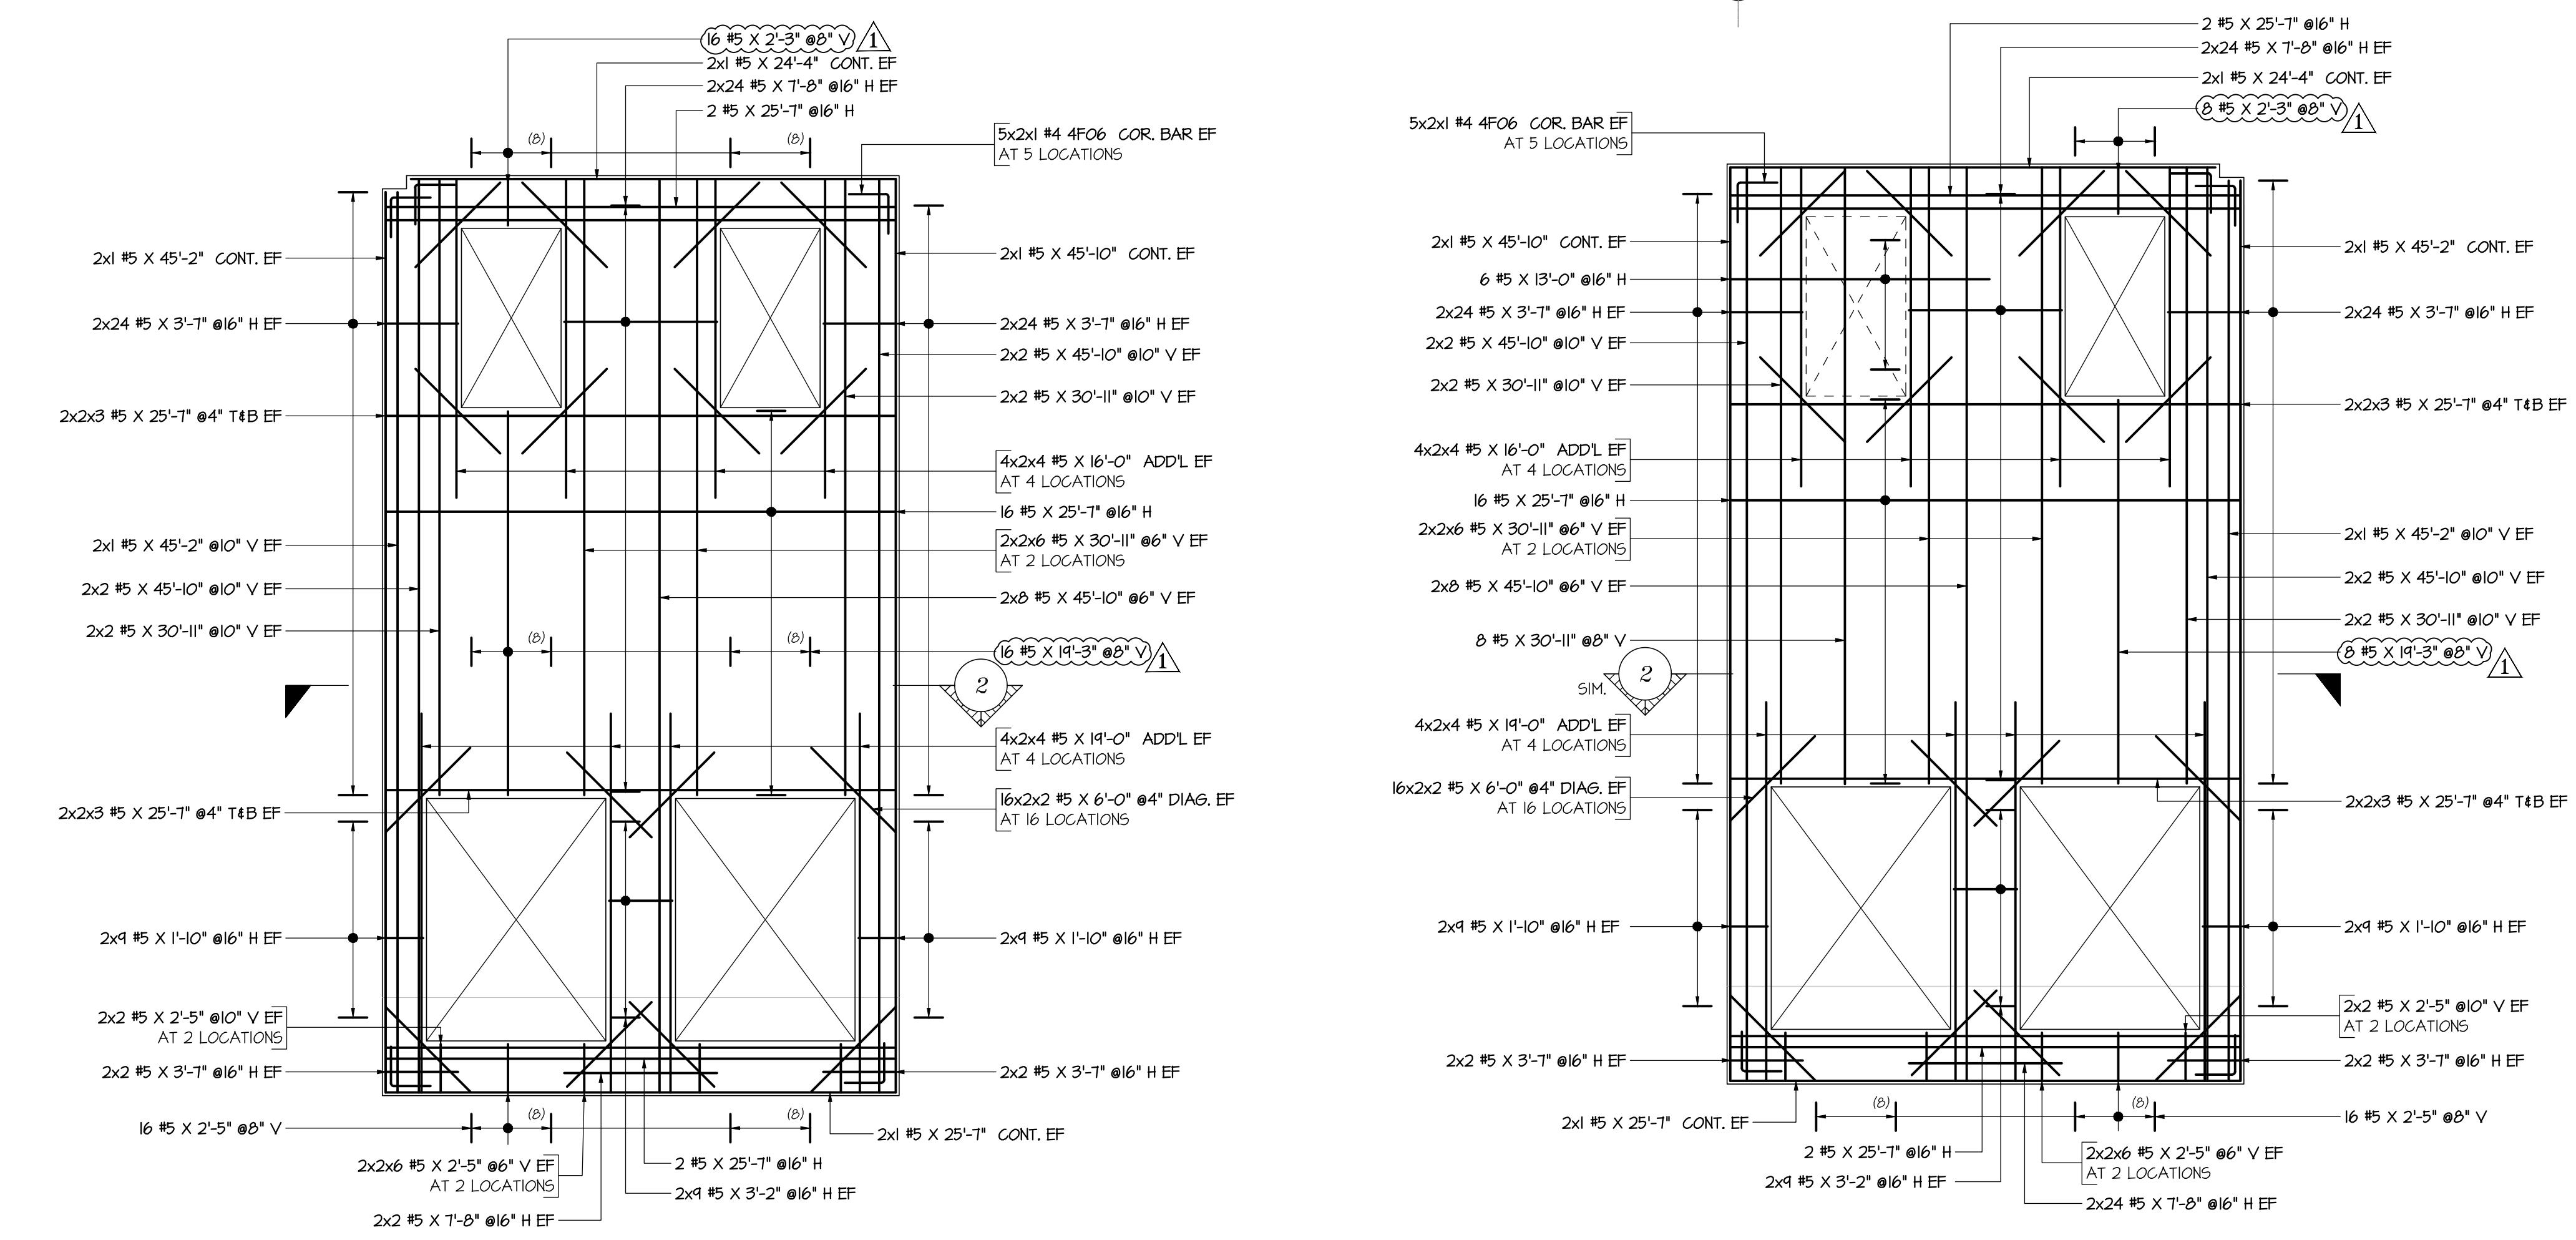


WALL PANEL - N68
SCALE: 1/6" = 1'-0"
SDR: R3, R2 & S200
4 1/4" THK WALL

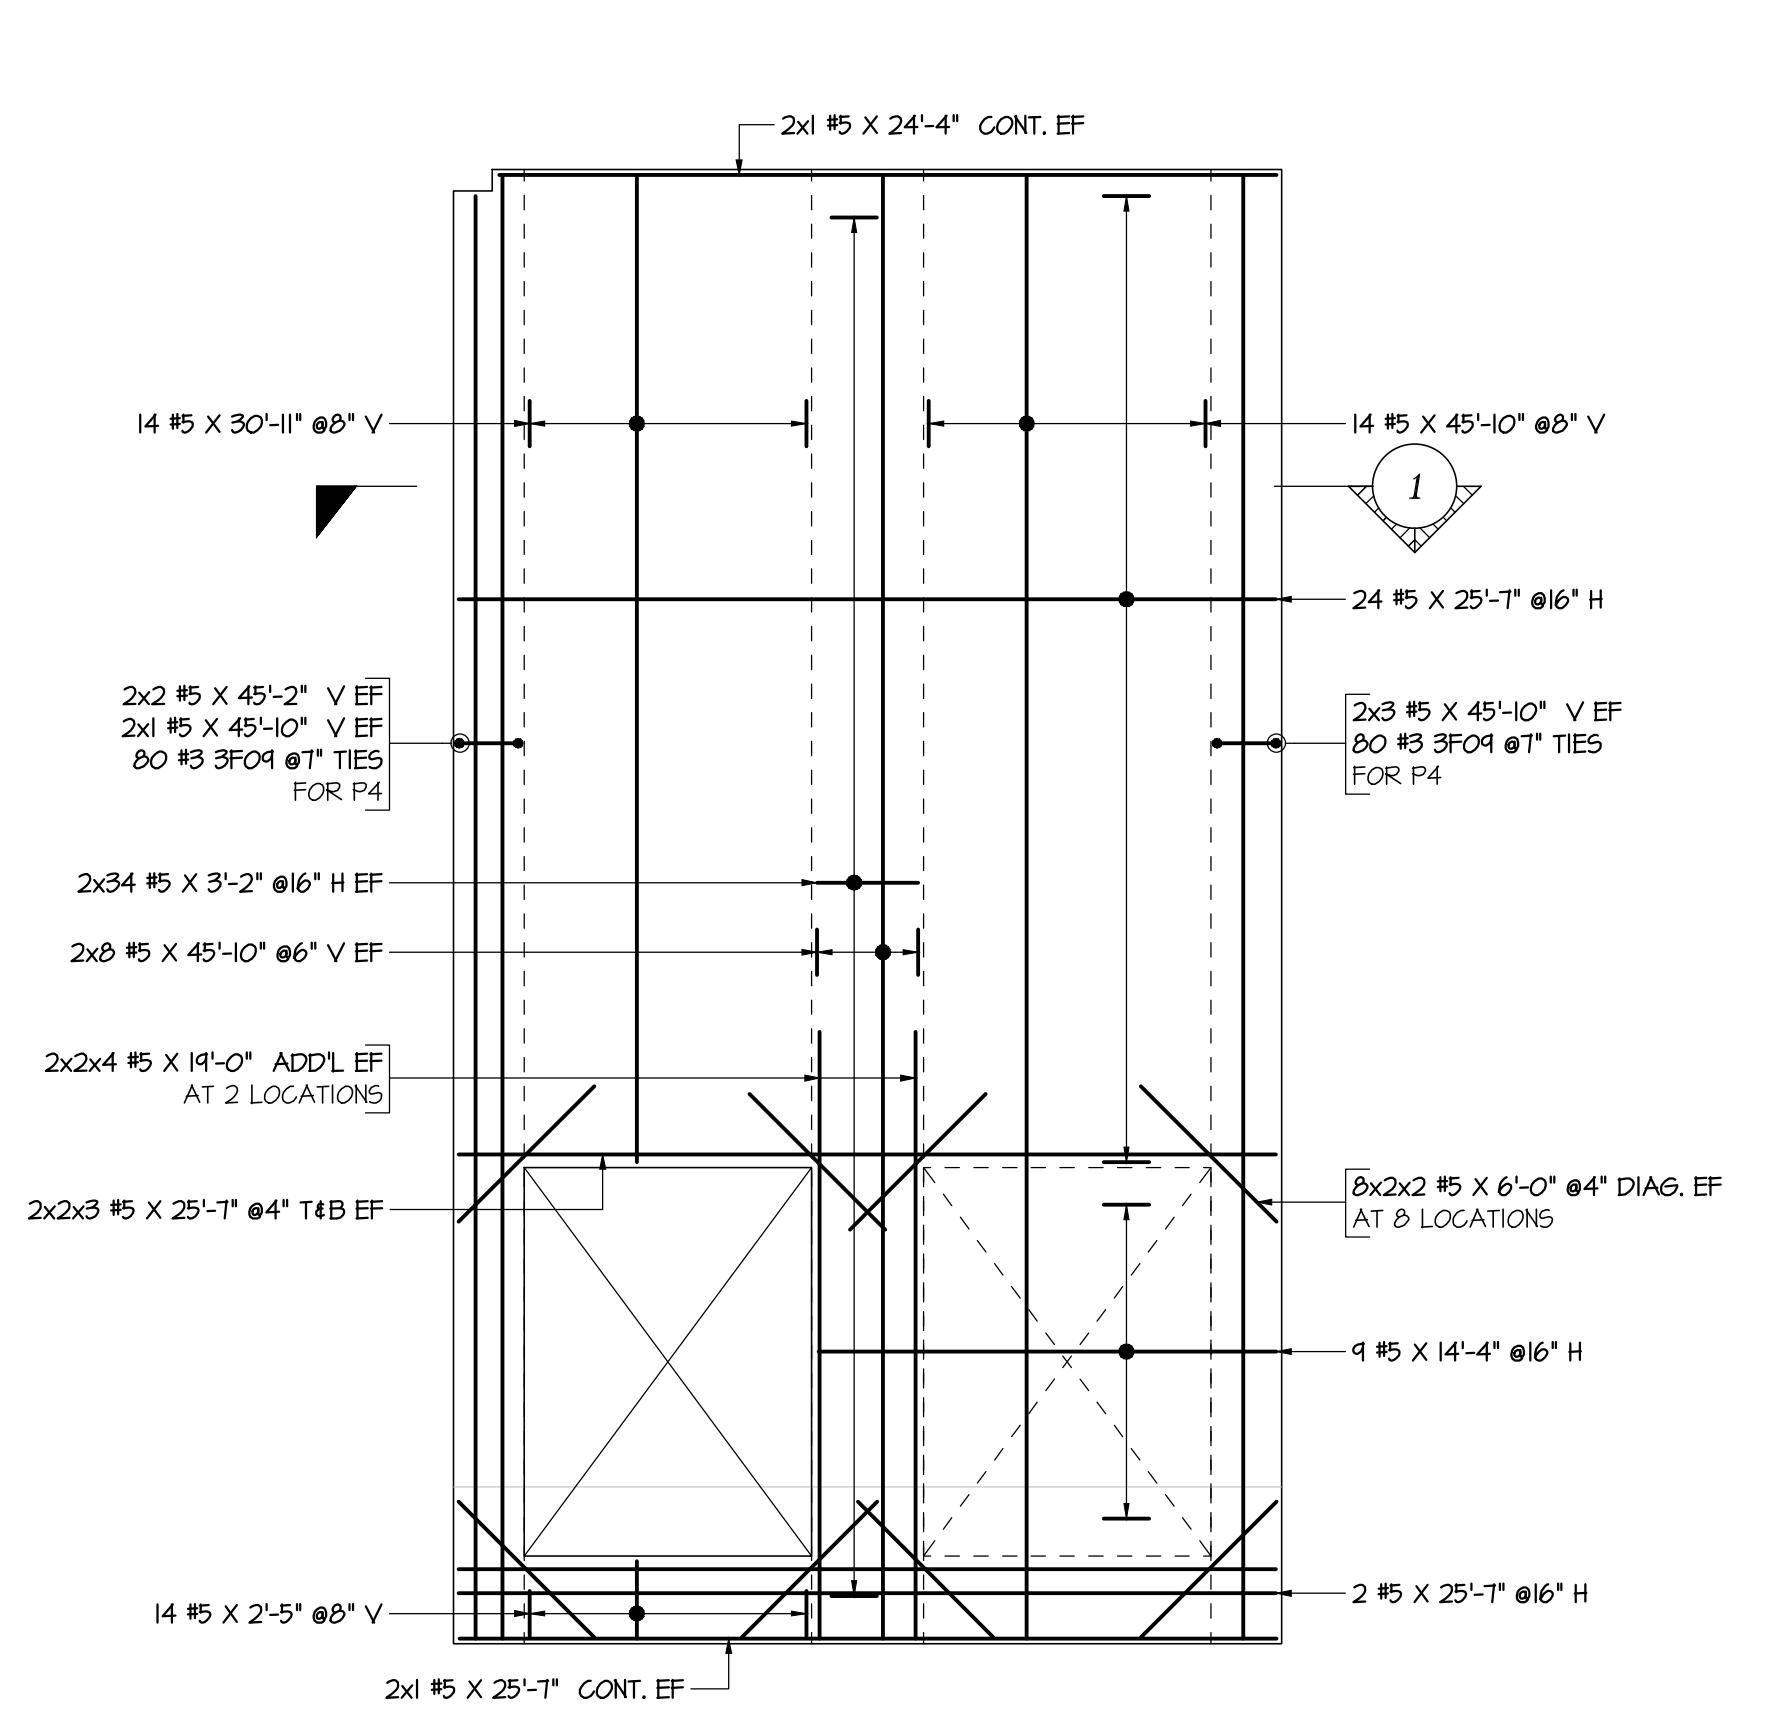

WALL PANEL - N69
SCALE: 1/6" = 1'-0"
SDR: R3, R2 & S200
4 1/4" THK WALL

Drawing Sheet : R-13										BENDING DETAILS									
Bar Mark	Oly	Size	Total Length	Type	A'	B'	C'	D'	E'	F'	G'	H'	I'	J'	K'	L'	M'	N'	O'
3F09	481	#3	5'-7 1/2"	T1	0'-4 1/2"	1'-10 1/2"	0'-7"	1'-10 1/2"	0'-7"	1'-4 1/2"	0'-4 1/2"	2'-0"	2'-0"	2'-0"	2'-0"	2'-0"	2'-0"	2'-0"	
4F06	36	#4	4'-0"	T1	4'-0"	4'-0"	2'-0"	2'-0"	2'-0"	2'-0"	2'-0"	2'-0"	2'-0"	2'-0"	2'-0"	2'-0"	2'-0"	2'-0"	

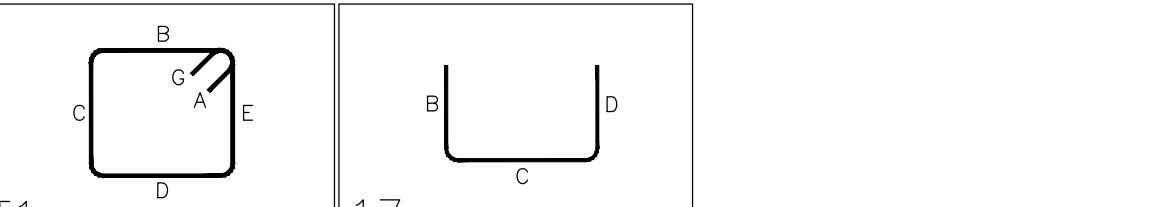

STRUCTURAL NOTES	
LEGENDS	LABEL LEGENDS
T - TOP	6x2x6 #4 4C09 @12" B2
B - BOTTOM	NOTES
V - VERT - VERTICAL	SPACING
H - HORIZ - HORIZONTAL	BAR MARK
CLR - CLR - CLEAR COVER	BAR SIZE
SIM - SIM - SIMILAR	NUMBER OF BARS
typ - typ - TYPICAL	EACH FACE/EACH SIDE
TOP/MAT - TOP OF MAT	NUMBER OF LOCATION
ES - EACH SIDE	
EF - EACH FACE	
CONT - CONTINUOUS	
COR - CORNER	
THK - THICKNESS	
ADDL - ADDITIONAL	
DIAG - DIAGONAL	
NTS - NOT TO SCALE	
C - CENTER LINE	
SDR - STRUCTURAL DRAWING REFERENCE	
	DENOTES OPENINGS
	DENOTES KNOCK OUTS
CLEAR COVER TO REINFORCEMENT	
WALL PANEL	2" AT ENDS
	1 1/2" #5 @ BELOW AT EXTERIOR FACE
	3" #6 @ ABOVE AT EXTERIOR FACE
	3/4" AT INTERIOR FACE


NORTH WALL PANELS	
PLACING DRAWING REFERENCE	
DWG.NO:	DRAWING DESCRIPTION
R-4	NORTH WALL PANELS N-1 TO N-8
R-5	NORTH WALL PANELS N-9 TO N-15
R-6	NORTH WALL PANELS N-16 TO N-22
R-7	NORTH WALL PANELS N-23 TO N-29
R-8	NORTH WALL PANELS N-30 TO N-36
R-9	NORTH WALL PANELS N-37 TO N-43
R-10	NORTH WALL PANELS N-44 TO N-50
R-II	NORTH WALL PANELS N-51 TO N-58
R-12	NORTH WALL PANELS N-59 TO N-66
R-13	NORTH WALL PANELS N-67 TO N-73
R-14	NORTH WALL PANELS N-74 TO N-81

REINFORCING STEEL PLACING DRAWING ONLY. USE IN CONJUNCTION WITH CONTRACT DRAWINGS & SPECIFICATIONS. ELEVATIONS & DIMENSIONS SHOWN ON THIS DRAWING ARE FOR DETAILING PURPOSES ONLY AND SHOULD NOT BE USED FOR CONSTRUCTION UNLESS VERIFIED BY ENGINEER OR CONTRACTOR.

WALL PANEL - N71
SCALE: 1/6" = 1'-0"
SDR: R3, R2 & S200
4 1/4" THK WALL



WALL PANEL - N72
SCALE: 1/6" = 1'-0"
SDR: R3, R2 & S200
4 1/4" THK WALL

WALL PANEL - N73
SCALE: 1/6" = 1'-0"
SDR: R3, R2 & S200
4 1/4" THK WALL

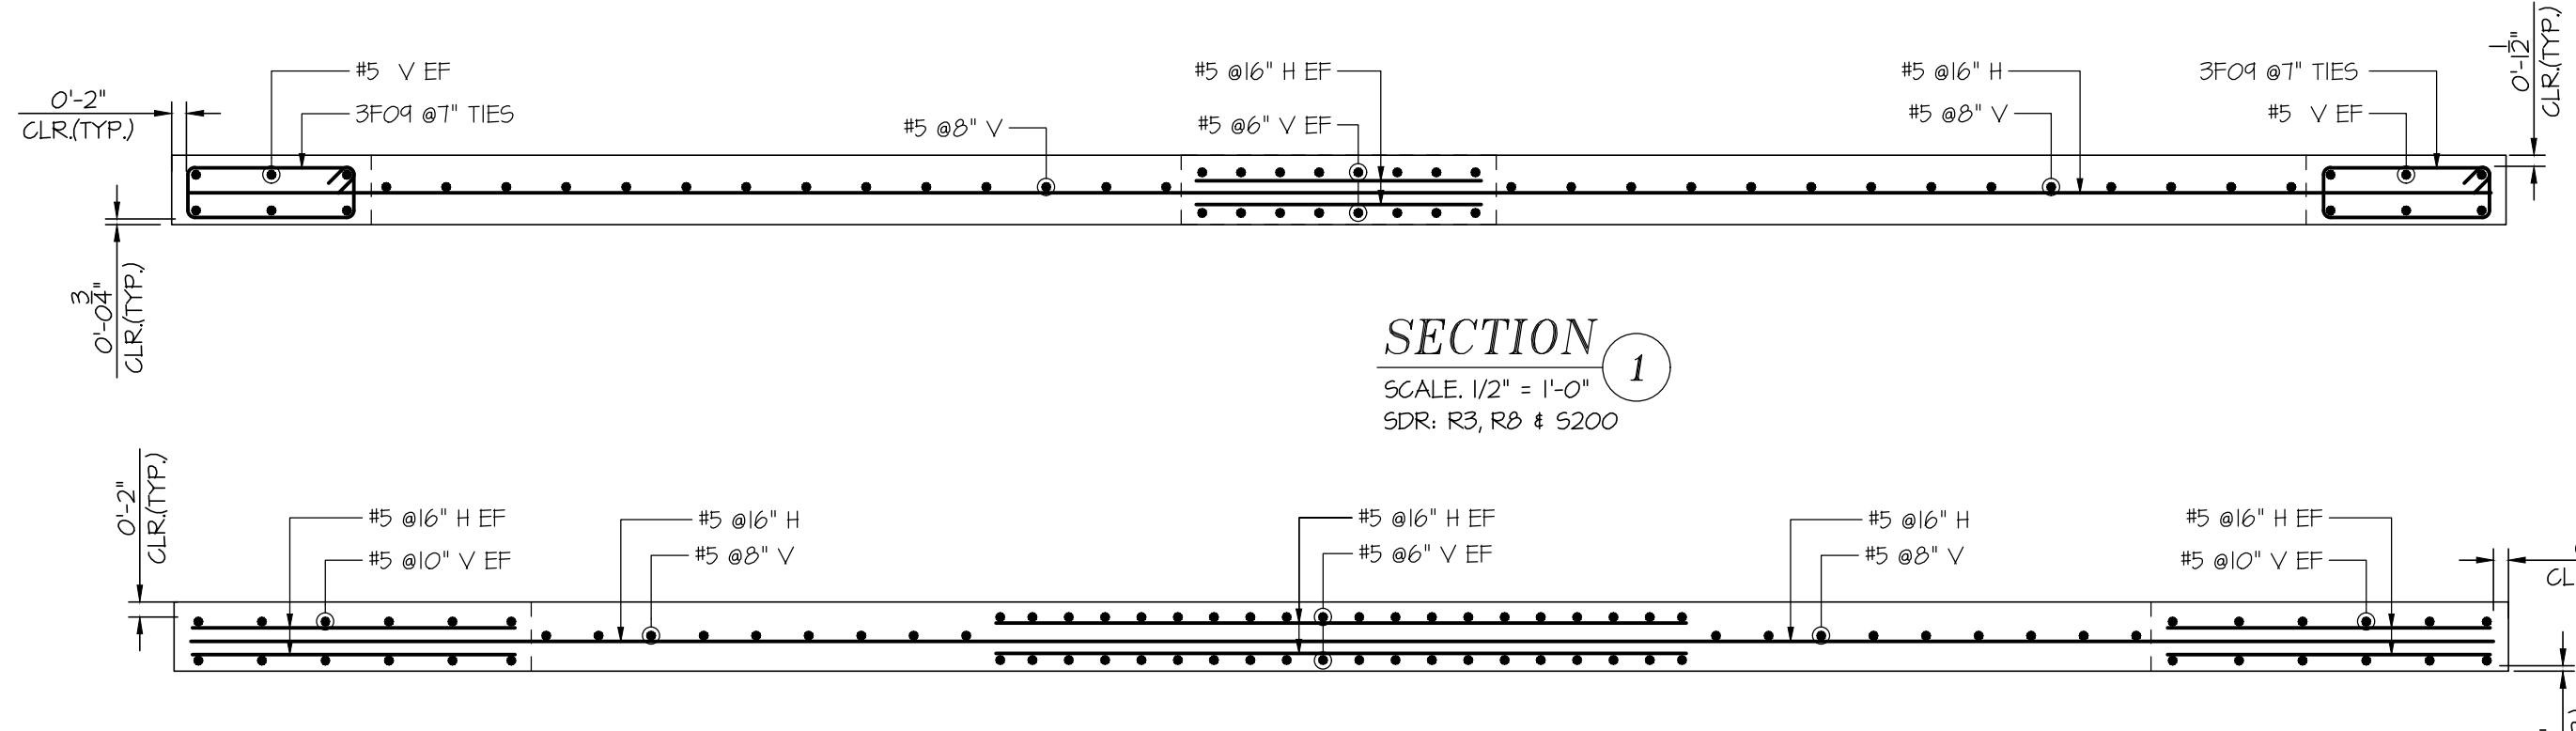


SECTION 1
SCALE: 1/2" = 1'-0"
SDR: R3, R2 & S200

SECTION 2
SCALE: 1/2" = 1'-0"
SDR: R3, R2 & S200

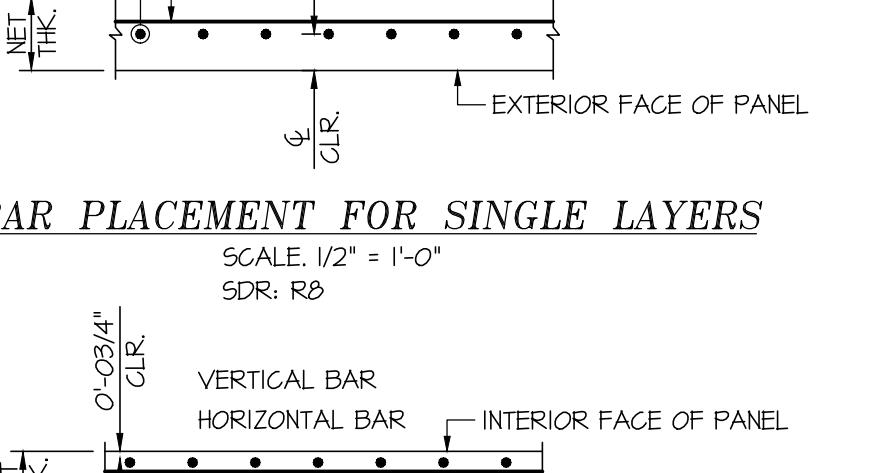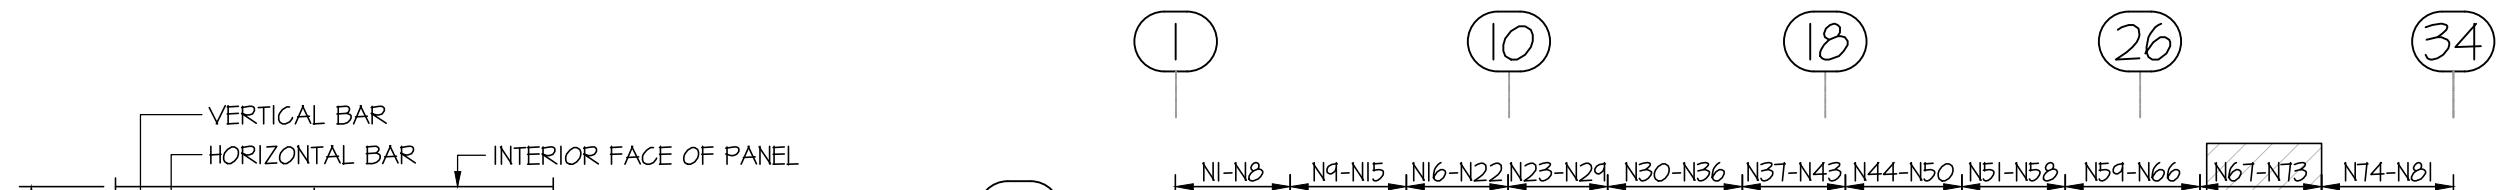


REBAR PLACEMENT FOR SINGLE LAYERS
SCALE: 1/2" = 1'-0"
SDR: R3

REBAR PLACEMENT FOR DOUBLE LAYERS
SCALE: 1/2" = 1'-0"
SDR: R3

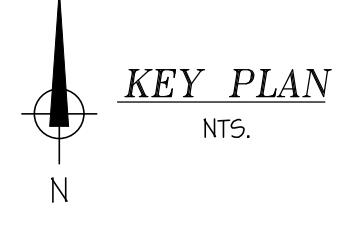

7		
6		
5		
4		
3		
2	06.10.2019	RE SUBMITTED FOR APPROVAL
1	05.24.2019	APPROVAL DATE SENT FOR
RE-STEEL SUPPLY CO., INC.		
REINFORCING STEEL • WIRE MESH		
2000 Eddystone Industrial Park • Eddystone, PA 19022-1588		
Phone: 800-876-8216 • Fax: 610-876-8428		
Structure	VALLEY VIEW BUSINESS PARK TILT PANELS	
Location	JESSUP, PA	
Architect	KSS ARCHITECTS	
Engineer	RICHARD ADAMS	
Customer	T&T CONSTRUCTION	
Made by:	Date:	CONTRACT NO.
PRO	05.24.2019	U2524
DRAWING COVERS		DRAWING NO.
NORTH WALL PANELS		R-13
REV. NO.	DATE	DESCRIPTION
06.10.2019		REVISED AS PER LATEST CD'S RECEIVED ON 05.31.19

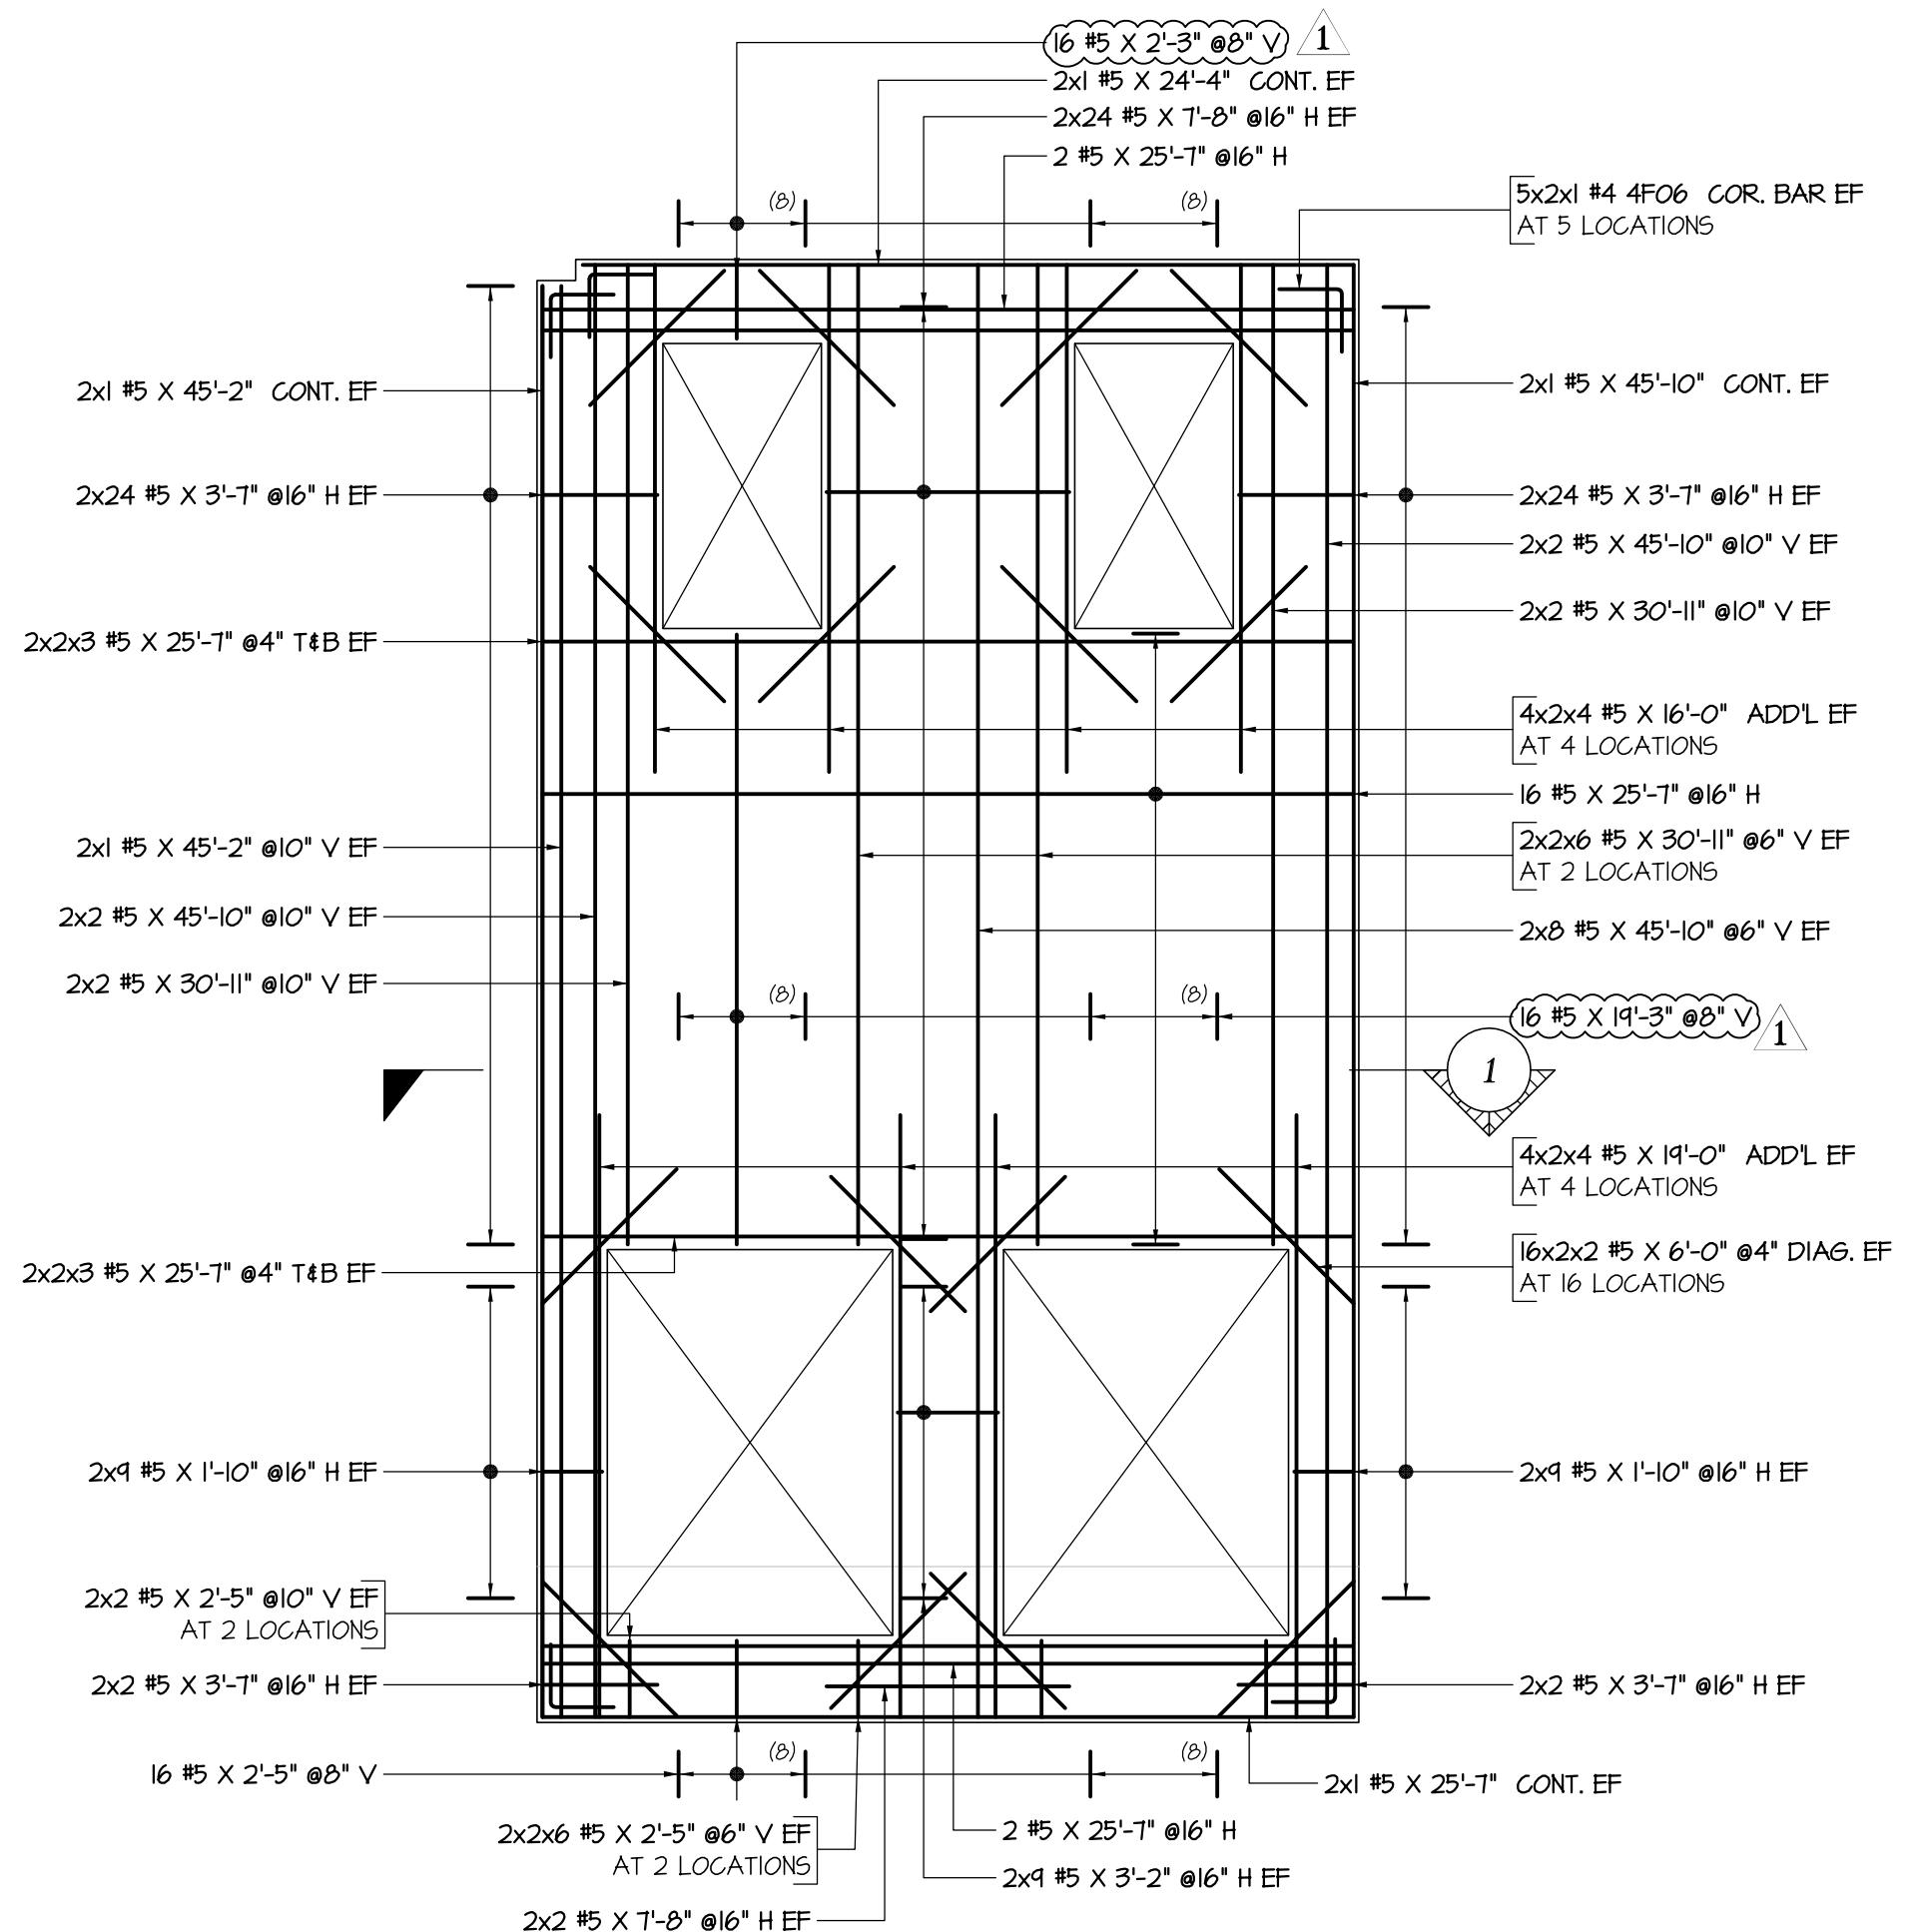


WALL PANEL - N74

SCALE 1/8" = 1'-0"

SDR: R3, R8 & S200

(1/4" THK WALL)

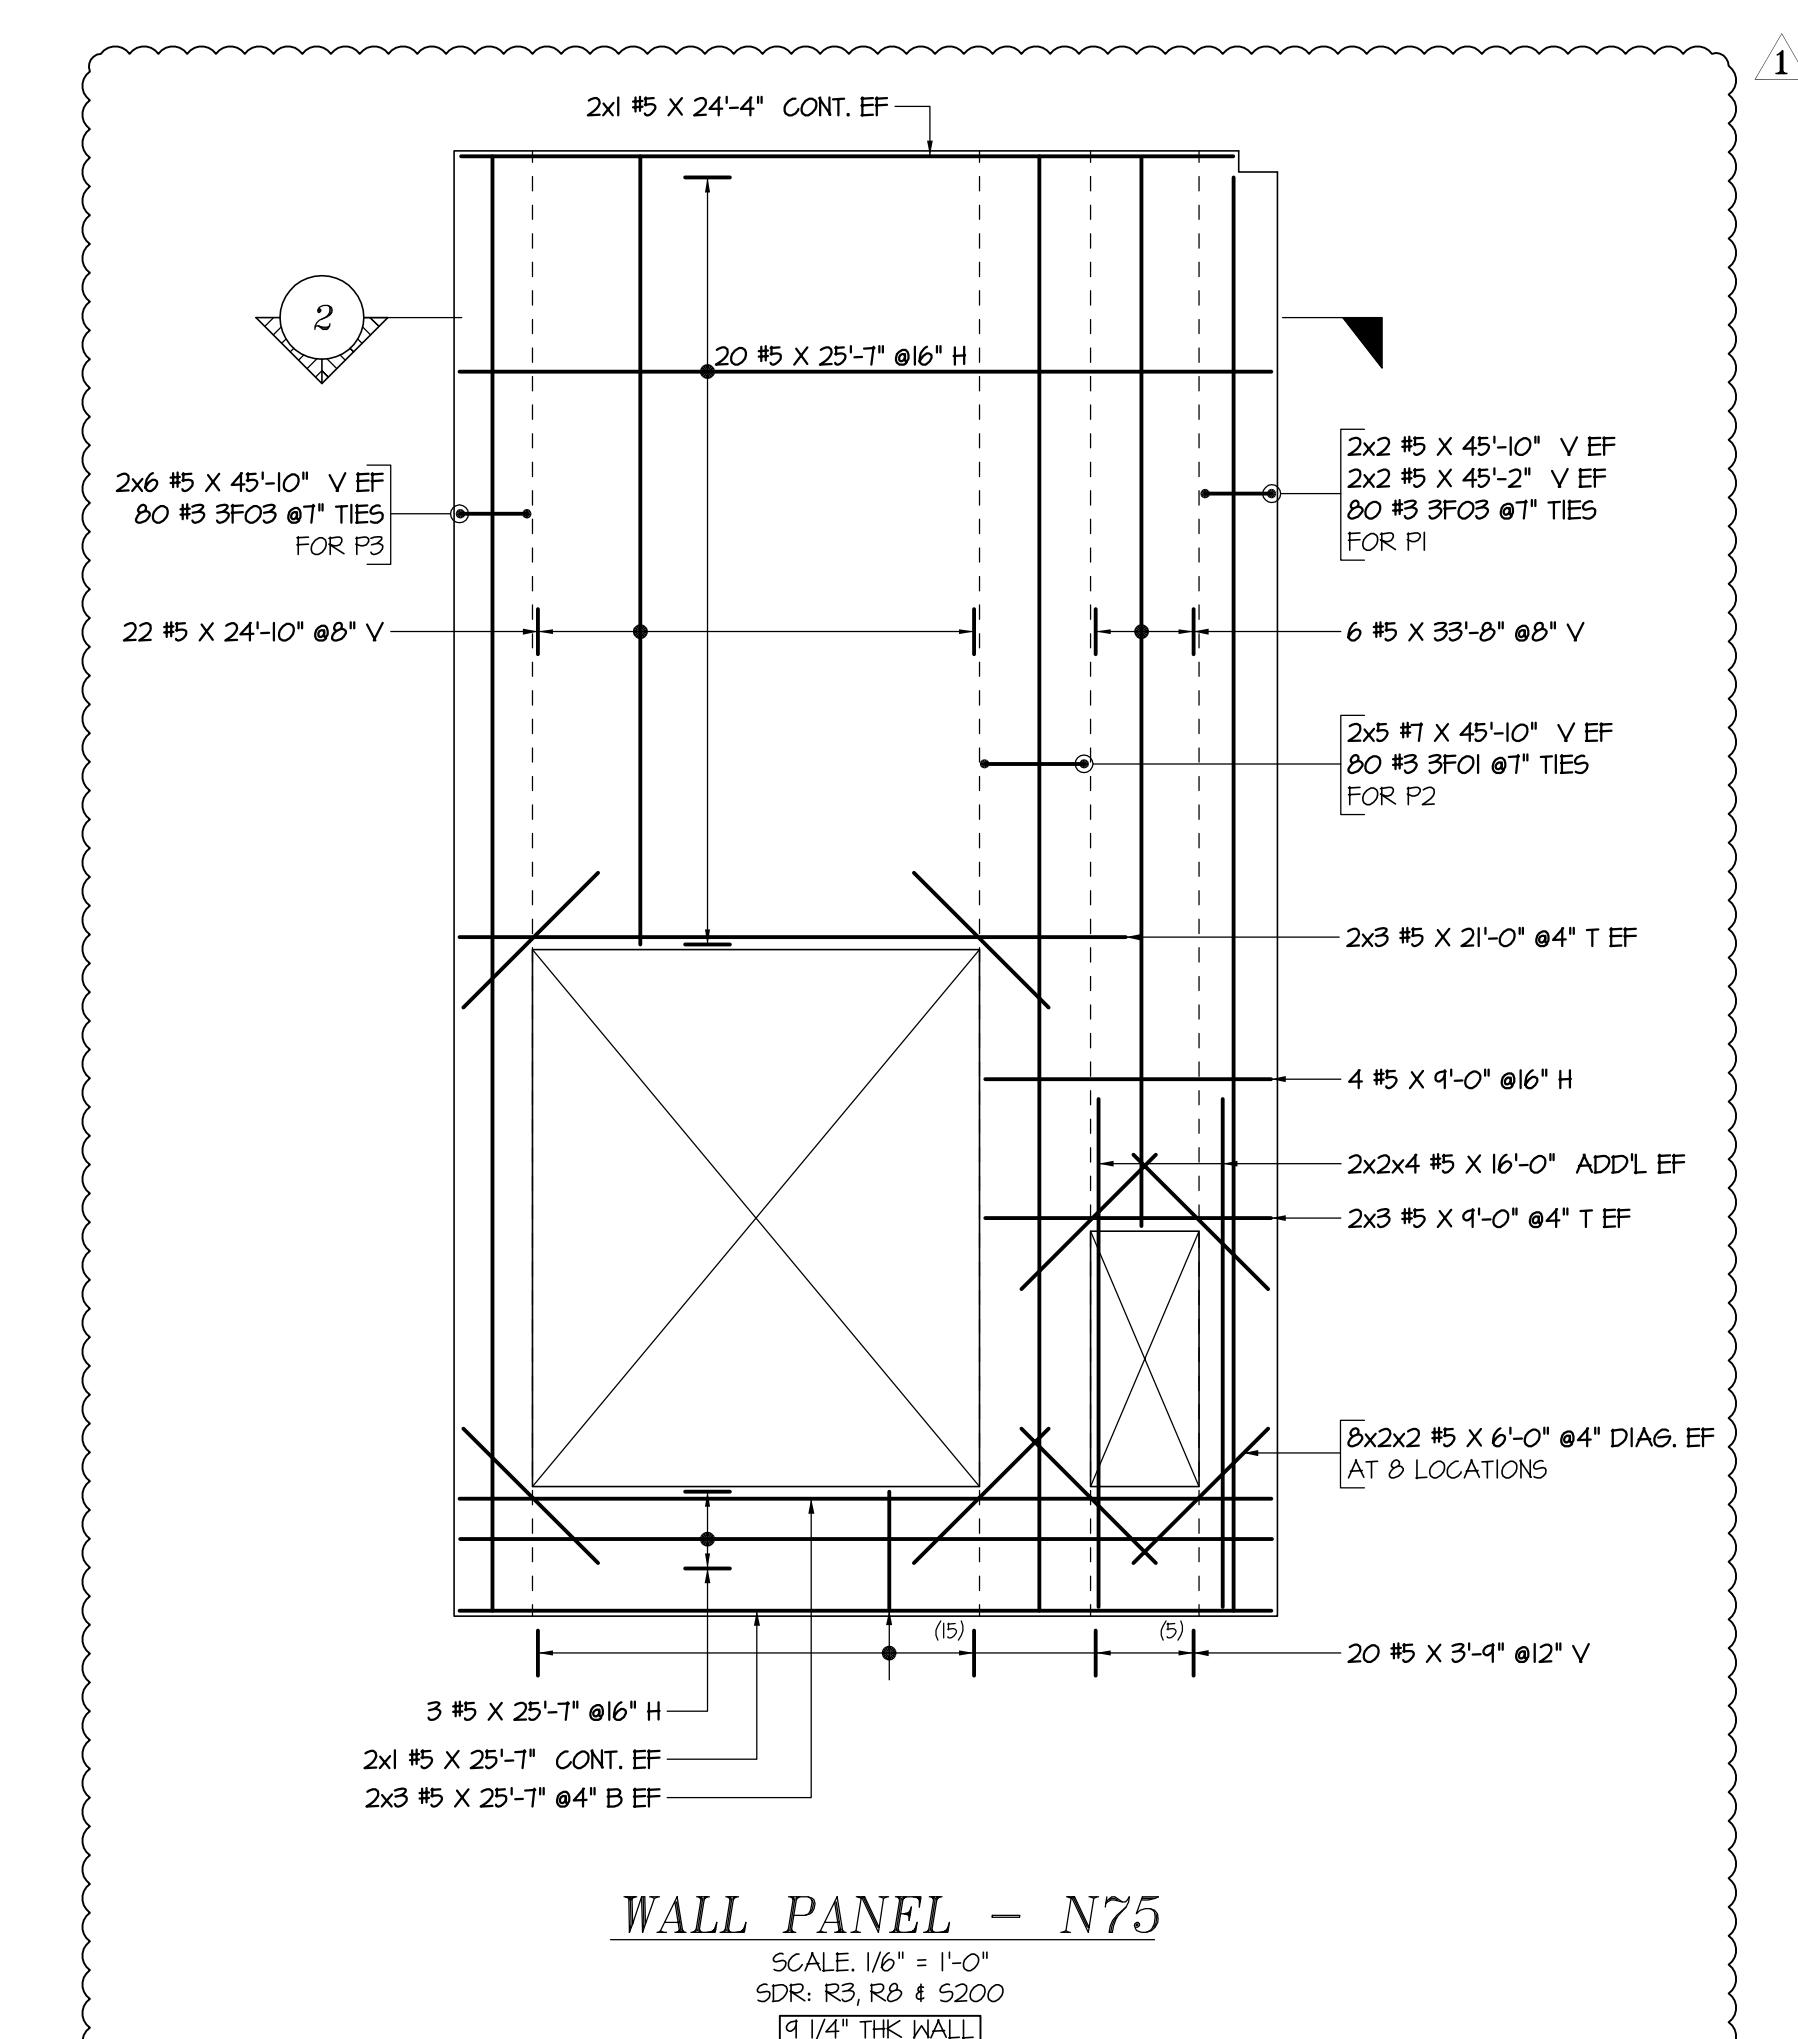


WALL PANEL - N75

SCALE 1/8" = 1'-0"

SDR: R3, R8 & S200

(1/4" THK WALL)

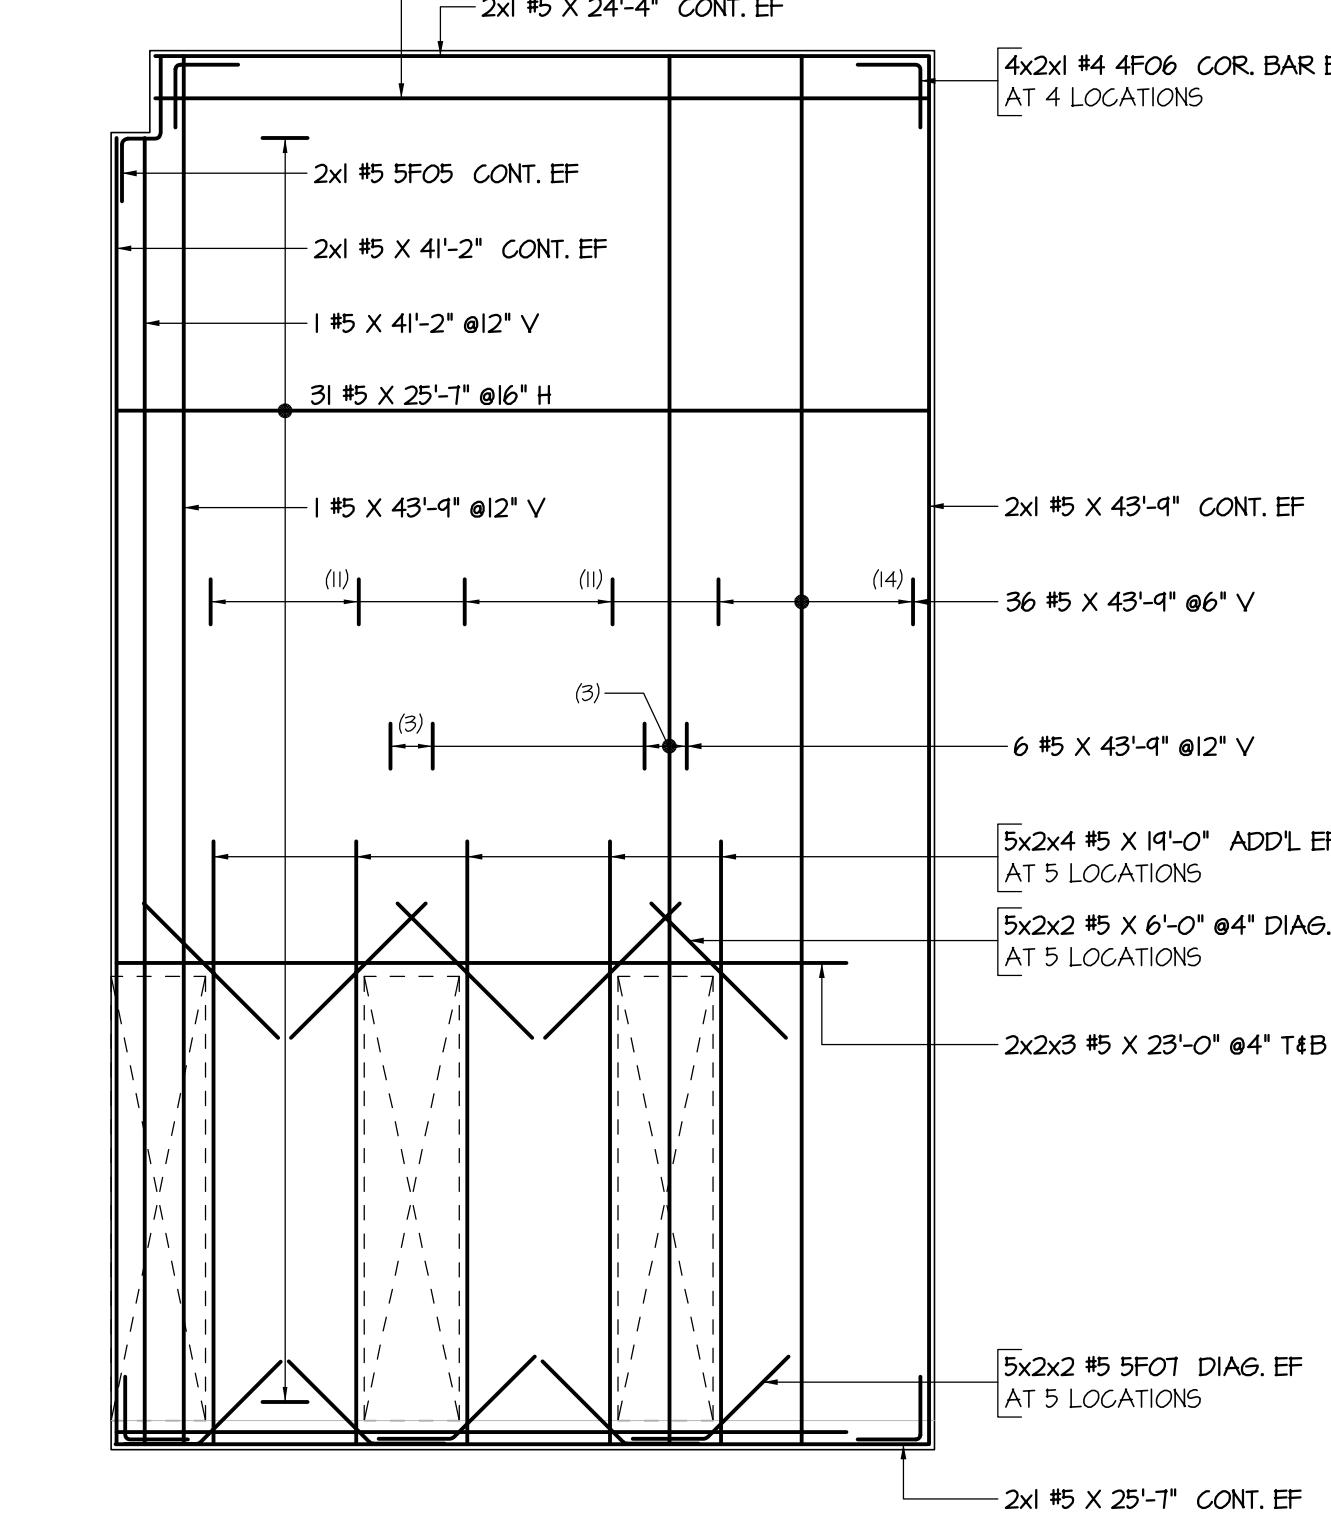


WALL PANEL - N76

SCALE 1/8" = 1'-0"

SDR: R3, R8 & S200

(1/4" THK WALL)

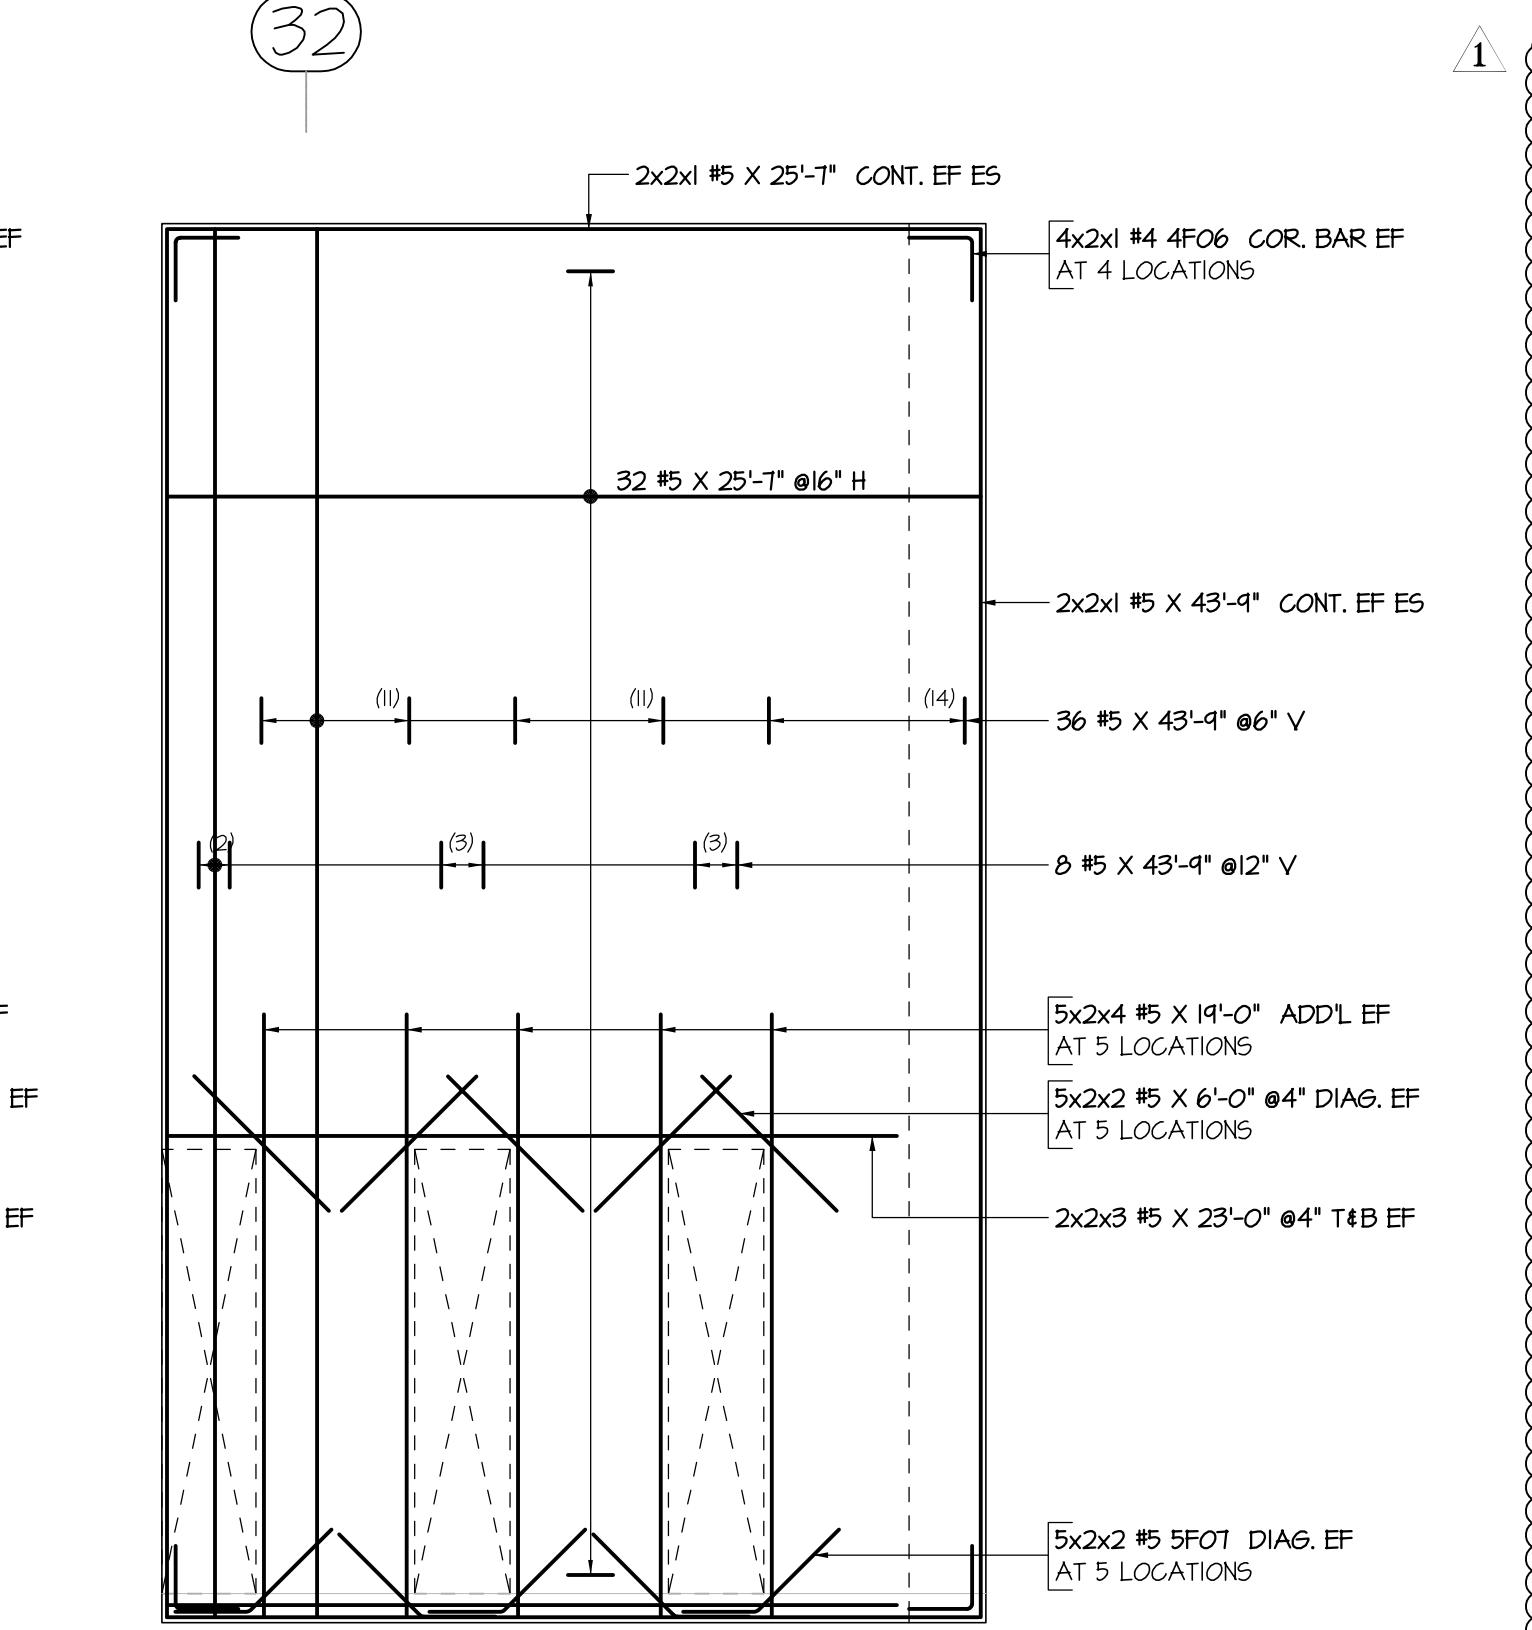


WALL PANEL - N77

SCALE 1/8" = 1'-0"

SDR: R3, R8 & S200

(1/4" THK WALL)

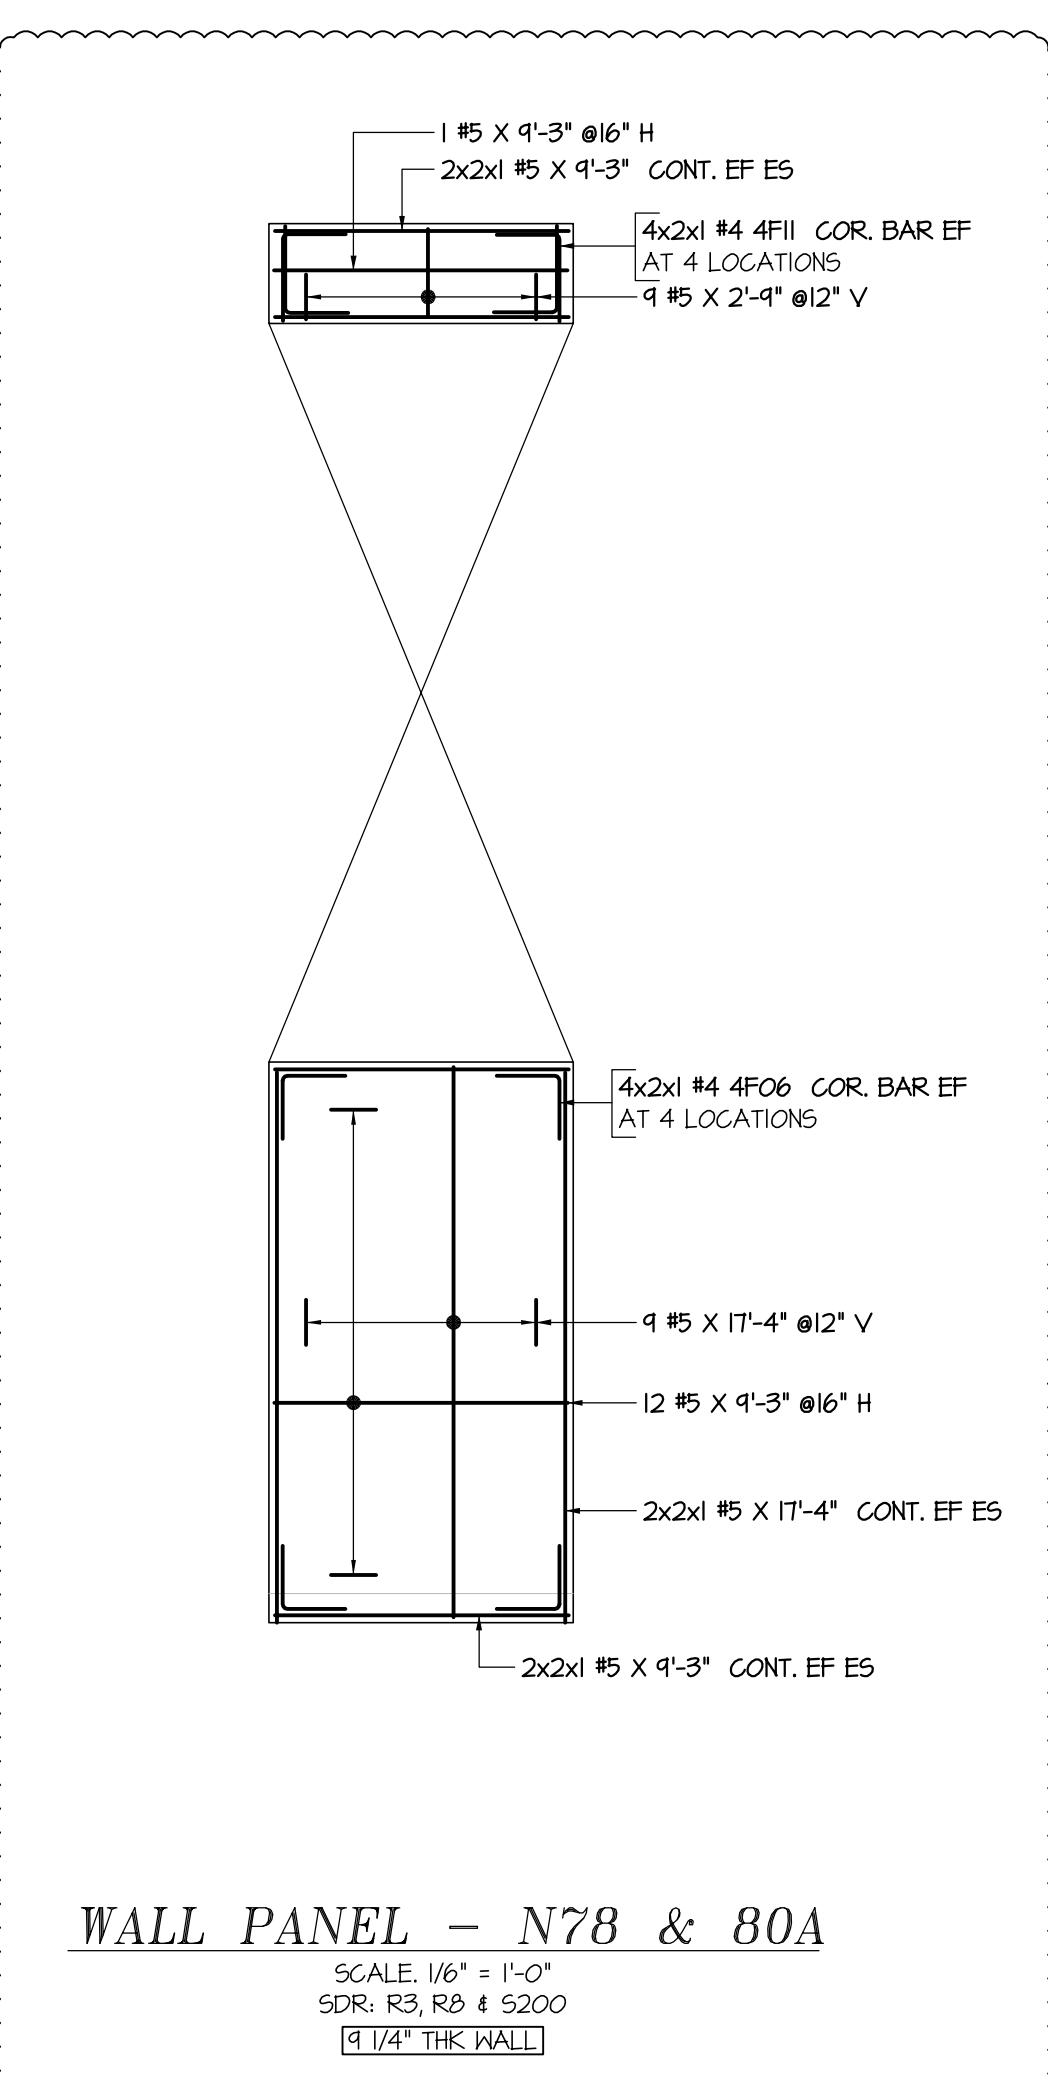


WALL PANEL - N78 & 80A

SCALE 1/8" = 1'-0"

SDR: R3, R8 & S200

(1/4" THK WALL)

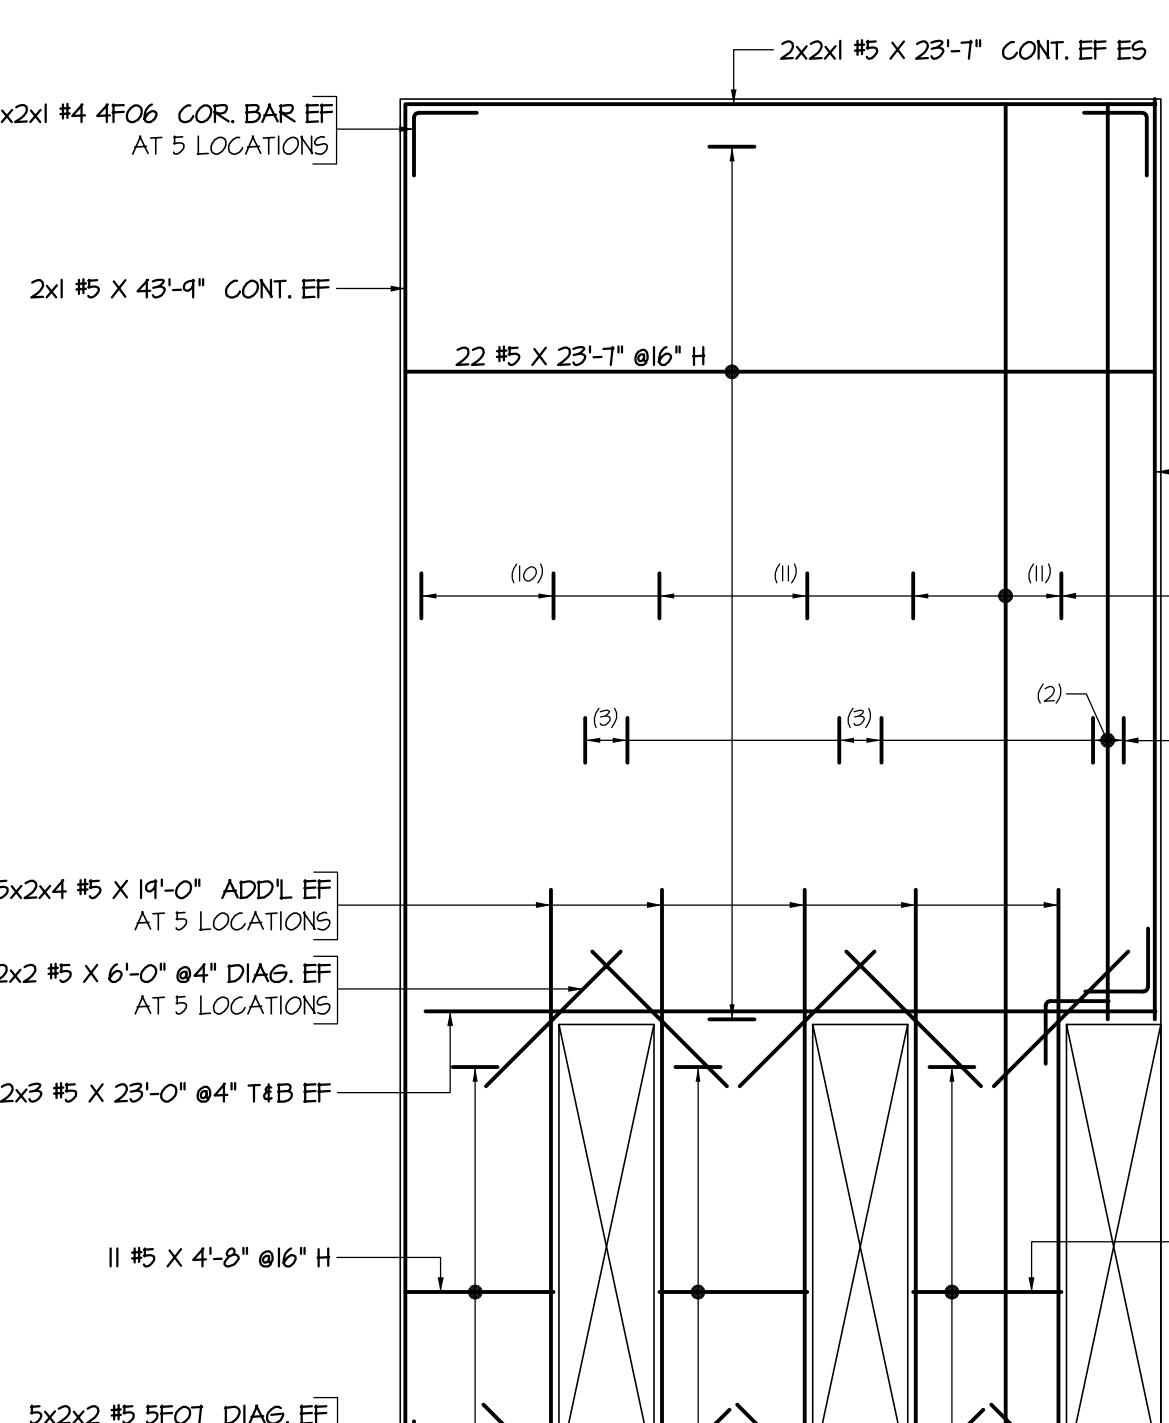


WALL PANEL - N79

SCALE 1/8" = 1'-0"

SDR: R3, R8 & S200

(1/4" THK WALL)

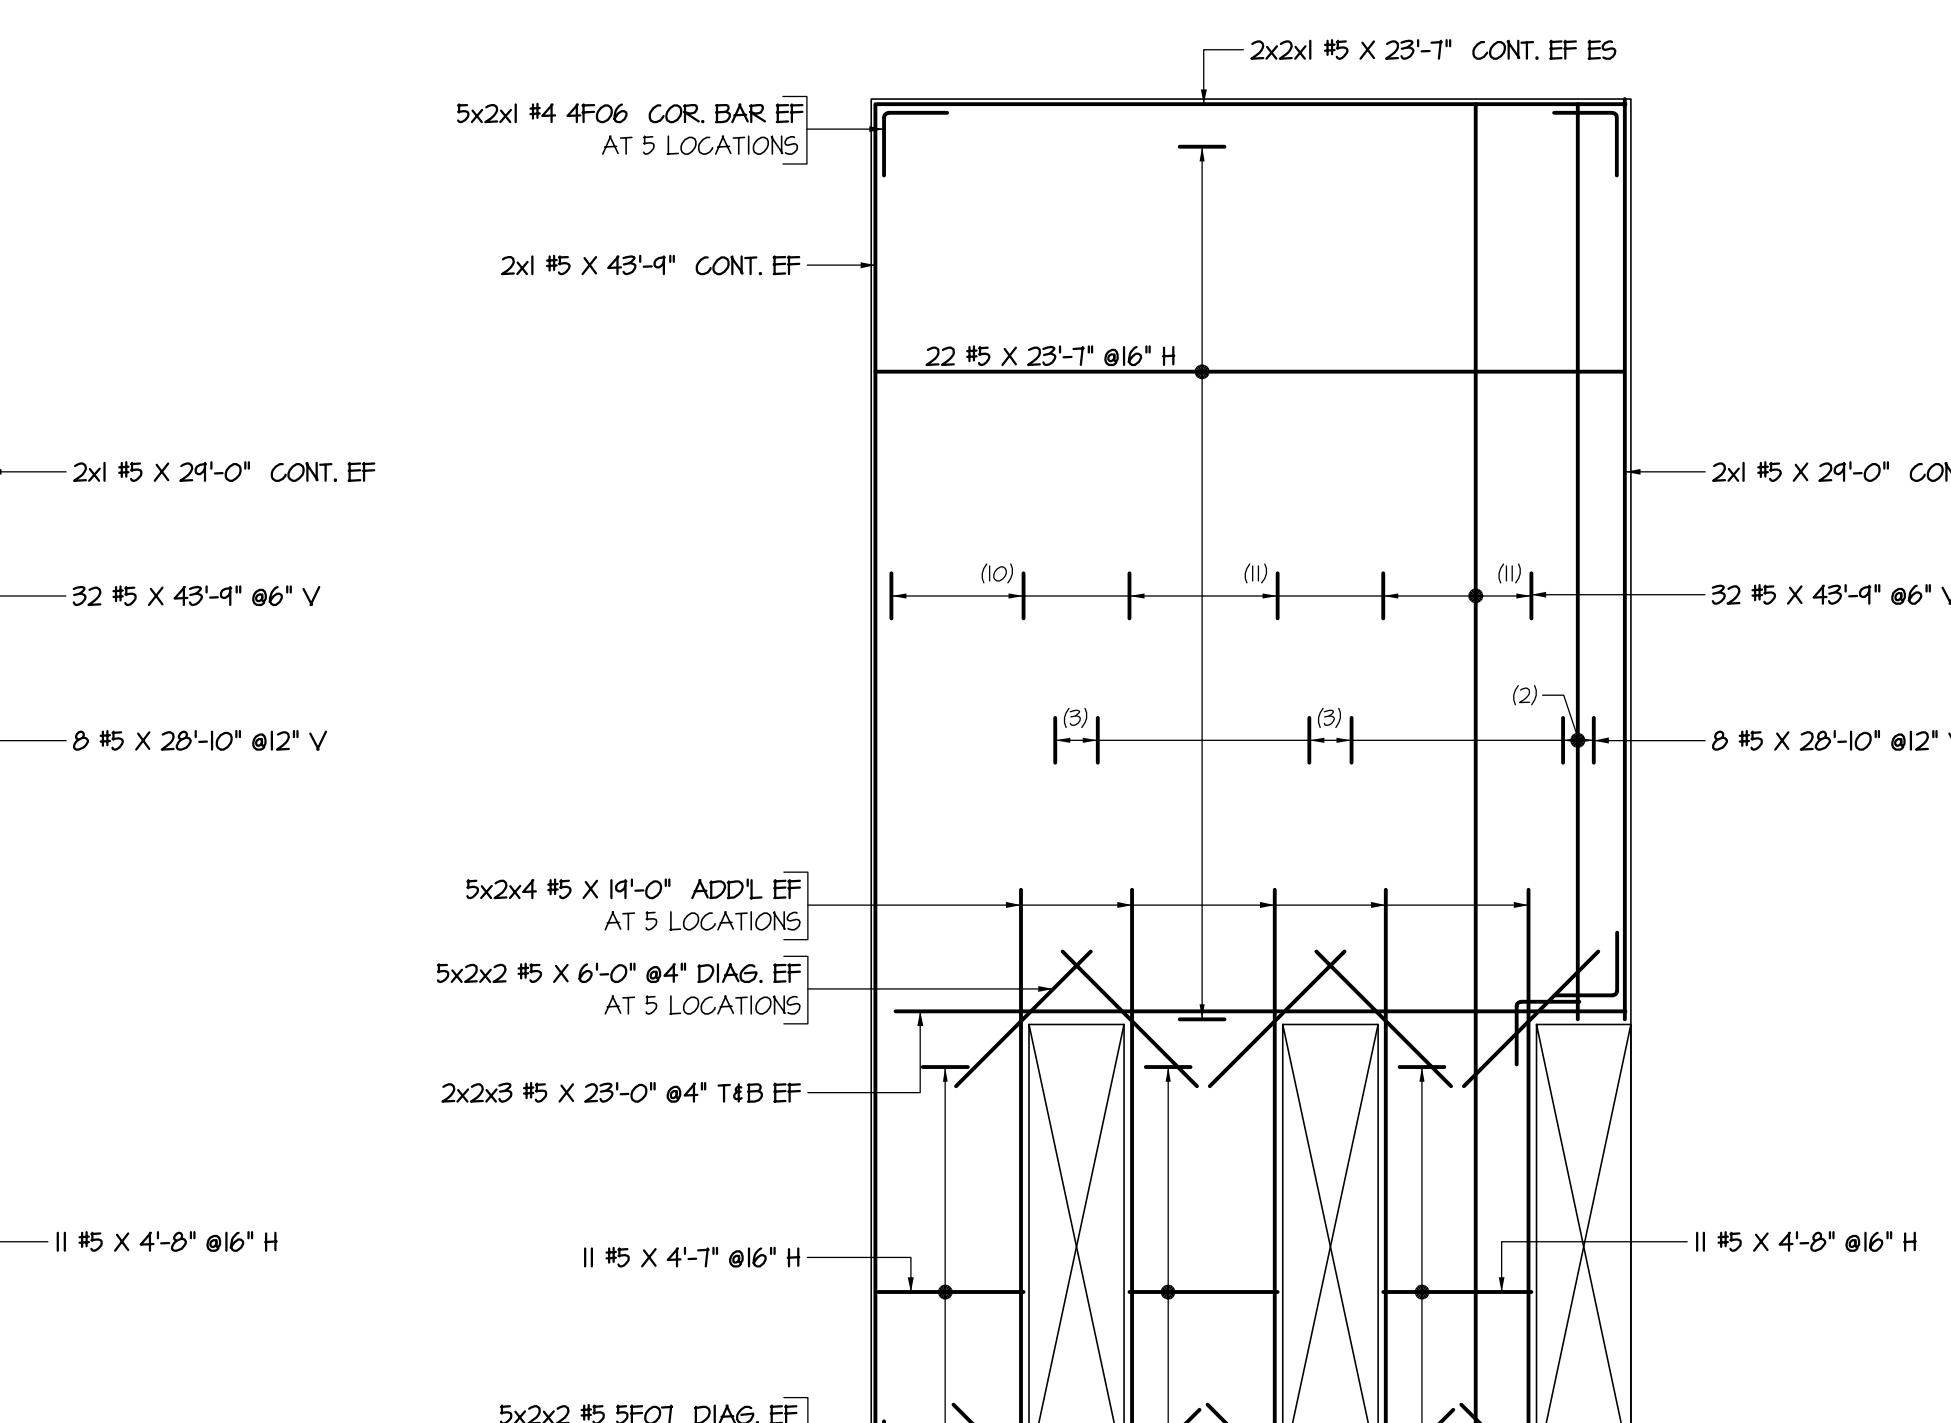


WALL PANEL - N80

SCALE 1/8" = 1'-0"

SDR: R3, R8 & S200

(1/4" THK WALL)



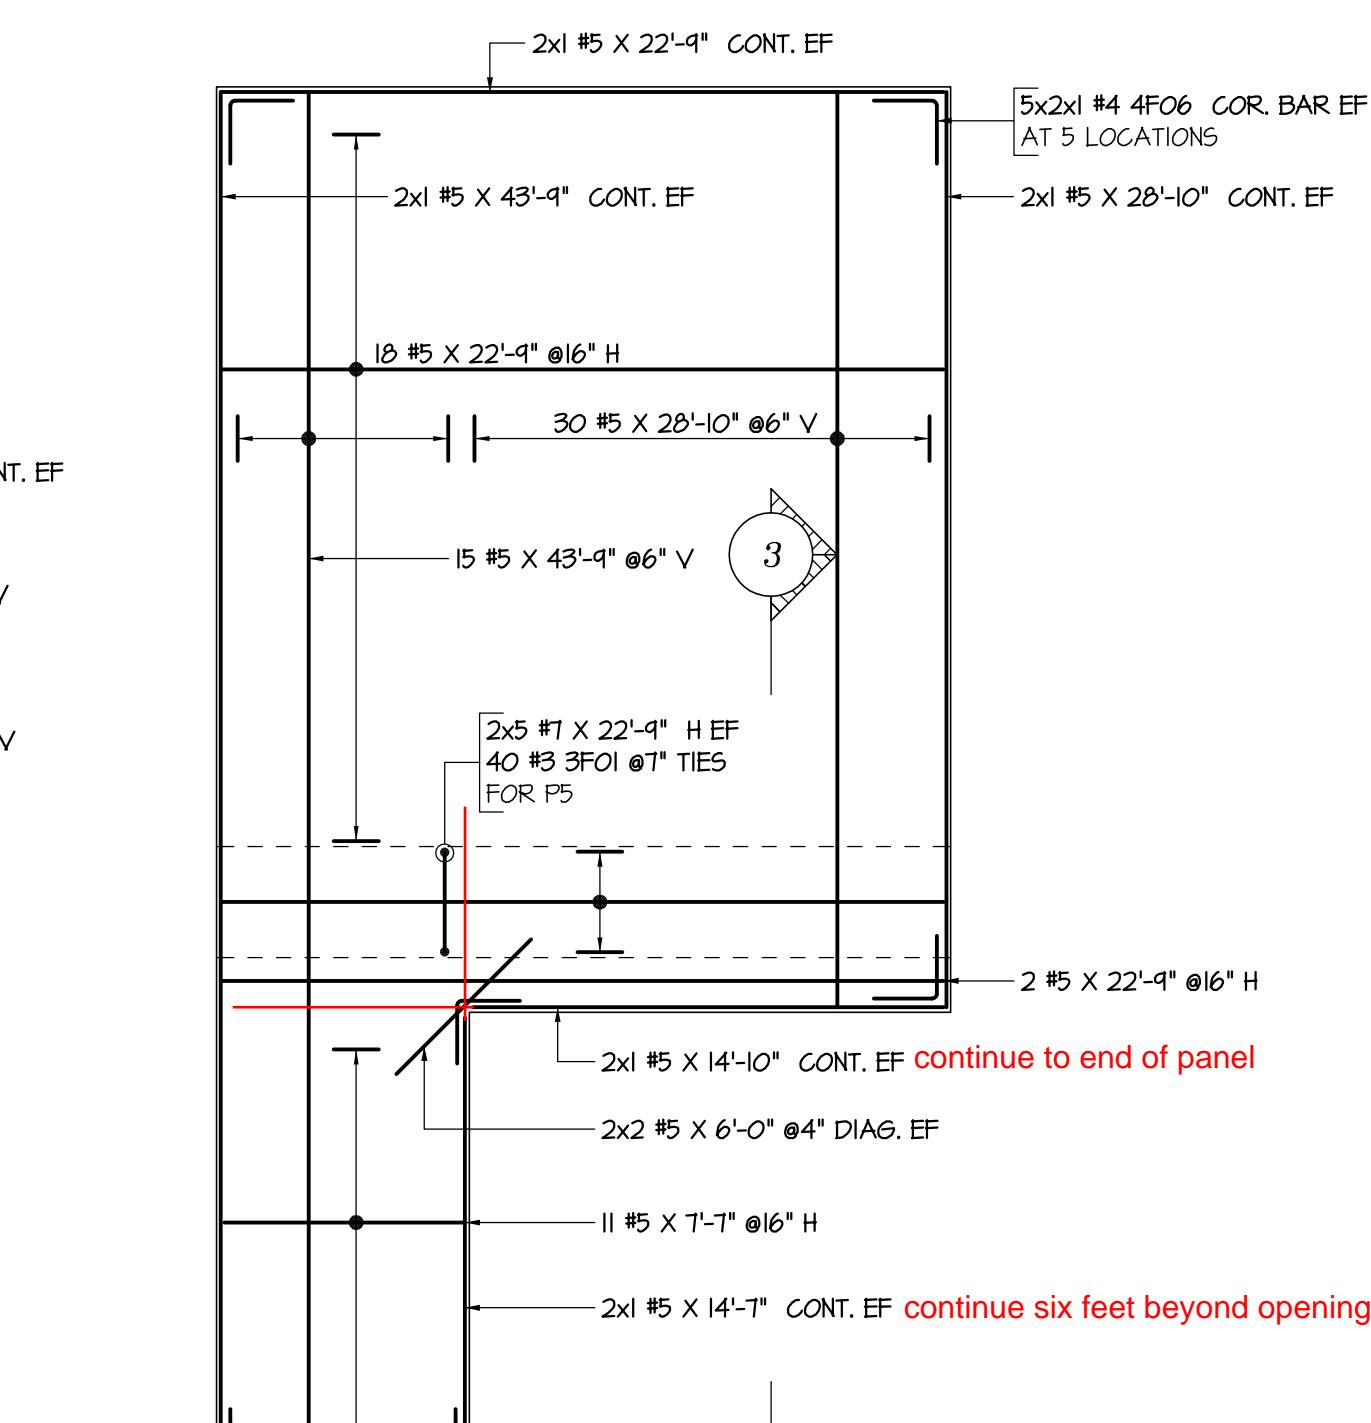


WALL PANEL - N81

SCALE 1/8" = 1'-0"



SDR: R3, R8 & S200

(1/4" THK WALL)

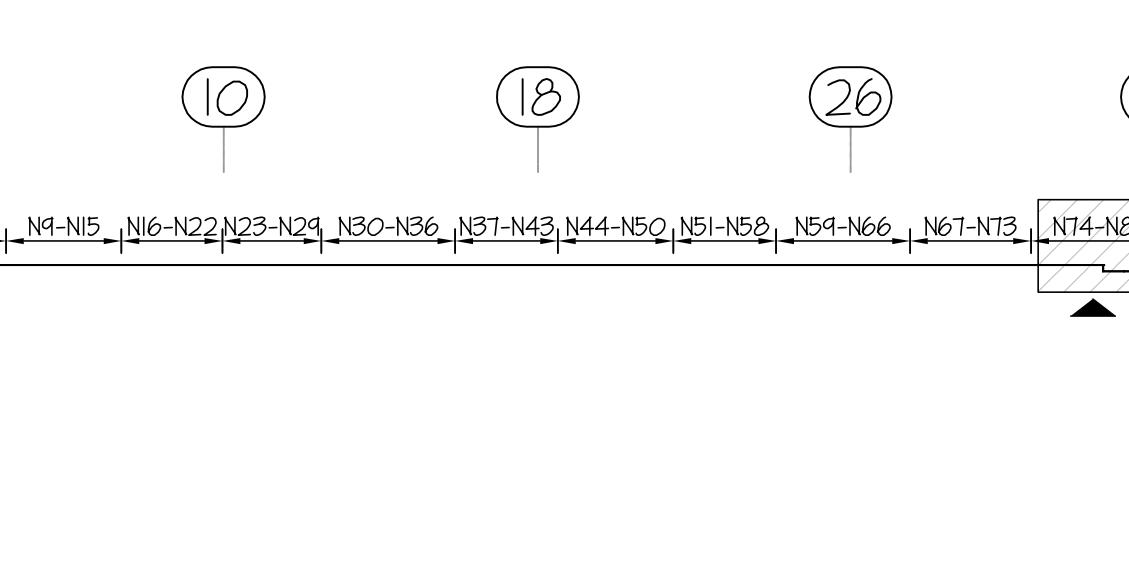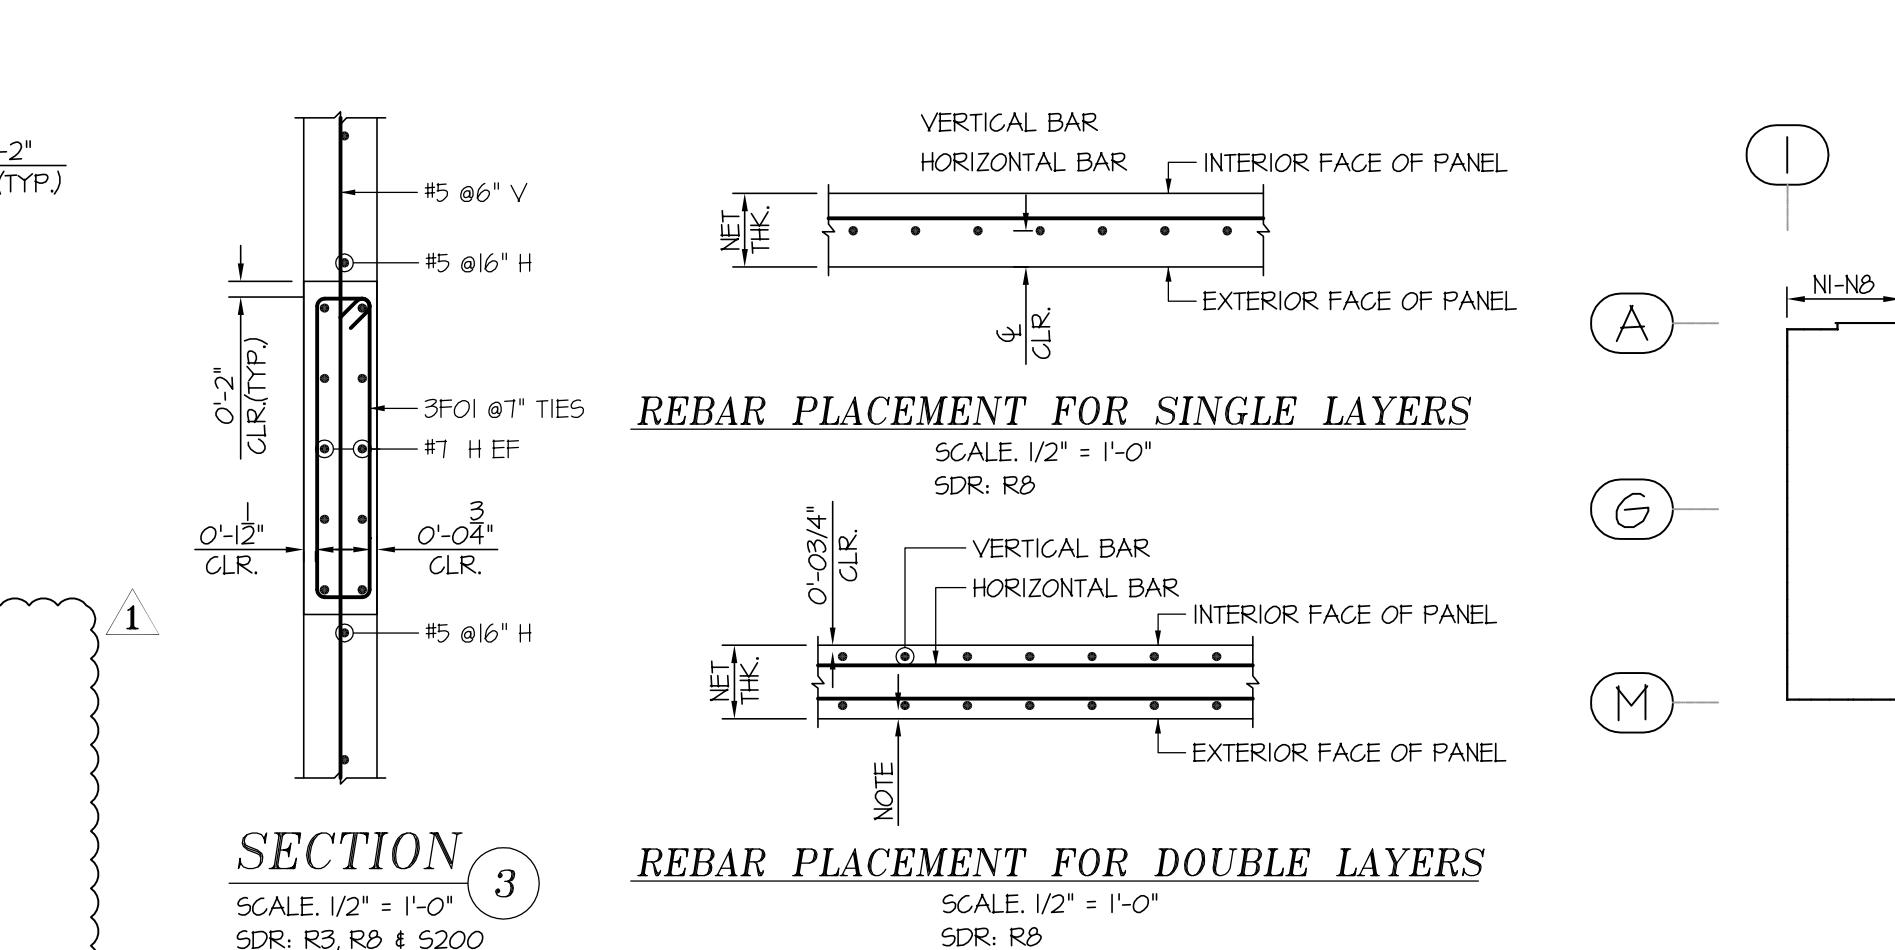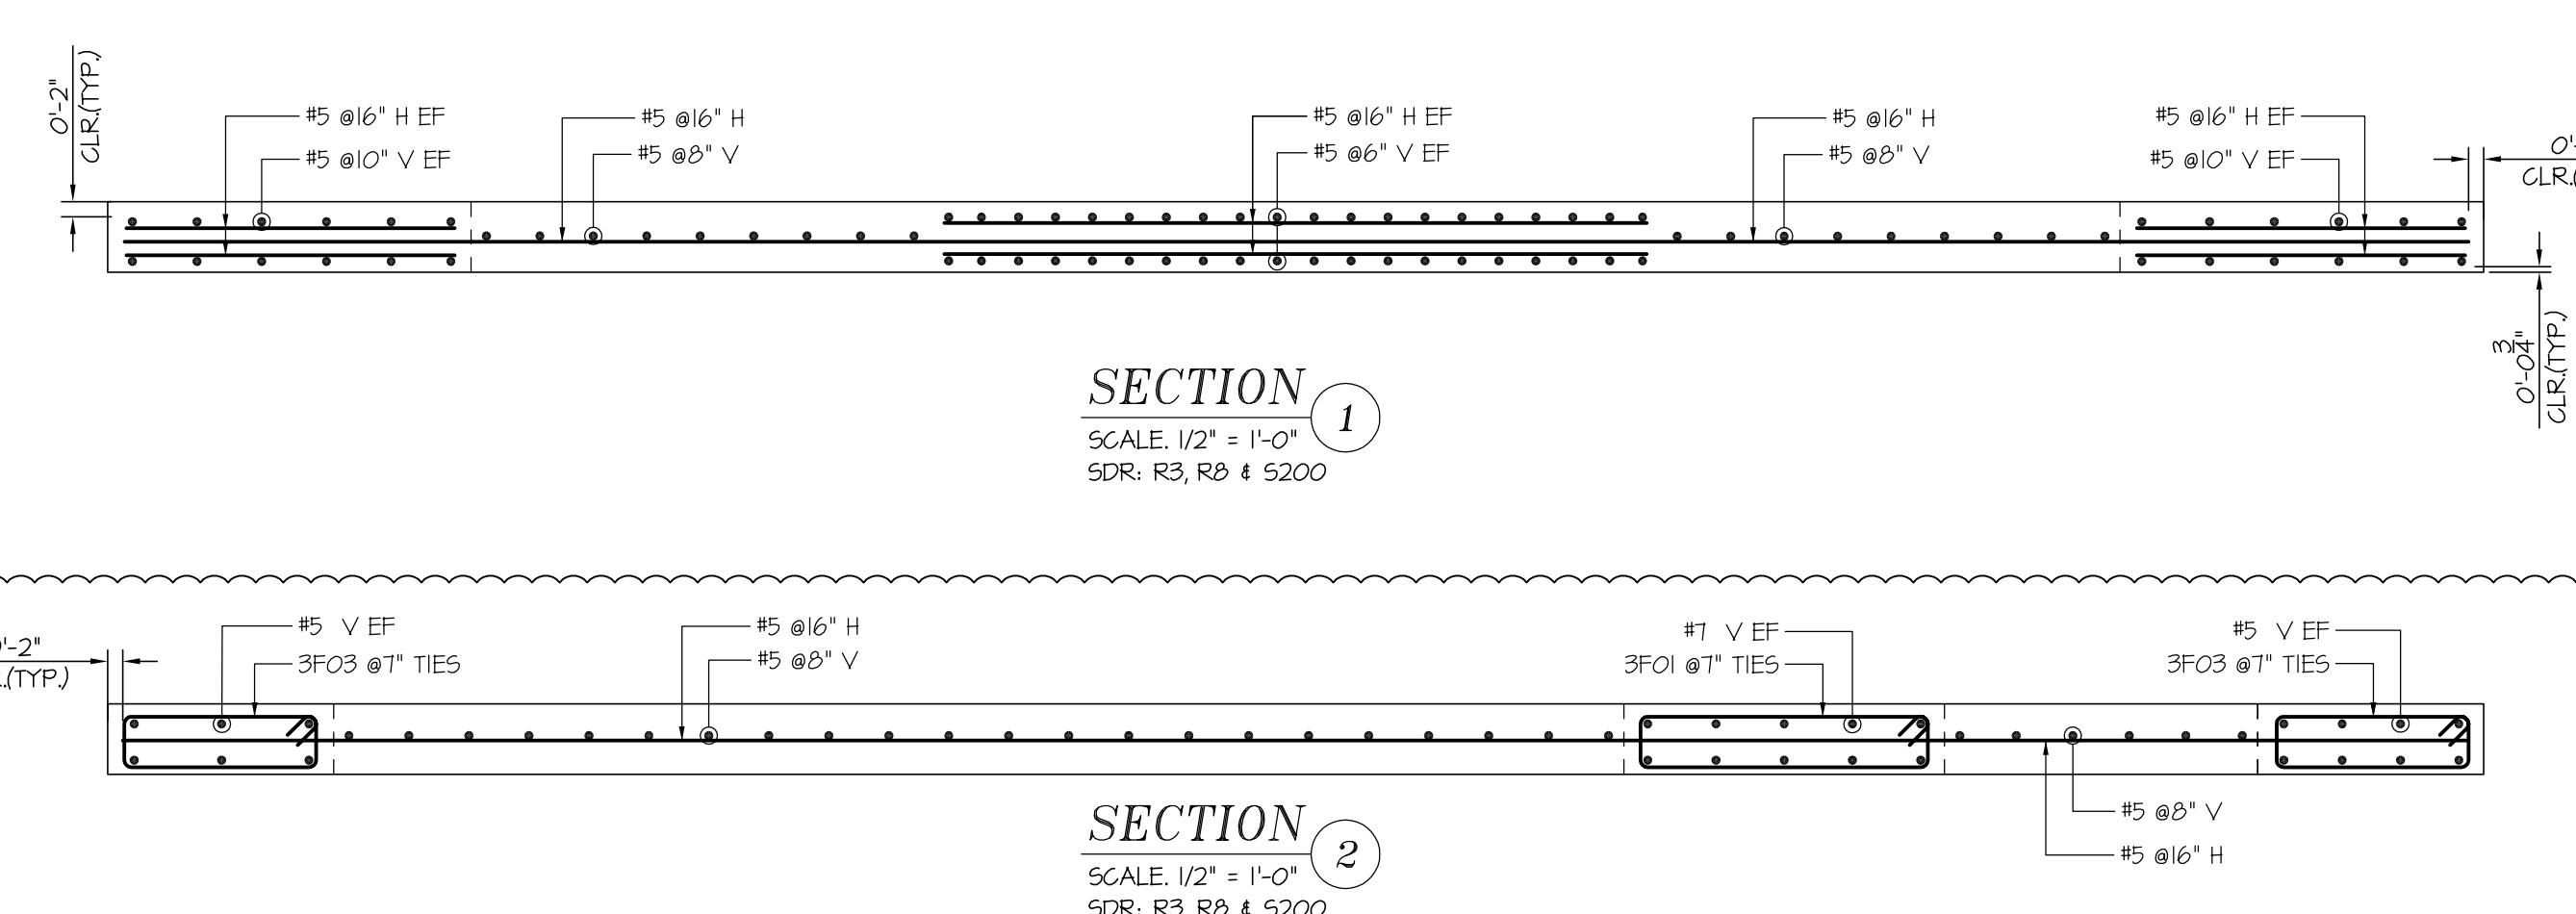

KEY PLAN









N

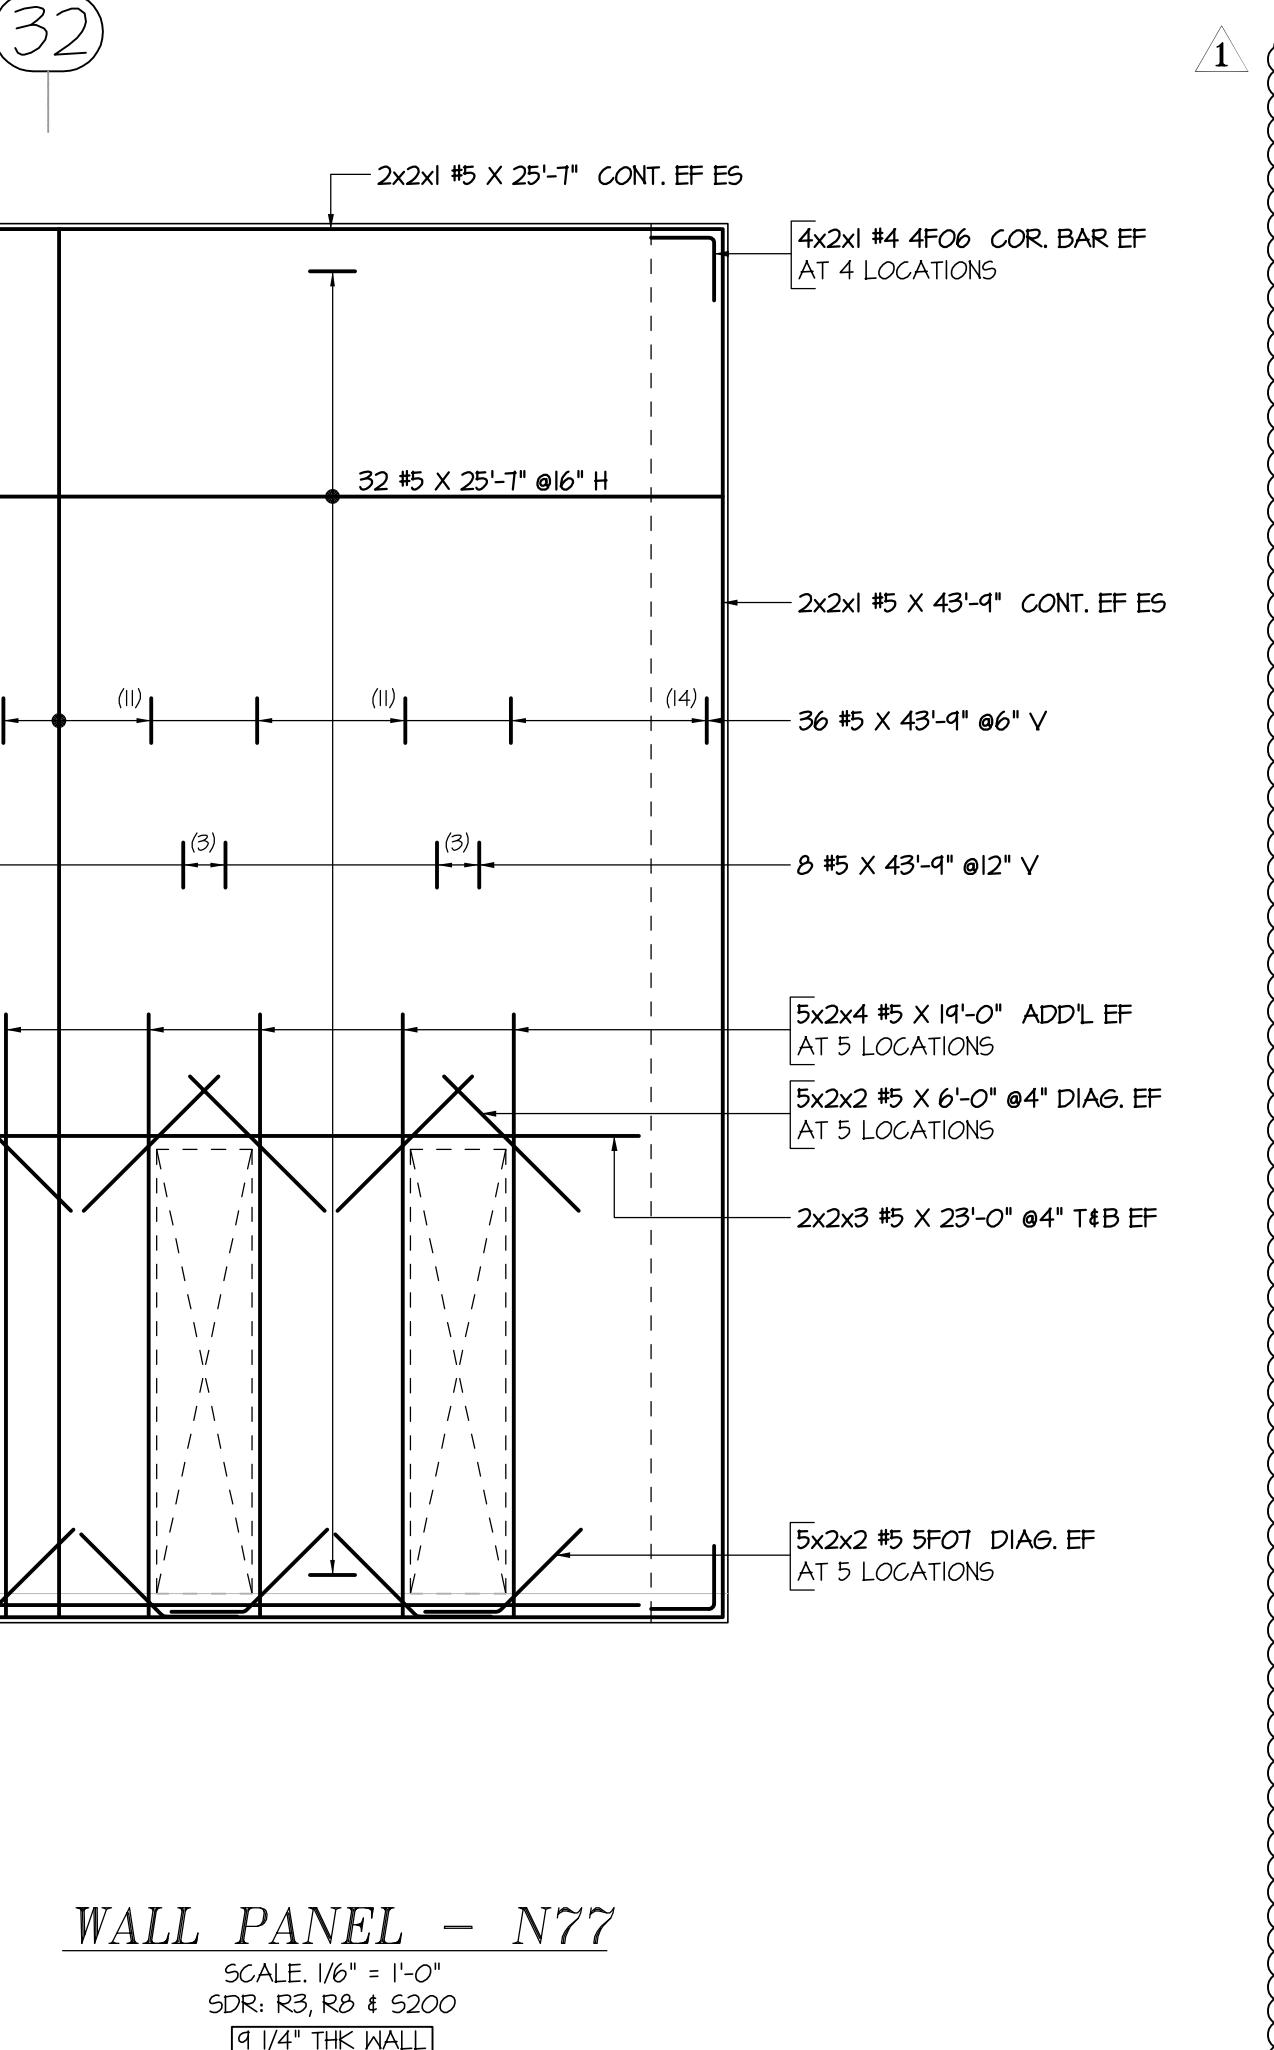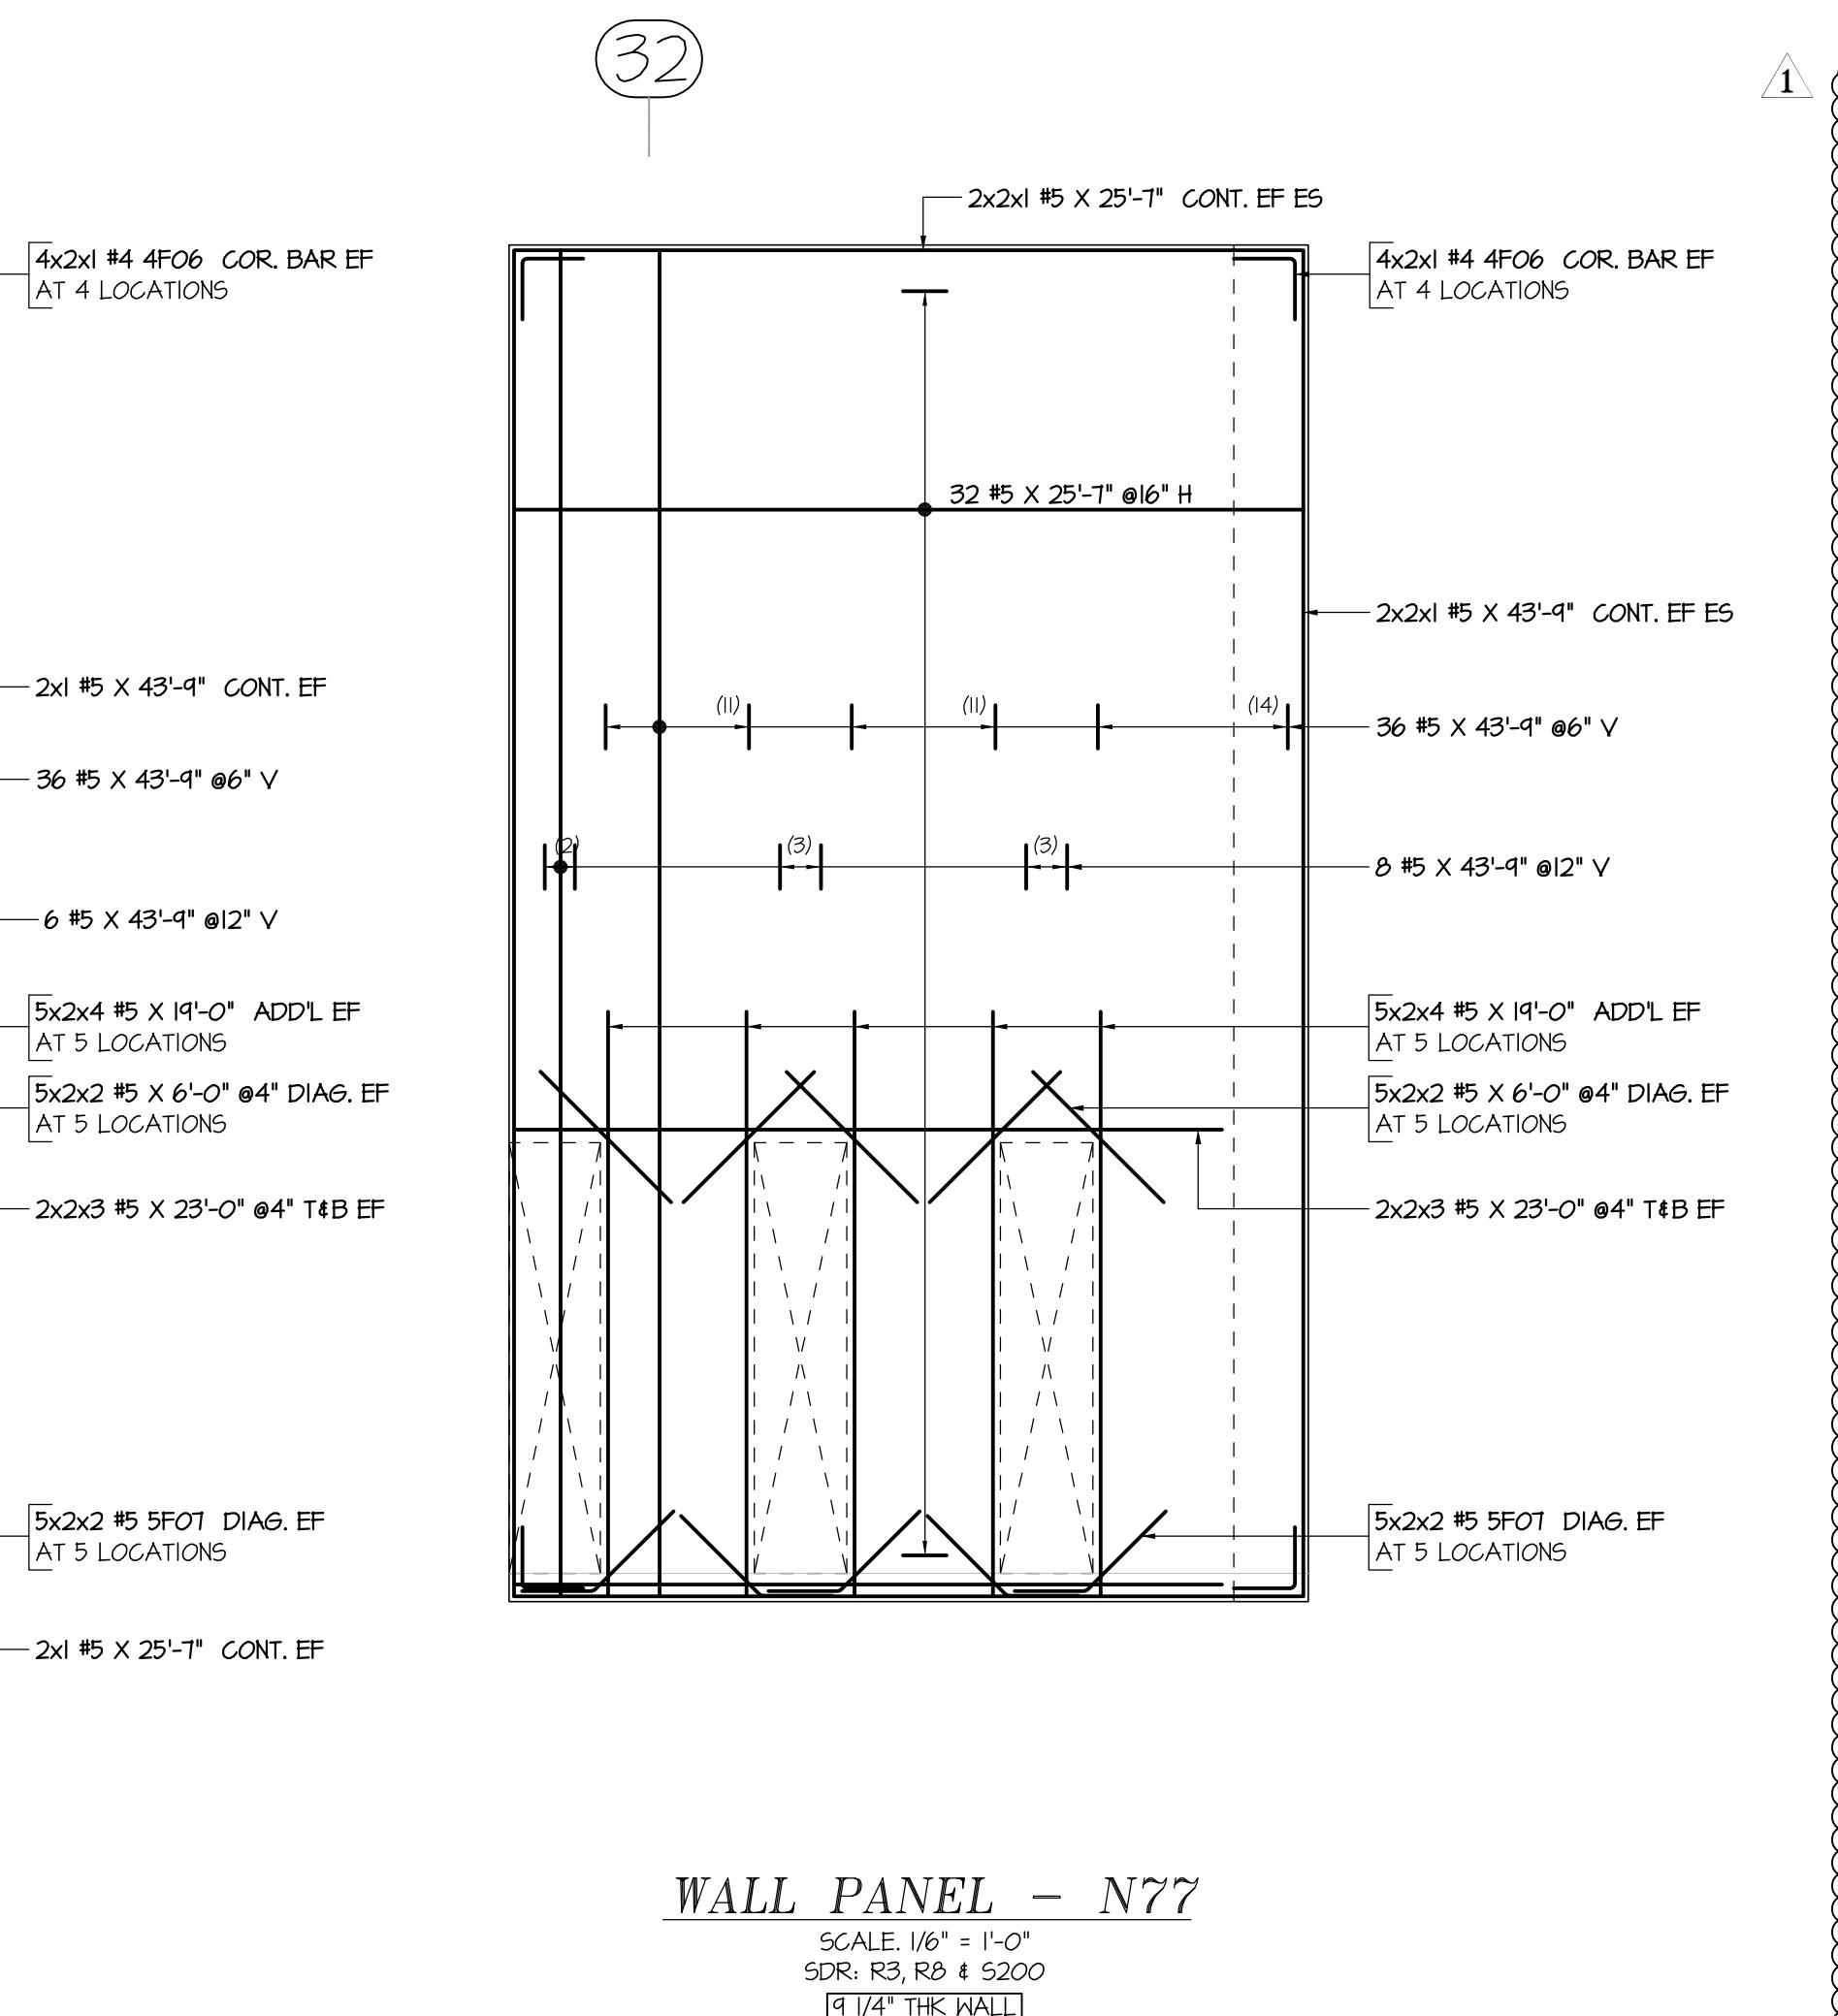

NORTH WALL PANELS PLACING DRAWING REFERENCE											
DWG.NO:	DRAWING DESCRIPTION										
R-4	NORTH WALL PANELS N-1 TO N-8										
R-5	NORTH WALL PANELS N-9 TO N-15										
R-6	NORTH WALL PANELS N-16 TO N-22										
R-7	NORTH WALL PANELS N-23 TO N-29										
R-8	NORTH WALL PANELS N-30 TO N-36										
R-9	NORTH WALL PANELS N-31 TO N-43										
R-10	NORTH WALL PANELS N-44 TO N-50										
R-II	NORTH WALL PANELS N-51 TO N-58										
R-I2	NORTH WALL PANELS N-59 TO N-66										
R-13	NORTH WALL PANELS N-67 TO N73										
R-14	NORTH WALL PANELS N-74 TO N-81										

REINFORCING STEEL PLACING DRAWING ONLY. USE IN CONJUNCTION WITH CONTRACT DRAWINGS & SPECIFICATIONS. ELEVATIONS & DIMENSIONS SHOWN ON THIS DRAWING ARE FOR DETAILING PURPOSES ONLY AND SHOULD NOT BE USED FOR CONSTRUCTION UNLESS VERIFIED BY ENGINEER OR CONTRACTOR.

7		
6		
5		
4		
3		
2	06.10.2019	RE SUBMITTED FOR APPROVAL
1	05.24.2019	APPROVAL DATE SENT FOR
RE-STEEL SUPPLY CO., INC.		
REINFORCING STEEL - WIRE MESH		
200 Eddystone Industrial Park • Eddystone, PA 19022-1588		
Phone: 800-876-8216 • Fax: 610-876-8428		
Structure	VALLEY VIEW BUSINESS PARK TILT PANELS	
Location	JESSUP,PA	
Architect	KSS ARCHITECTS	
Engineer	RICHARD ADAMS	
Customer	T&T CONSTRUCTION	
Made by:	Date:	CONTRACT NO.
PRO	05.24.2019	U2524
DRAWING COVERS		
NORTH WALL PANELS N-74 TO N-81		
REV. NO.	DATE	DESCRIPTION
DRAWING NO. R-14		

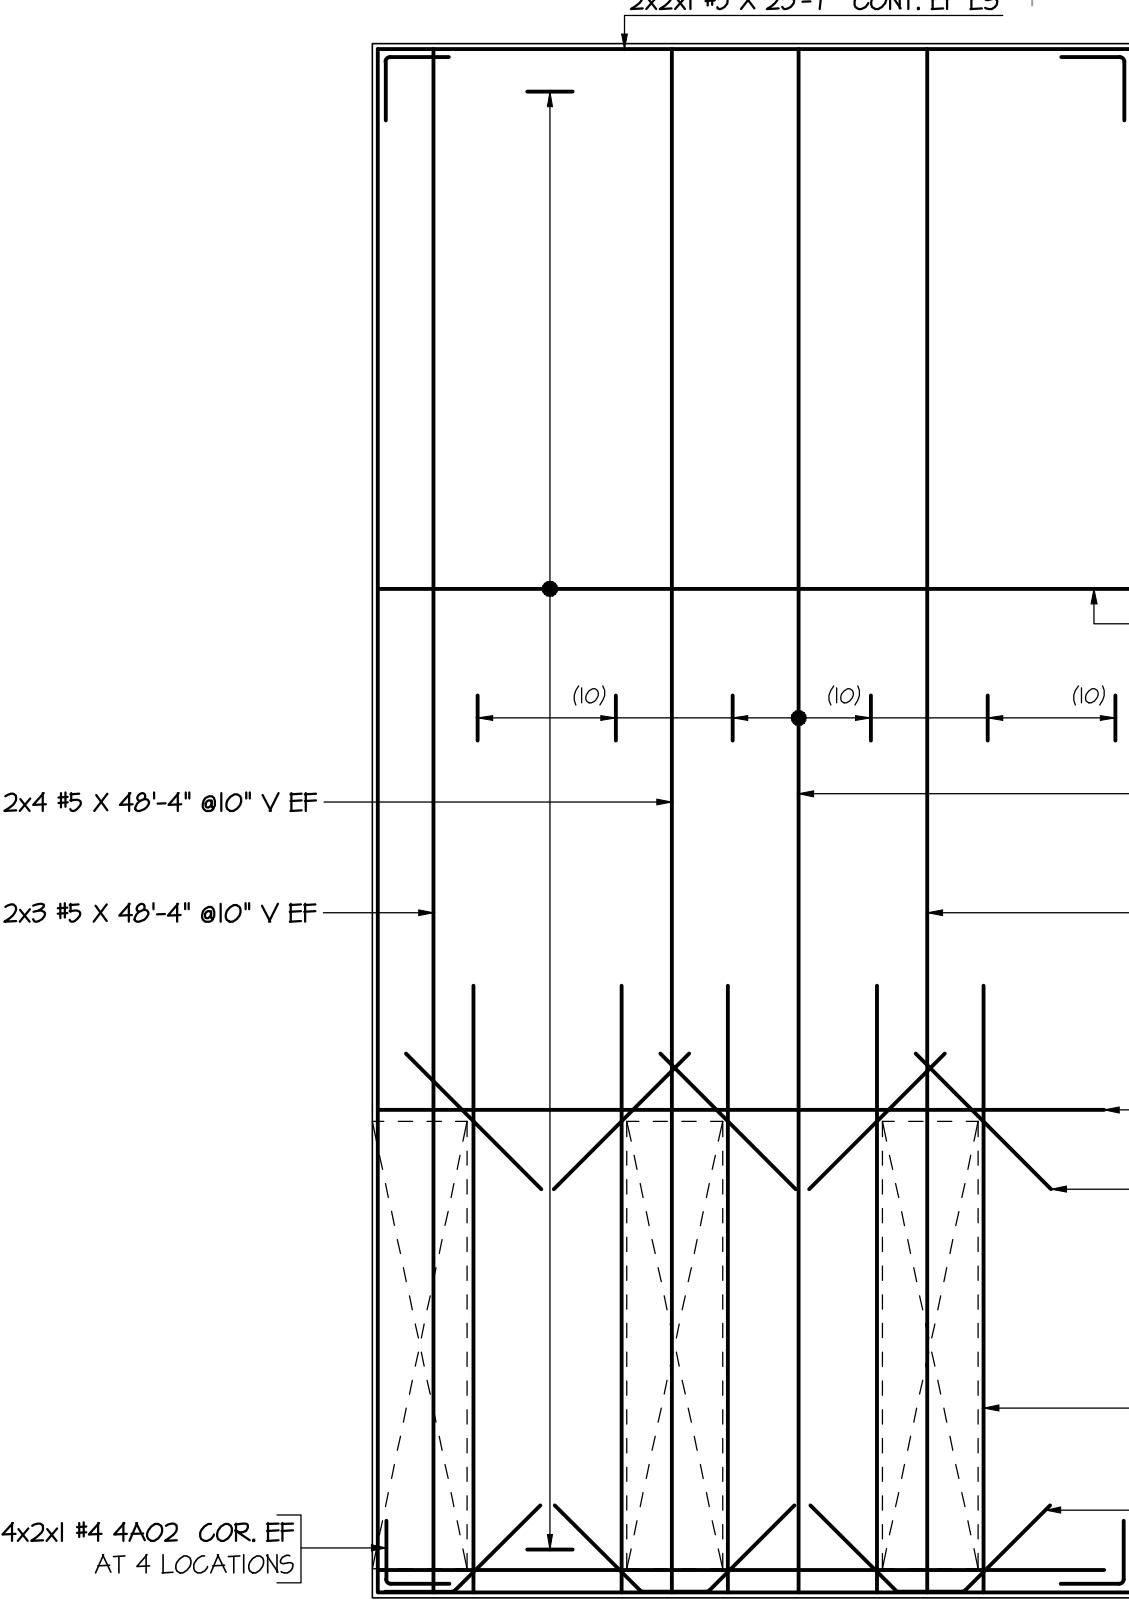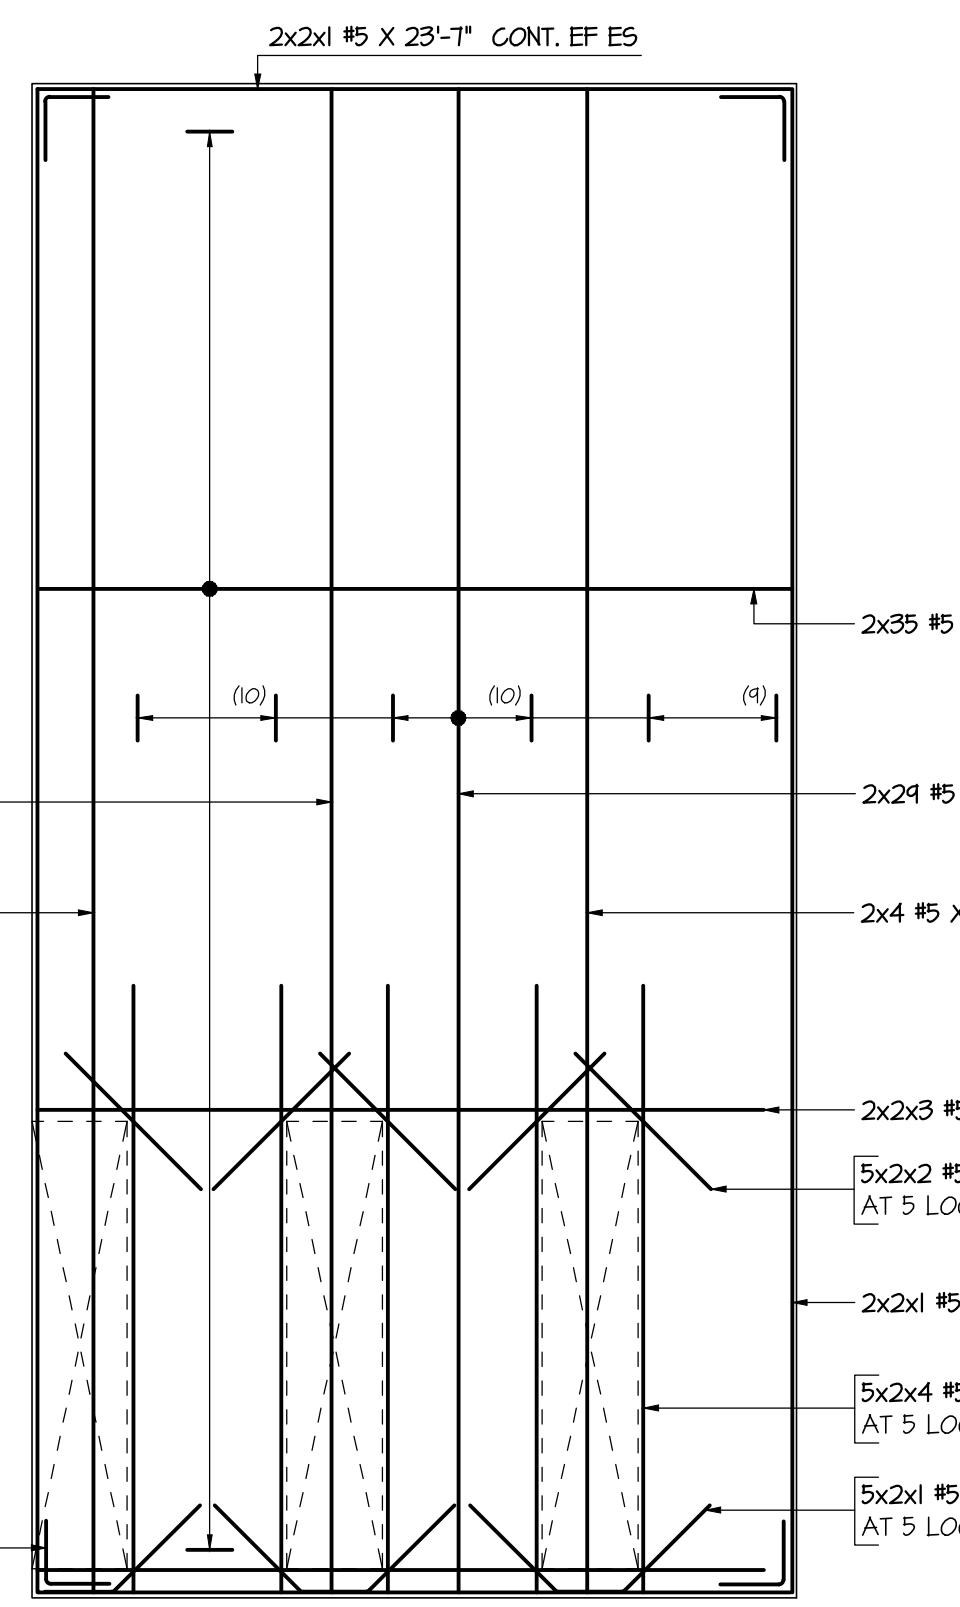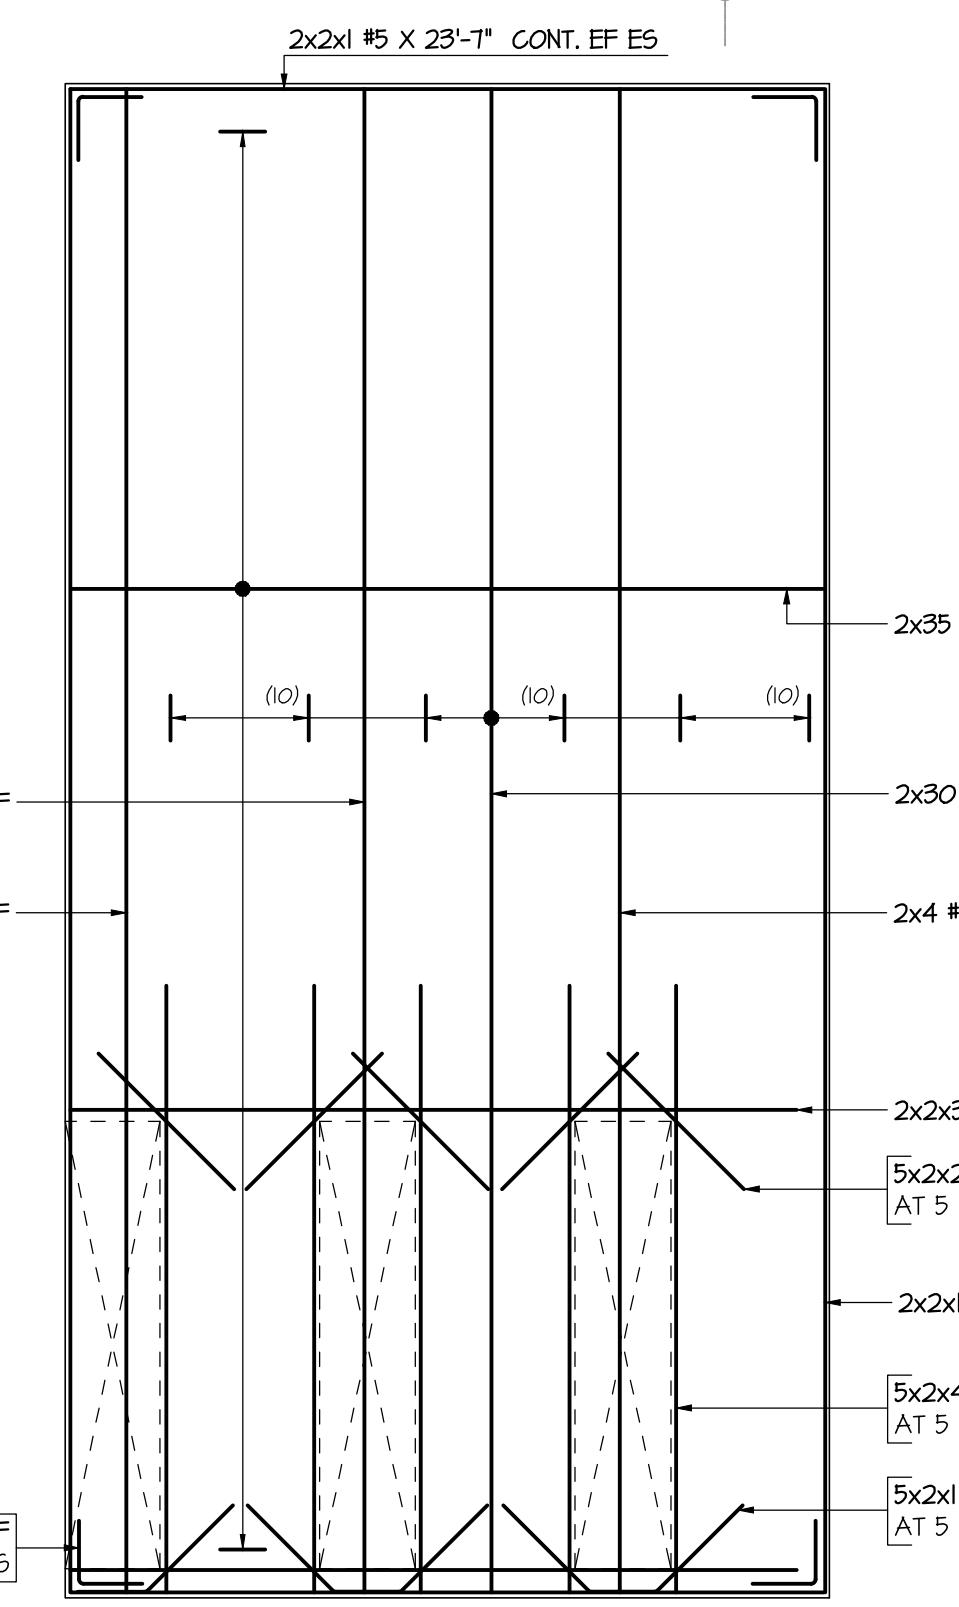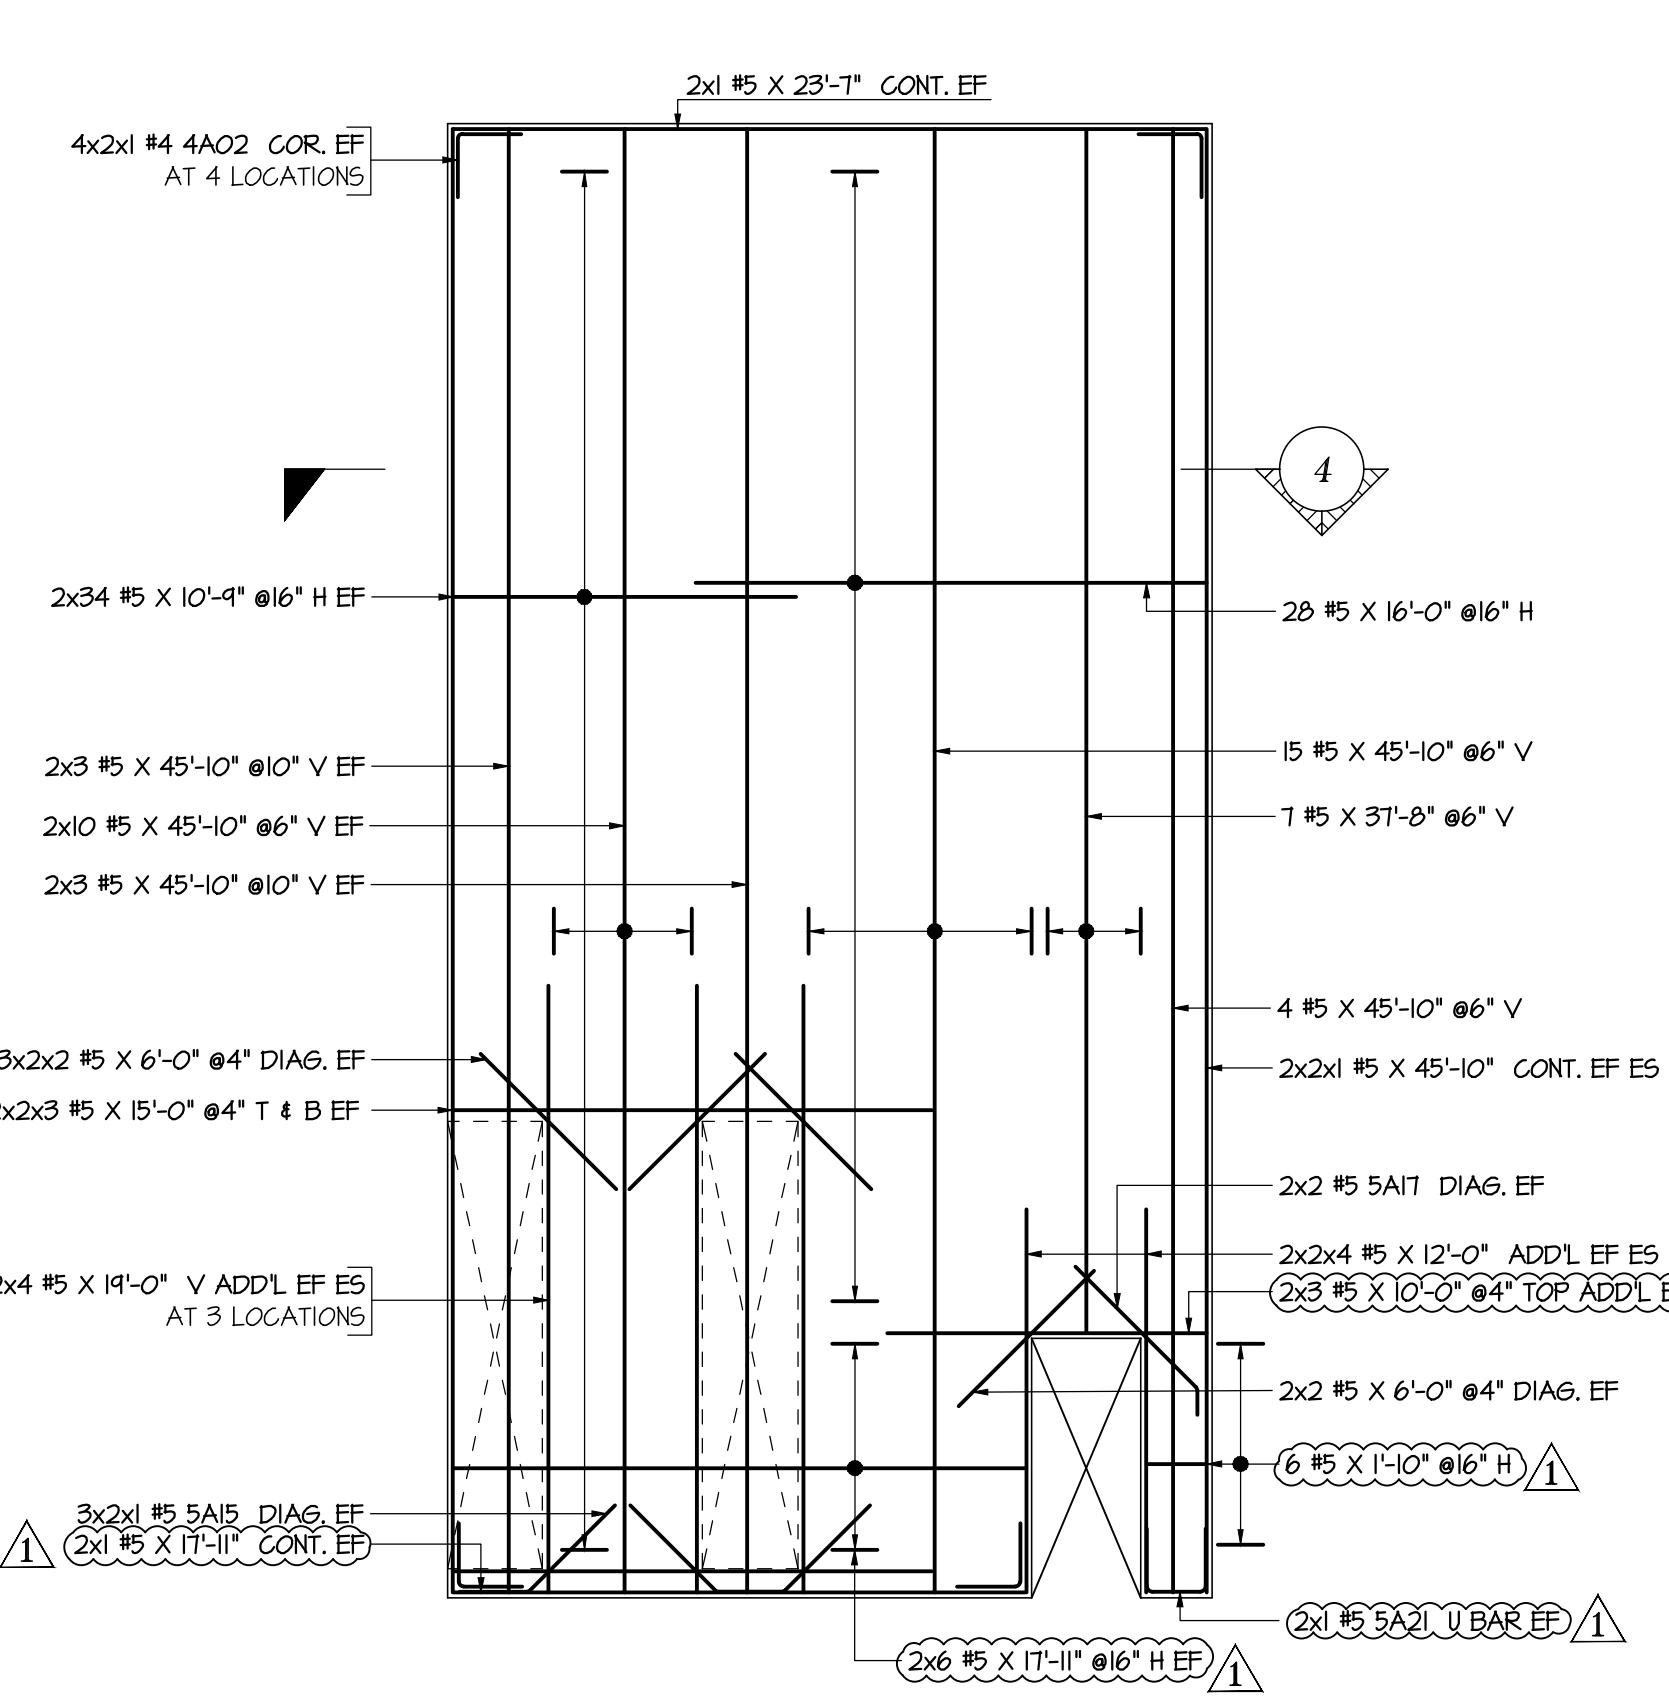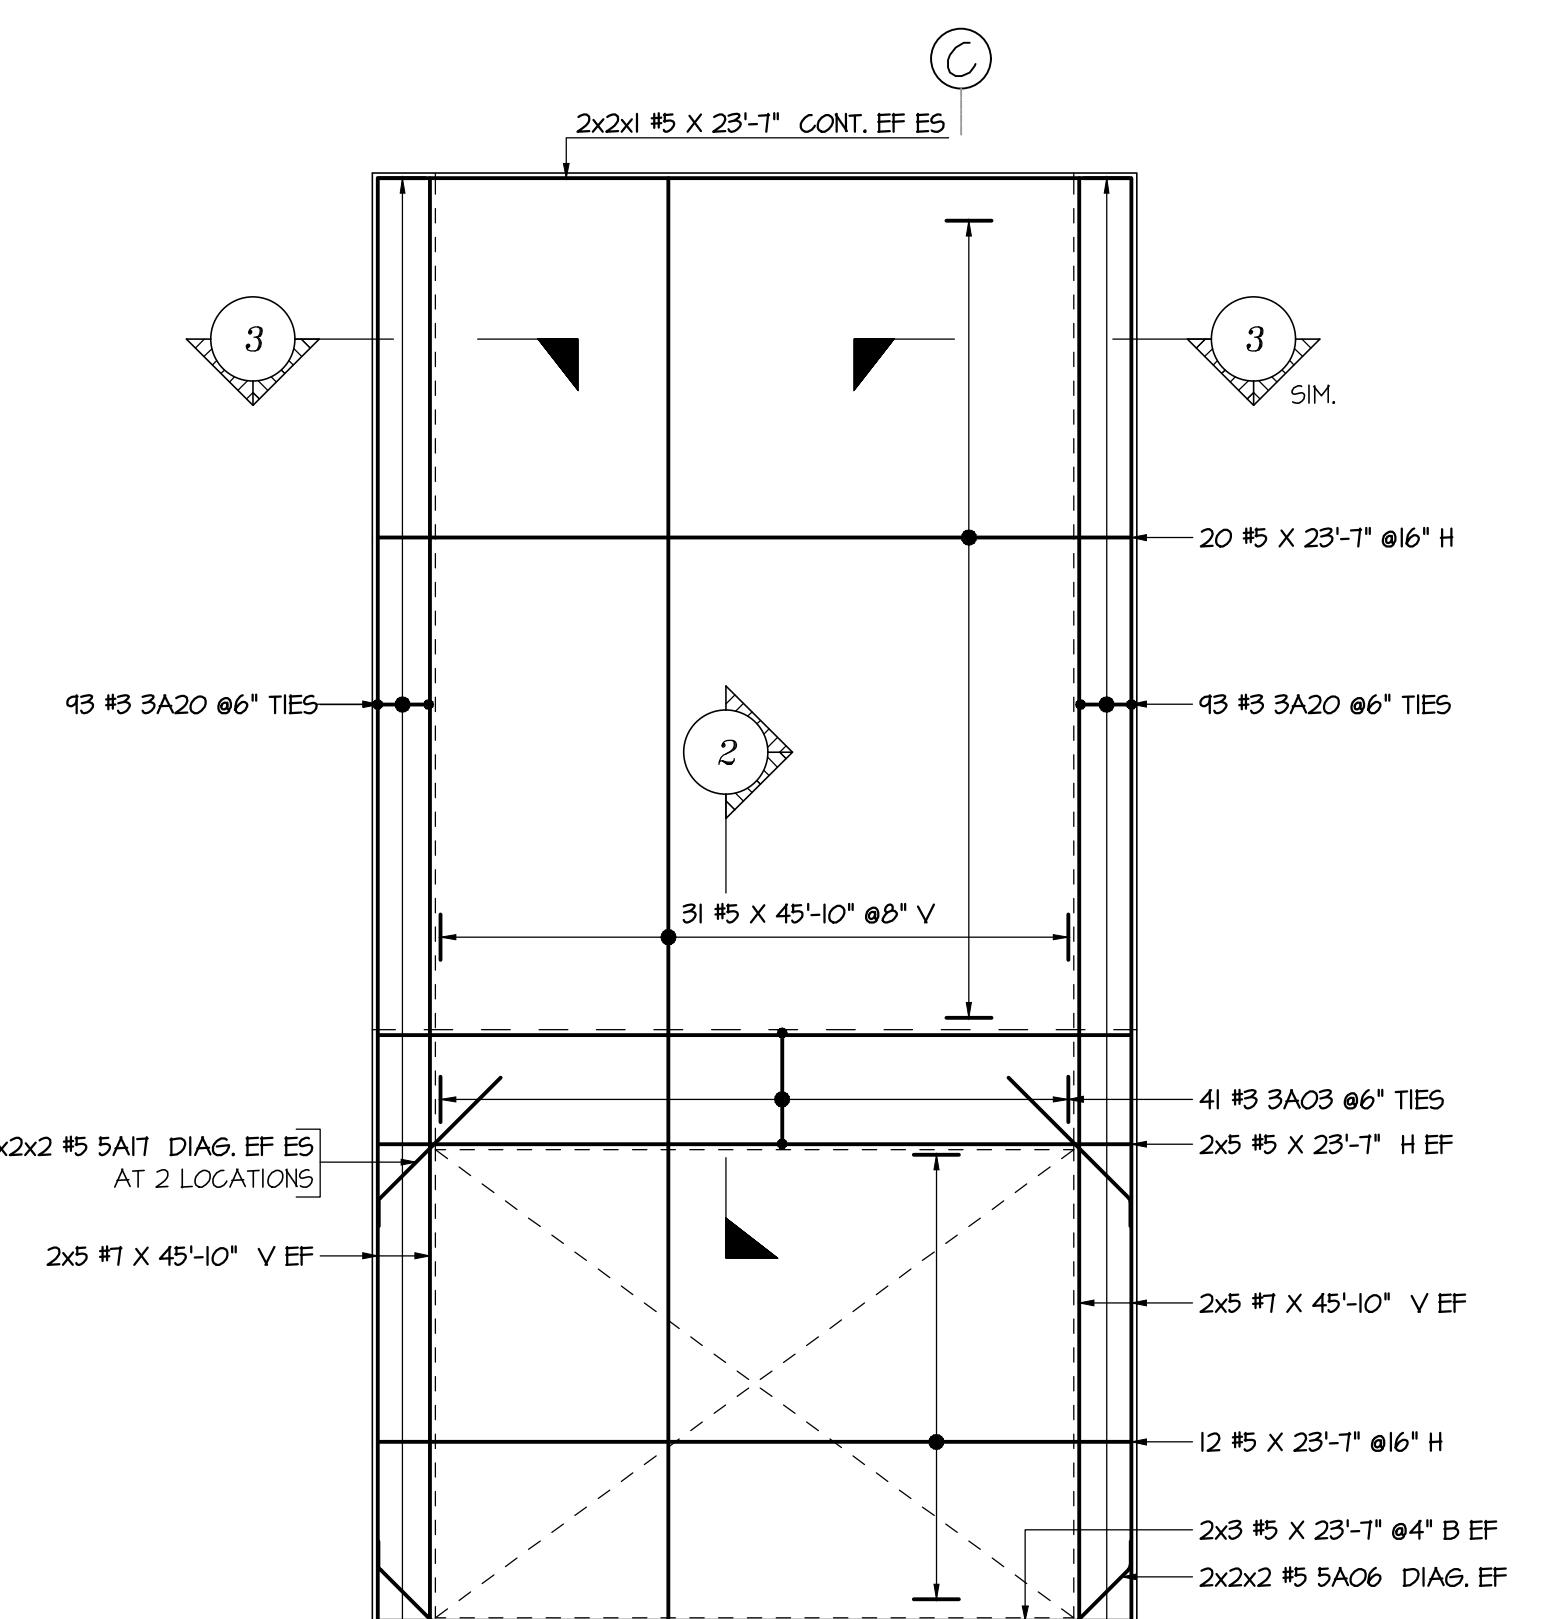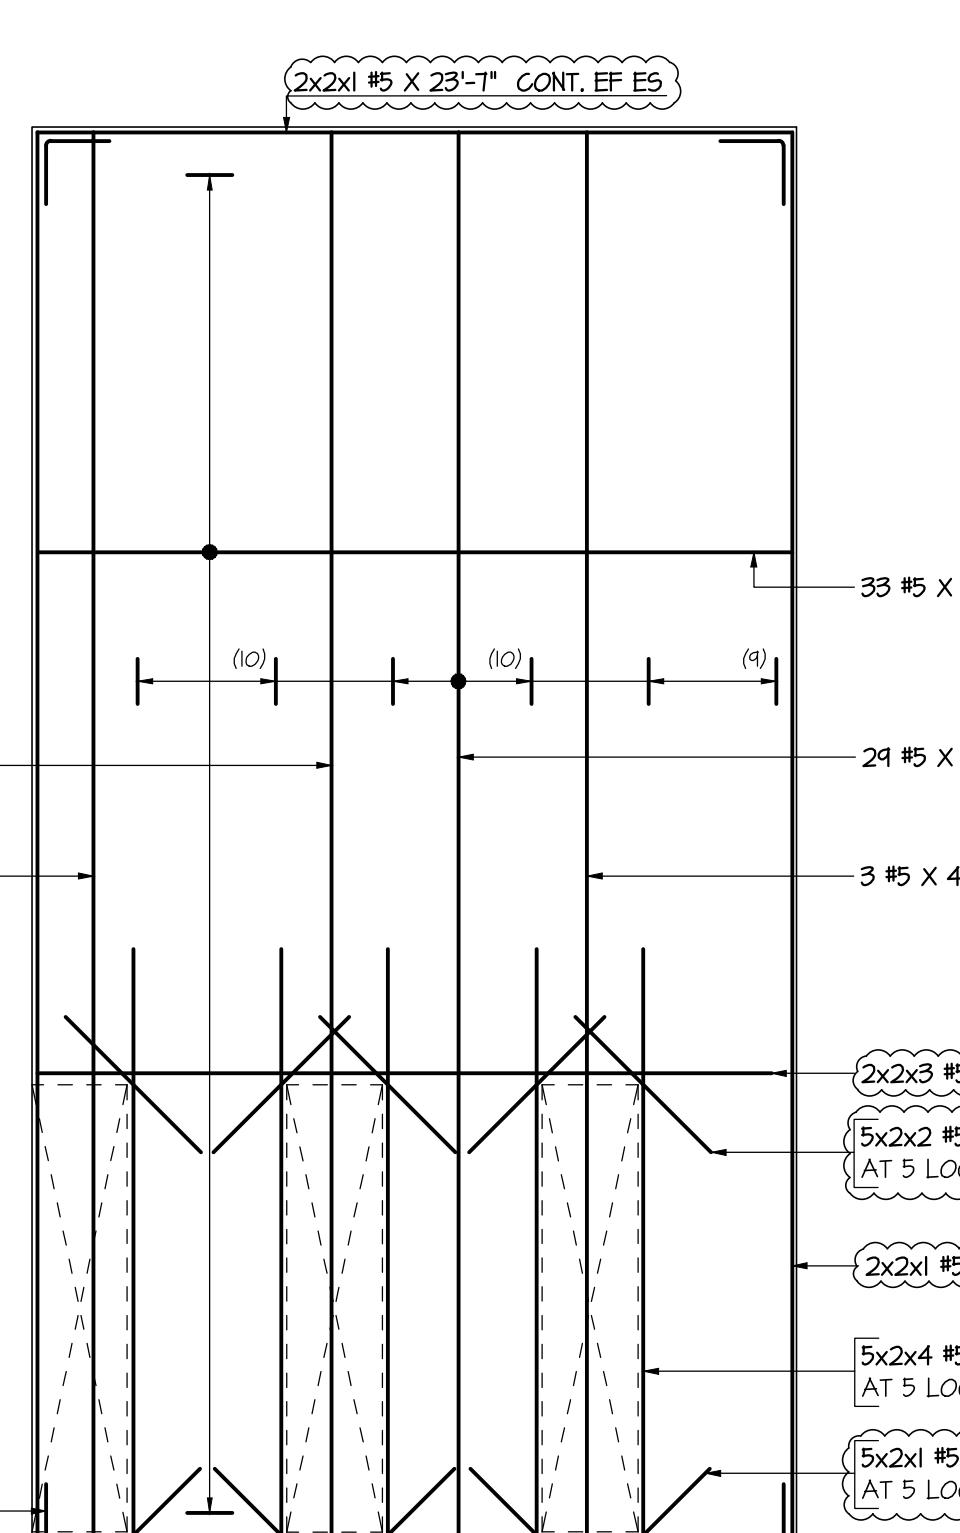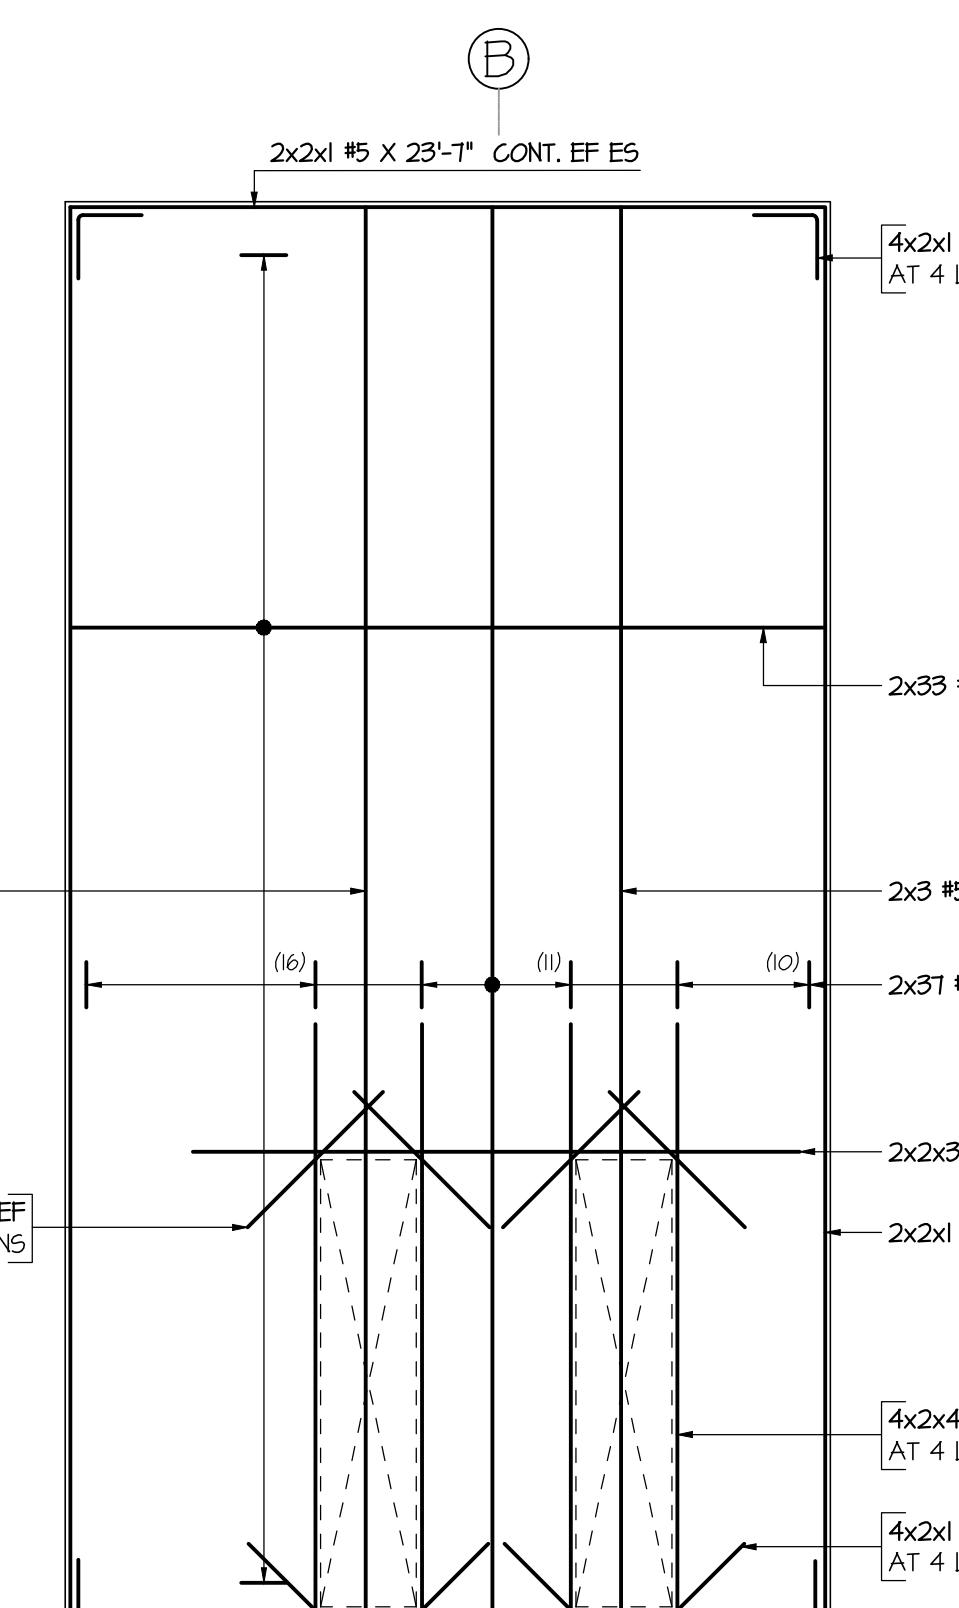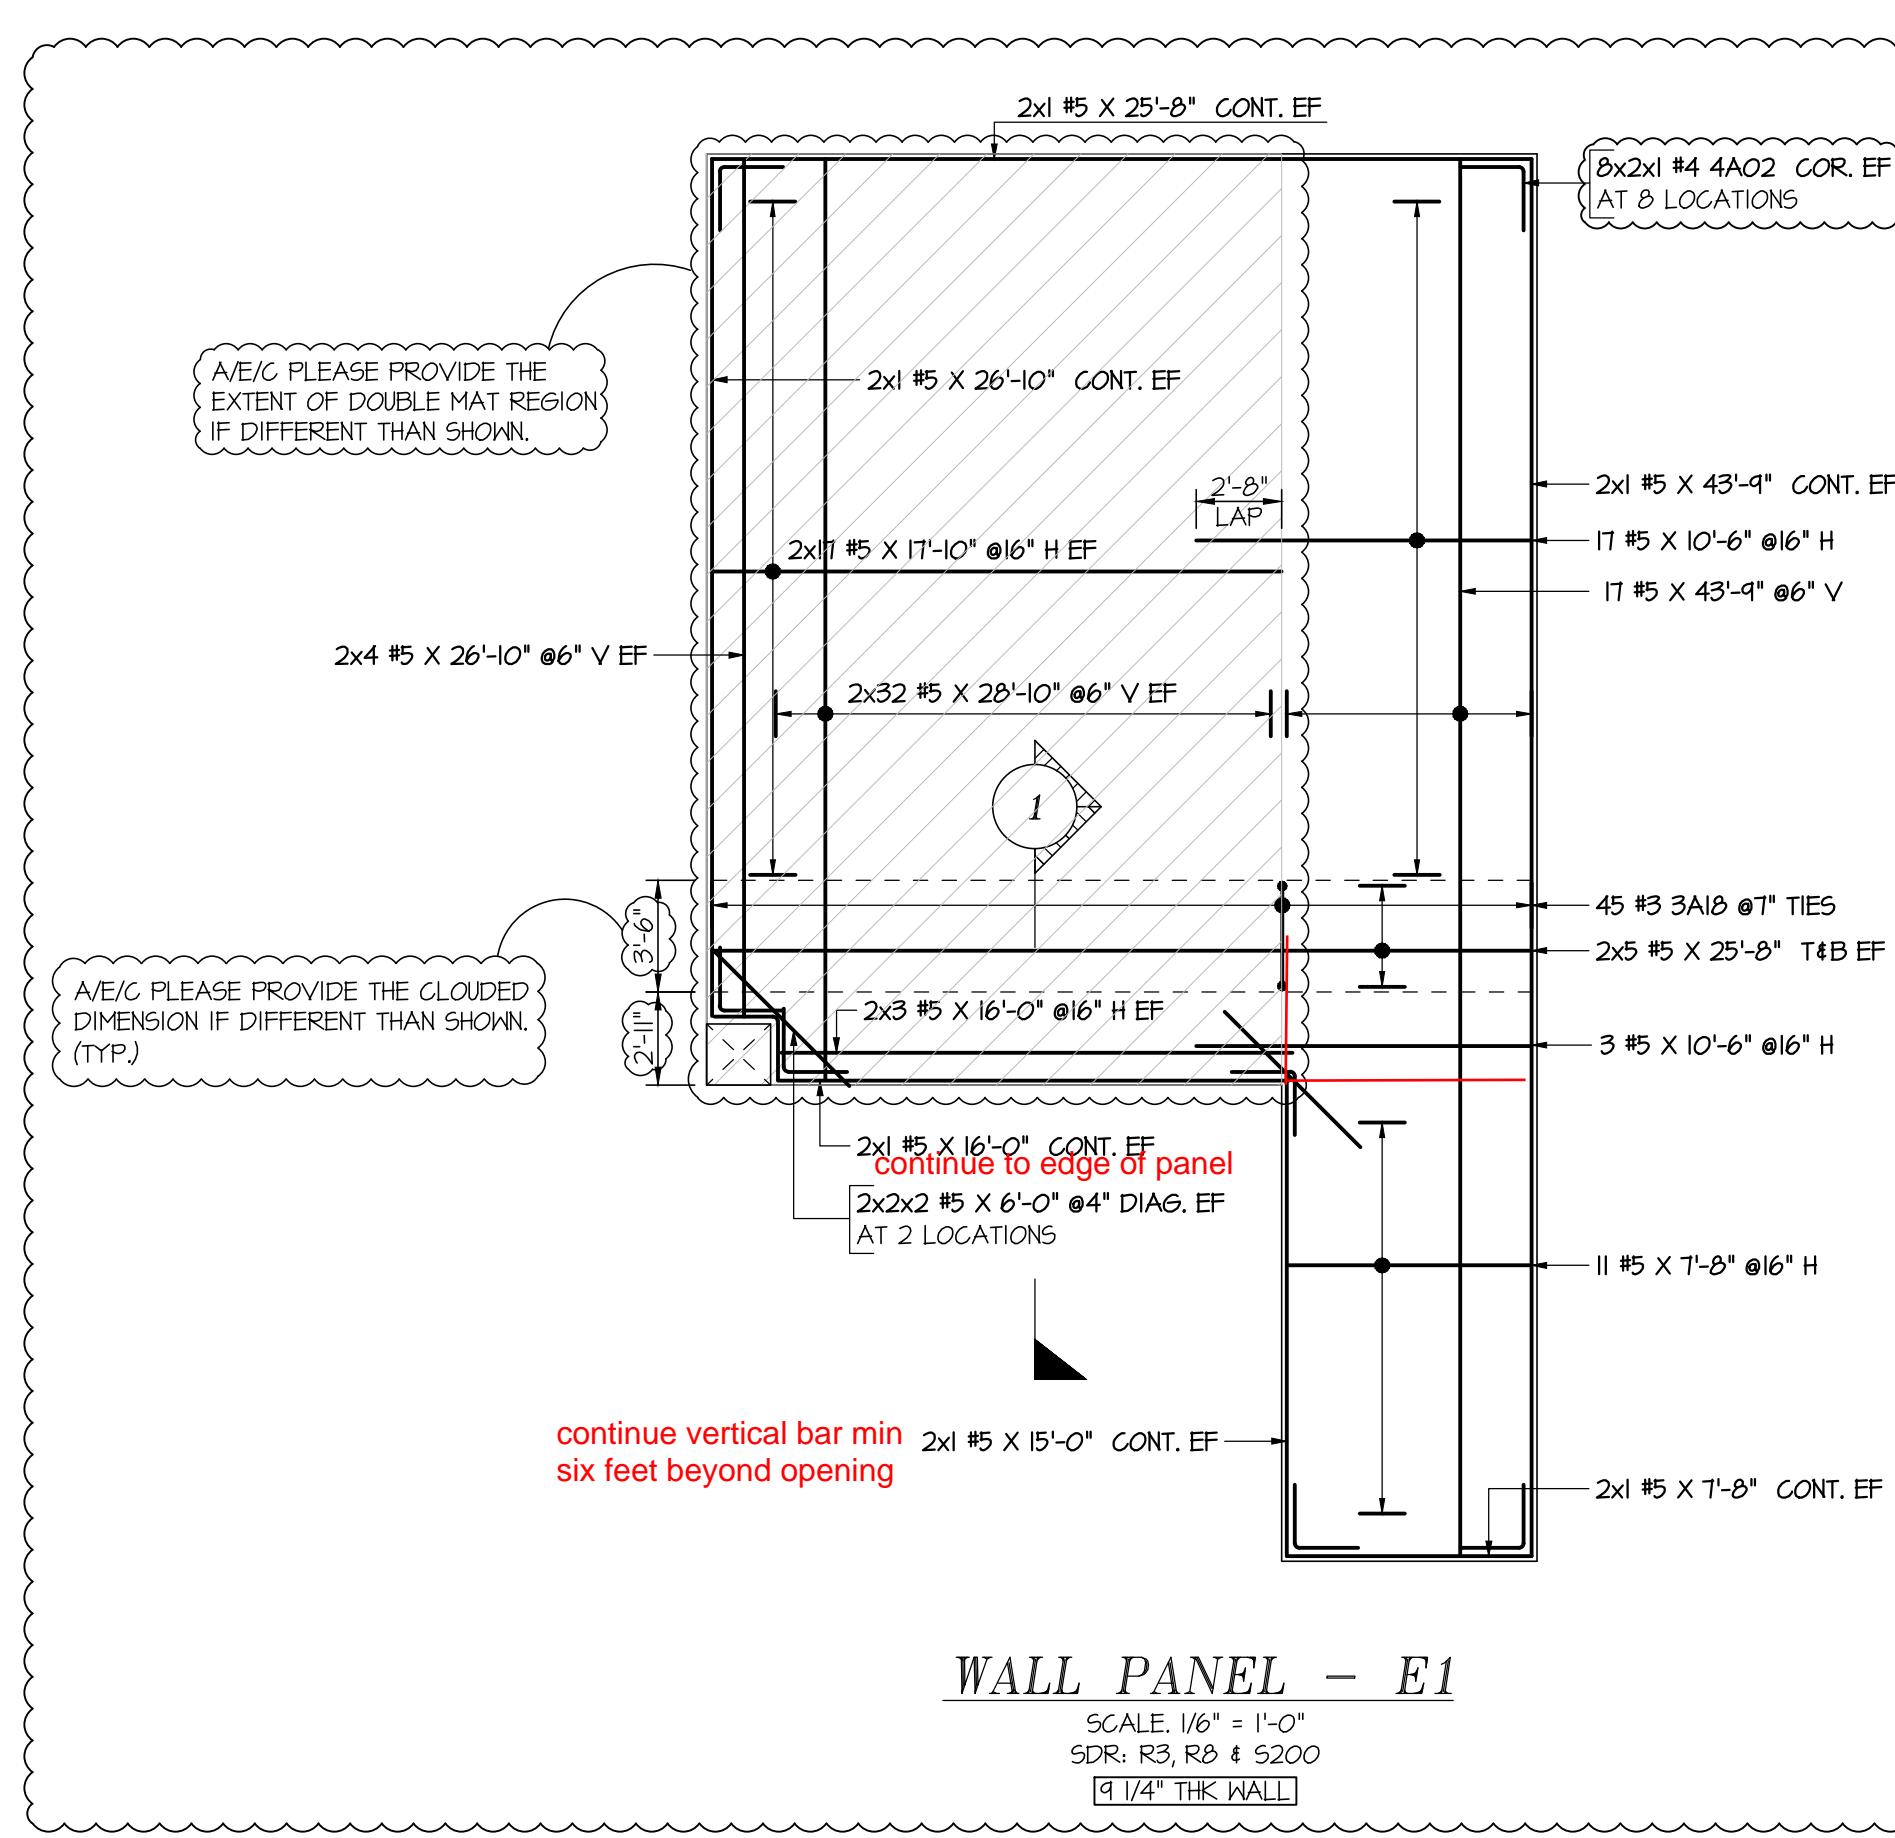

SECTION 1

Dimensions shown for Section 1:

- Total height: 3'-6"
- Top horizontal clearance (CLR.): 0'-2"
- Bottom horizontal clearance (CLR.): 0'-12"
- Vertical clearance (CLR.): 0'-04"
- Reinforcement: #5 @ 6" V EF, #5 @ 16" H EF, #5 T&B EF, 3A18 @ 7" TIES.

SECTION 2

Dimensions shown for Section 2:






- Total height: 3'-0"
- Top horizontal clearance (CLR.): 0'-2"
- Bottom horizontal clearance (CLR.): 0'-04"
- Vertical clearance (CLR.): 0'-04"
- Reinforcement: #5 @ 8" V, #5 @ 16" H EF, #5 H EF, 3A03 @ 6" TIES.


SECTION

SCALE: 1/2

SDR: P1/R

A/E/C PLEASE PROVIDE THE DIMENSIONS IF DIFFERENT THAN SHOWN. (TYP.)

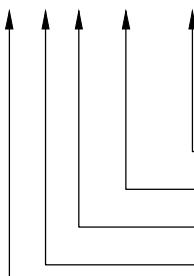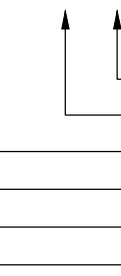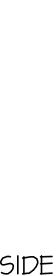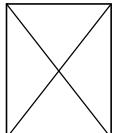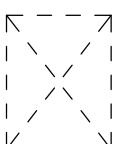
<u>STRUCTURAL NOTES</u>	
<u>CLEAR COVER TO REINFORCEMENT</u>	
WALL PANEL	2" AT ENDS
	1 1/2" #5 & BELOW AT EXTERIOR FACE
	2" #6 & ABOVE AT EXTERIOR FACE
	3/4" AT INTERIOR FACE
<u>LEGENDS</u>	
T - TOP	
B - BOTTOM	
V, VERT - VERTICAL	
H, HORIZ - HORIZONTAL	
CLR. - CLEAR COVER	
SIM. - SIMILAR	
TYP. - TYPICAL	
T.O.MAT - TOP OF MAT	
ES - EACH SIDE	
EF - EACH FACE	
CONT - CONTINUOUS	
COR. - CORNER	
THK. - THICKNESS	
ADD'L - ADDITIONAL	
DIAG. - DIAGONAL	
NTS - NOT TO SCALE	
¢ - CENTER LINE	
SDR - STRUCTURAL DRAWING REFERENCE	
<u>LABEL LEGENDS</u>	
6x2x6 #4 4C09 @12" B2	
	NOTES SPACING
	BAR MARK
	BAR SIZE
	NUMBER OF BARS
	EACH FACE/EACH SIDE
	NUMBER OF LOCATION
	DENOTES OPENINGS
	DENOTES KNOCK OUTS

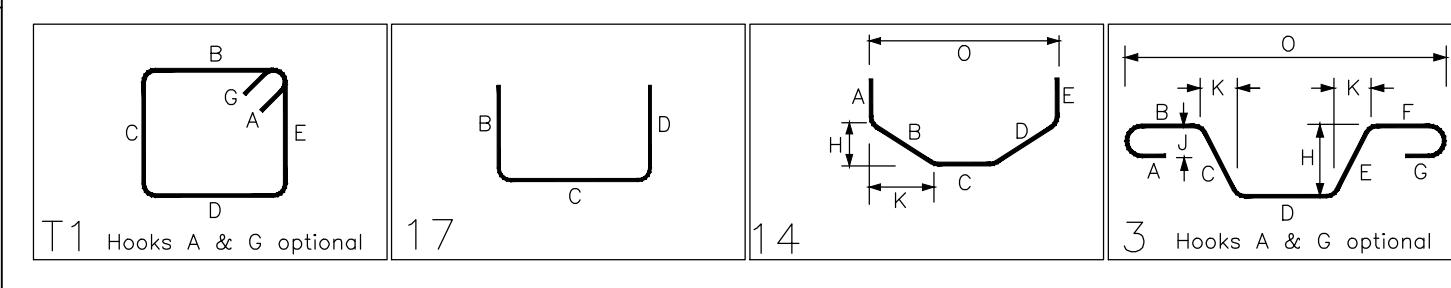


<u>EAST WALL PANELS PLACING DRAWING REFERENCE</u>	
DWG.NO:	DRAWING DESCRIPTION
R-1	EAST WALL PANELS E1 TO E8
R-2	EAST WALL PANELS E9 TO E16
R-3	EAST WALL PANELS E17 TO E23

REINFORCING STEEL PLACING DRAWING ONLY. USE IN
CONJUNCTION WITH CONTRACT DRAWINGS & SPECIFICATIONS.
NOTATIONS & DIMENSIONS SHOWN ON THIS DRAWING ARE FOR
ROUTING PURPOSES ONLY AND SHOULD NOT BE USED FOR
CONSTRUCTION UNLESS VERIFIED BY ENGINEER OR CONTRACTOR.


6.05.2019	RESUBMITTED FOR APPROVAL	
5.23.2019	APPROVAL	
DATE	SENT FOR	
E-STEEL SUPPLY CO., INC.		
REINFORCING STEEL - WIRE MESH		
		
2000 Eddystone Industrial Park • Eddystone, PA 19022-1588		
Phone: 800-876-8216 • Fax: 610-876-8428		
VALLEY VIEW BUSINESS PARK TILT PANELS		
JESSUP, PA		
-		
RICHARD ADAMS ENGINEERS & CONSULTANTS, INC.		
T&T CONSTRUCTION		
y: PRO	Date: 05.23.2019	CONTRACT NO. U2524
DRAWING COVERS EAST WALL PANELS EI TO E8		DRAWING NO. R-1

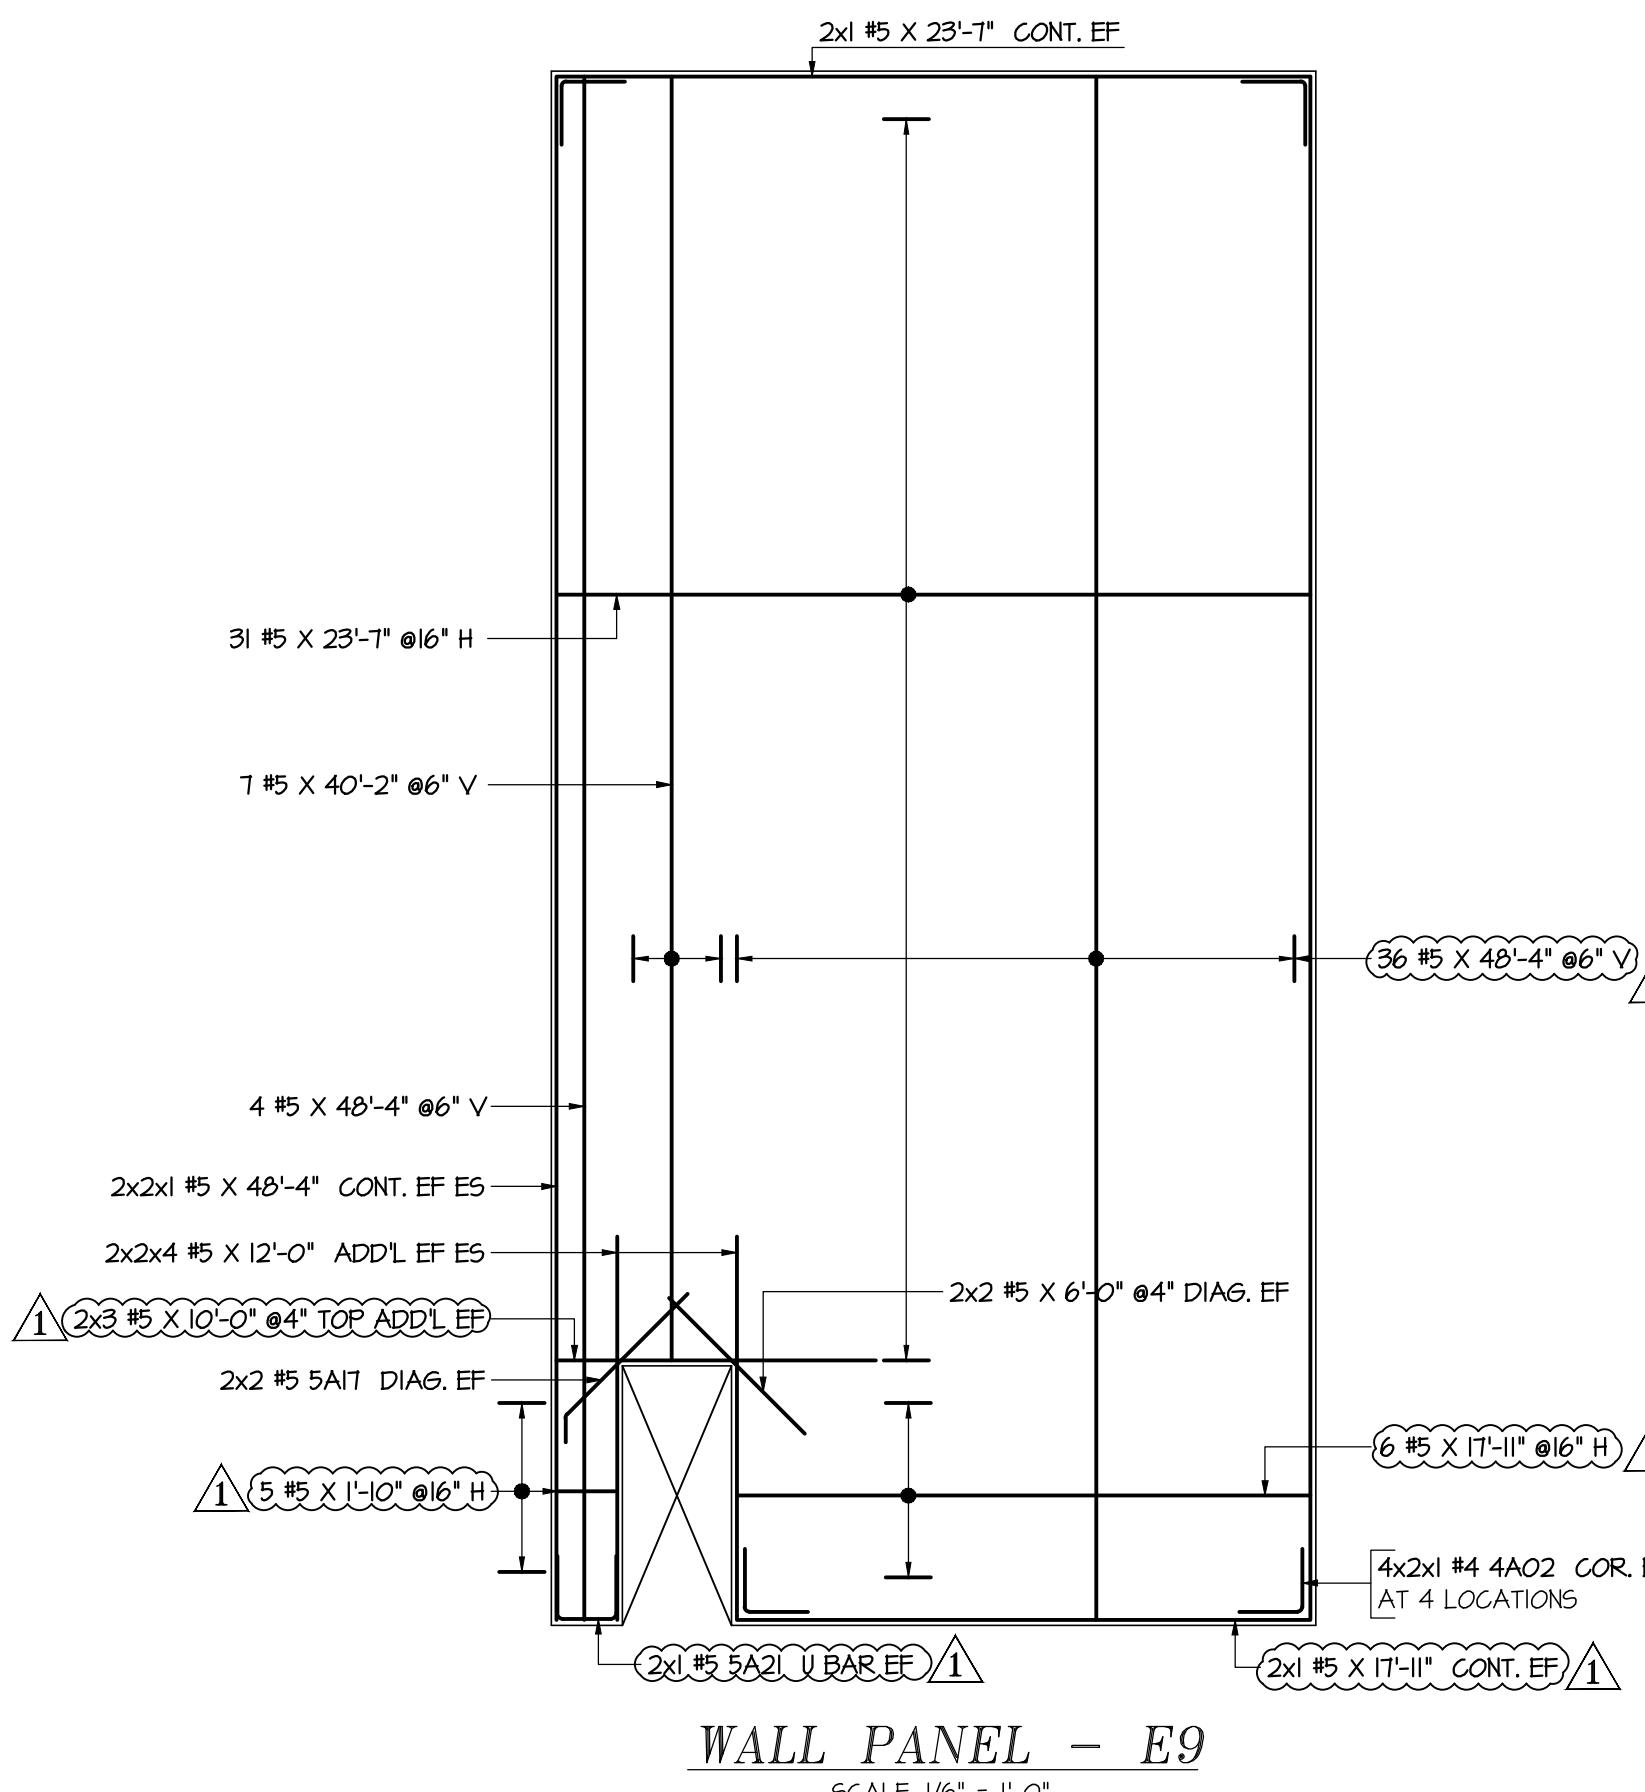


WALL PANEL - E9

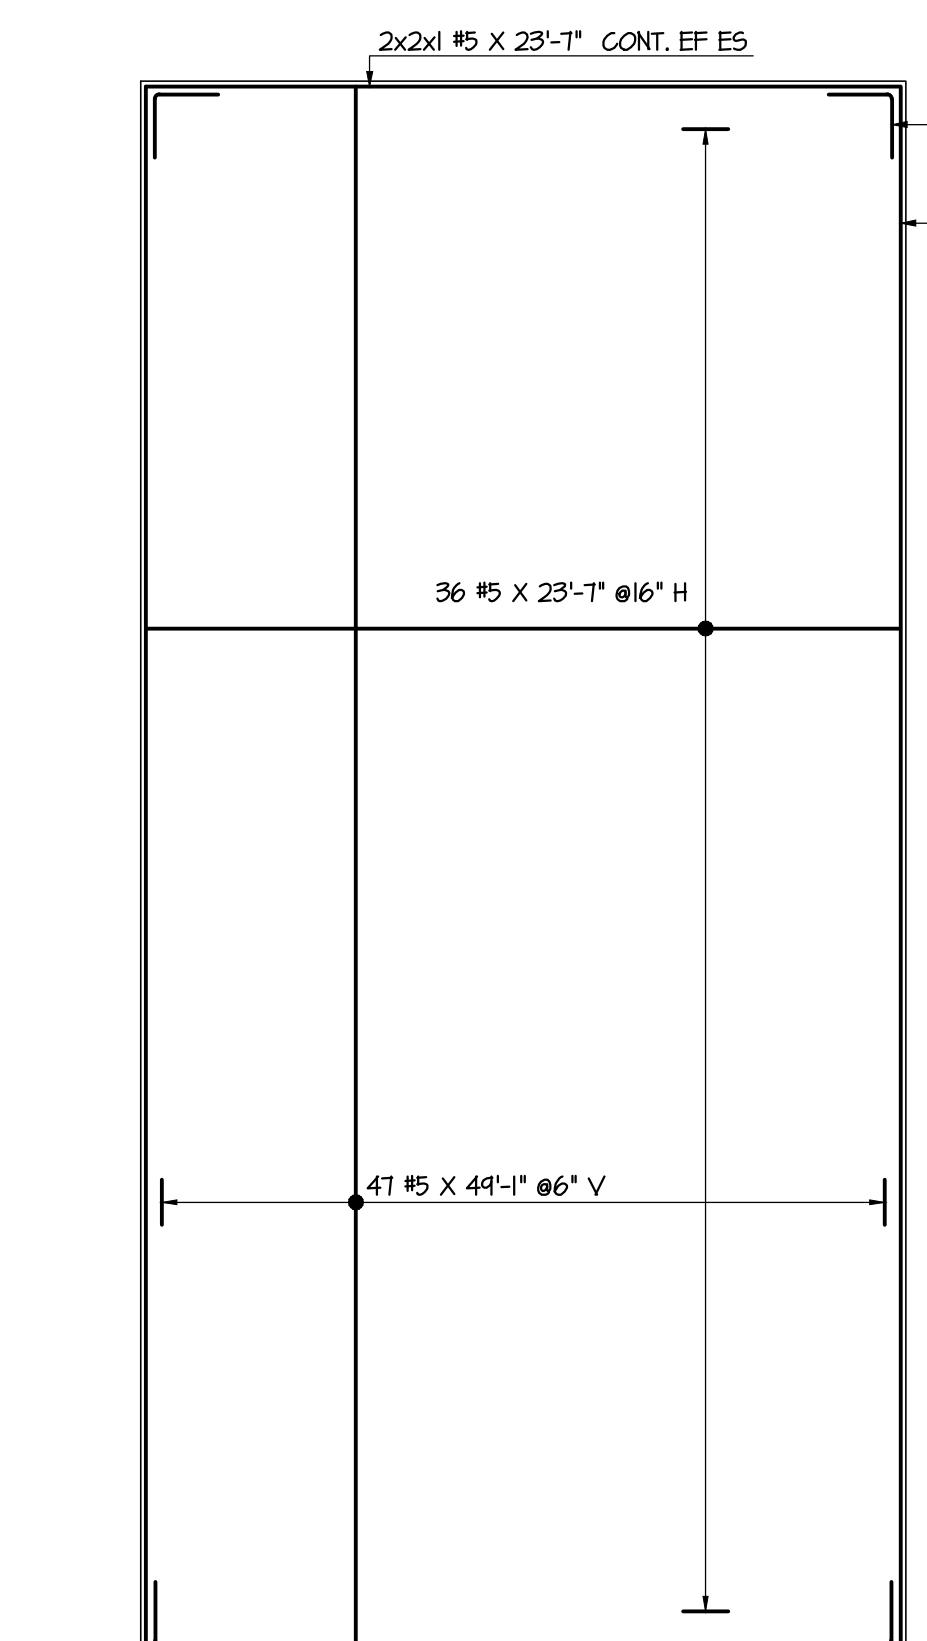


WALL PANEL - E10

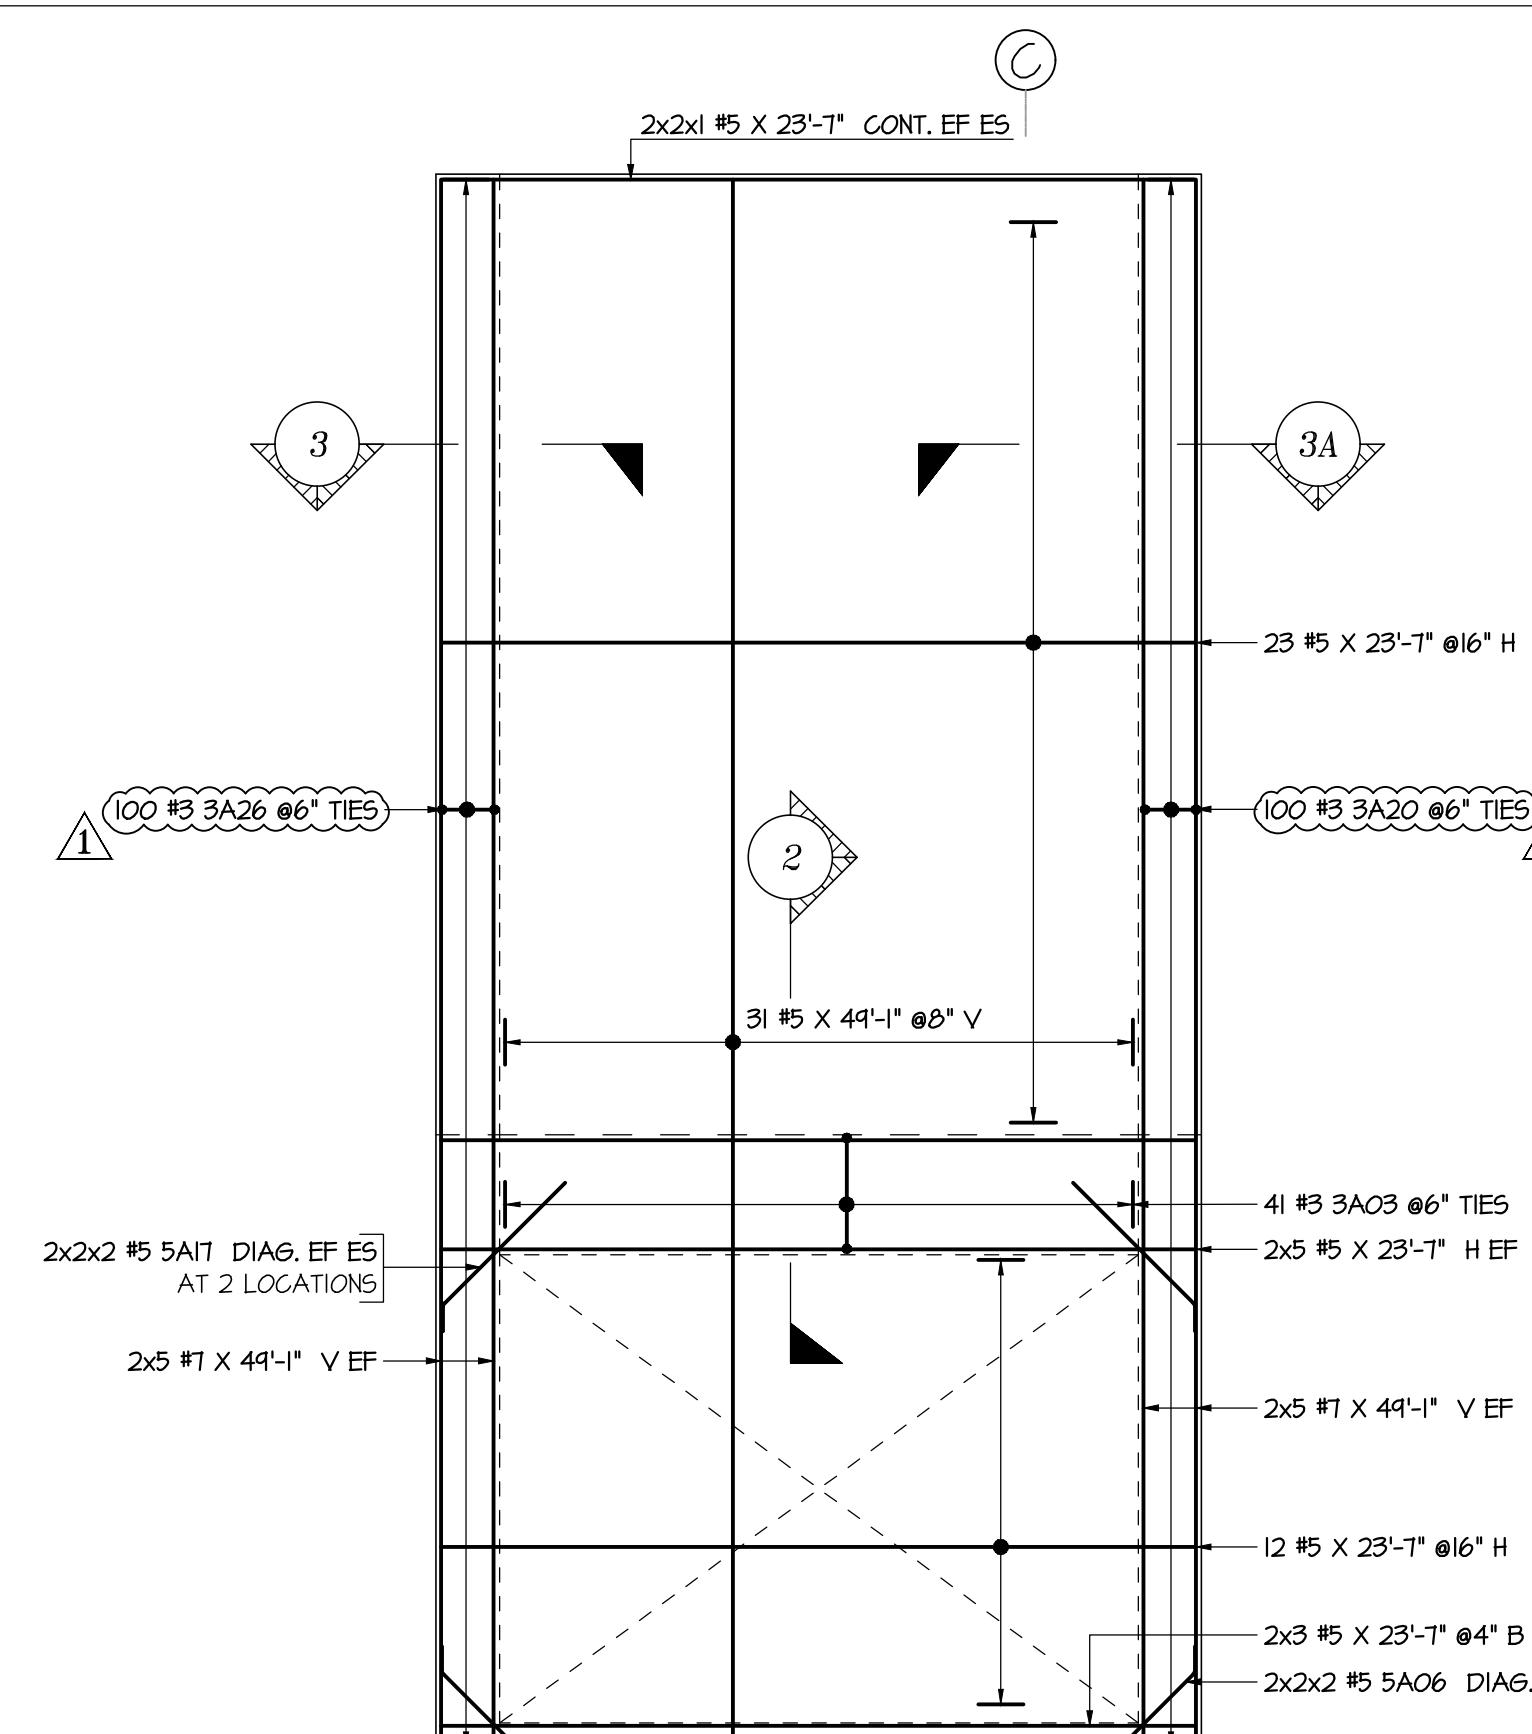


WALL PANEL - E11

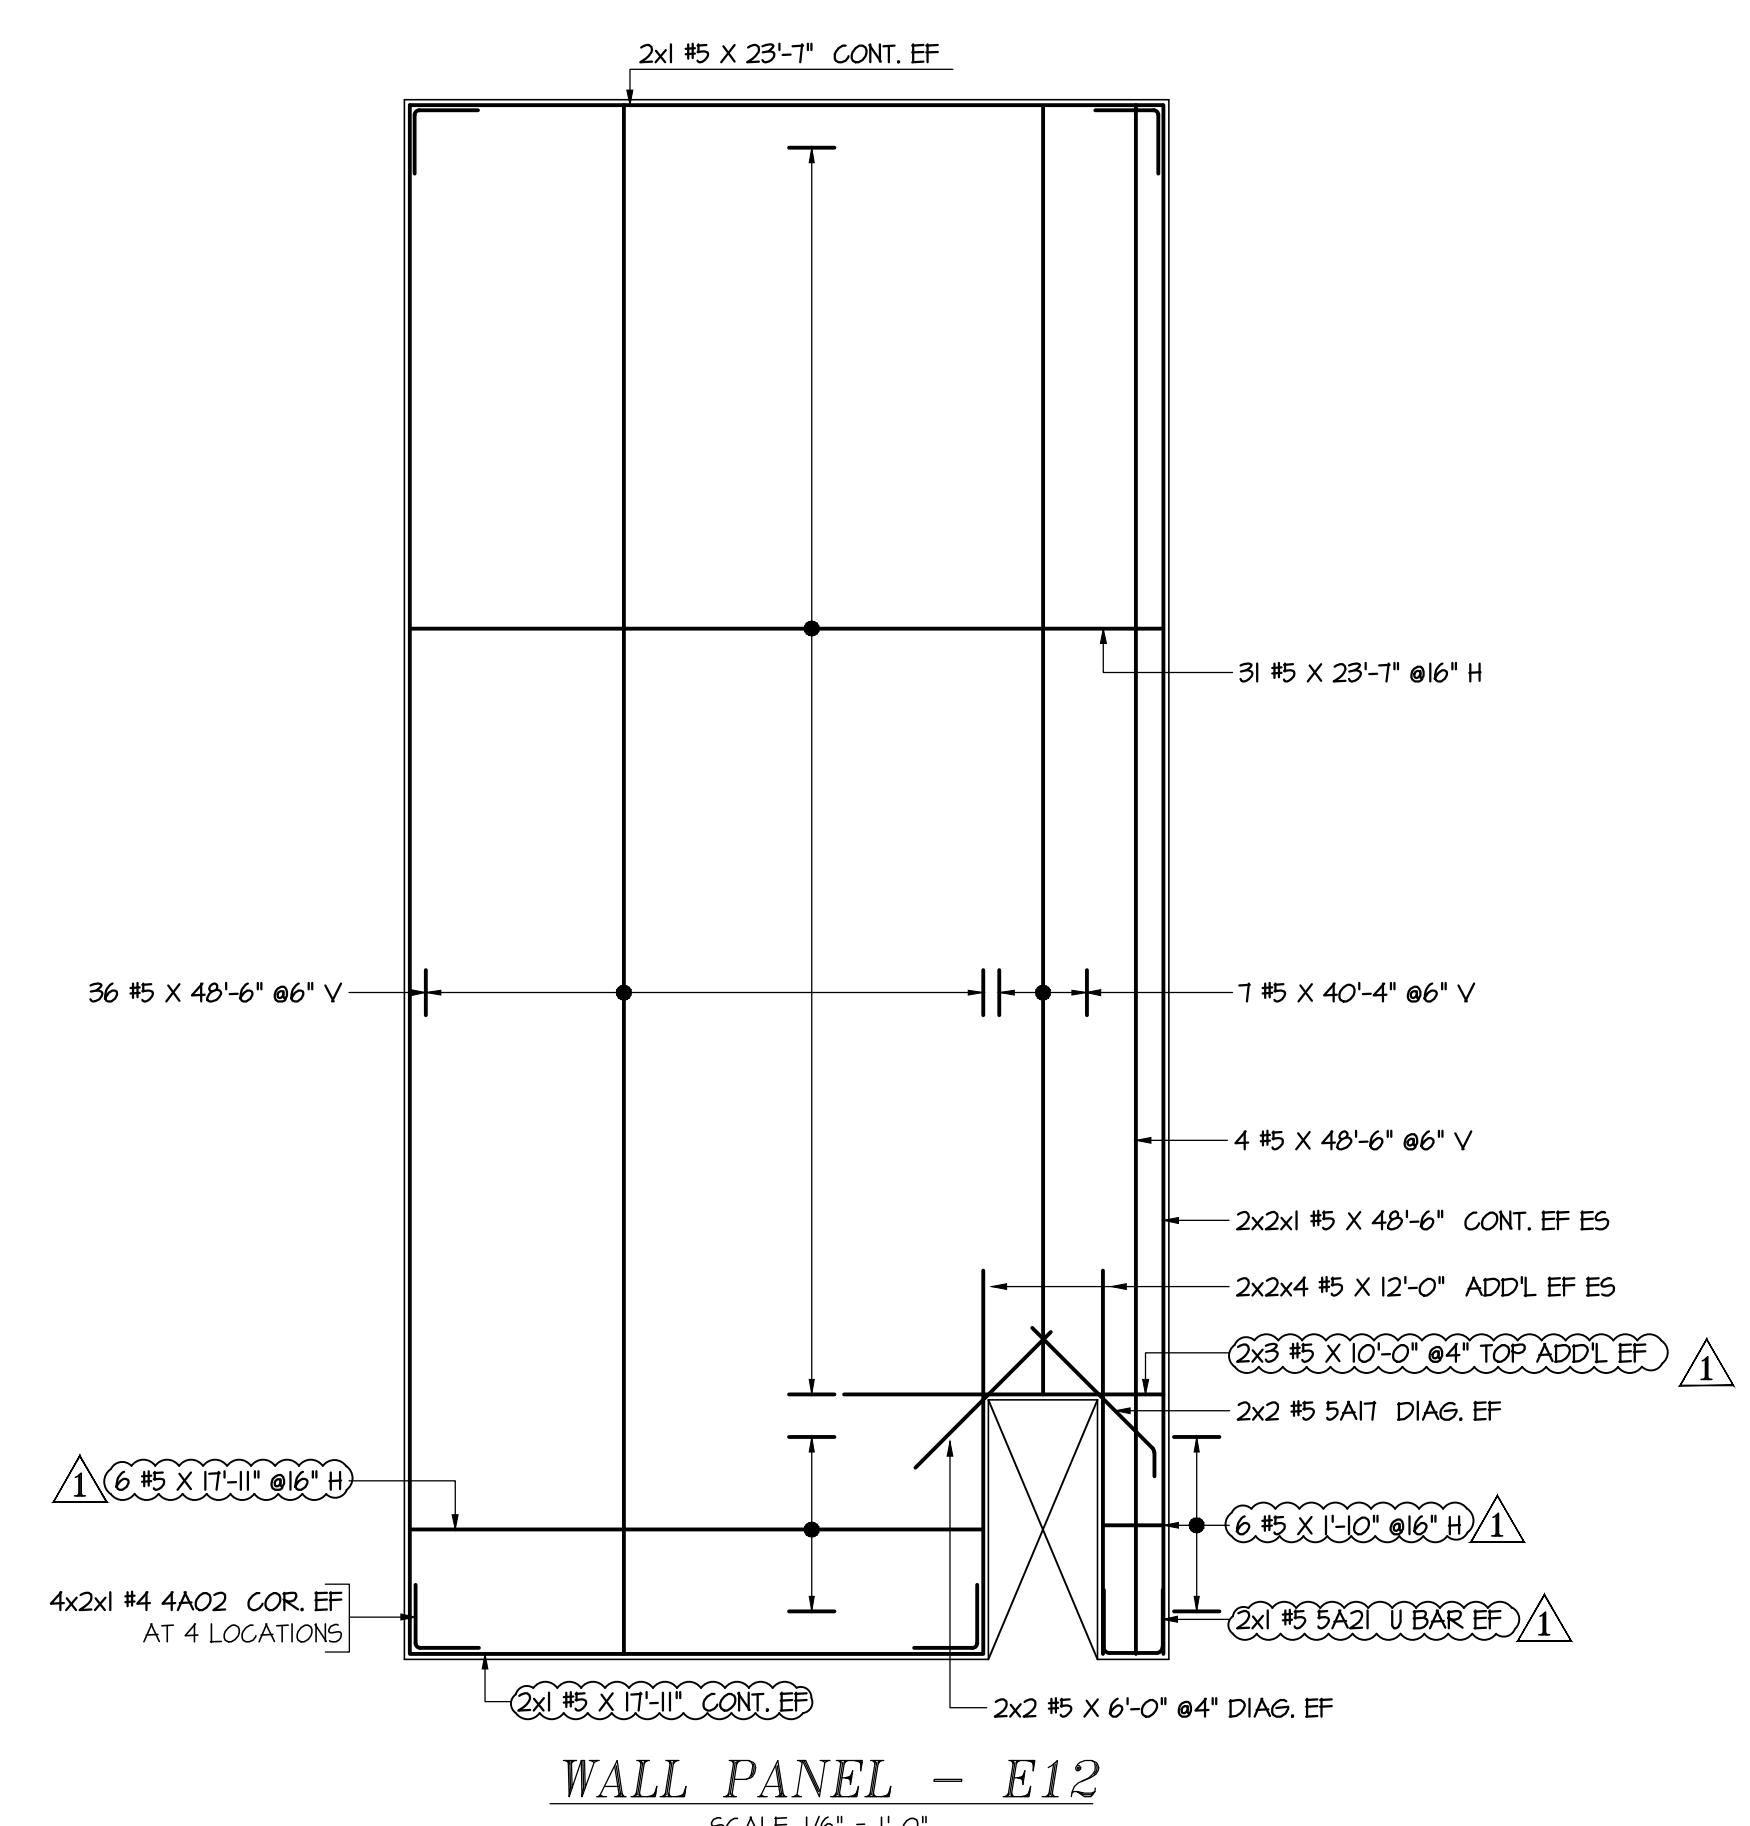


WALL PANEL - E12

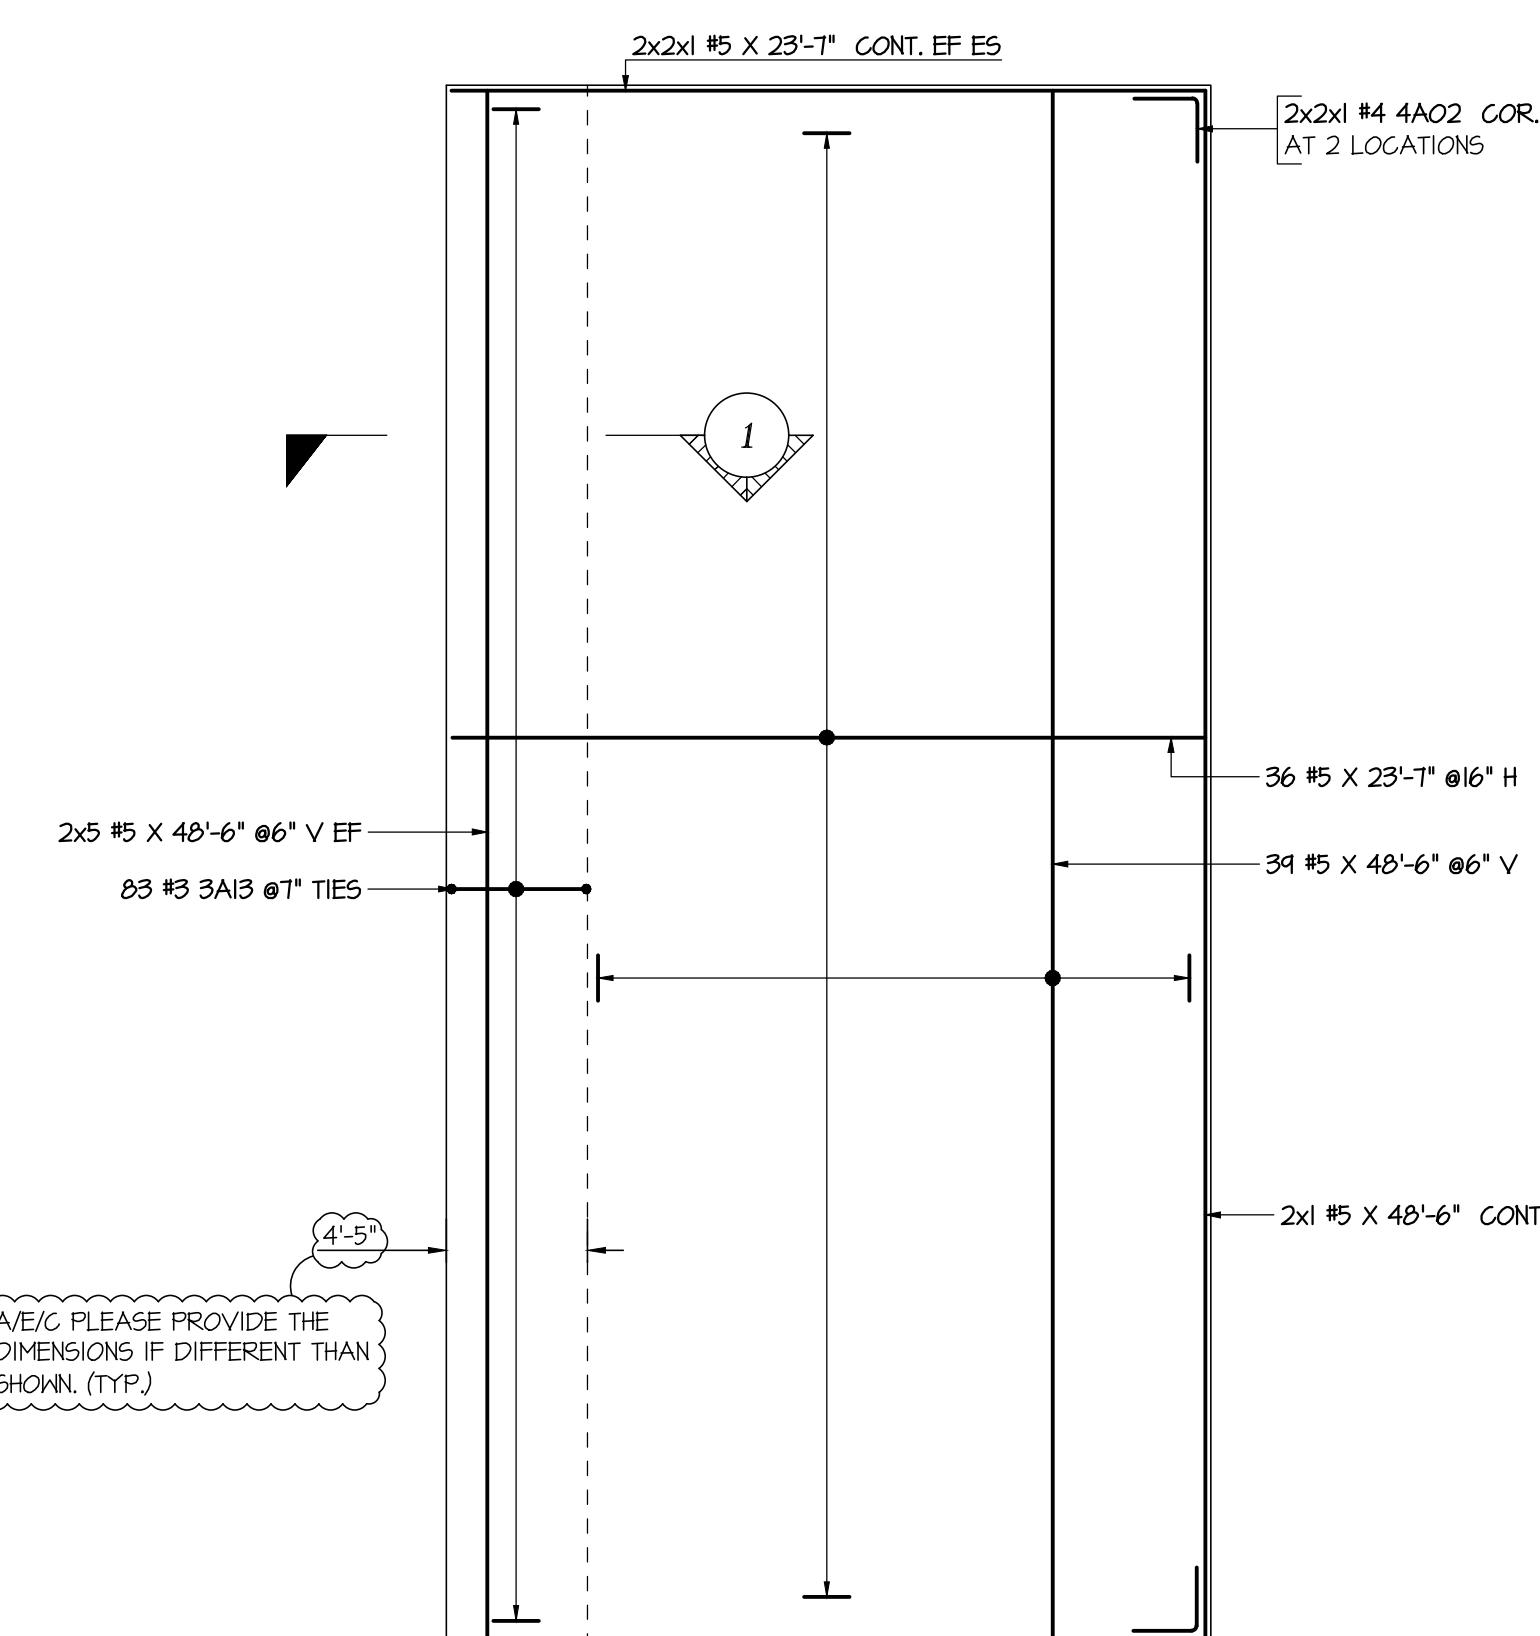


WALL PANEL - E13

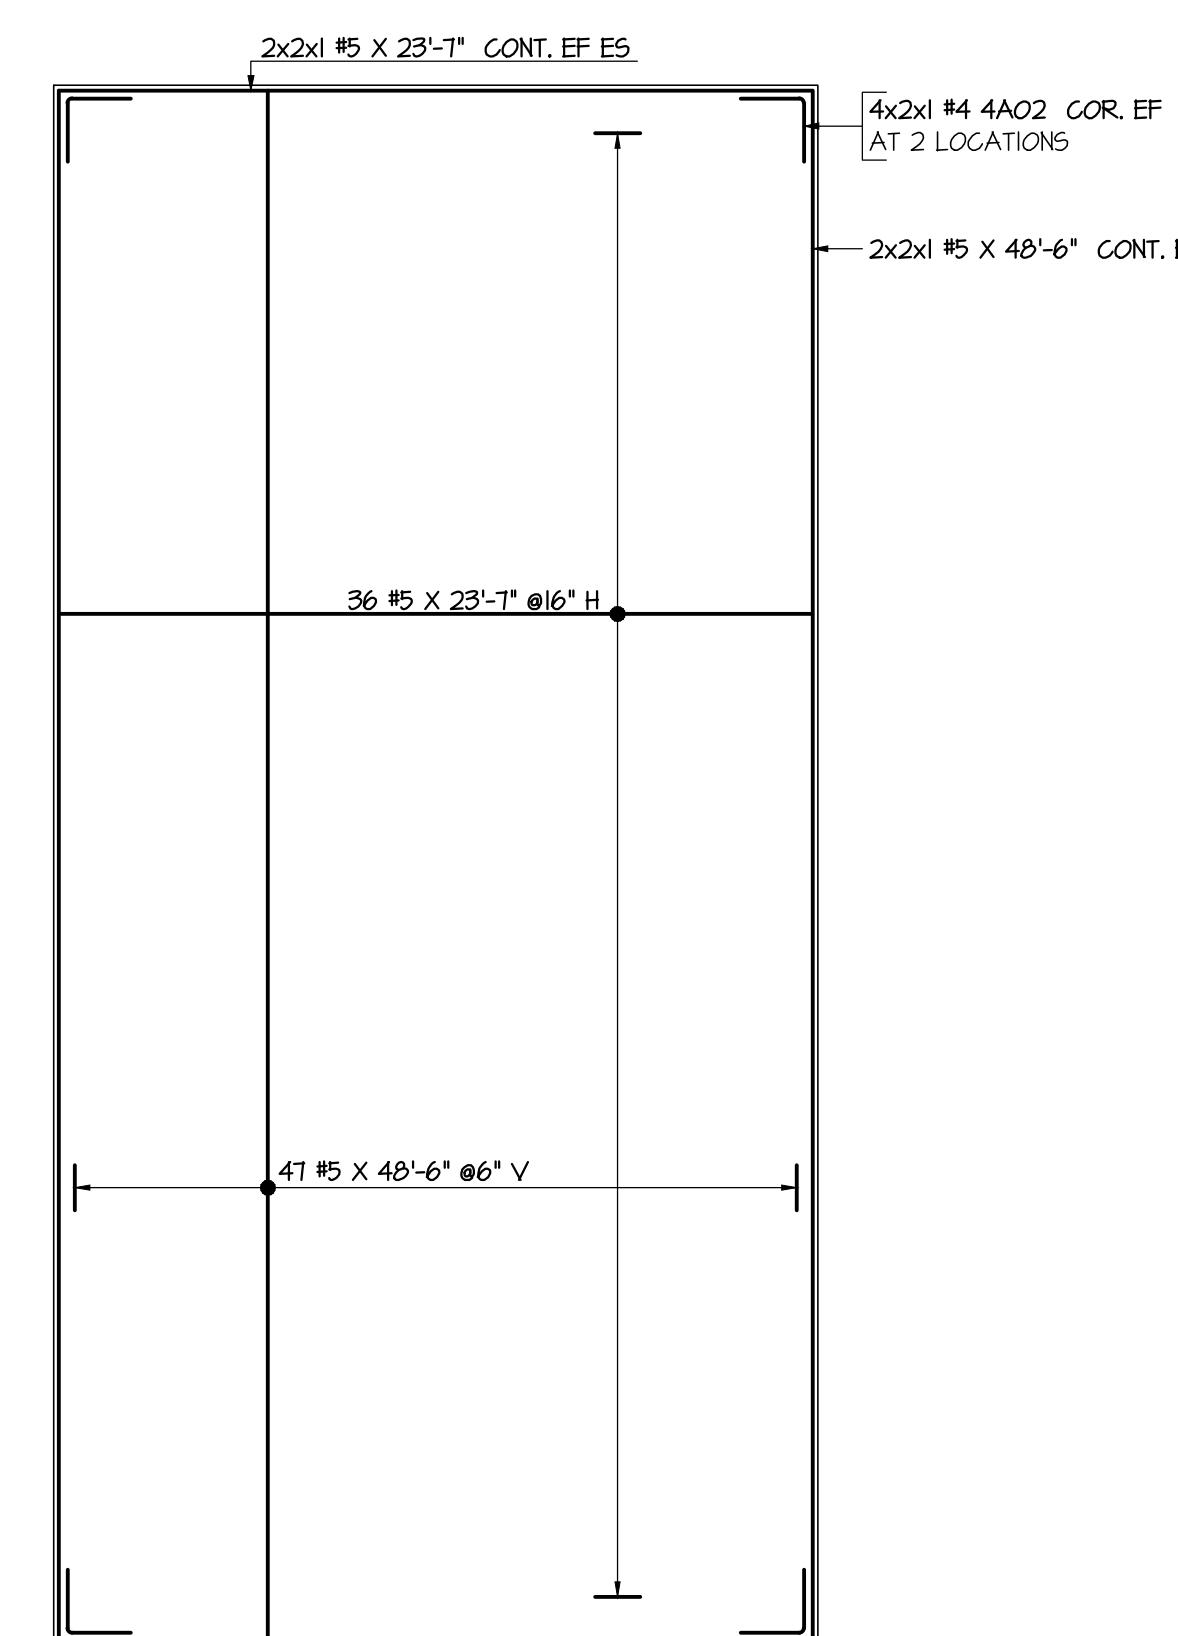

WALL PANEL - E14

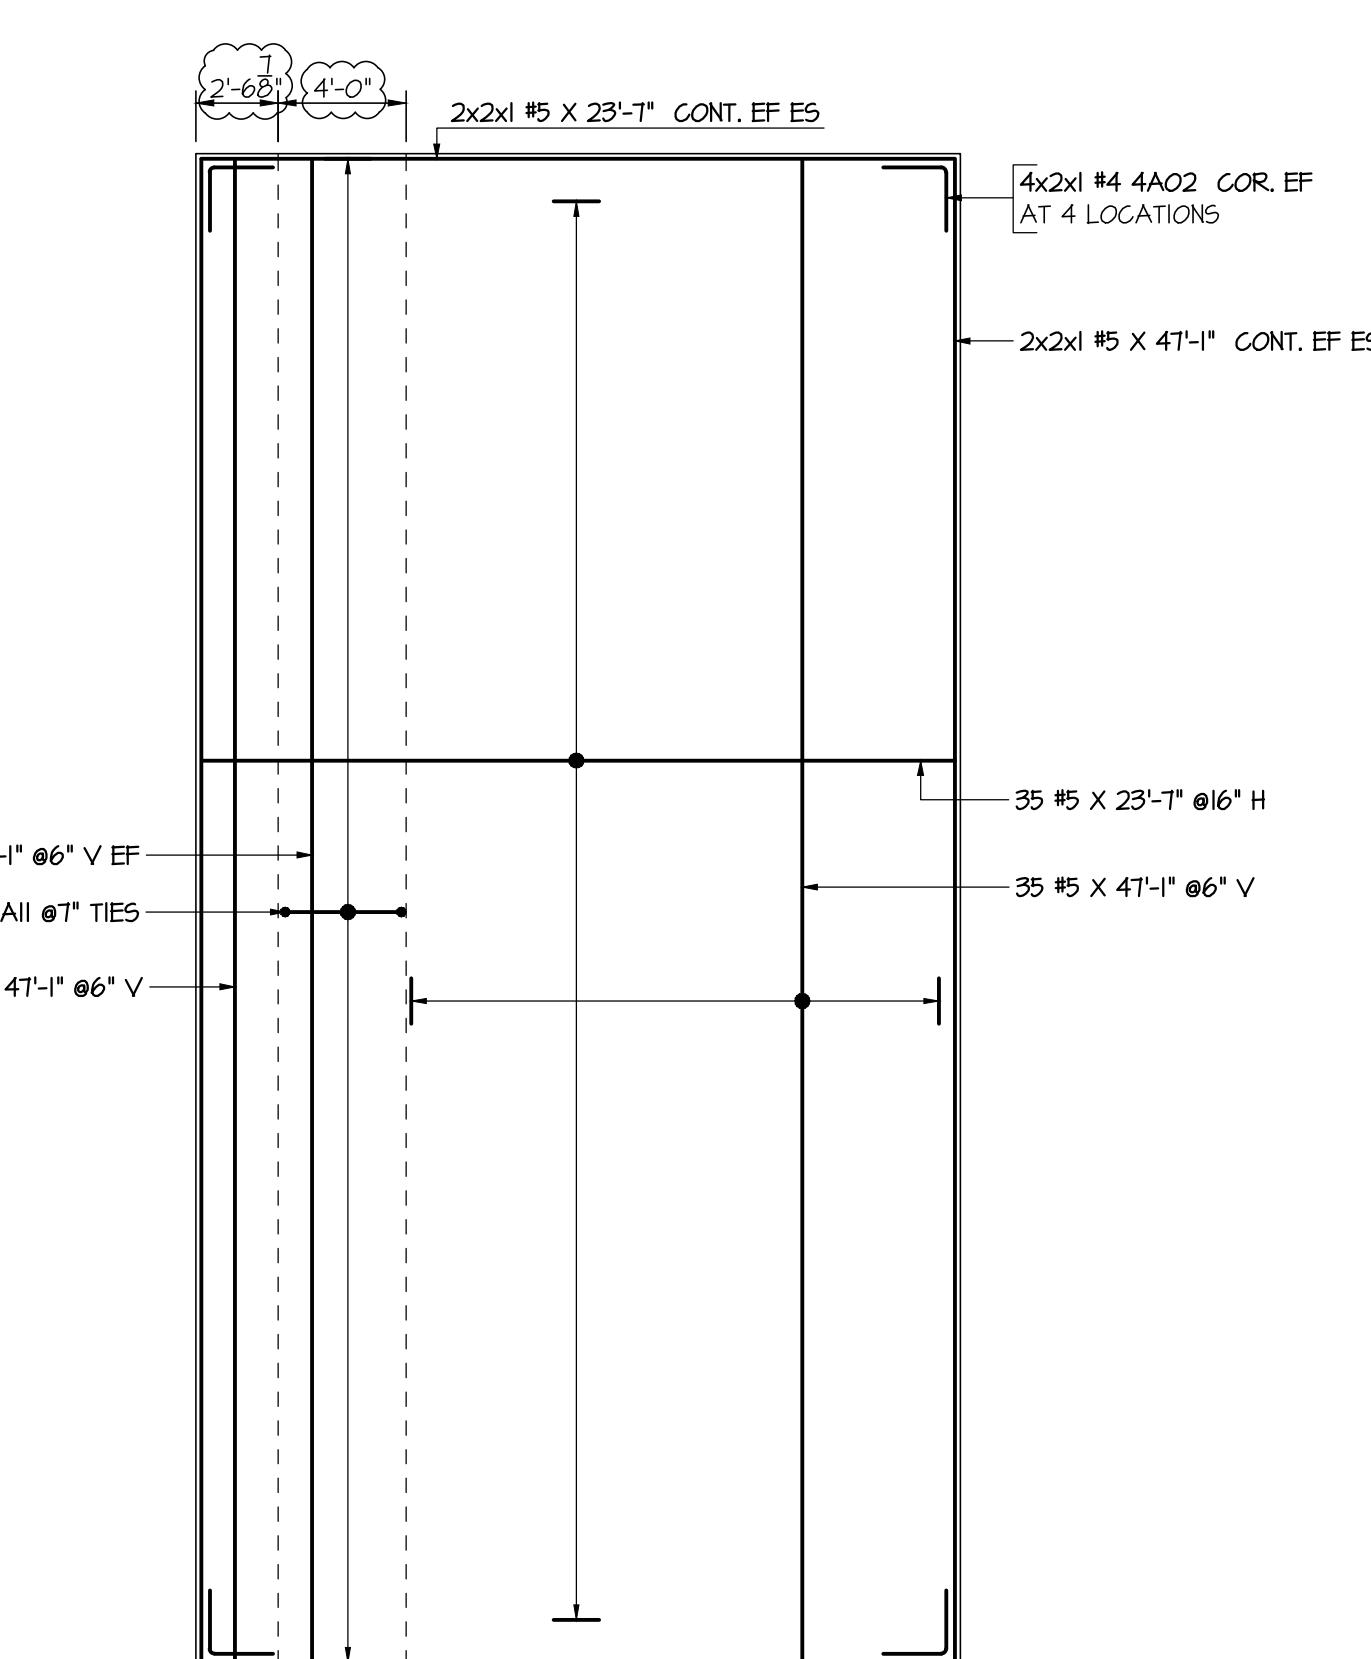

WALL PANEL - E15

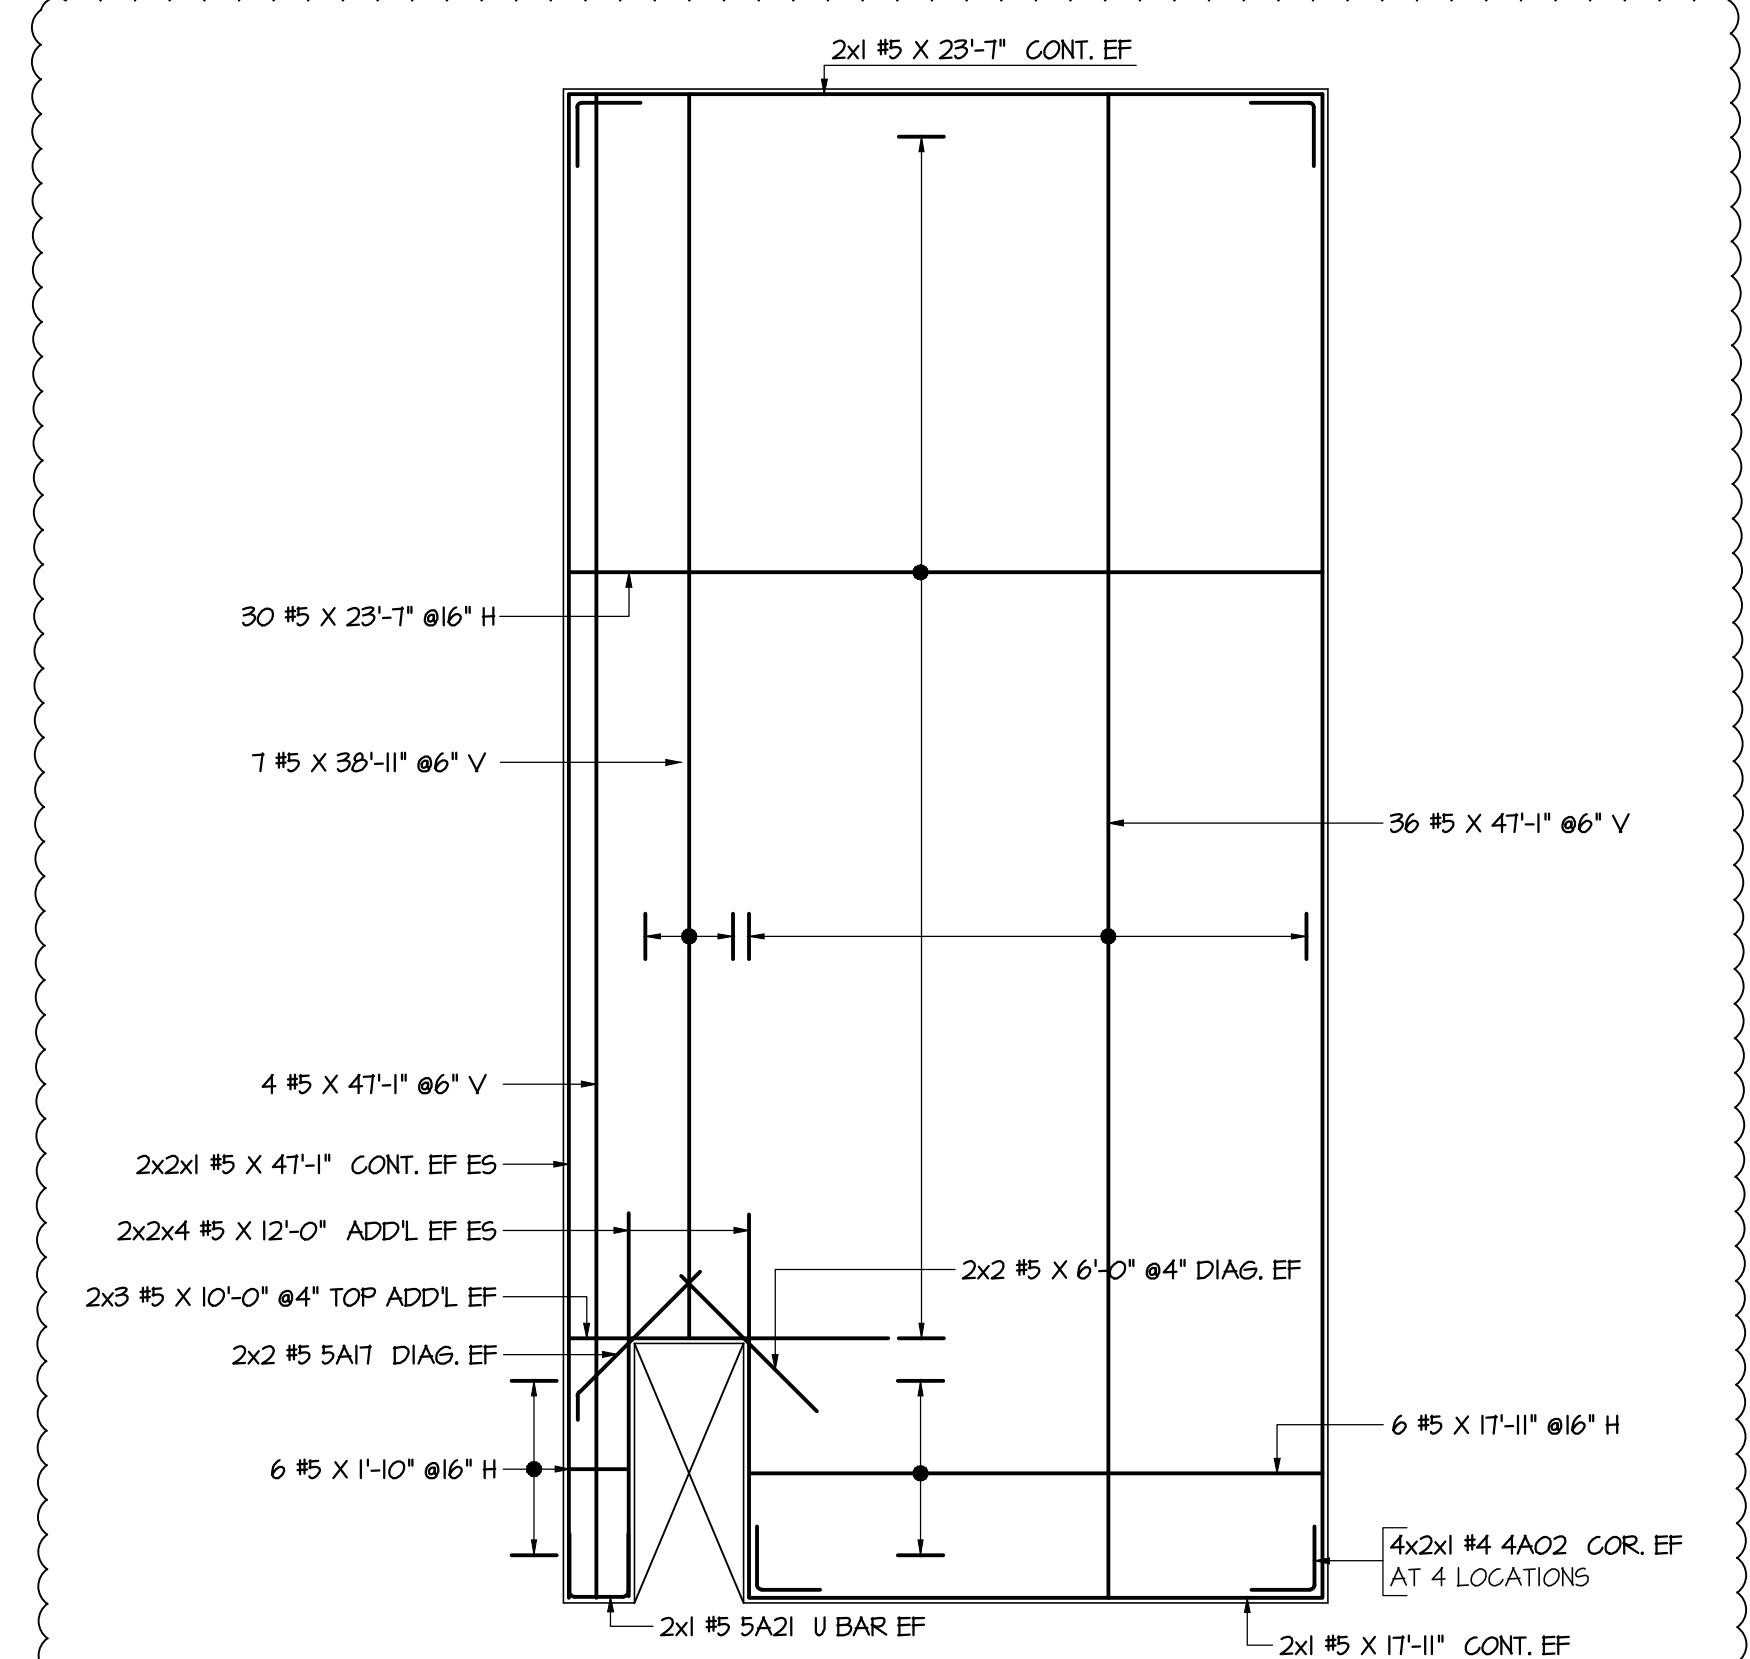



WALL PANEL - E16







REINFORCING STEEL PLACING DRAWING ONLY. USE IN CONJUNCTION WITH CONTRACT DRAWINGS & SPECIFICATIONS. ELEVATIONS & DIMENSIONS SHOWN ON THIS DRAWING ARE FOR DETAILING PURPOSES ONLY AND SHOULD NOT BE USED FOR CONSTRUCTION UNLESS VERIFIED BY ENGINEER OR CONTRACTOR.

STRUCTURAL NOTES	
CLEAR COVER TO REINFORCEMENT	
2"	AT ENDS
1 1/2"	#6 @ BELOW AT EXTERIOR FACE
2"	#6 @ ABOVE AT EXTERIOR FACE
3/4"	AT INTERIOR FACE
T	- TOP
B	- BOTTOM
V. VERT	- VERTICAL
H. HORIZ	- HORIZONTAL
CLR.	- CLEAR COVER
SIM.	- SIMILAR
TYP.	- TYPICAL
T.O.MAT	- TOP OF MAT
EACH SIDE	- EACH SIDE
EF	- EACH FACE
CONT.	- CONTINUOUS
COR.	- CORNER
THK.	- THICKNESS
ADDL.	- ADDITIONAL
DIAG.	- DIAGONAL
NTS	- NOT TO SCALE
G	- CENTER LINE
SDR	- STRUCTURAL DRAWING REFERENCE

BONDING DETAILS											
Drawing Sheet : R-2	Oy	Size	Total Length	Type	'A'	'B'	'C'	'D'	'E'	'F'	'G'
3A03	4	#3	9'-0" X 11'	0'-4"	3'-6"	3'-4"	0'-8" X	0'-4"			
3A11	82	#3	9'-0" X 11'	0'-4"	3'-8"	0'-6" X	3'-8"	0'-6" X	0'-4"		
3A13	83	#3	10'-4" X 11'	0'-4"	4'-3"	0'-7"	4'-3"	0'-7"	0'-4"		
3A20	100	#3	5'-5" X 11'	1'-7" X	0'-8" X	1'-7" X	0'-8" X	0'-4" X			
3A26	100	#3	5'-5" X 11'	1'-7" X	0'-8" X	1'-7" X	0'-8" X	0'-4" X			
4A02	52	#4	4'-0" X 17'	0'-4" X	3'-2"	2'-0"	2'-0"				
5A06	8	#5	5'-11" X 14'	0'-10"	3'-3" X	1'-10"		2'-3" X	2'-3" X	4'-1" X	
5A17	20	#5	6'-2" X 3'	0'-10"	5'-4" X	0'-10"		3'-10" X	3'-9" X	4'-7" X	
5A21	6	#5	5'-10" X 17'	0'-10" X	2'-0"	1'-10" X	2'-0"				

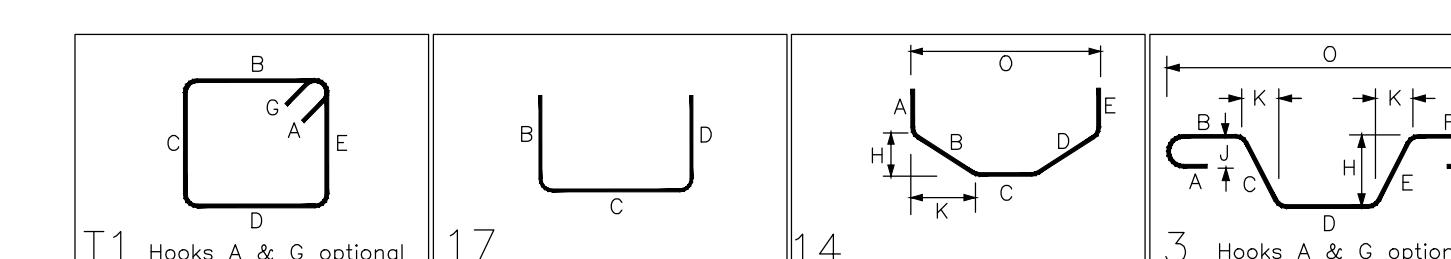

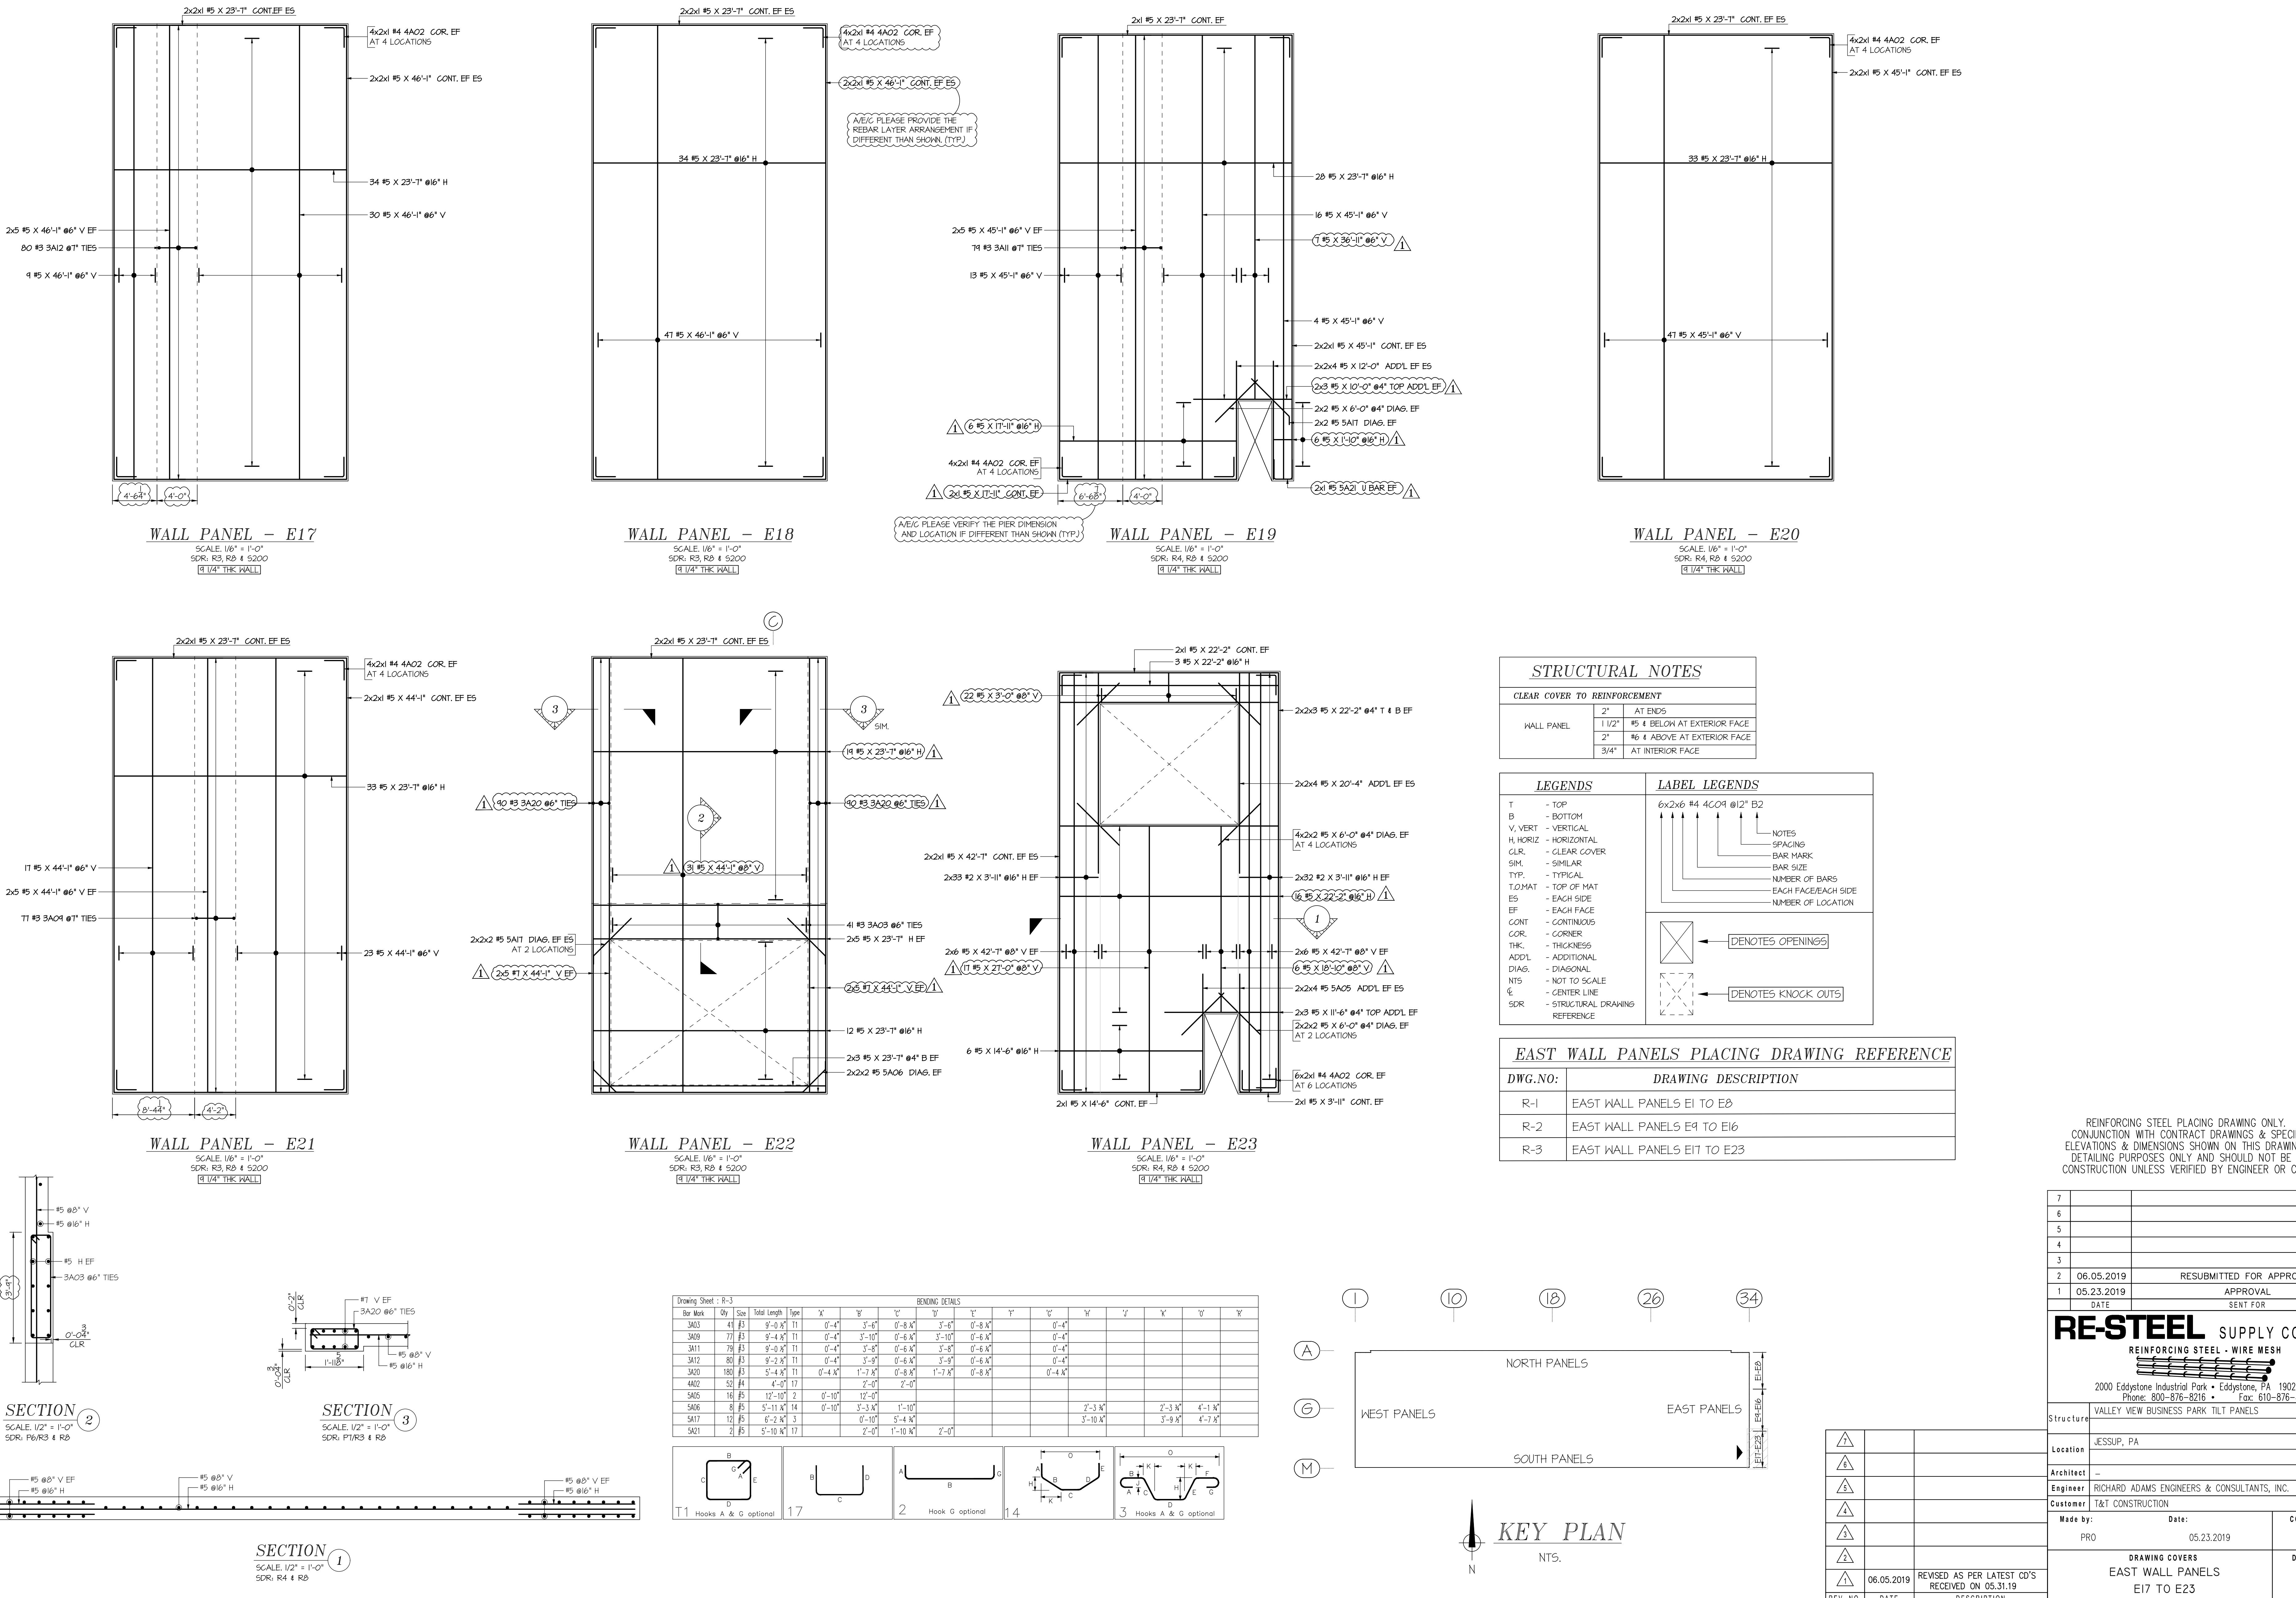

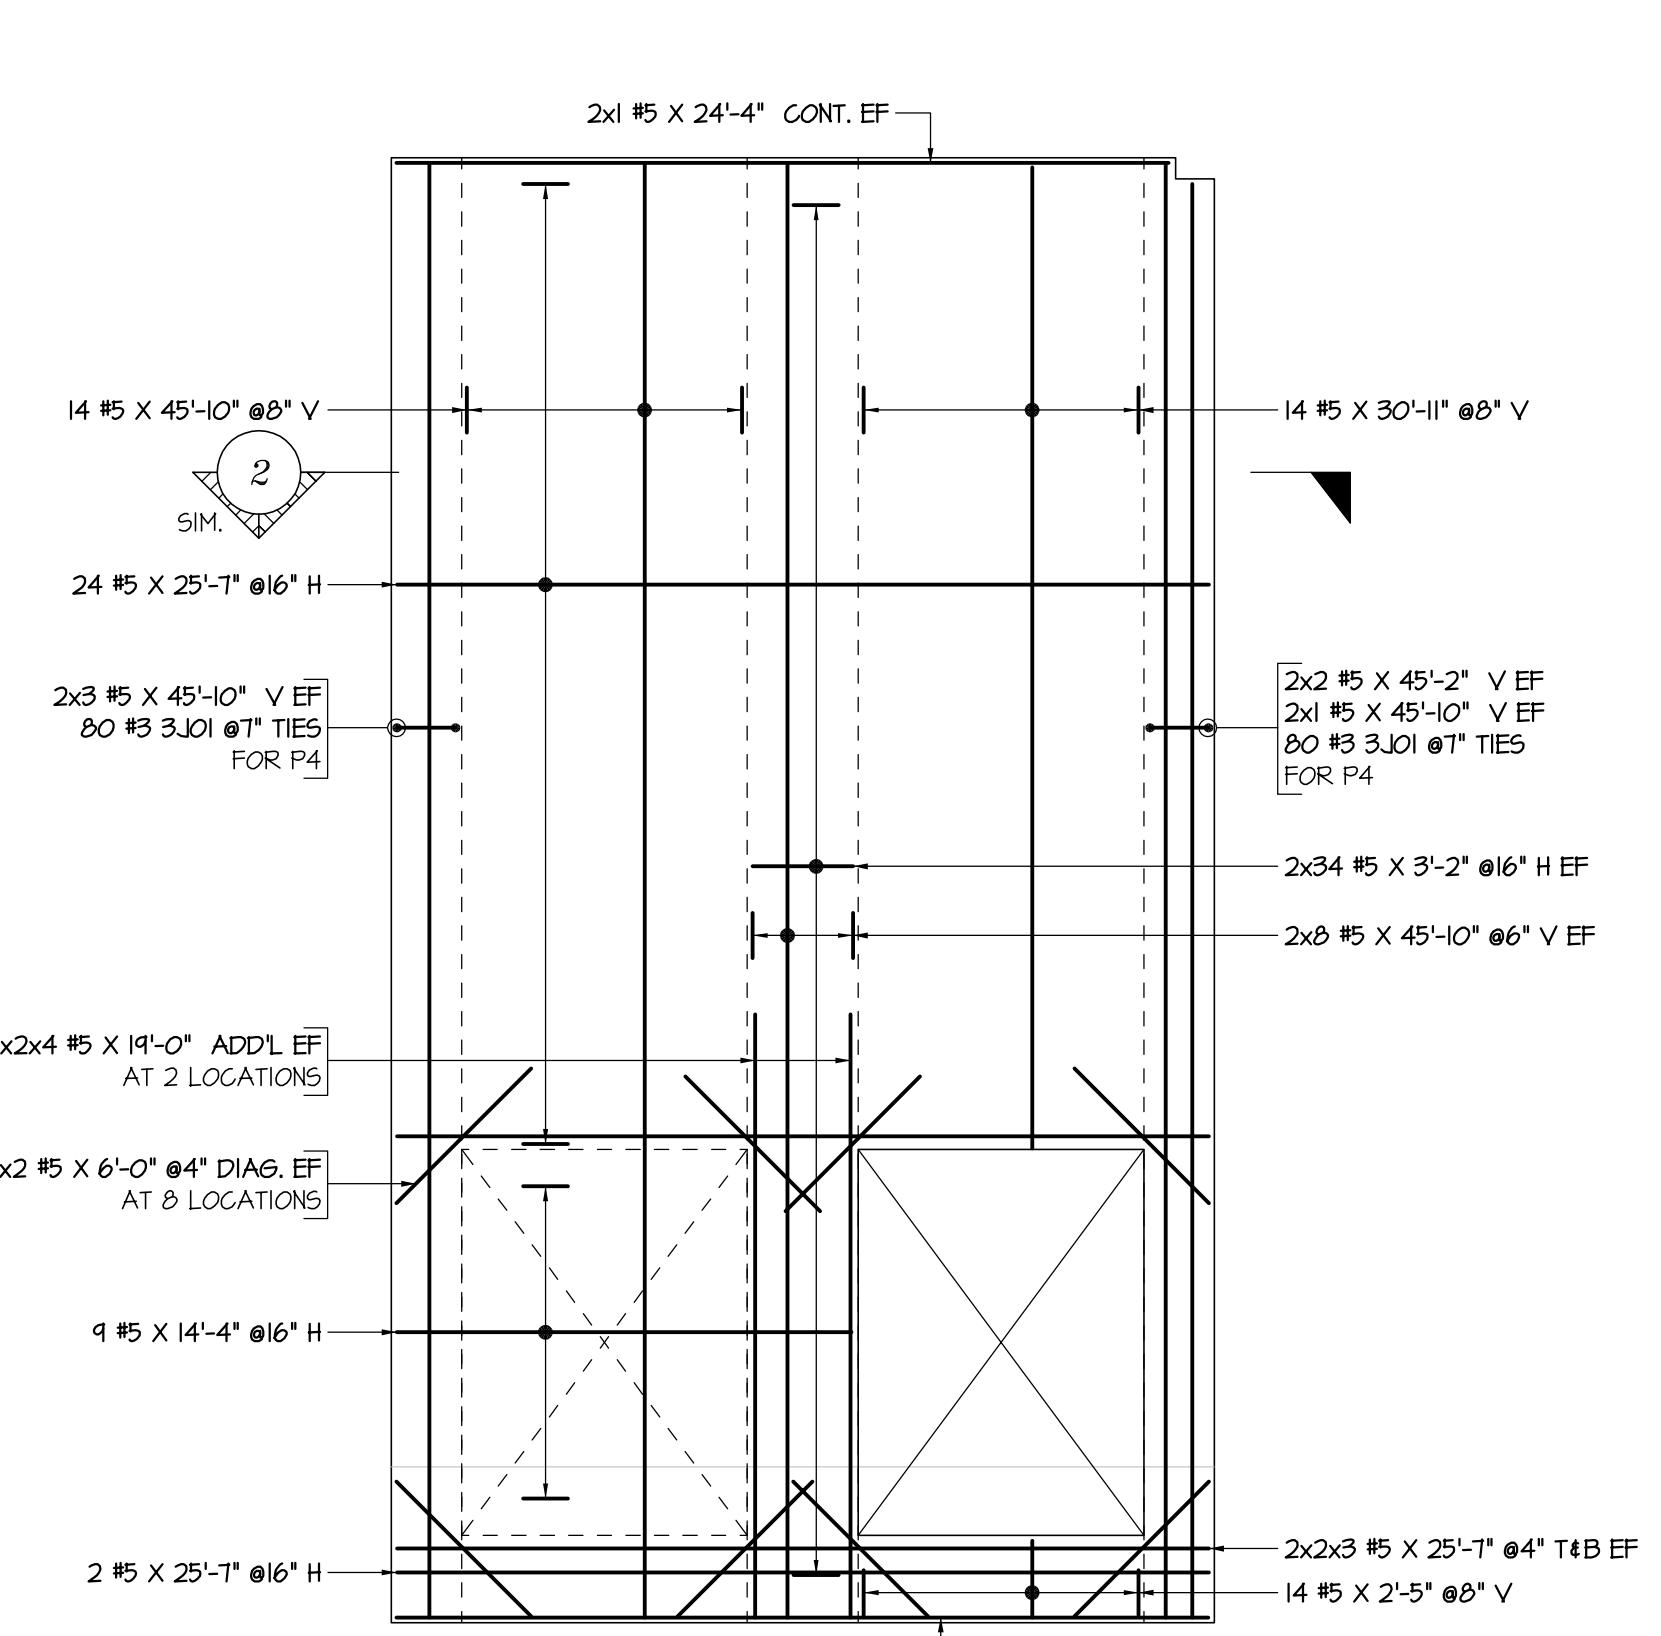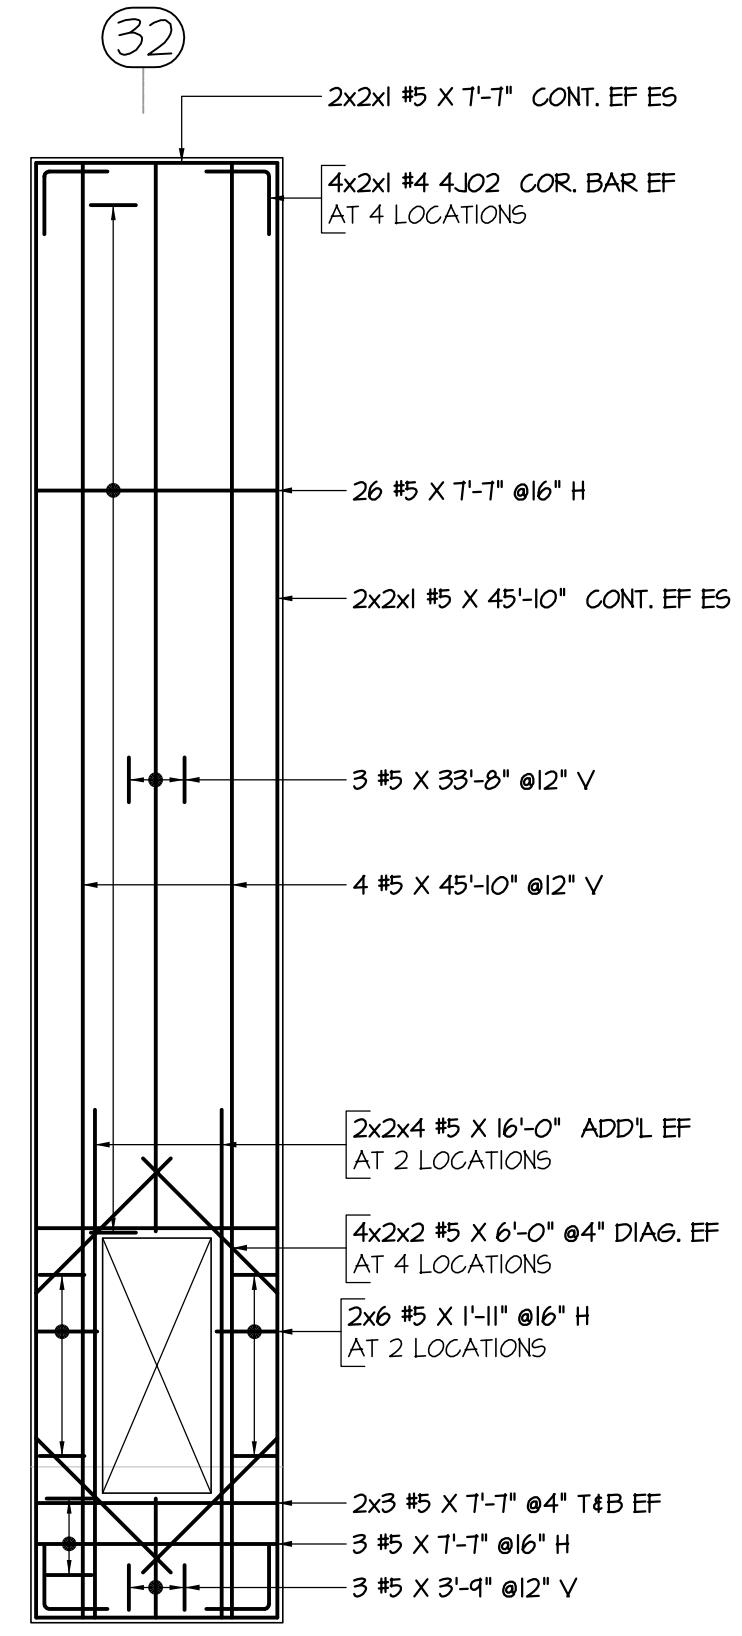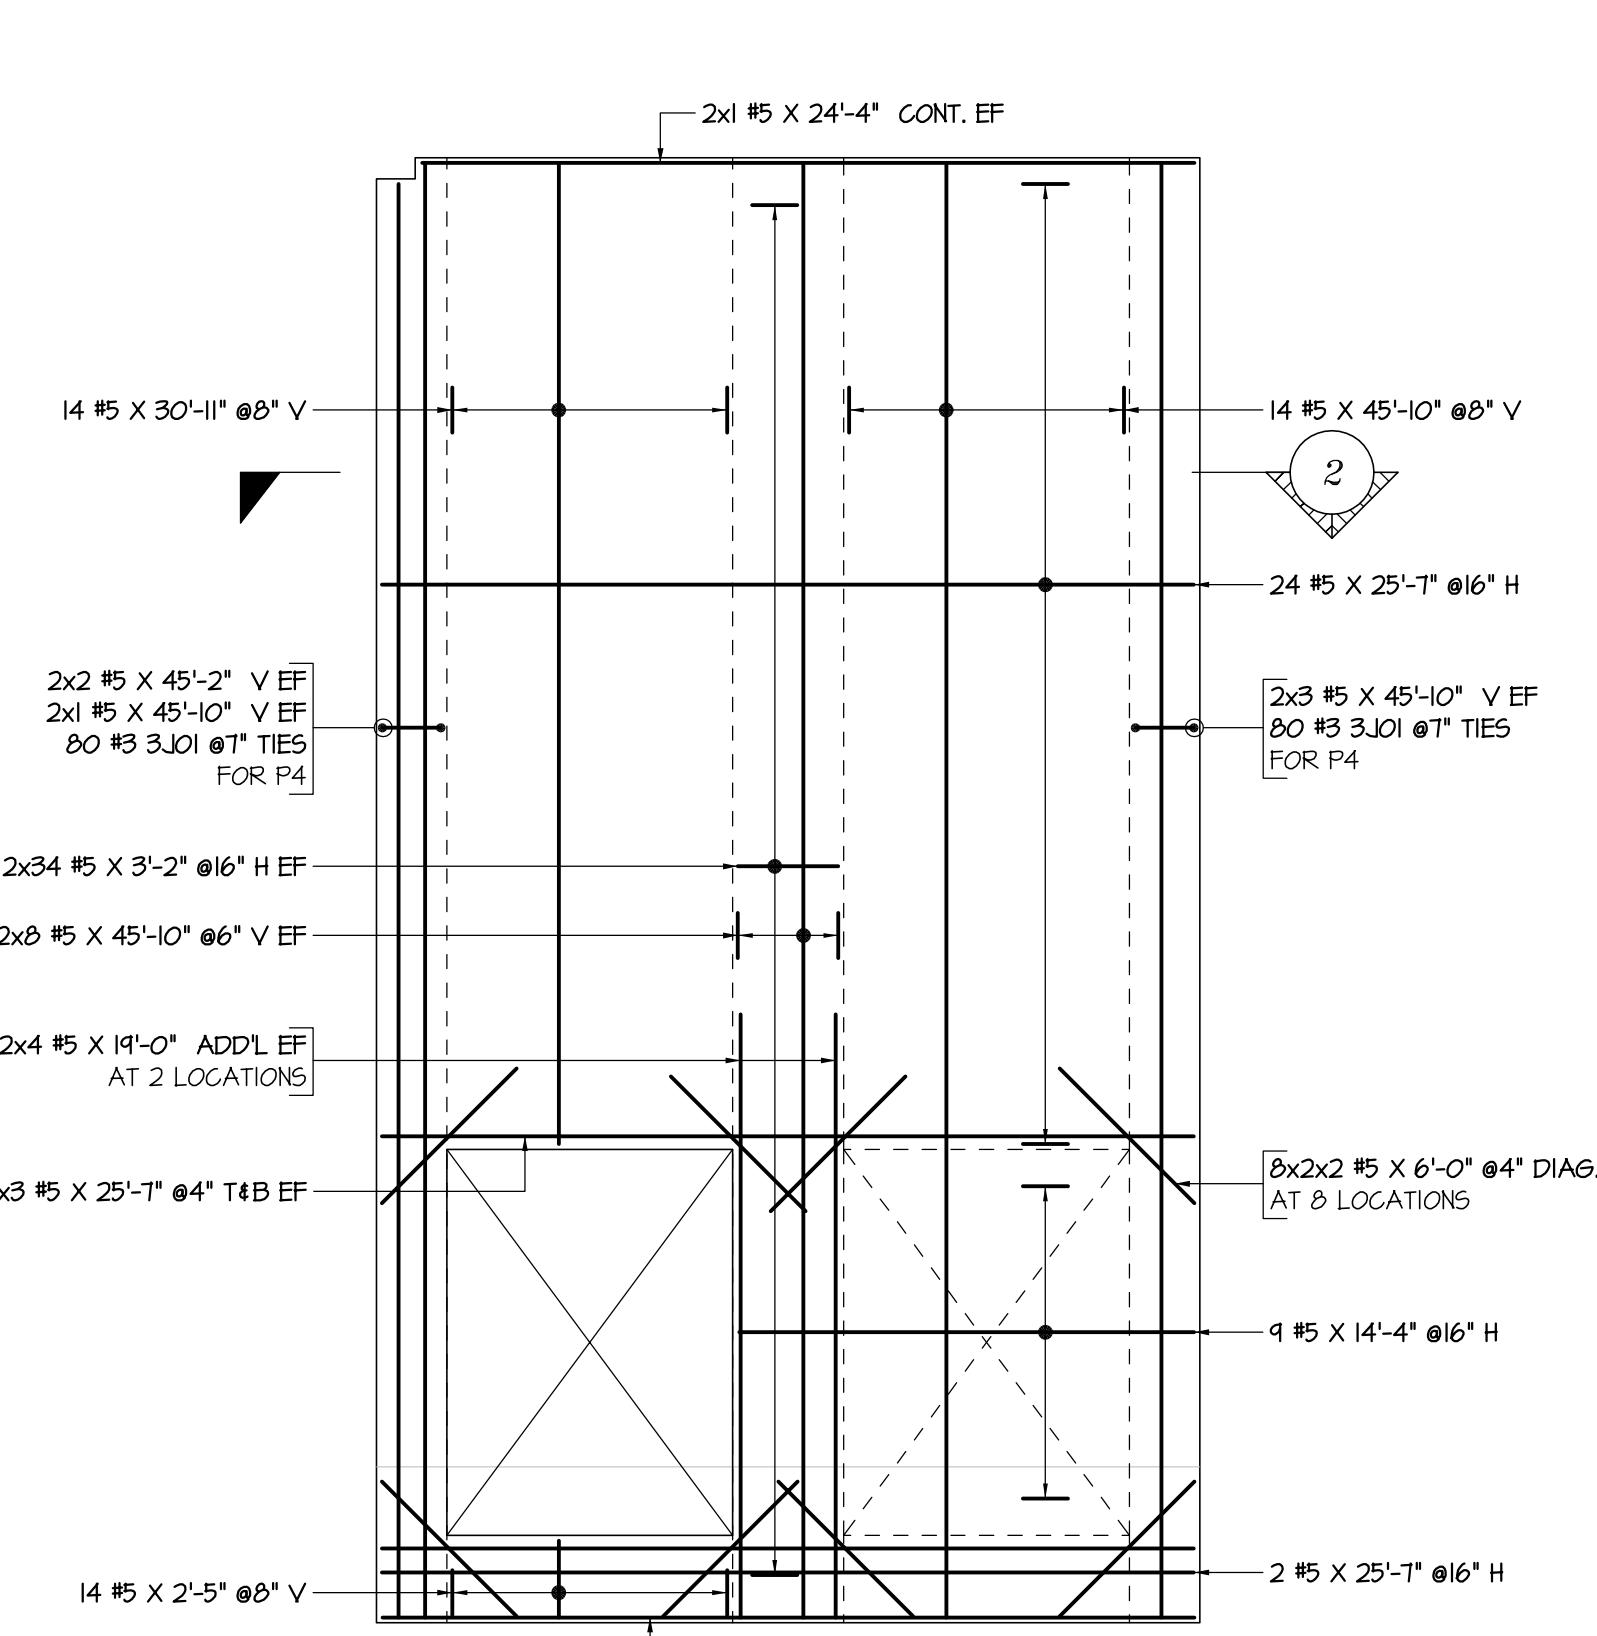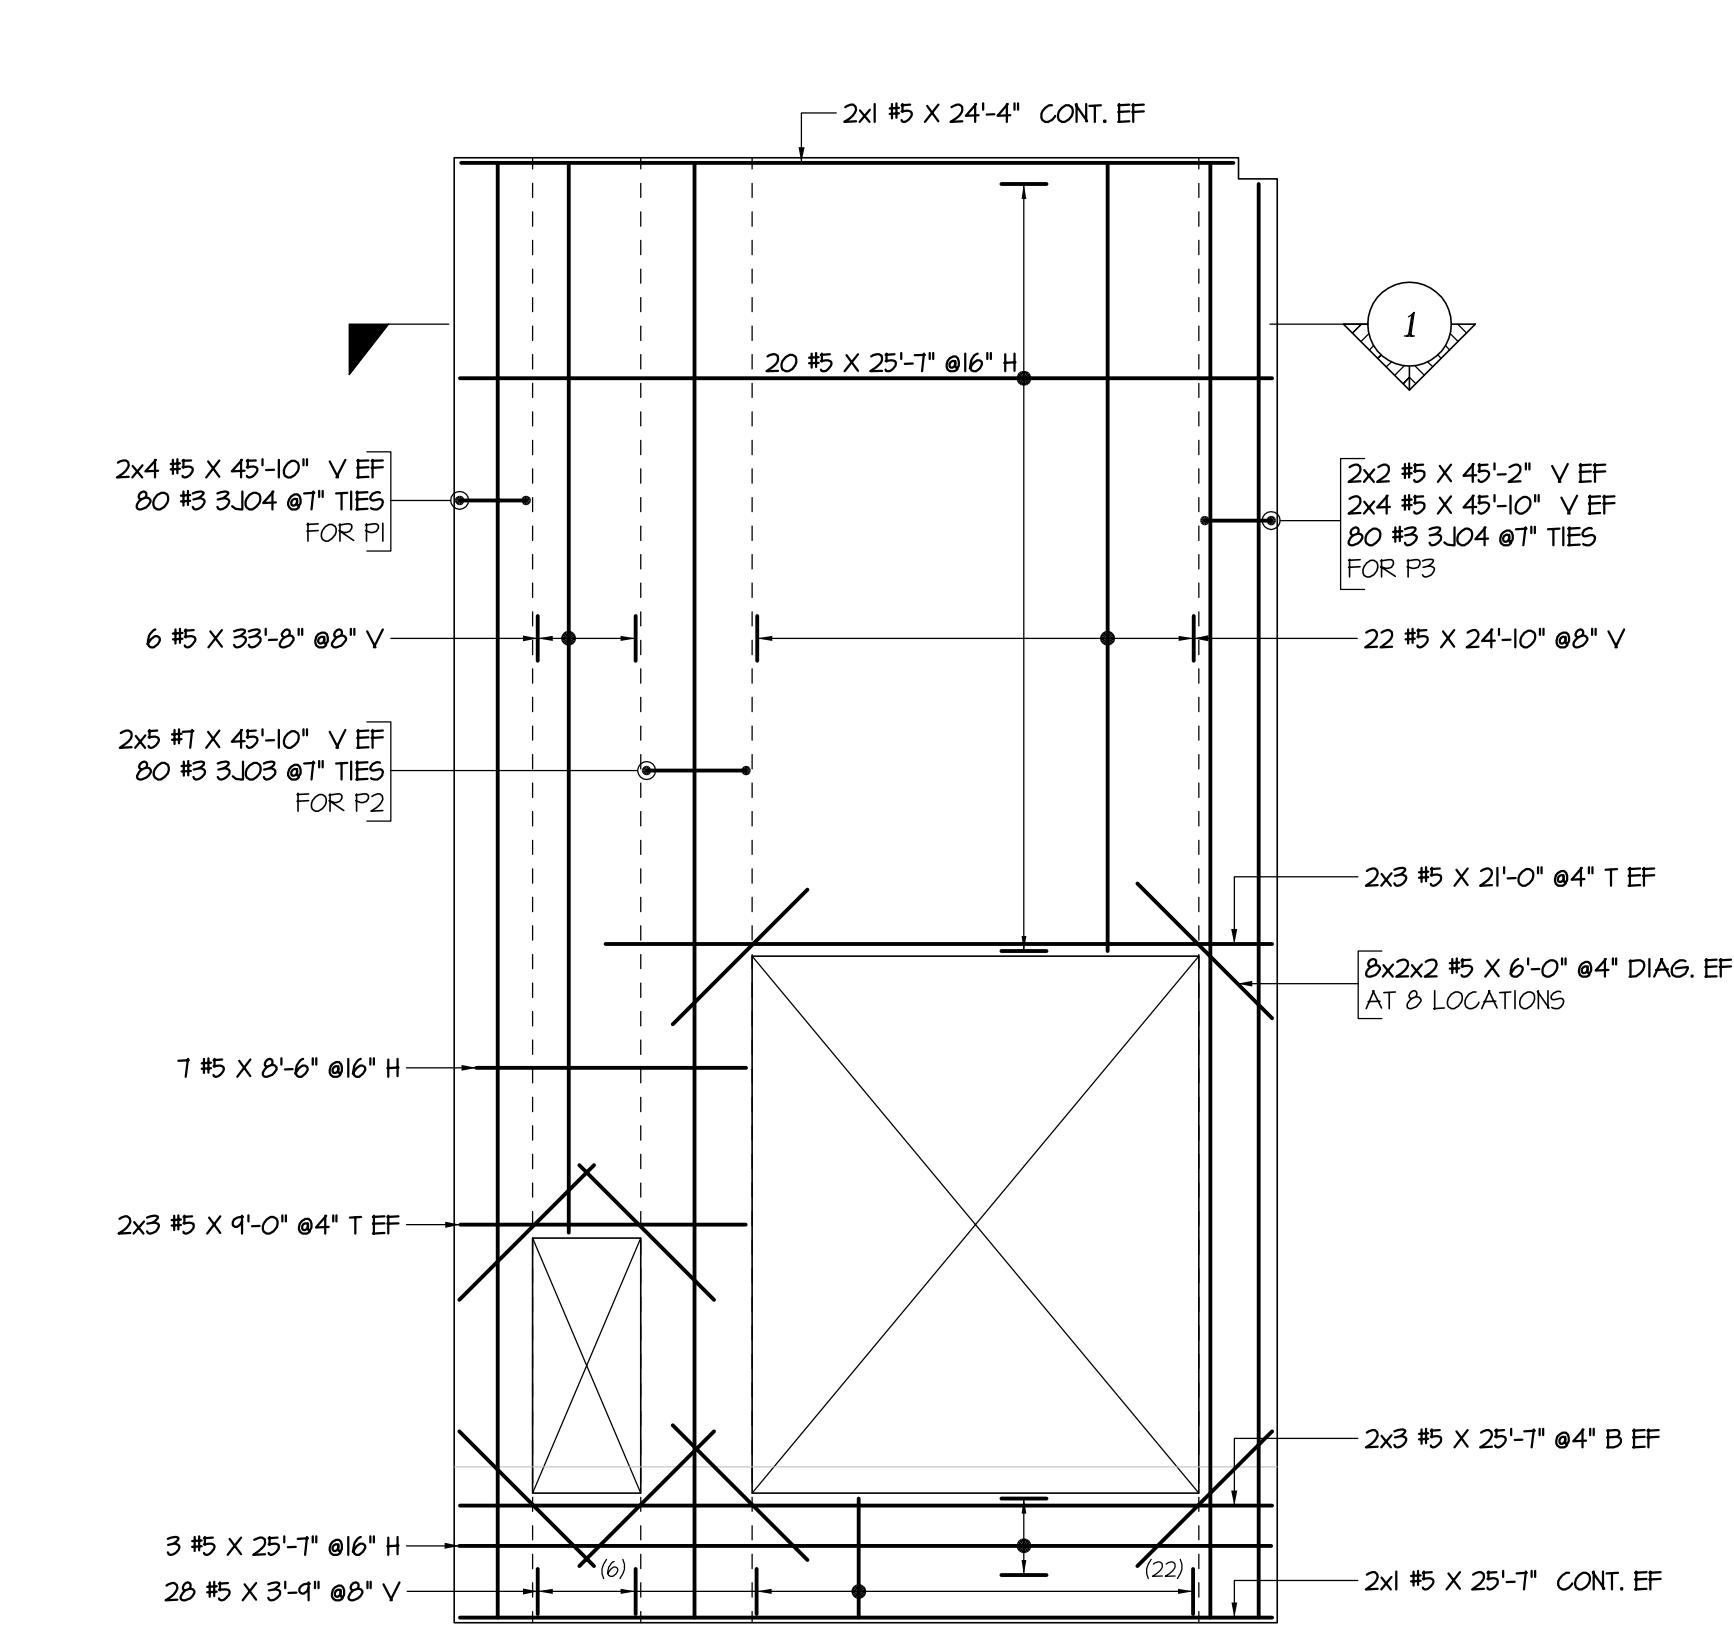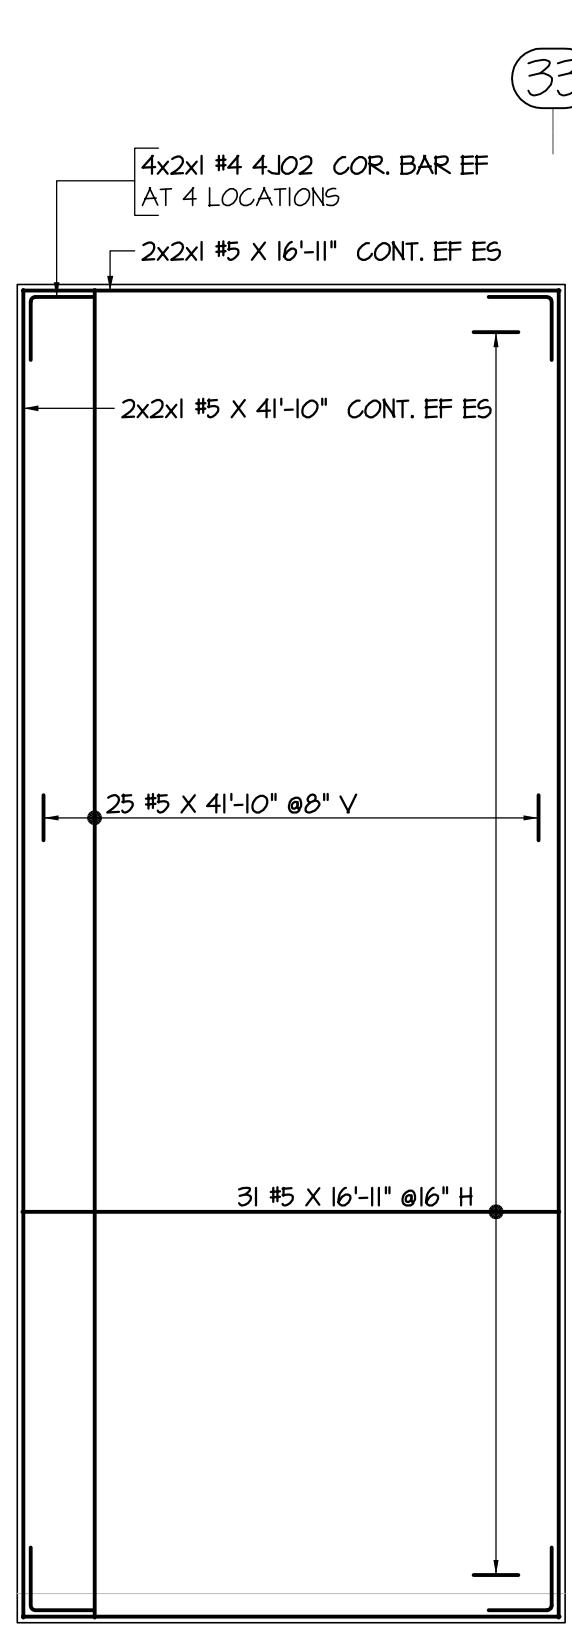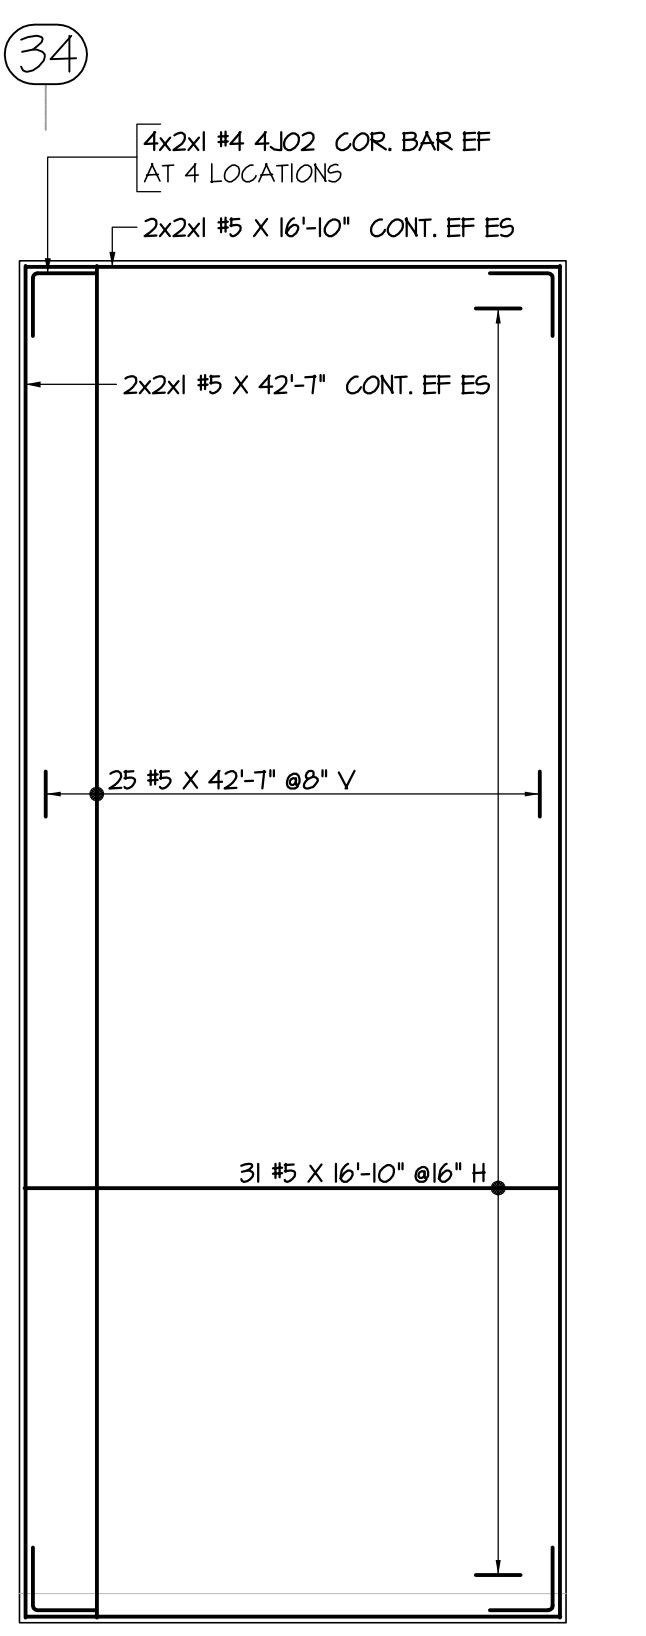

WALL PANEL - S1

SCALE: 1/8" = 1'-0"

SDR: R4, R8 & 5200

[1/4" THK WALL]

WALL PANEL - S2

SCALE: 1/8" = 1'-0"

SDR: R4, R8 & 5200

[1/4" THK WALL]

WALL PANEL - S3

SCALE: 1/8" = 1'-0"

SDR: R4, R8 & 5200

[1/4" THK WALL]

WALL PANEL - S4

SCALE: 1/8" = 1'-0"

SDR: R4, R8 & 5200

[1/4" THK WALL]

WALL PANEL - S5

SCALE: 1/8" = 1'-0"

SDR: R4, R8 & 5200


[1/4" THK WALL]

WALL PANEL - S6

SCALE: 1/8" = 1'-0"

SDR: R4, R8 & 5200

[1/4" THK WALL]

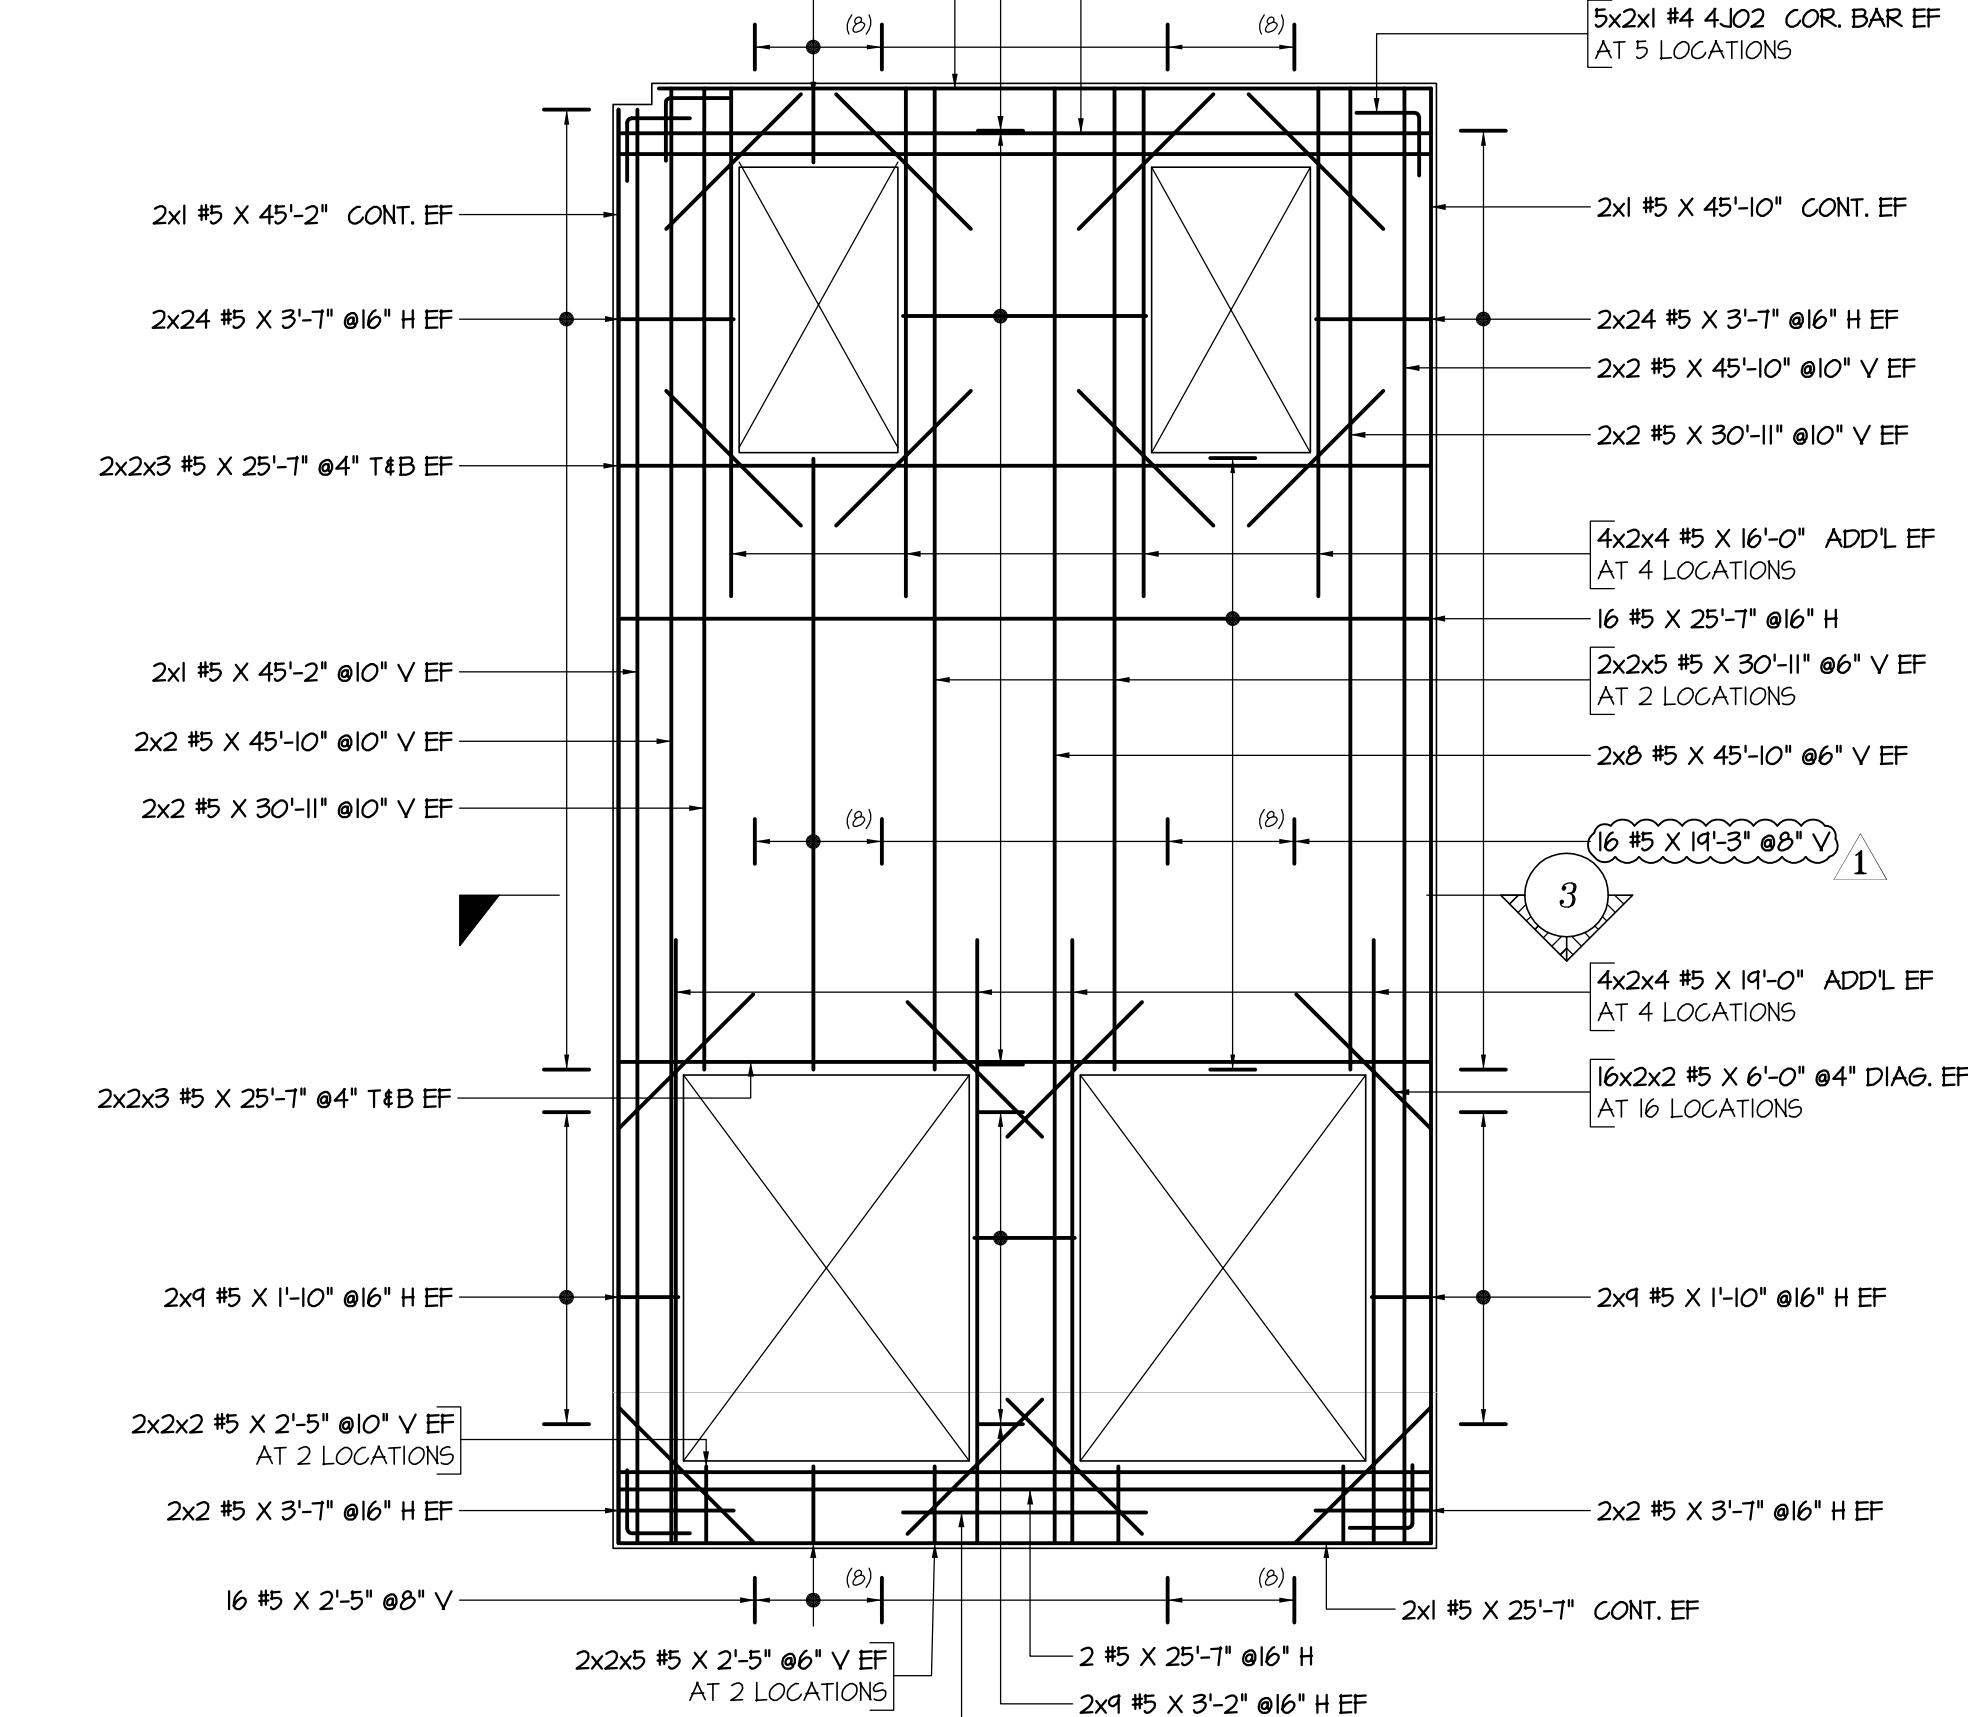


WALL PANEL - S7

SCALE: 1/8" = 1'-0"

SDR: R4, R8 & 5200

[1/4" THK WALL]



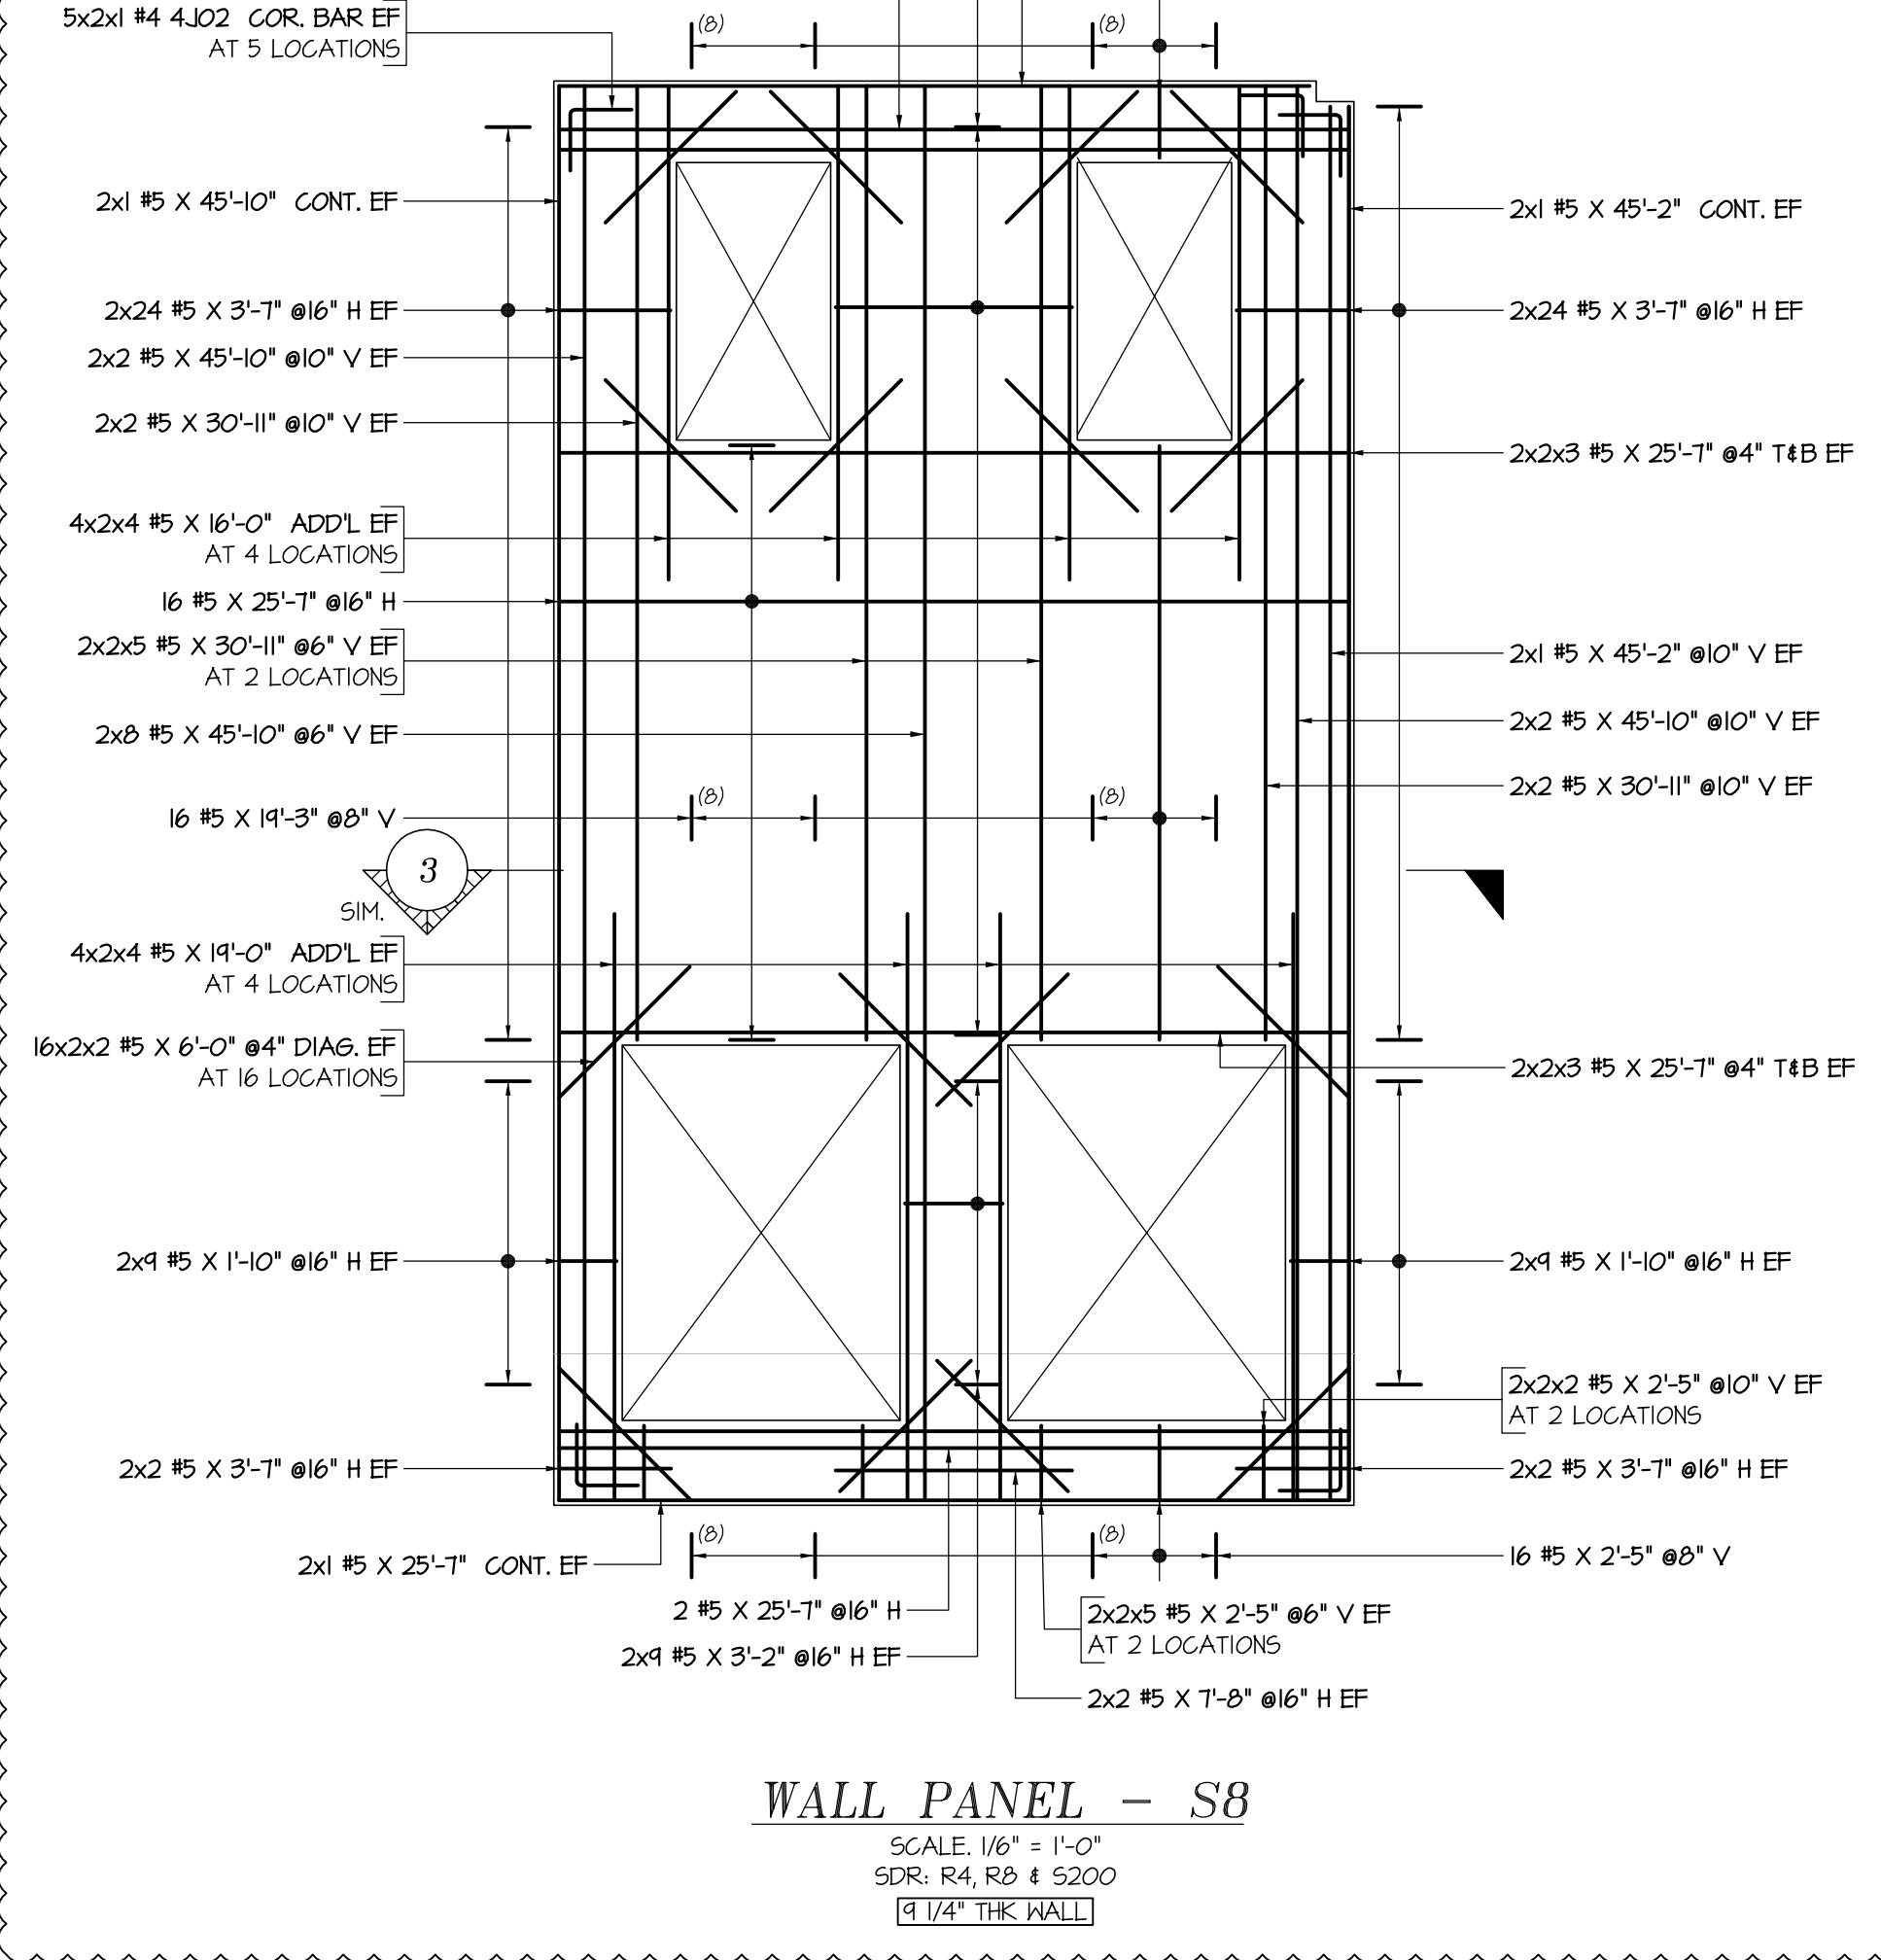


WALL PANEL - S8

SCALE: 1/8" = 1'-0"


SDR: R4, R8 & 5200

[1/4" THK WALL]

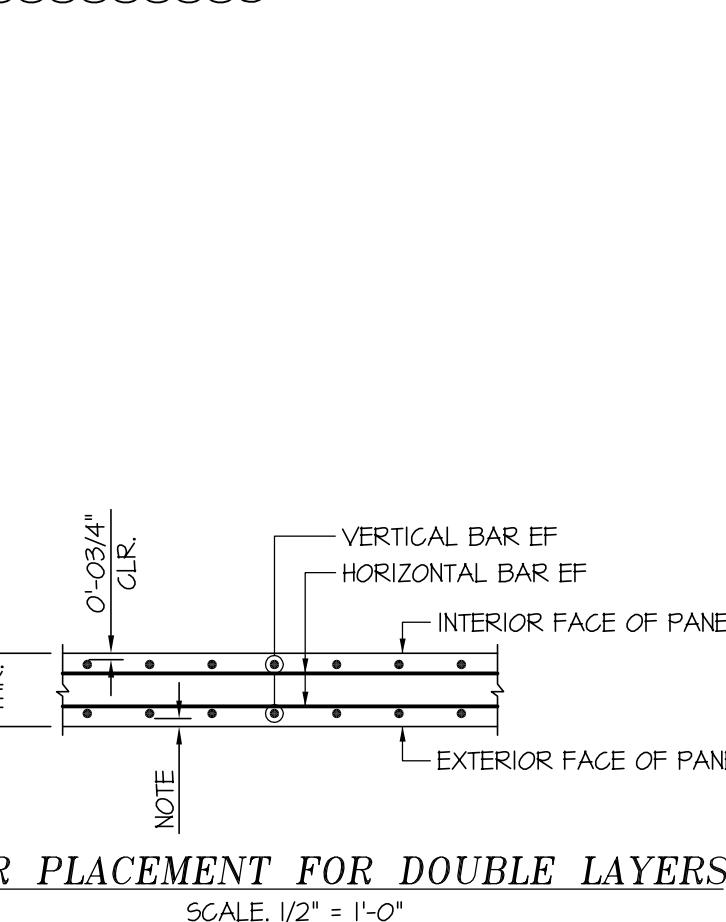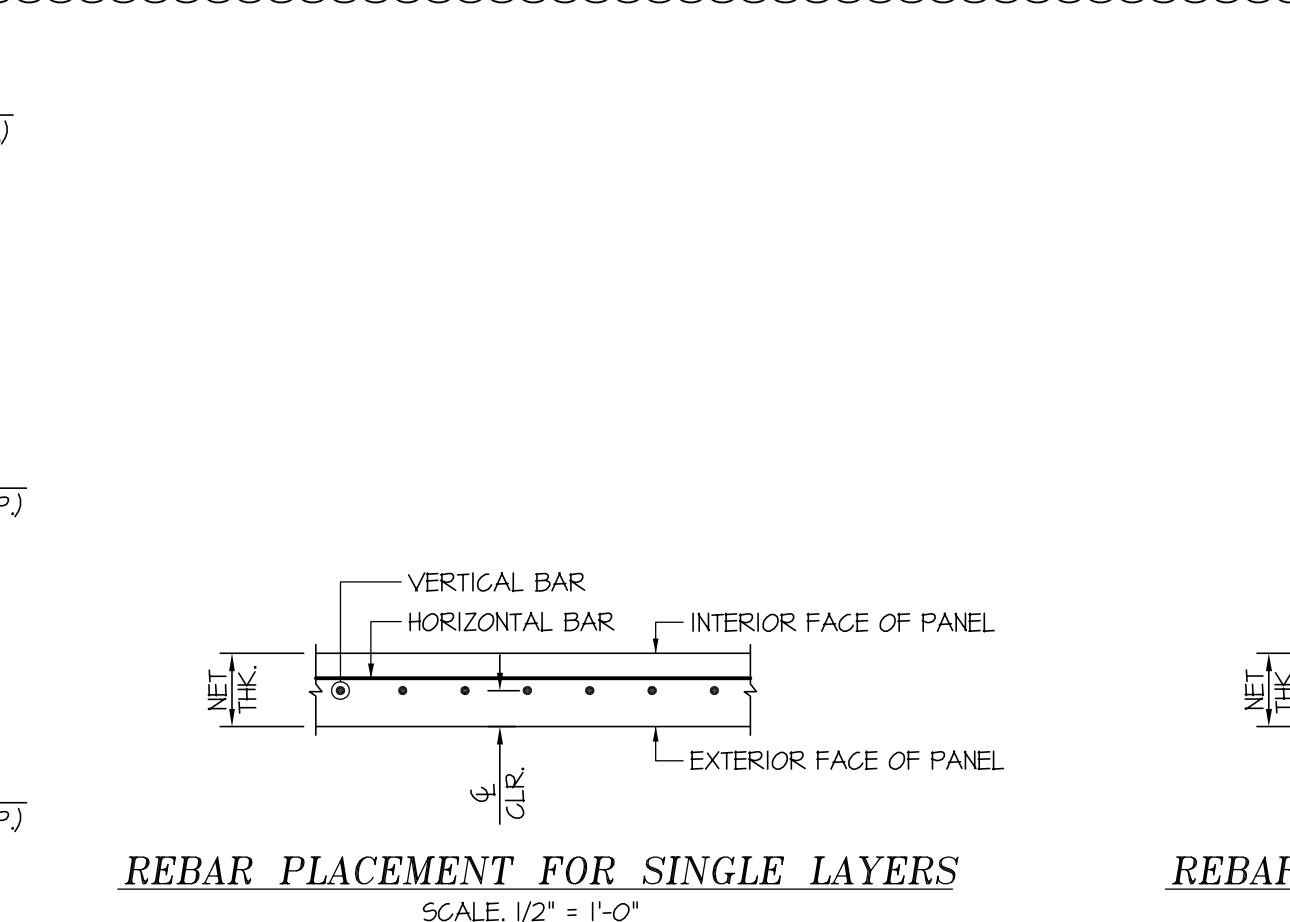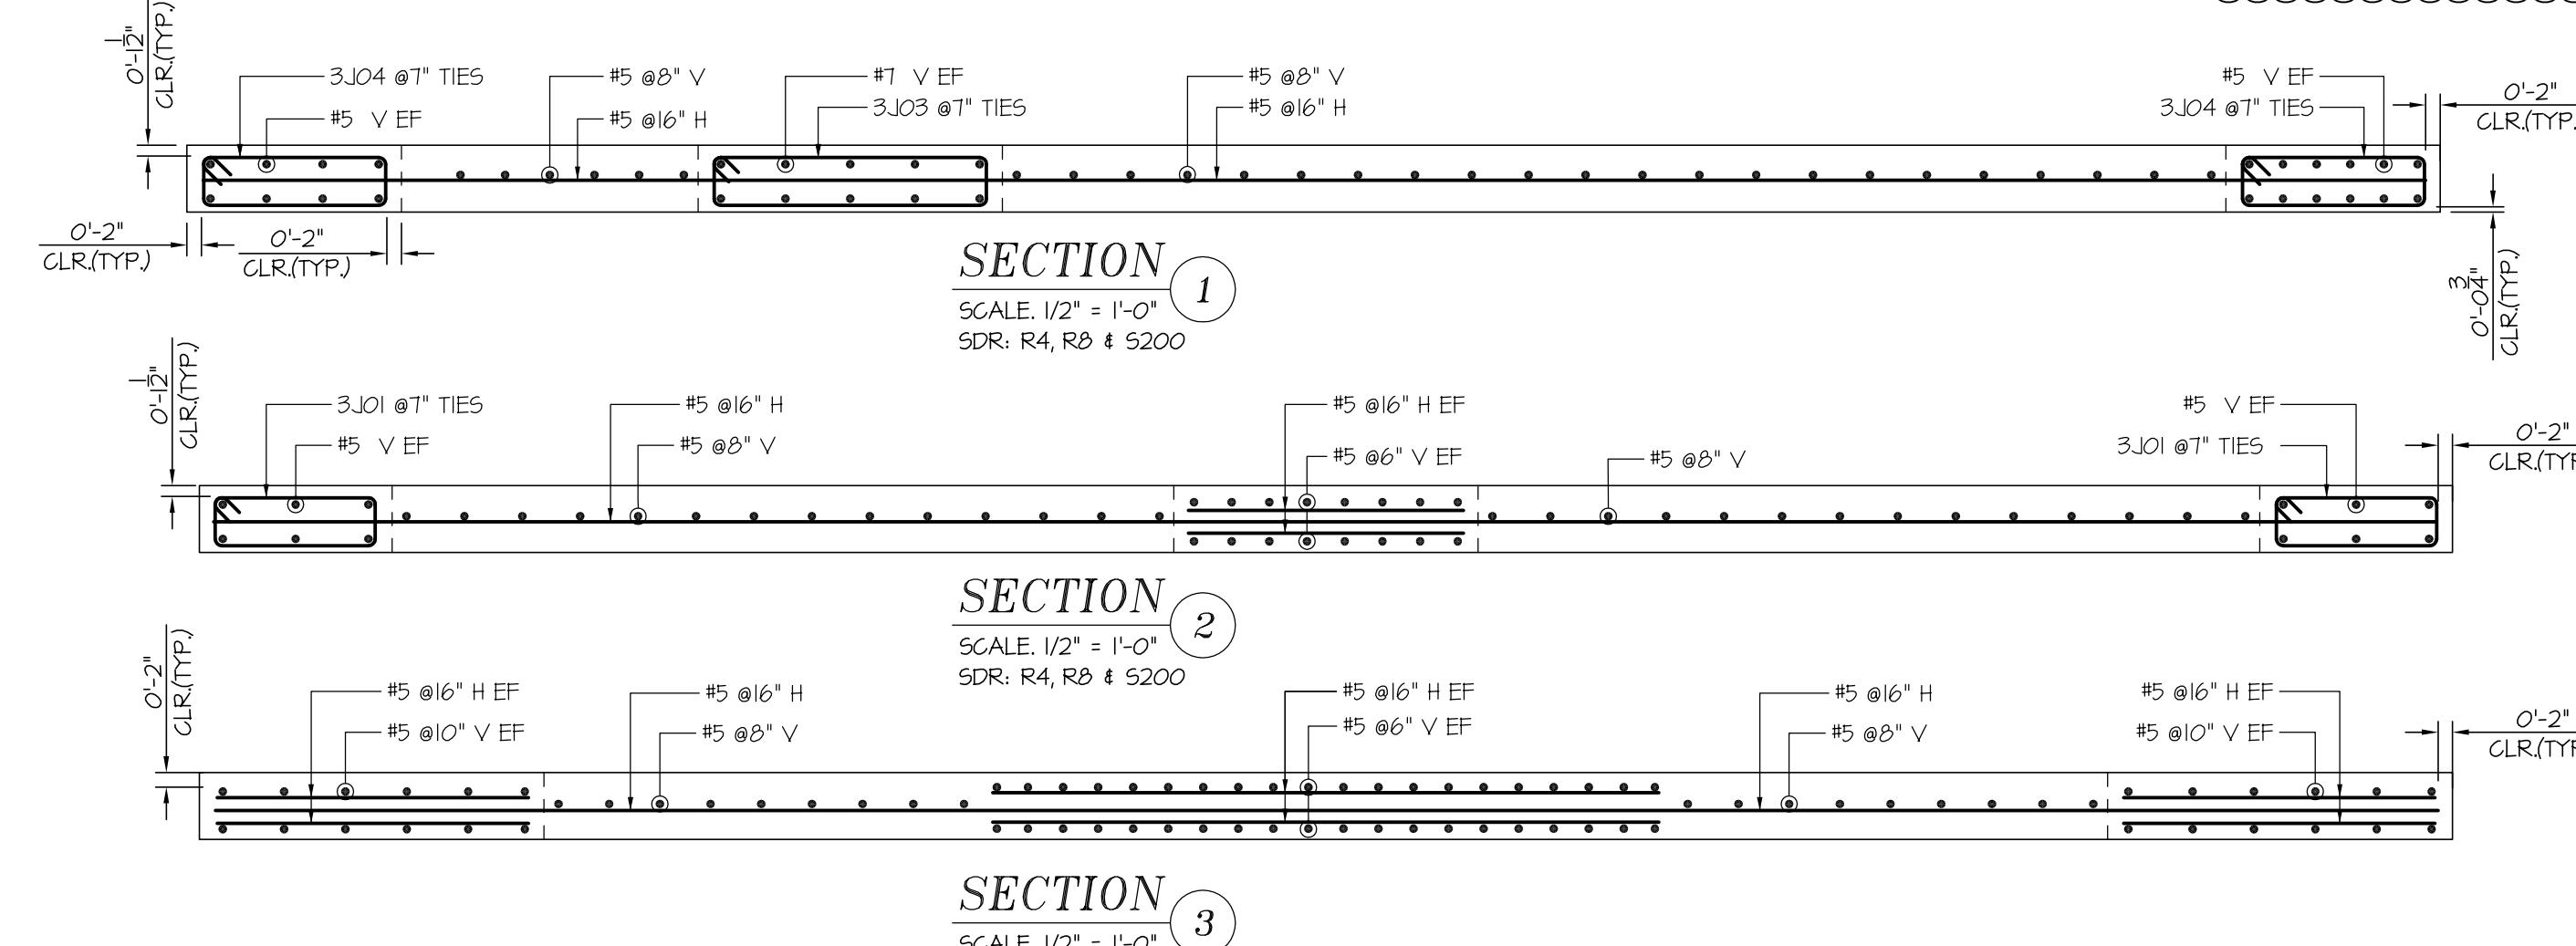

STRUCTURAL NOTES	
LEGENDS	LABEL LEGENDS
T - TOP B - BOTTOM V, VERT - VERTICAL H, HORIZONTAL CLR - CLEAR COVER SIM - SIMILAR TYP - TYPICAL TOP/MAT - TOP OF MAT ES - EACH SIDE EF - EACH FACE CONT - CONTINUOUS COR - CORNER THK - THICKNESS ADDL - ADDITIONAL DIAG - DIAGONAL NTS - NOT TO SCALE C - CENTER LINE SDR - STRUCTURAL DRAWING REFERENCE	6x2x6 #4 4C04 @12' B2 NOTES SPACING BAR MARK BAR SIZ NUMBER OF BARS EACH FACE/EACH SIDE NUMBER OF LOCATION DENOTES OPENINGS DENOTES KNOCK OUTS CLEAR COVER TO REINFORCEMENT WALL PANEL 2" AT ENDS 1 1/2" #6 4 BELOW AT EXTERIOR FACE 2" #6 4 ABOVE AT EXTERIOR FACE 3/4" AT INTERIOR FACE
DWG.NO:	DRAWING DESCRIPTION
R-18	SOUTH WALL PANELS S-1 TO S-8
R-19	SOUTH WALL PANELS S-9 TO S-15
R-20	SOUTH WALL PANELS S-16 TO S-22
R-21	SOUTH WALL PANELS N-23 TO N-30
R-22	SOUTH WALL PANELS N-31 TO N-37
R-23	SOUTH WALL PANELS N-38 TO N-44
R-24	SOUTH WALL PANELS N-45 TO N-51
R-25	SOUTH WALL PANELS N-52 TO N-58
R-26	SOUTH WALL PANELS N-59 TO N-66
R-27	SOUTH WALL PANELS N-67 TO N-73
R-28	SOUTH WALL PANELS N-74 TO N-80


Drawing Sheet : R-18									
BENDING DETAILS									
Bar Mark	Qty	Size	Total Length	Type	'A'	'B'	'C'	'D'	'E'
301	320	#3	5'-7 1/2"	11	0'-4 1/2"	1'-10 1/2"	0'-7"	1'-10 1/2"	0'-7"
303	80	#3	8'-2 1/2"	11	0'-4 1/2"	3'-2"	0'-7"	3'-2"	0'-7"
304	160	#3	6'-1 1/2"	11	0'-4 1/2"	2'-1 1/2"	0'-7"	2'-1 1/2"	0'-7"
	44	#4	4'-0"	17		2'-0"		2'-0"	

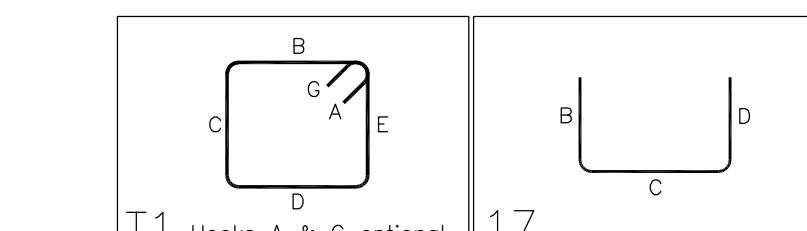

REINFORCING STEEL PLACING DRAWING ONLY. USE IN CONJUNCTION WITH CONTRACT DRAWINGS & SPECIFICATIONS. ELEVATIONS & DIMENSIONS SHOWN ON THIS DRAWING ARE FOR DETAILING PURPOSES ONLY AND SHOULD NOT BE USED FOR CONSTRUCTION UNLESS VERIFIED BY ENGINEER OR CONTRACTOR.


7	6
5	4
3	2
1	06.14.2019
2	05.29.2019
1	05.29.2019
	RE SUBMITTED FOR APPROVAL
	APPROVAL
	DATE
	SENT FOR

RE-STEEL SUPPLY CO., INC.
REINFORCING STEEL - WIRE MESH
2000 Eddystone Industrial Park • Eddystone, PA 19022-1588
Phone: 800-876-8216 • Fax: 610-876-8428
Structure: VALLEY VIEW BUSINESS PARK TILT PANELS
Location: JESSUP, PA
Architect: KSS ARCHITECTS
Engineer: RICHARD ADAMS
Customer: T&T CONSTRUCTION
Made by: PRO Date: 05.29.2019
DRAWING COVERS: SOUTH WALL PANELS S-1 TO S-8
REV. NO. DATE DESCRIPTION
DRAWING NO. R-18

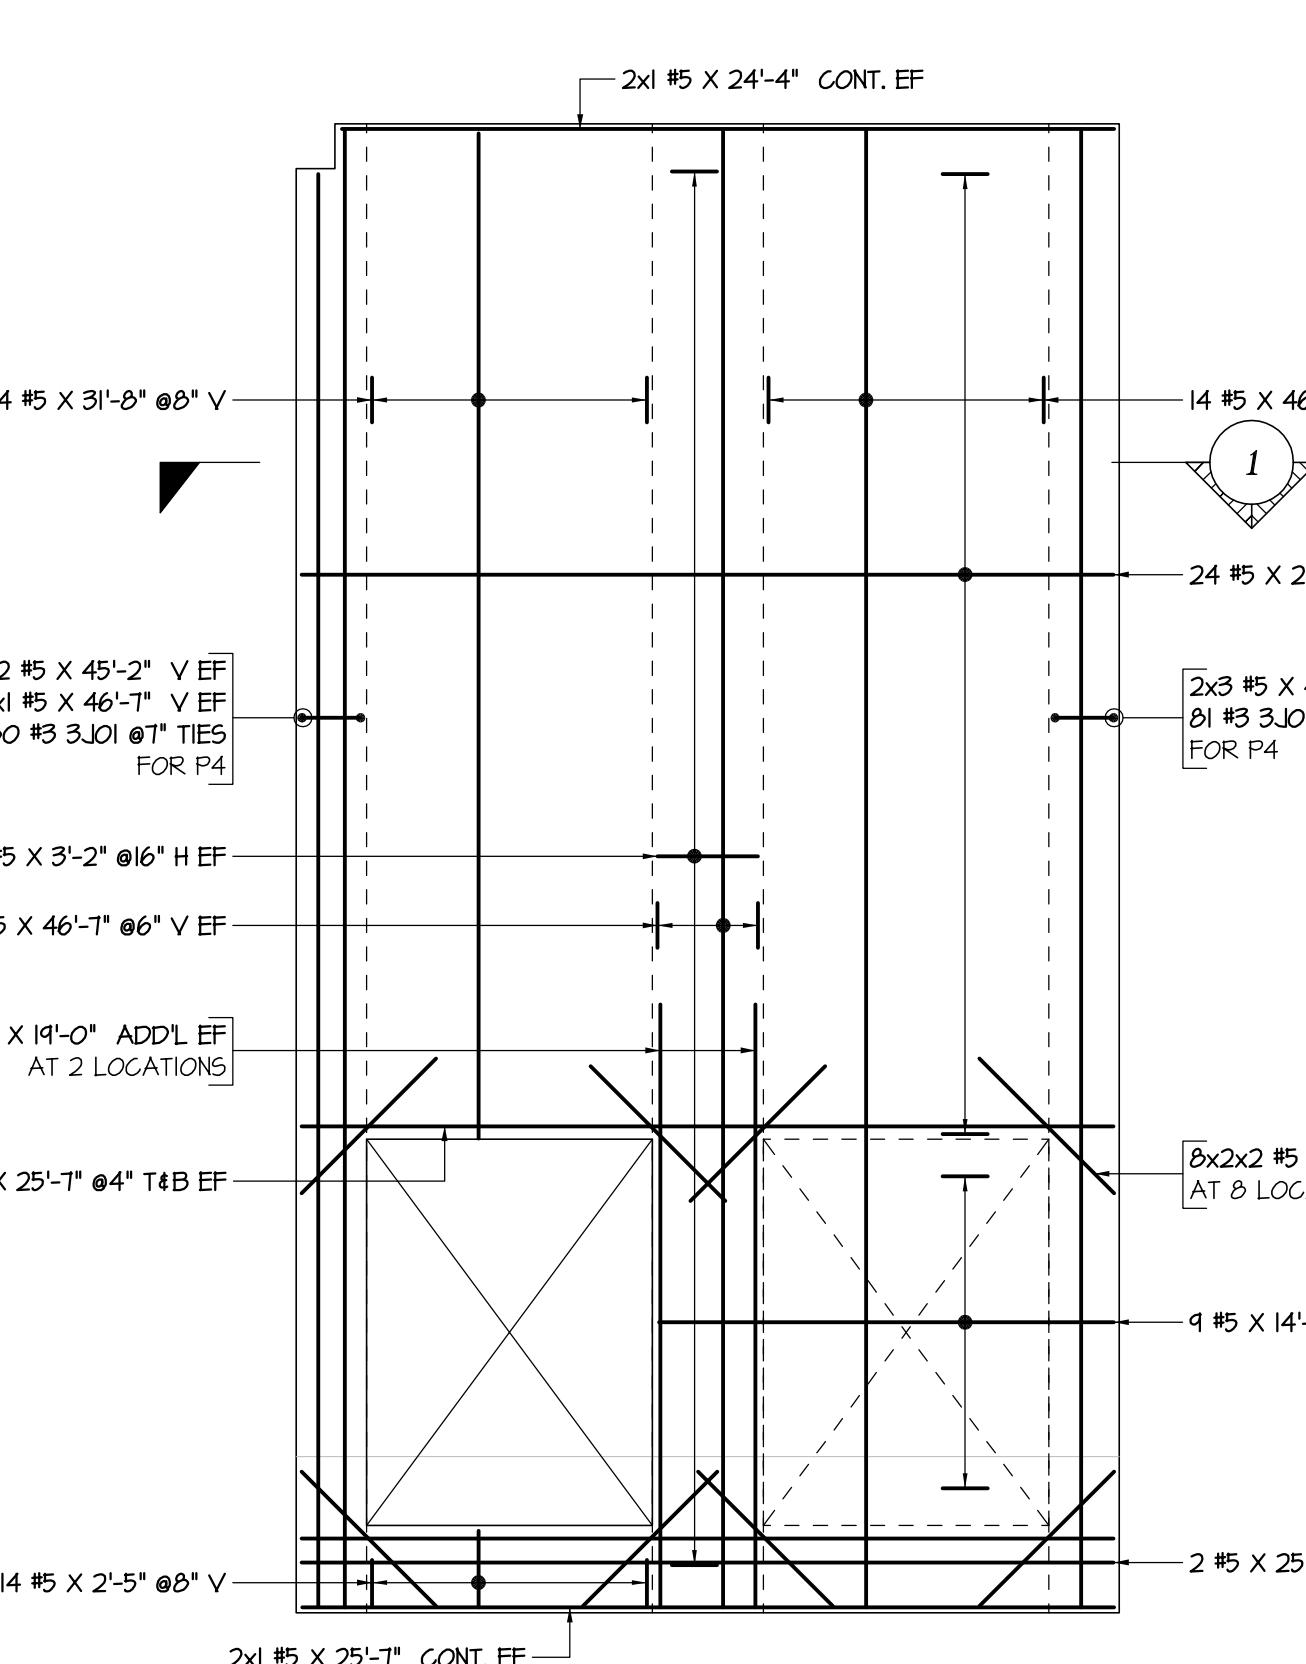


WALL PANEL - S9

SCALE: 1/8" = 1'-0"
SDR: R4, R8 & 5200
(4 1/4" THK WALL)

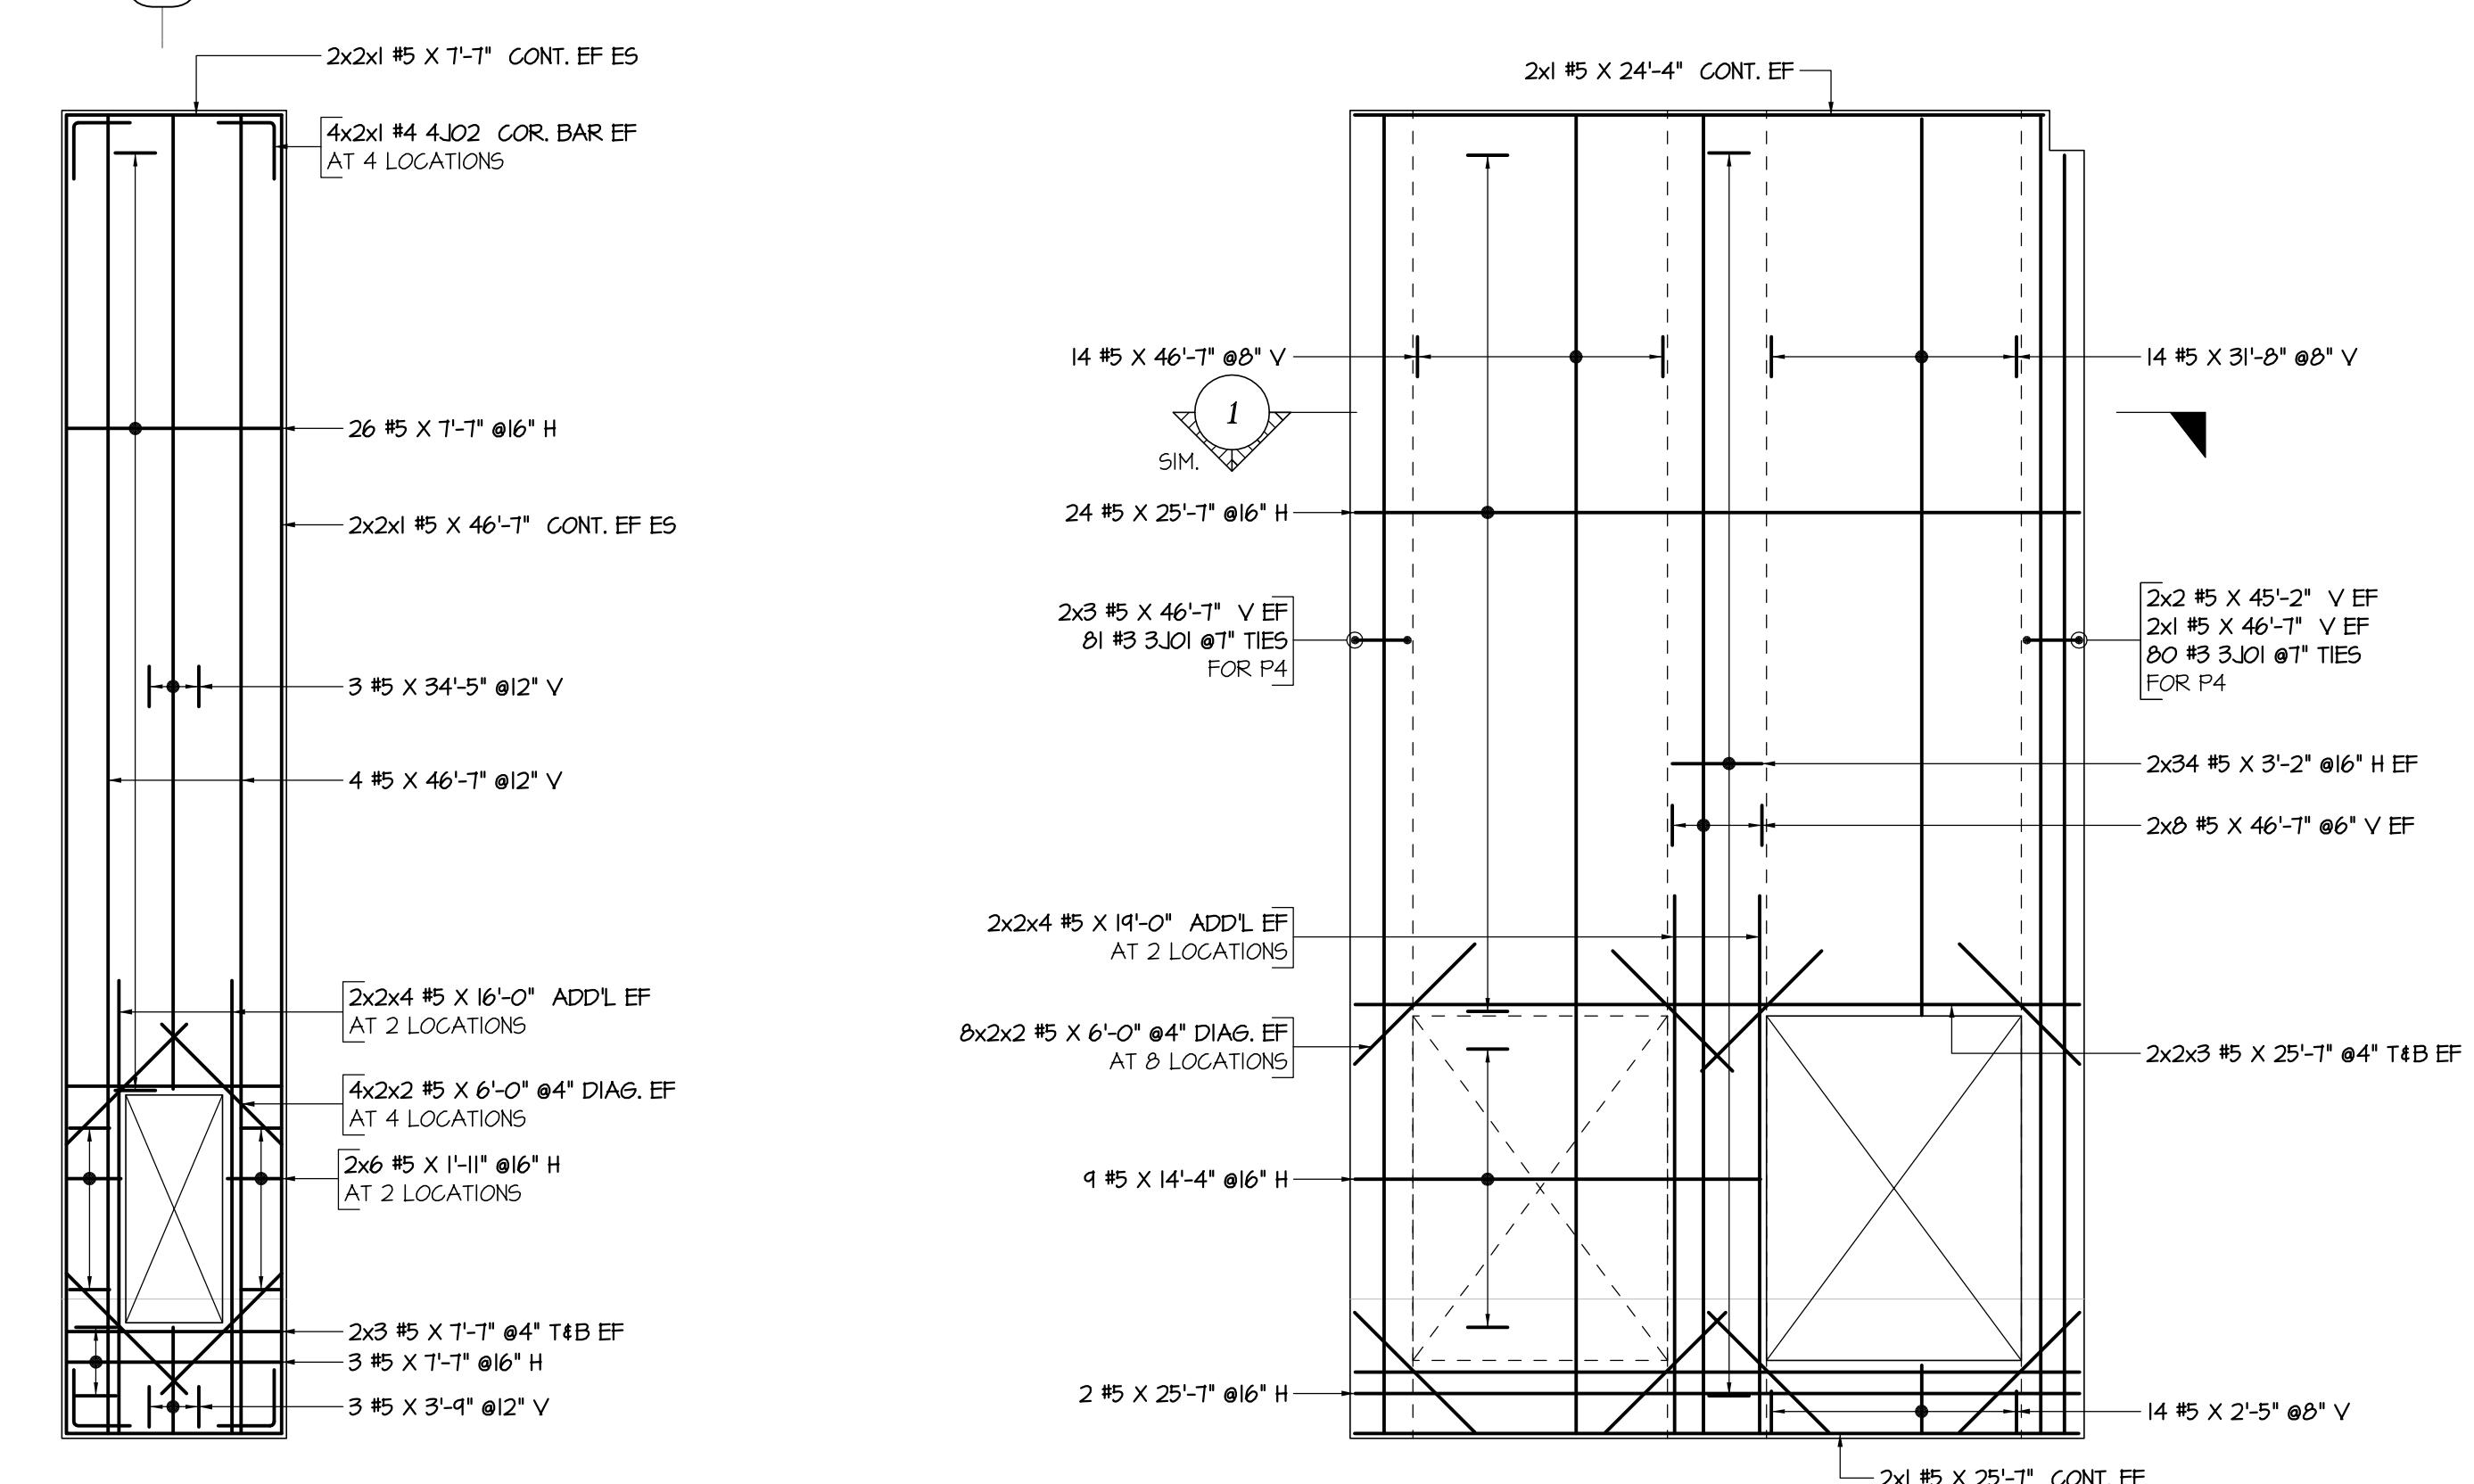


WALL PANEL - S10

SCALE: 1/8" = 1'-0"
SDR: R4, R8 & 5200
(4 1/4" THK WALL)

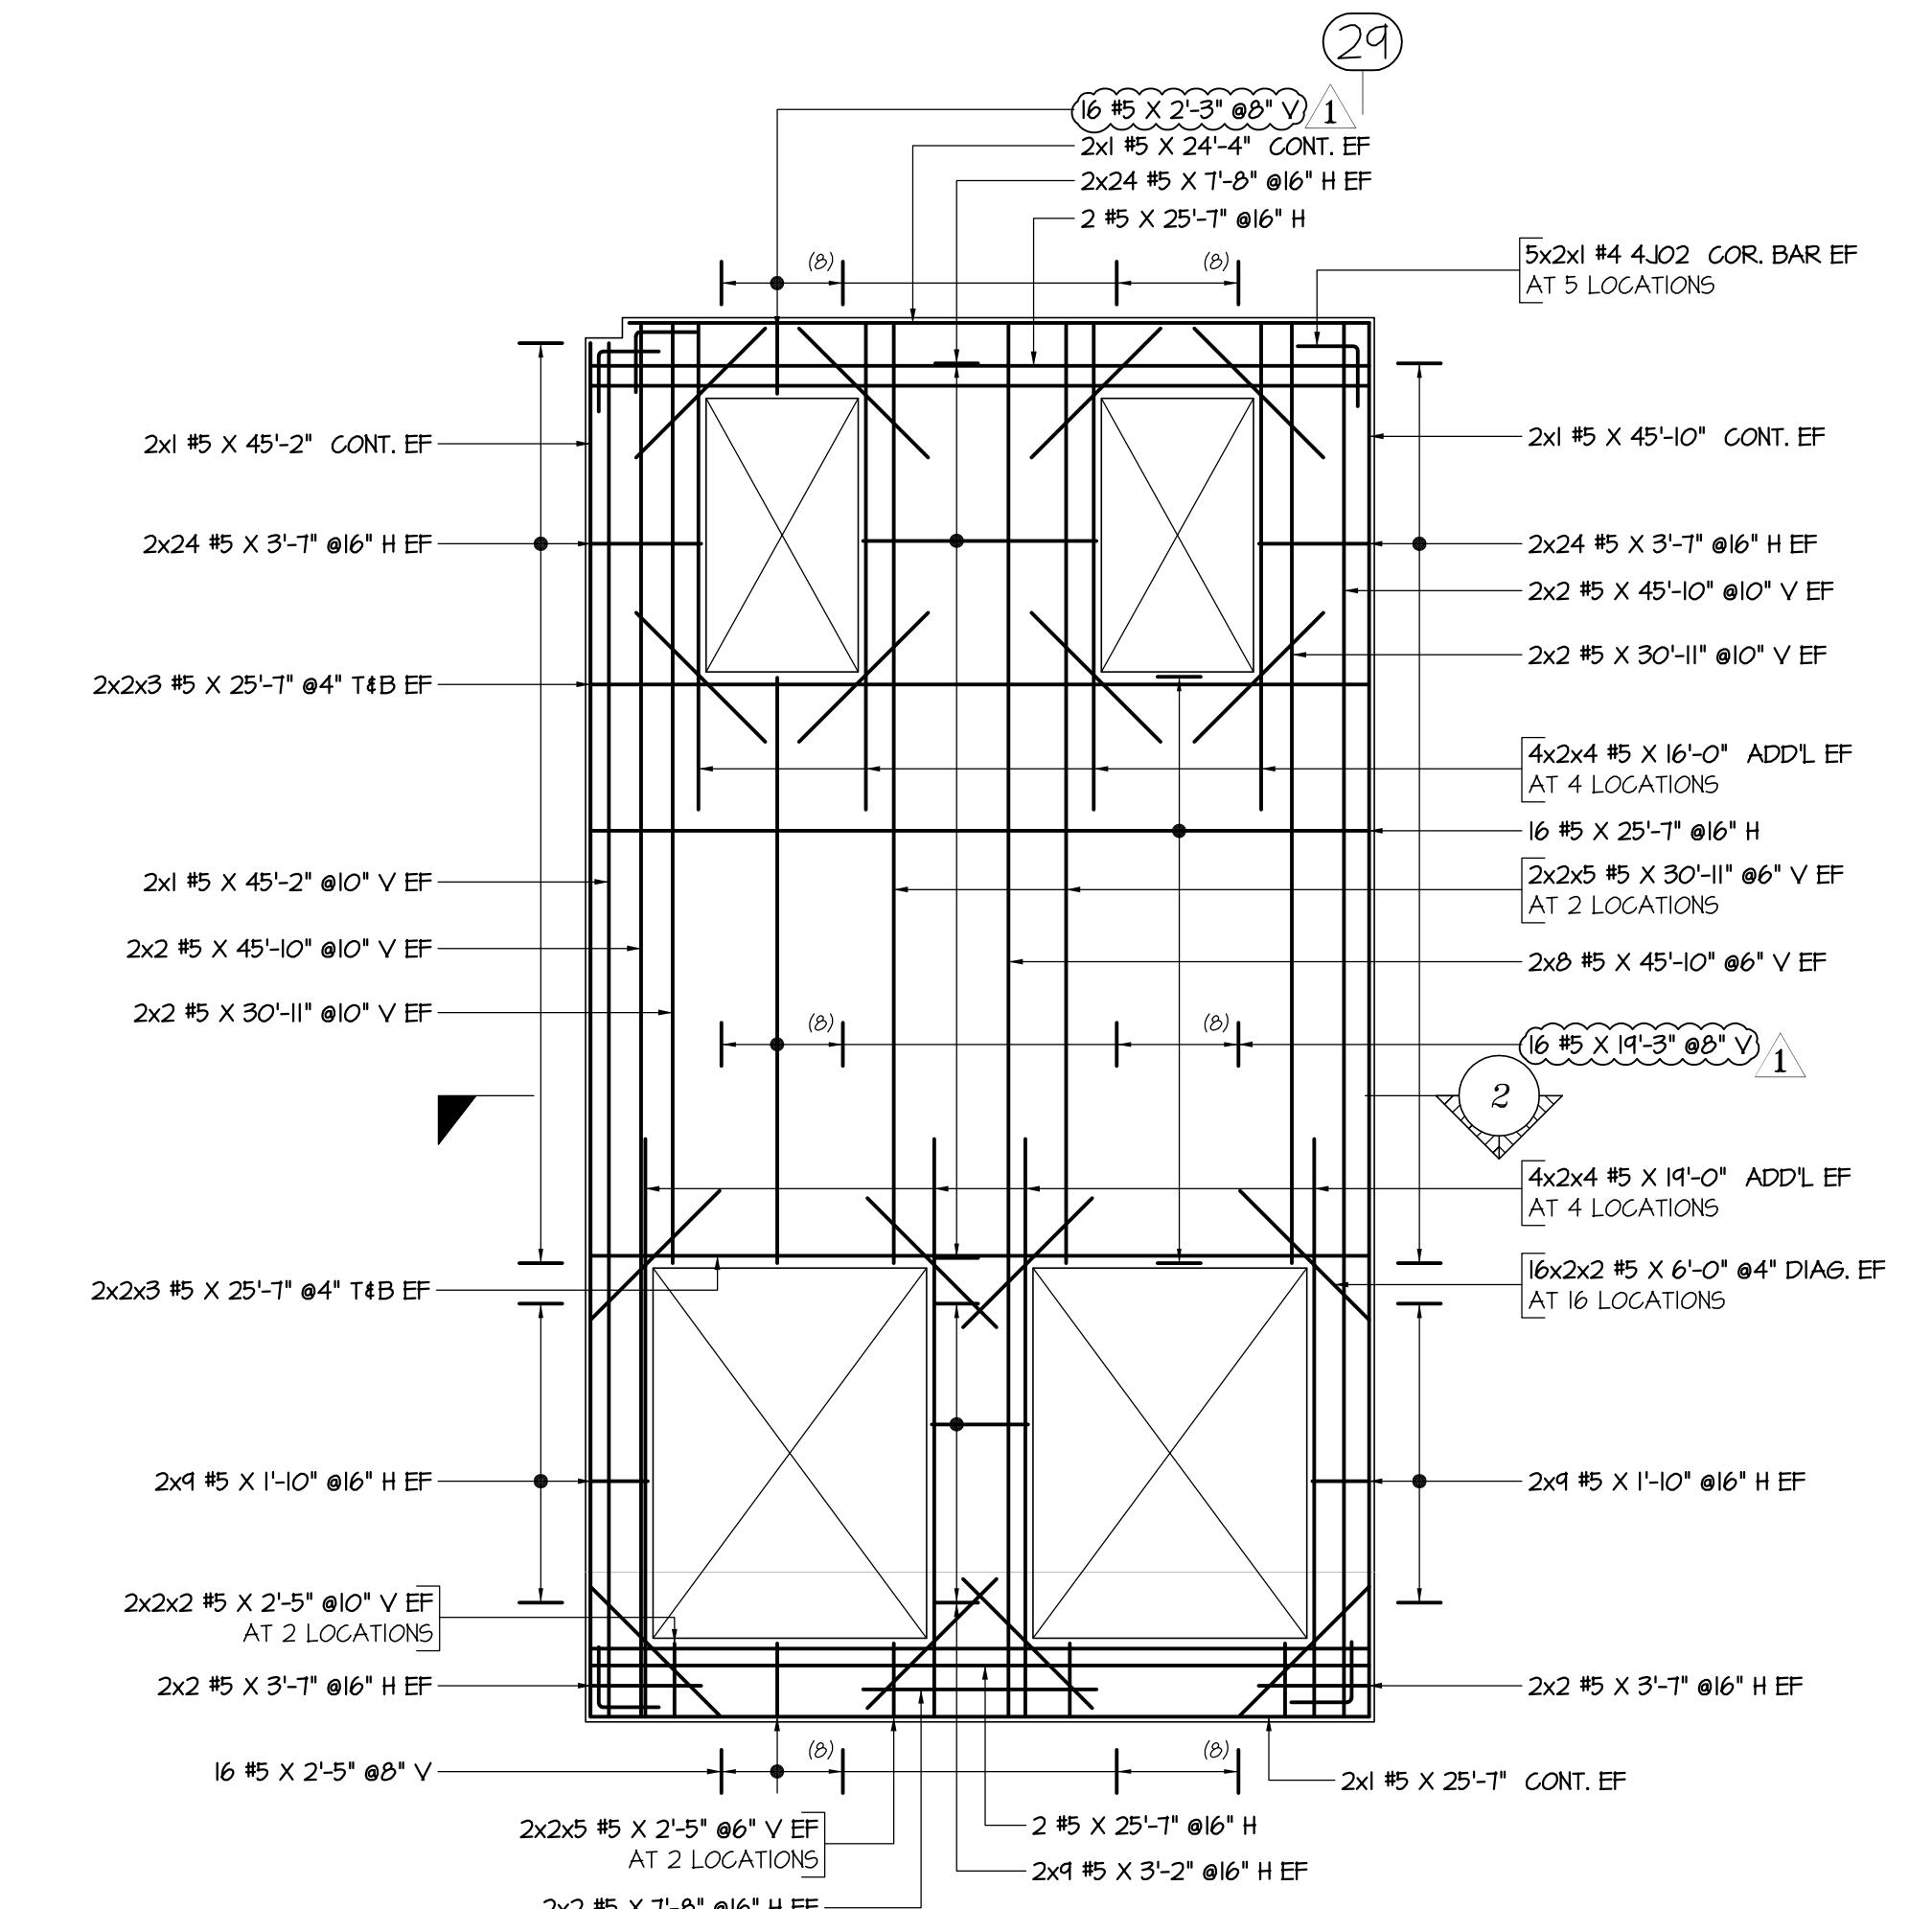


WALL PANEL - S12

SCALE: 1/8" = 1'-0"
SDR: R4, R8 & 5200
(4 1/4" THK WALL)

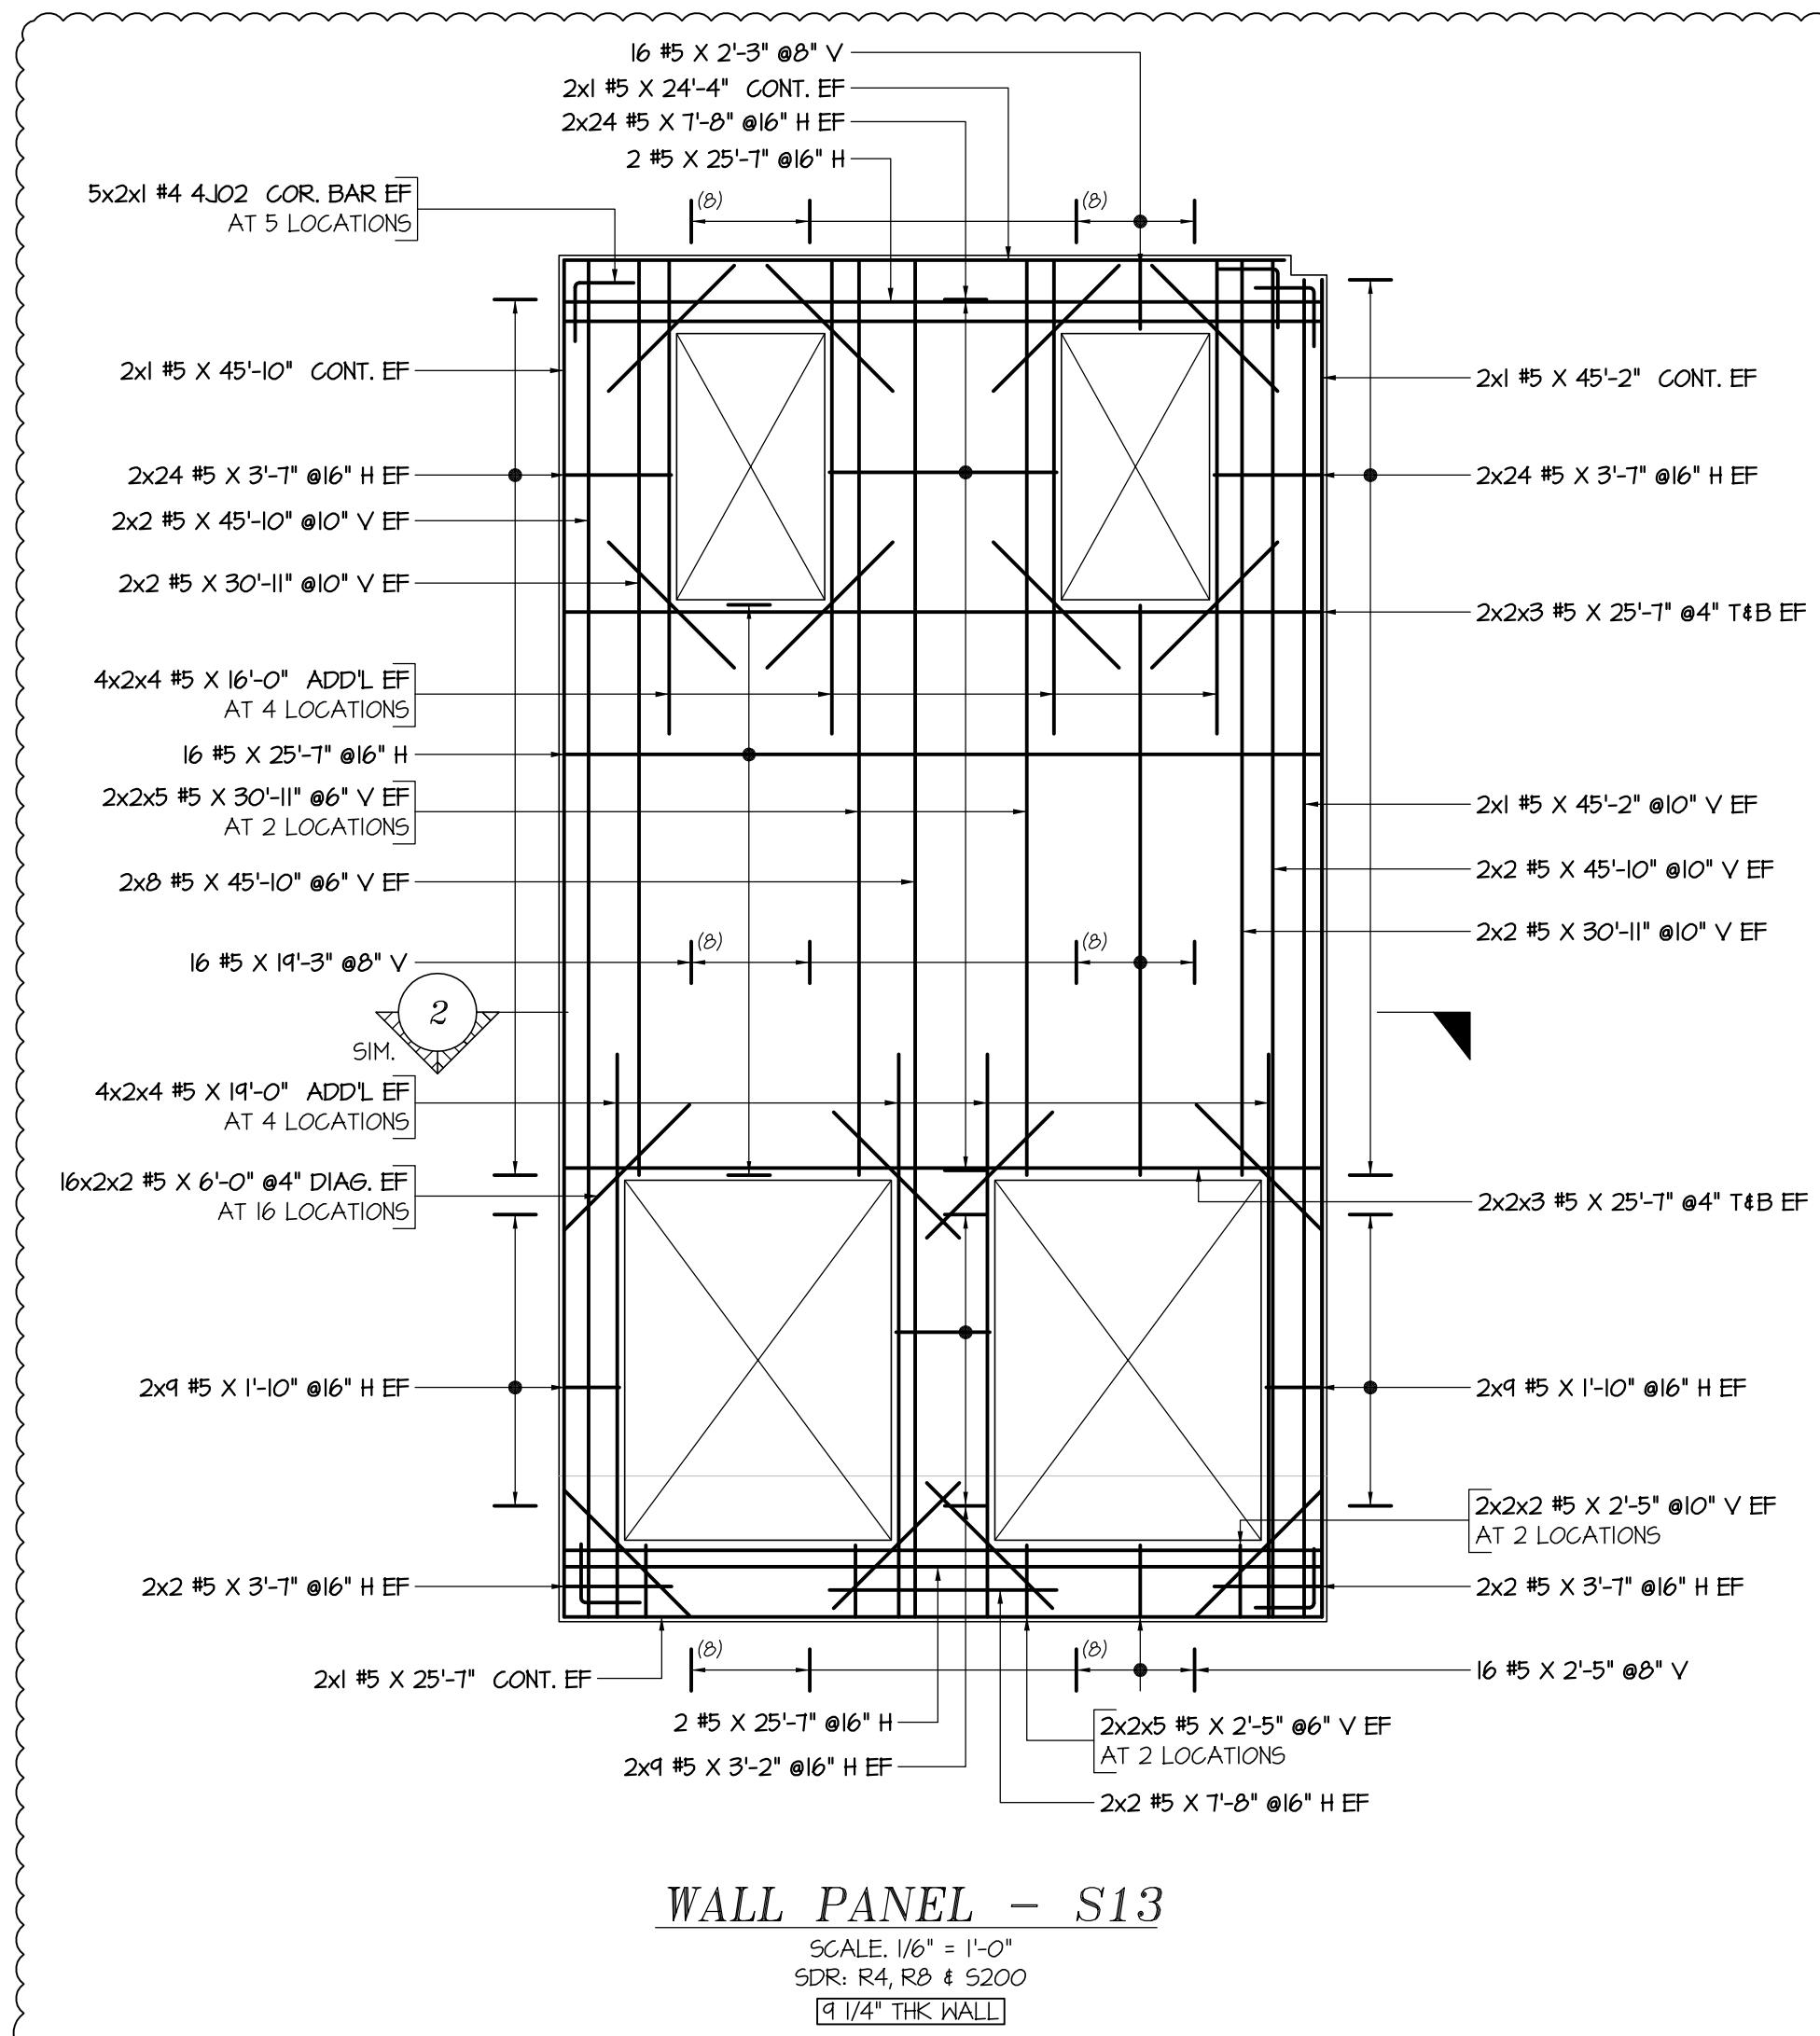

WALL PANEL - S13

SCALE: 1/8" = 1'-0"
SDR: R4, R8 & 5200
(4 1/4" THK WALL)

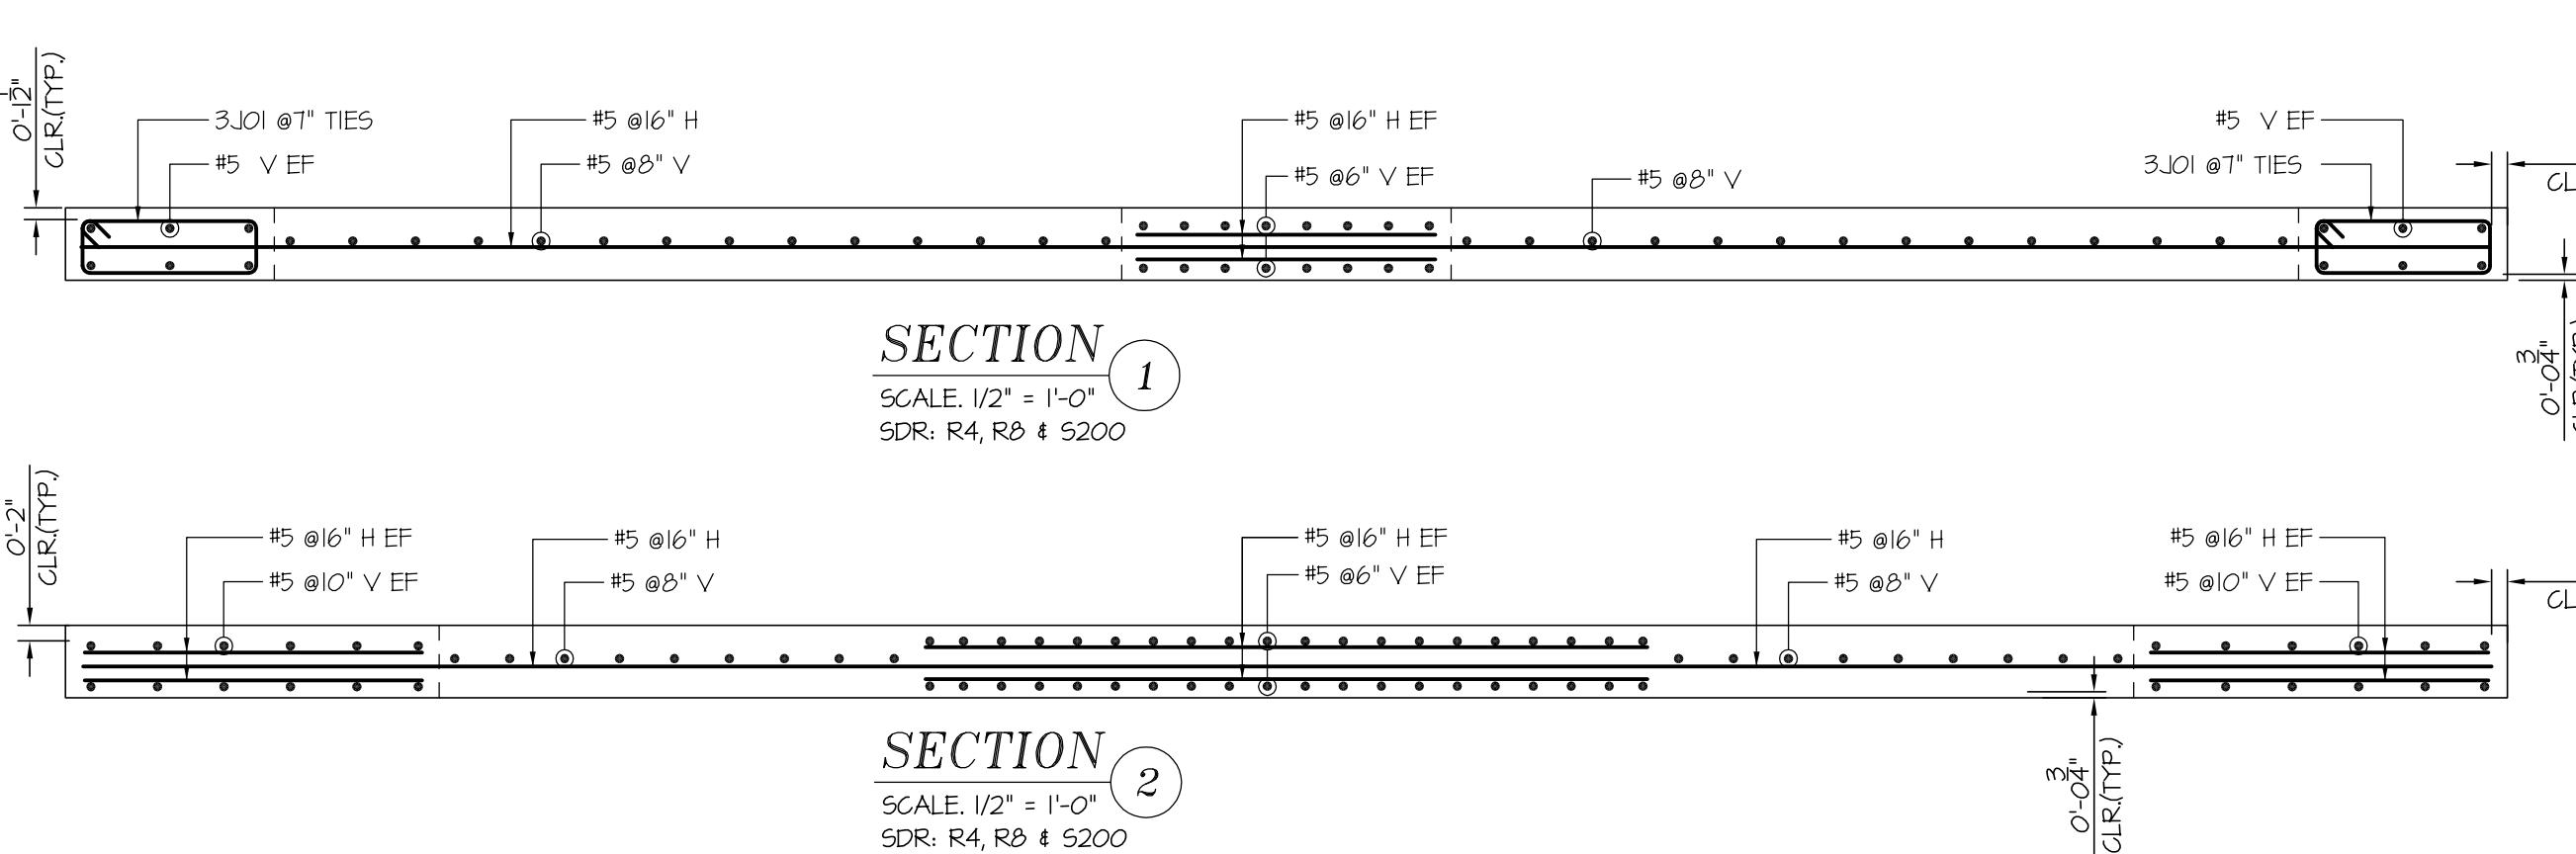


WALL PANEL - S14

SCALE: 1/8" = 1'-0"
SDR: R4, R8 & 5200
(4 1/4" THK WALL)

REBAR PLACEMENT FOR SINGLE LAYERS

SCALE: 1/2" = 1'-0"
SDR: R8

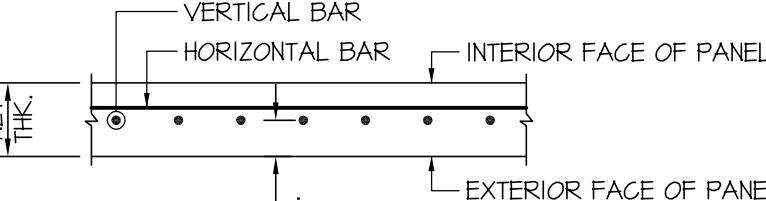


WALL PANEL - S15

SCALE: 1/8" = 1'-0"
SDR: R4, R8 & 5200
(4 1/4" THK WALL)


REBAR PLACEMENT FOR DOUBLE LAYERS

SCALE: 1/2" = 1'-0"
SDR: R8

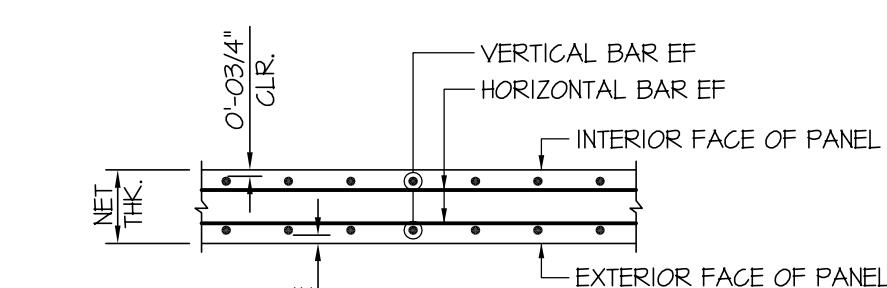


SOUTH WALL PANELS PLACING DRAWING REFERENCE	
DWG.NO:	DRAWING DESCRIPTION
R-18	SOUTH WALL PANELS S-1 TO S-8
R-19	SOUTH WALL PANELS S-9 TO S-15
R-20	SOUTH WALL PANELS S-16 TO S-22
R-21	SOUTH WALL PANELS N-23 TO N-30
R-22	SOUTH WALL PANELS N-31 TO N-37
R-23	SOUTH WALL PANELS N-38 TO N-44
R-24	SOUTH WALL PANELS N-45 TO N-51
R-25	SOUTH WALL PANELS N-52 TO N-58
R-26	SOUTH WALL PANELS N-59 TO N-66
R-27	SOUTH WALL PANELS N-67 TO NT3
R-28	SOUTH WALL PANELS N-74 TO N-80

BENDING DETAILS	
Bar Work	Oy Size
3001	482 #3 5'-7" X 11' 0"-4" X'
4002	36 #4 4'-0" 17' 0"-7" X 1'-10" X'
	0'-7" 2'-0"
	0'-4" X'

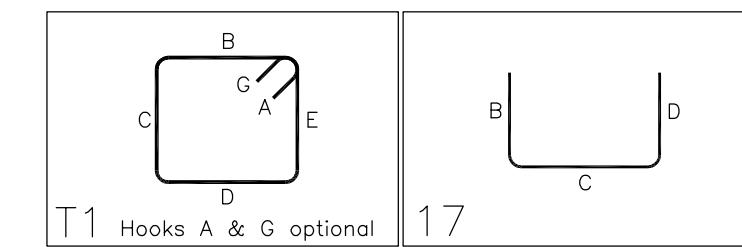

REINFORCING STEEL PLACING DRAWING ONLY. USE IN CONJUNCTION WITH CONTRACT DRAWINGS & SPECIFICATIONS. ELEVATIONS & DIMENSIONS SHOWN ON THIS DRAWING ARE FOR DETAILING PURPOSES ONLY AND SHOULD NOT BE USED FOR CONSTRUCTION UNLESS VERIFIED BY ENGINEER OR CONTRACTOR.

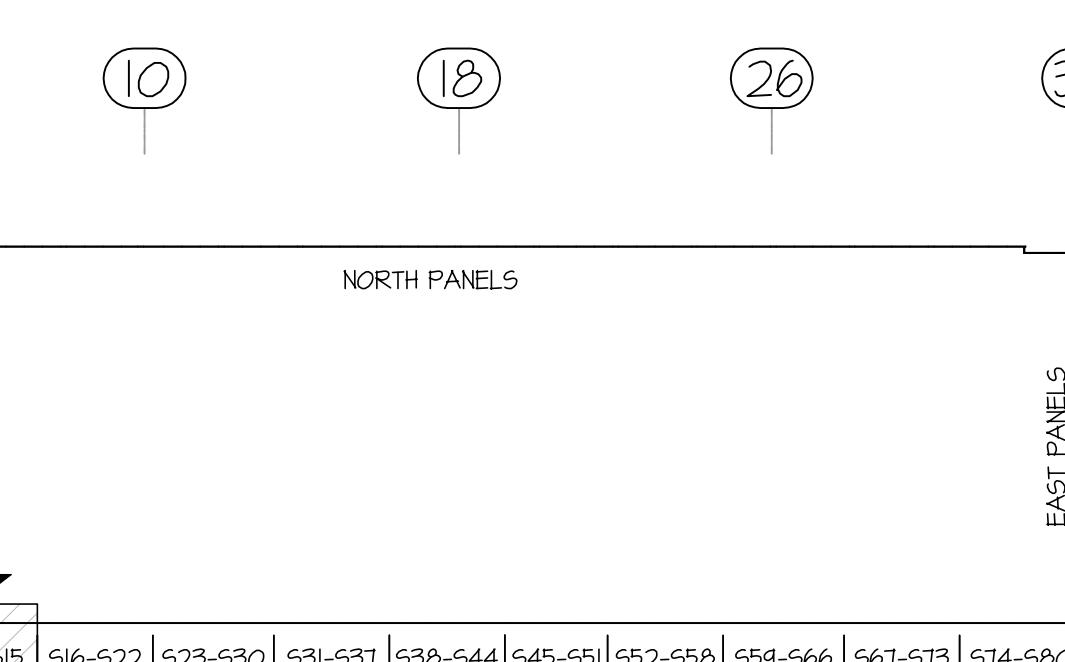












KEY PLAN
N.S.

7	
6	
5	
4	
3	
2	06.14.2019 RE SUBMITTED FOR APPROVAL
1	05.29.2019 APPROVAL DATE

RE-STEEL SUPPLY CO., INC.
REINFORCING STEEL - WIRE MESH
2000 Eddystone Industrial Park • Eddystone, PA 19022-1588
Phone: 800-876-8216 Fax: 610-876-8428

Structure	VALLEY VIEW BUSINESS PARK TILT PANELS
Location	JESSUP, PA
Architect	KSS ARCHITECTS
Engineer	RICHARD ADAMS
Customer	T&T CONSTRUCTION
Made by:	PRO Date: 05.29.2019
REV. NO.	CONTRACT NO. U2524
DATE	06.14.2019
REVISIONS AS PER LATEST CDS RECEIVED ON 05.31.19	DRAWING NO. R-19
REV. NO.	DRAWING COVERS
DATE	SOUTH WALL PANELS S-9 TO S-15
DESCRIPTION	

 

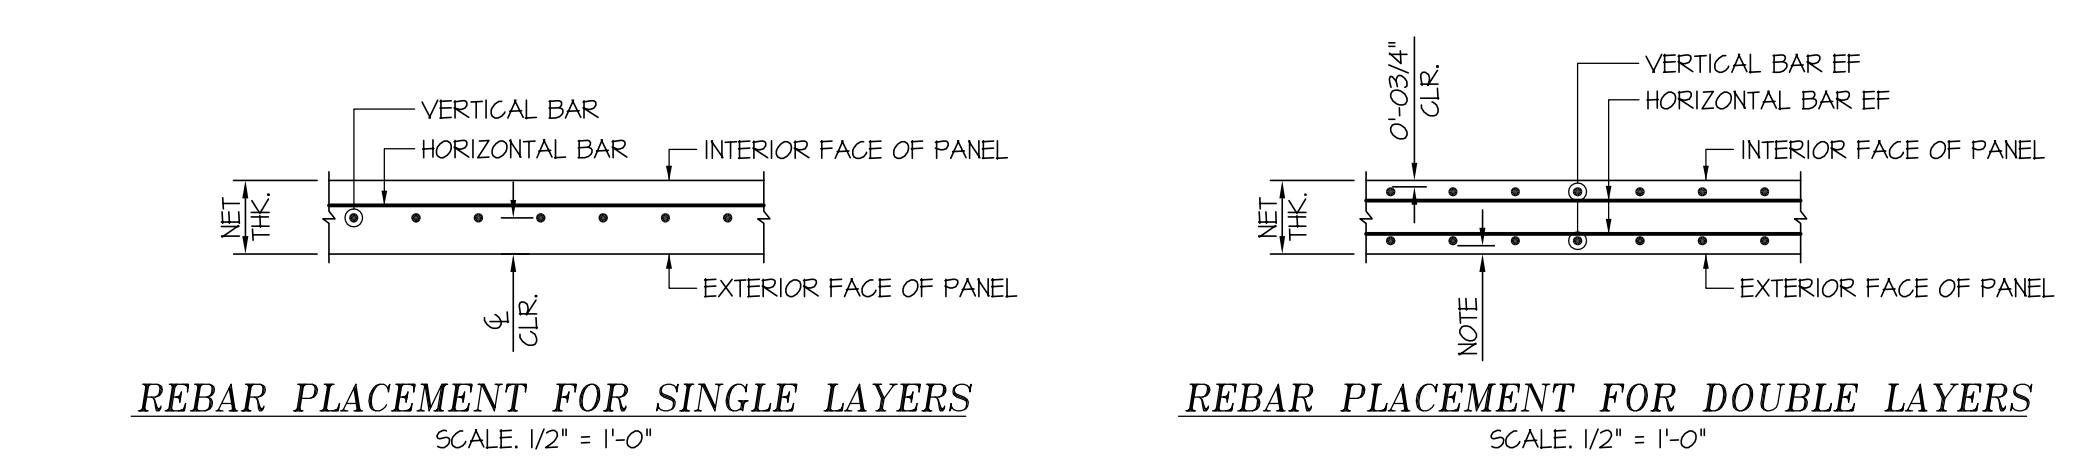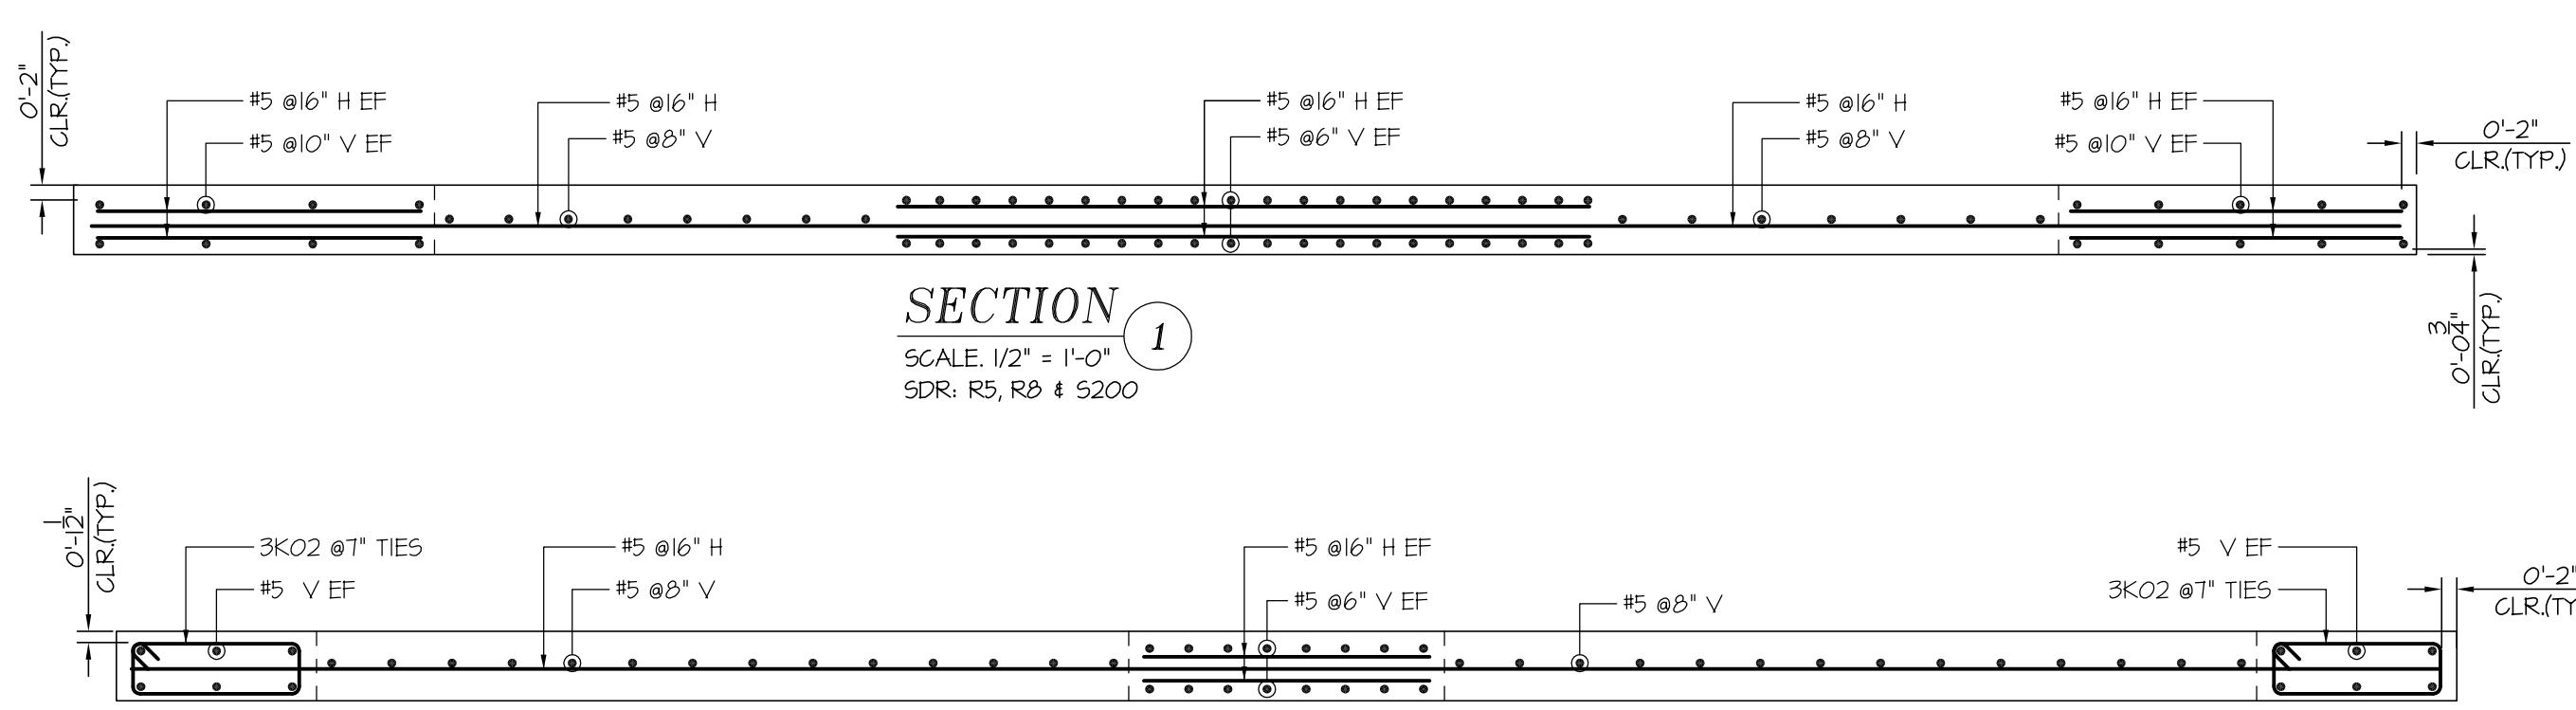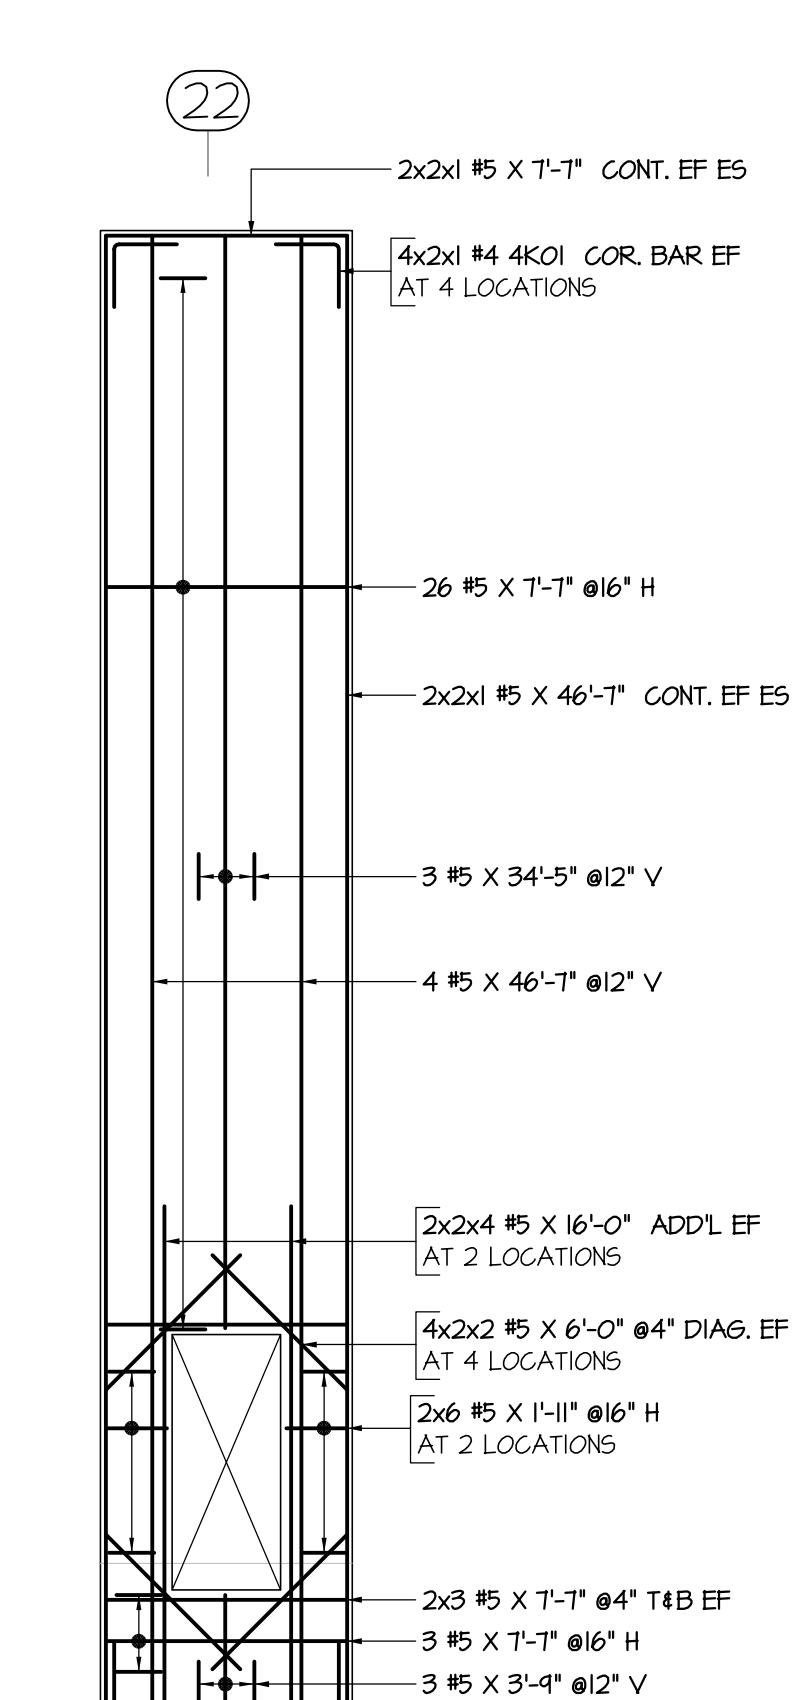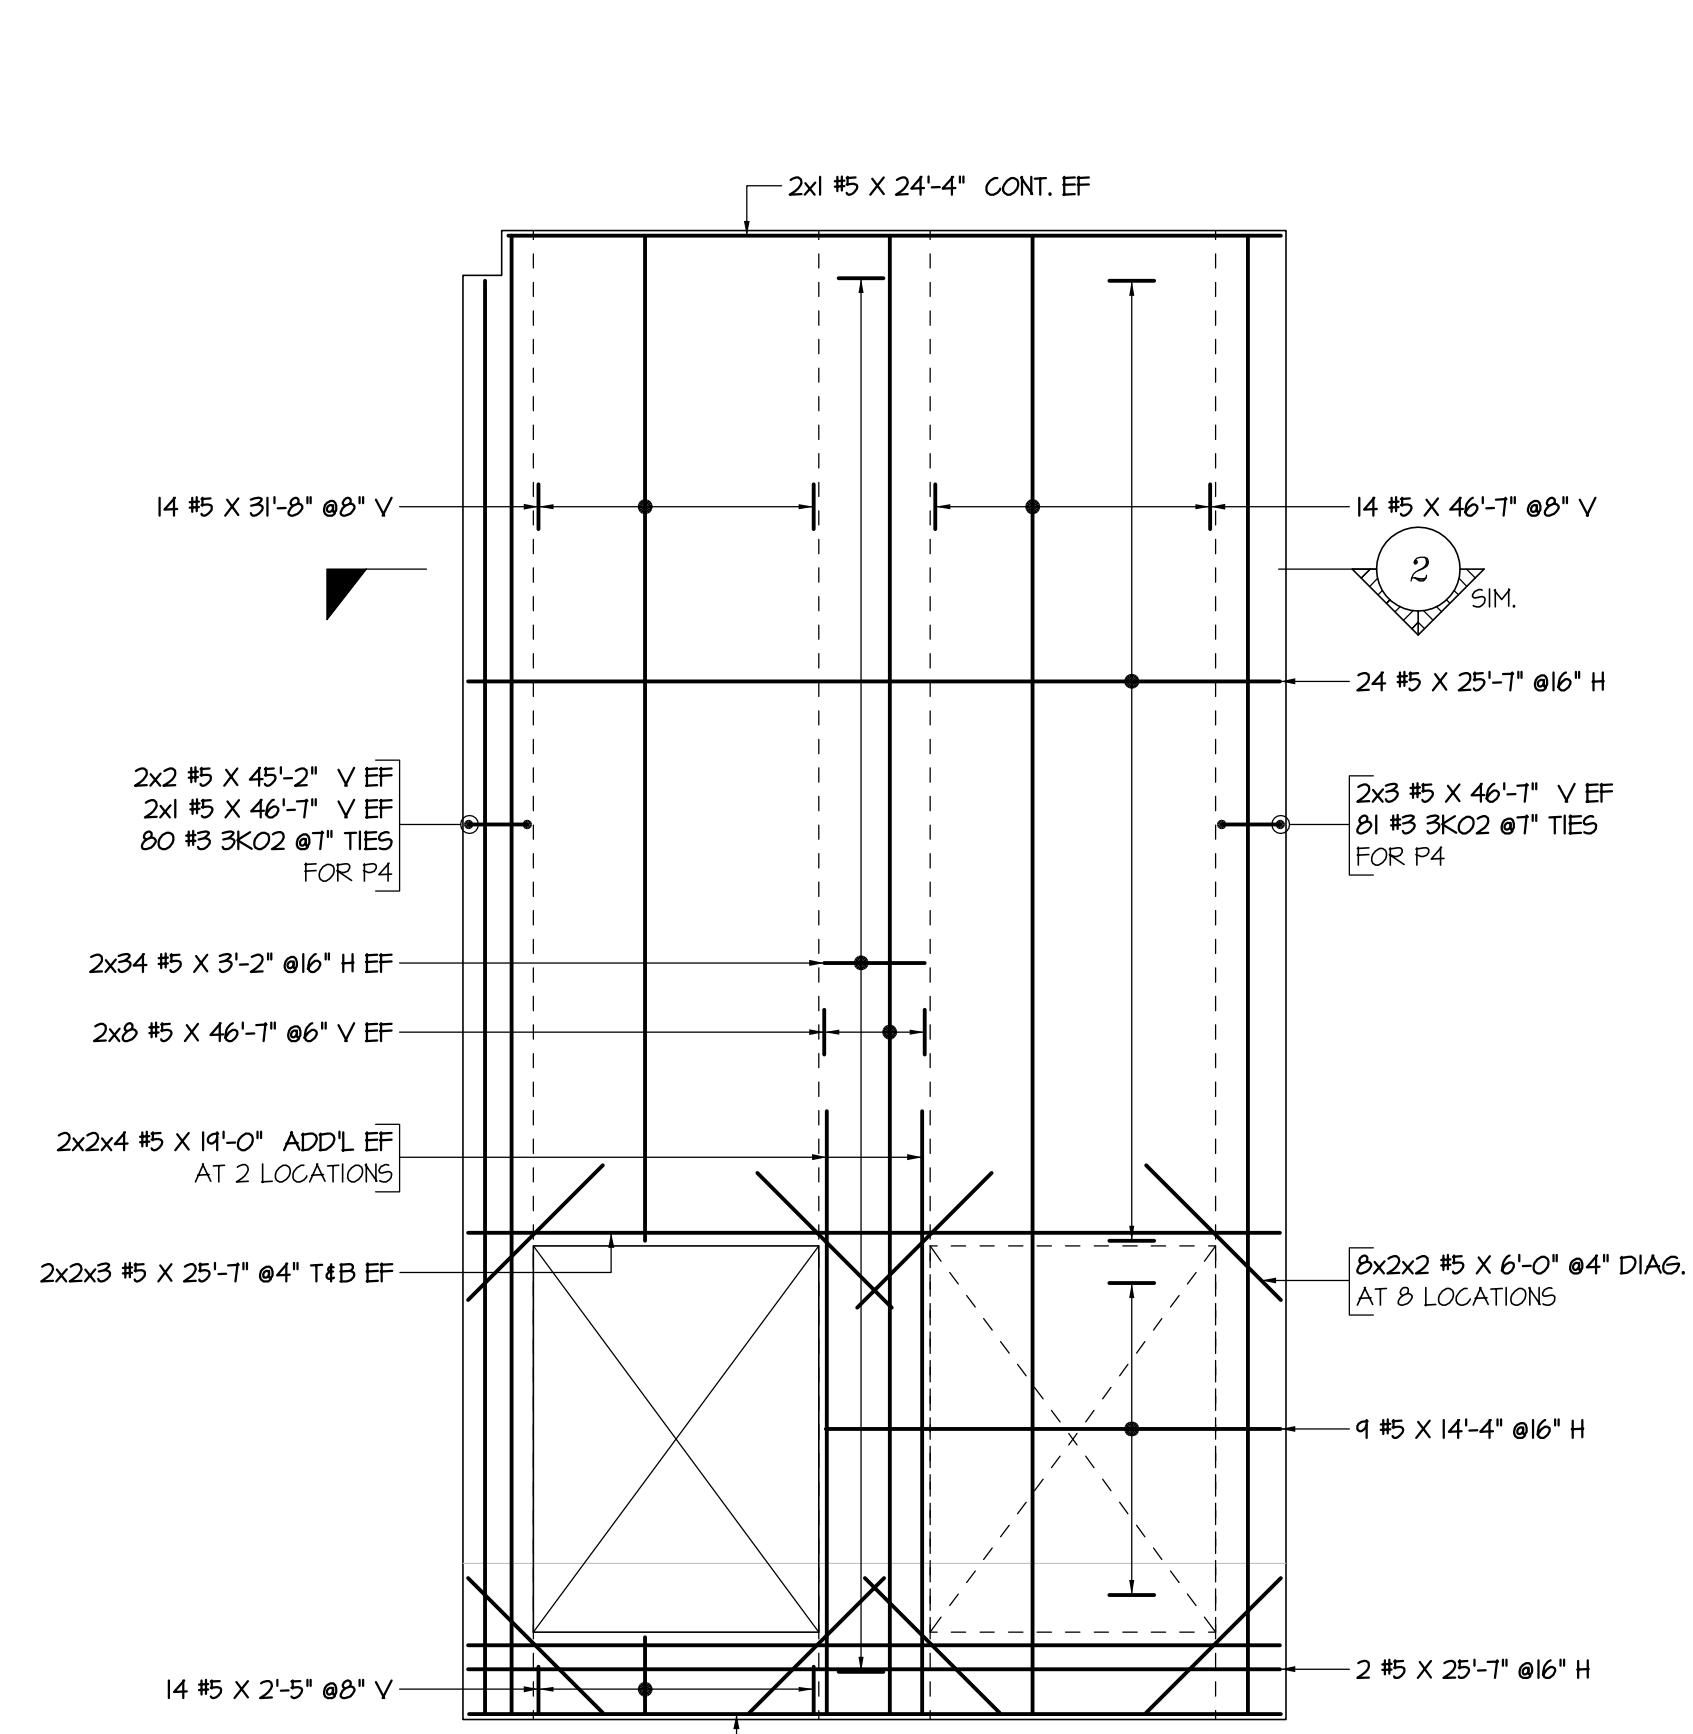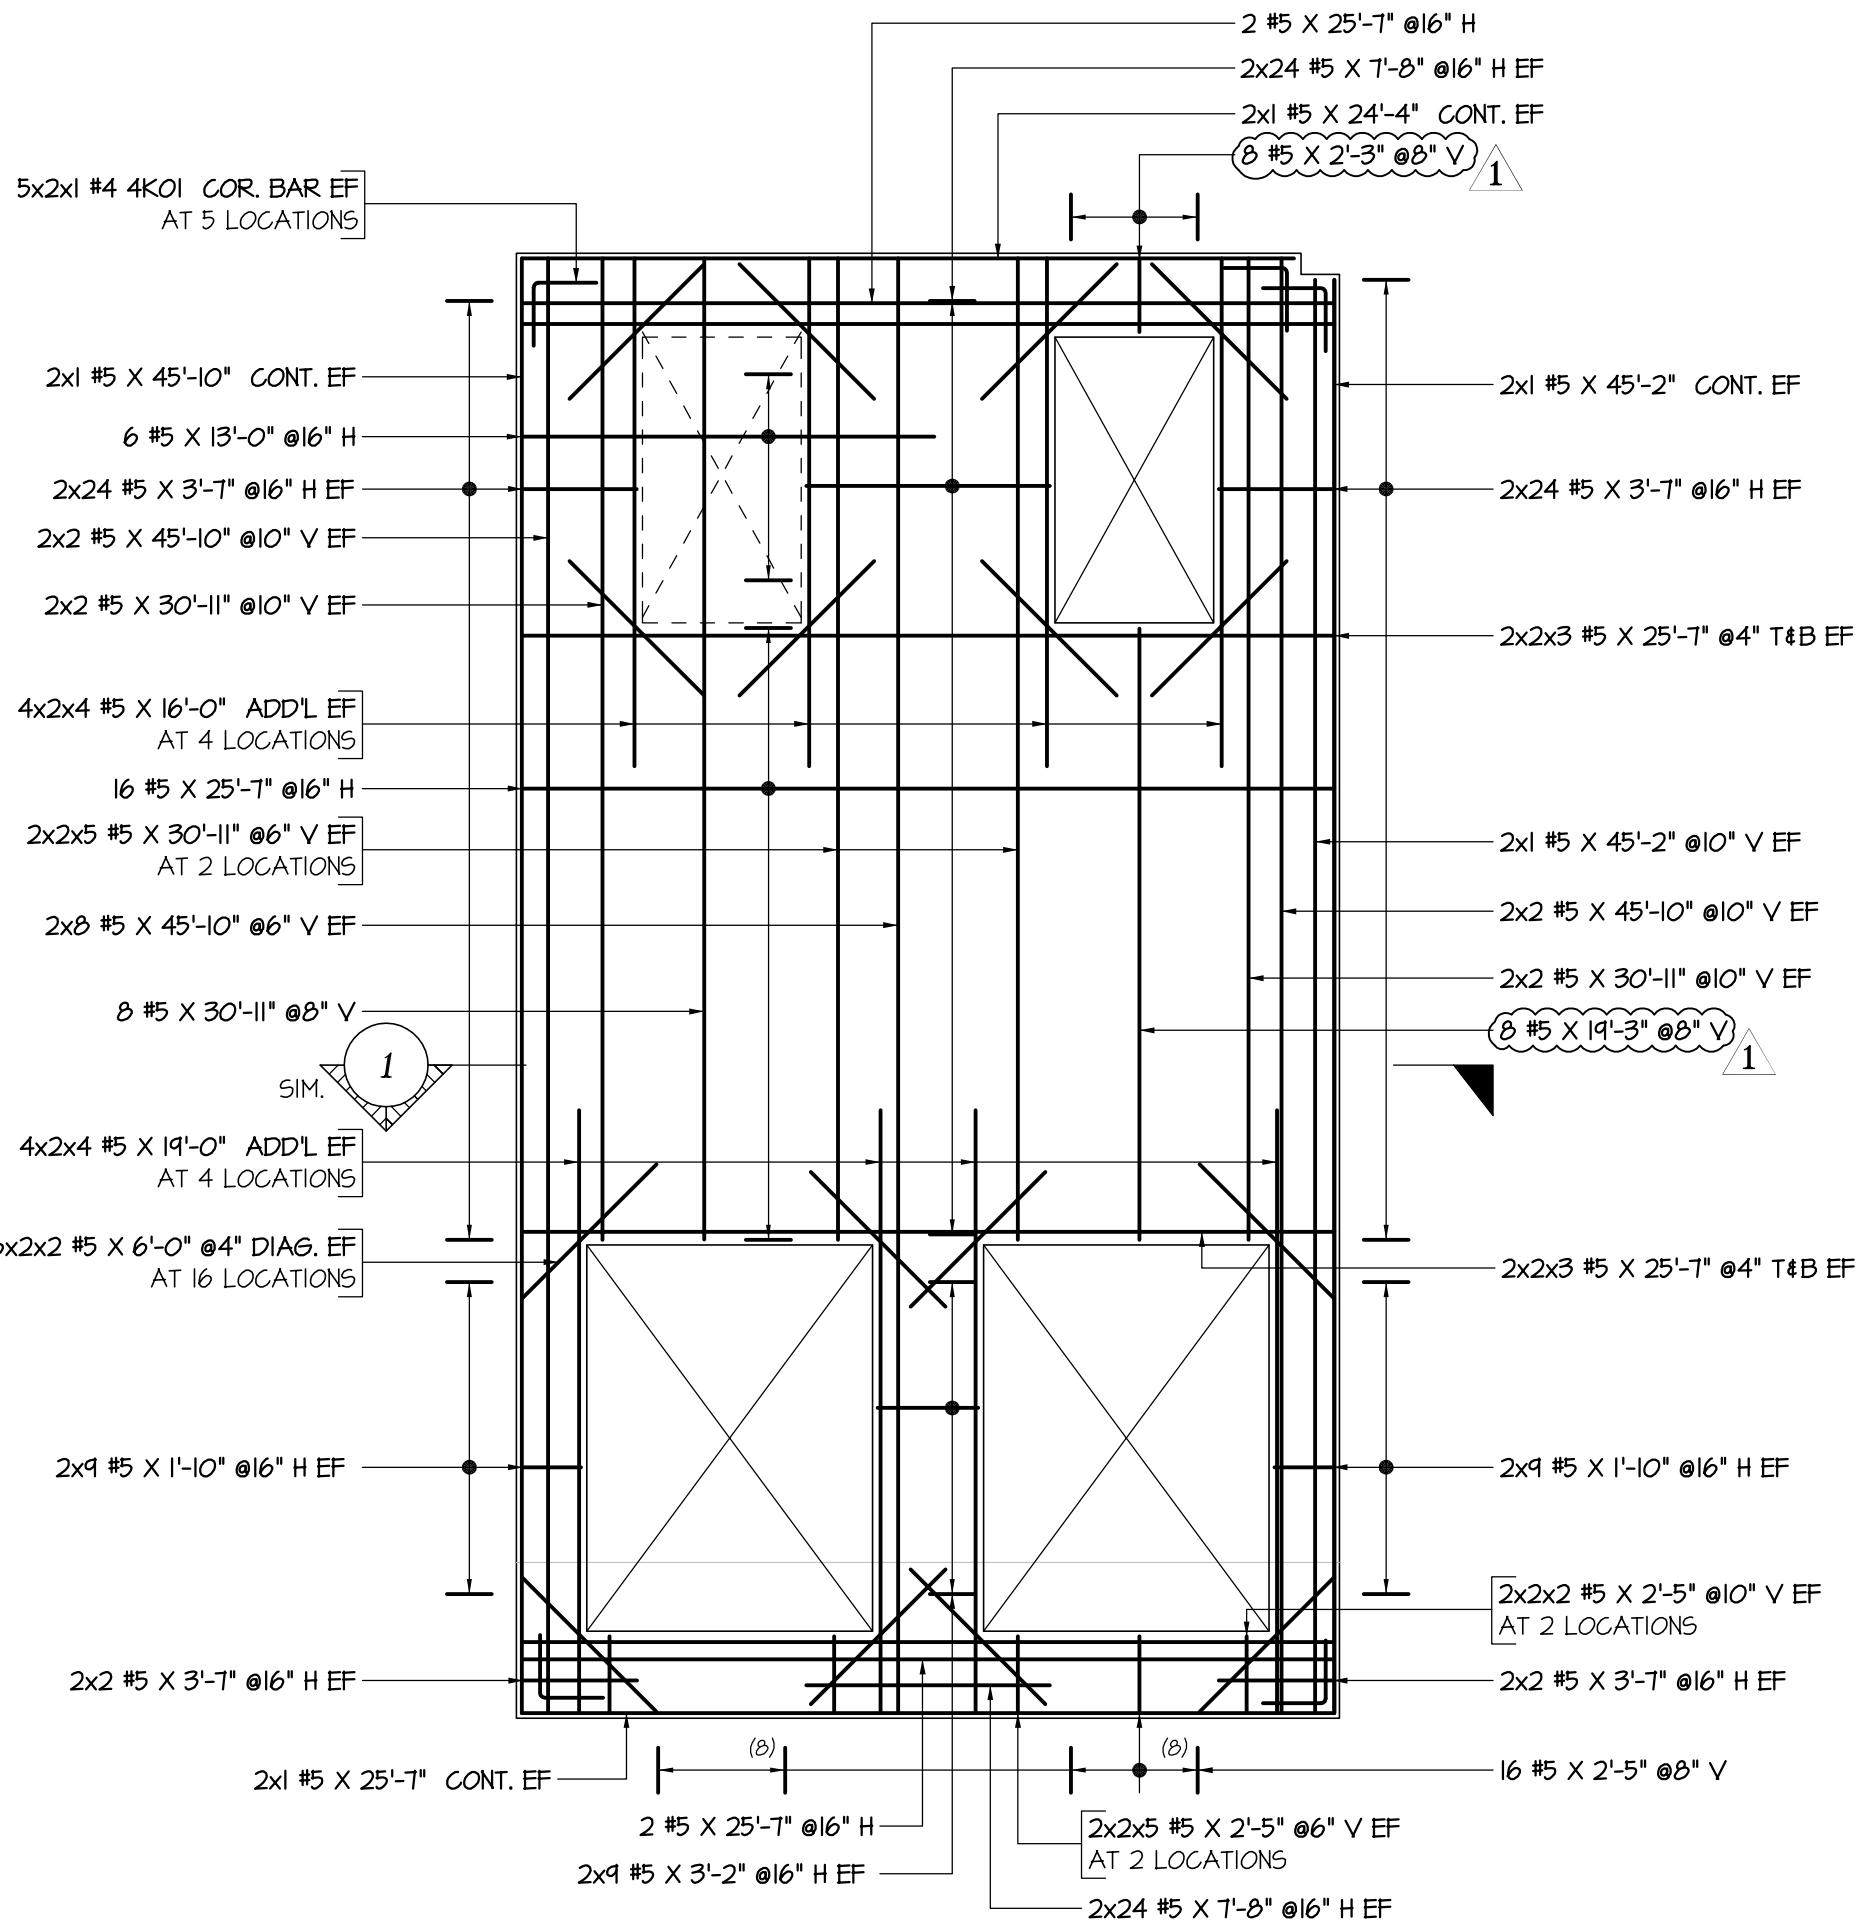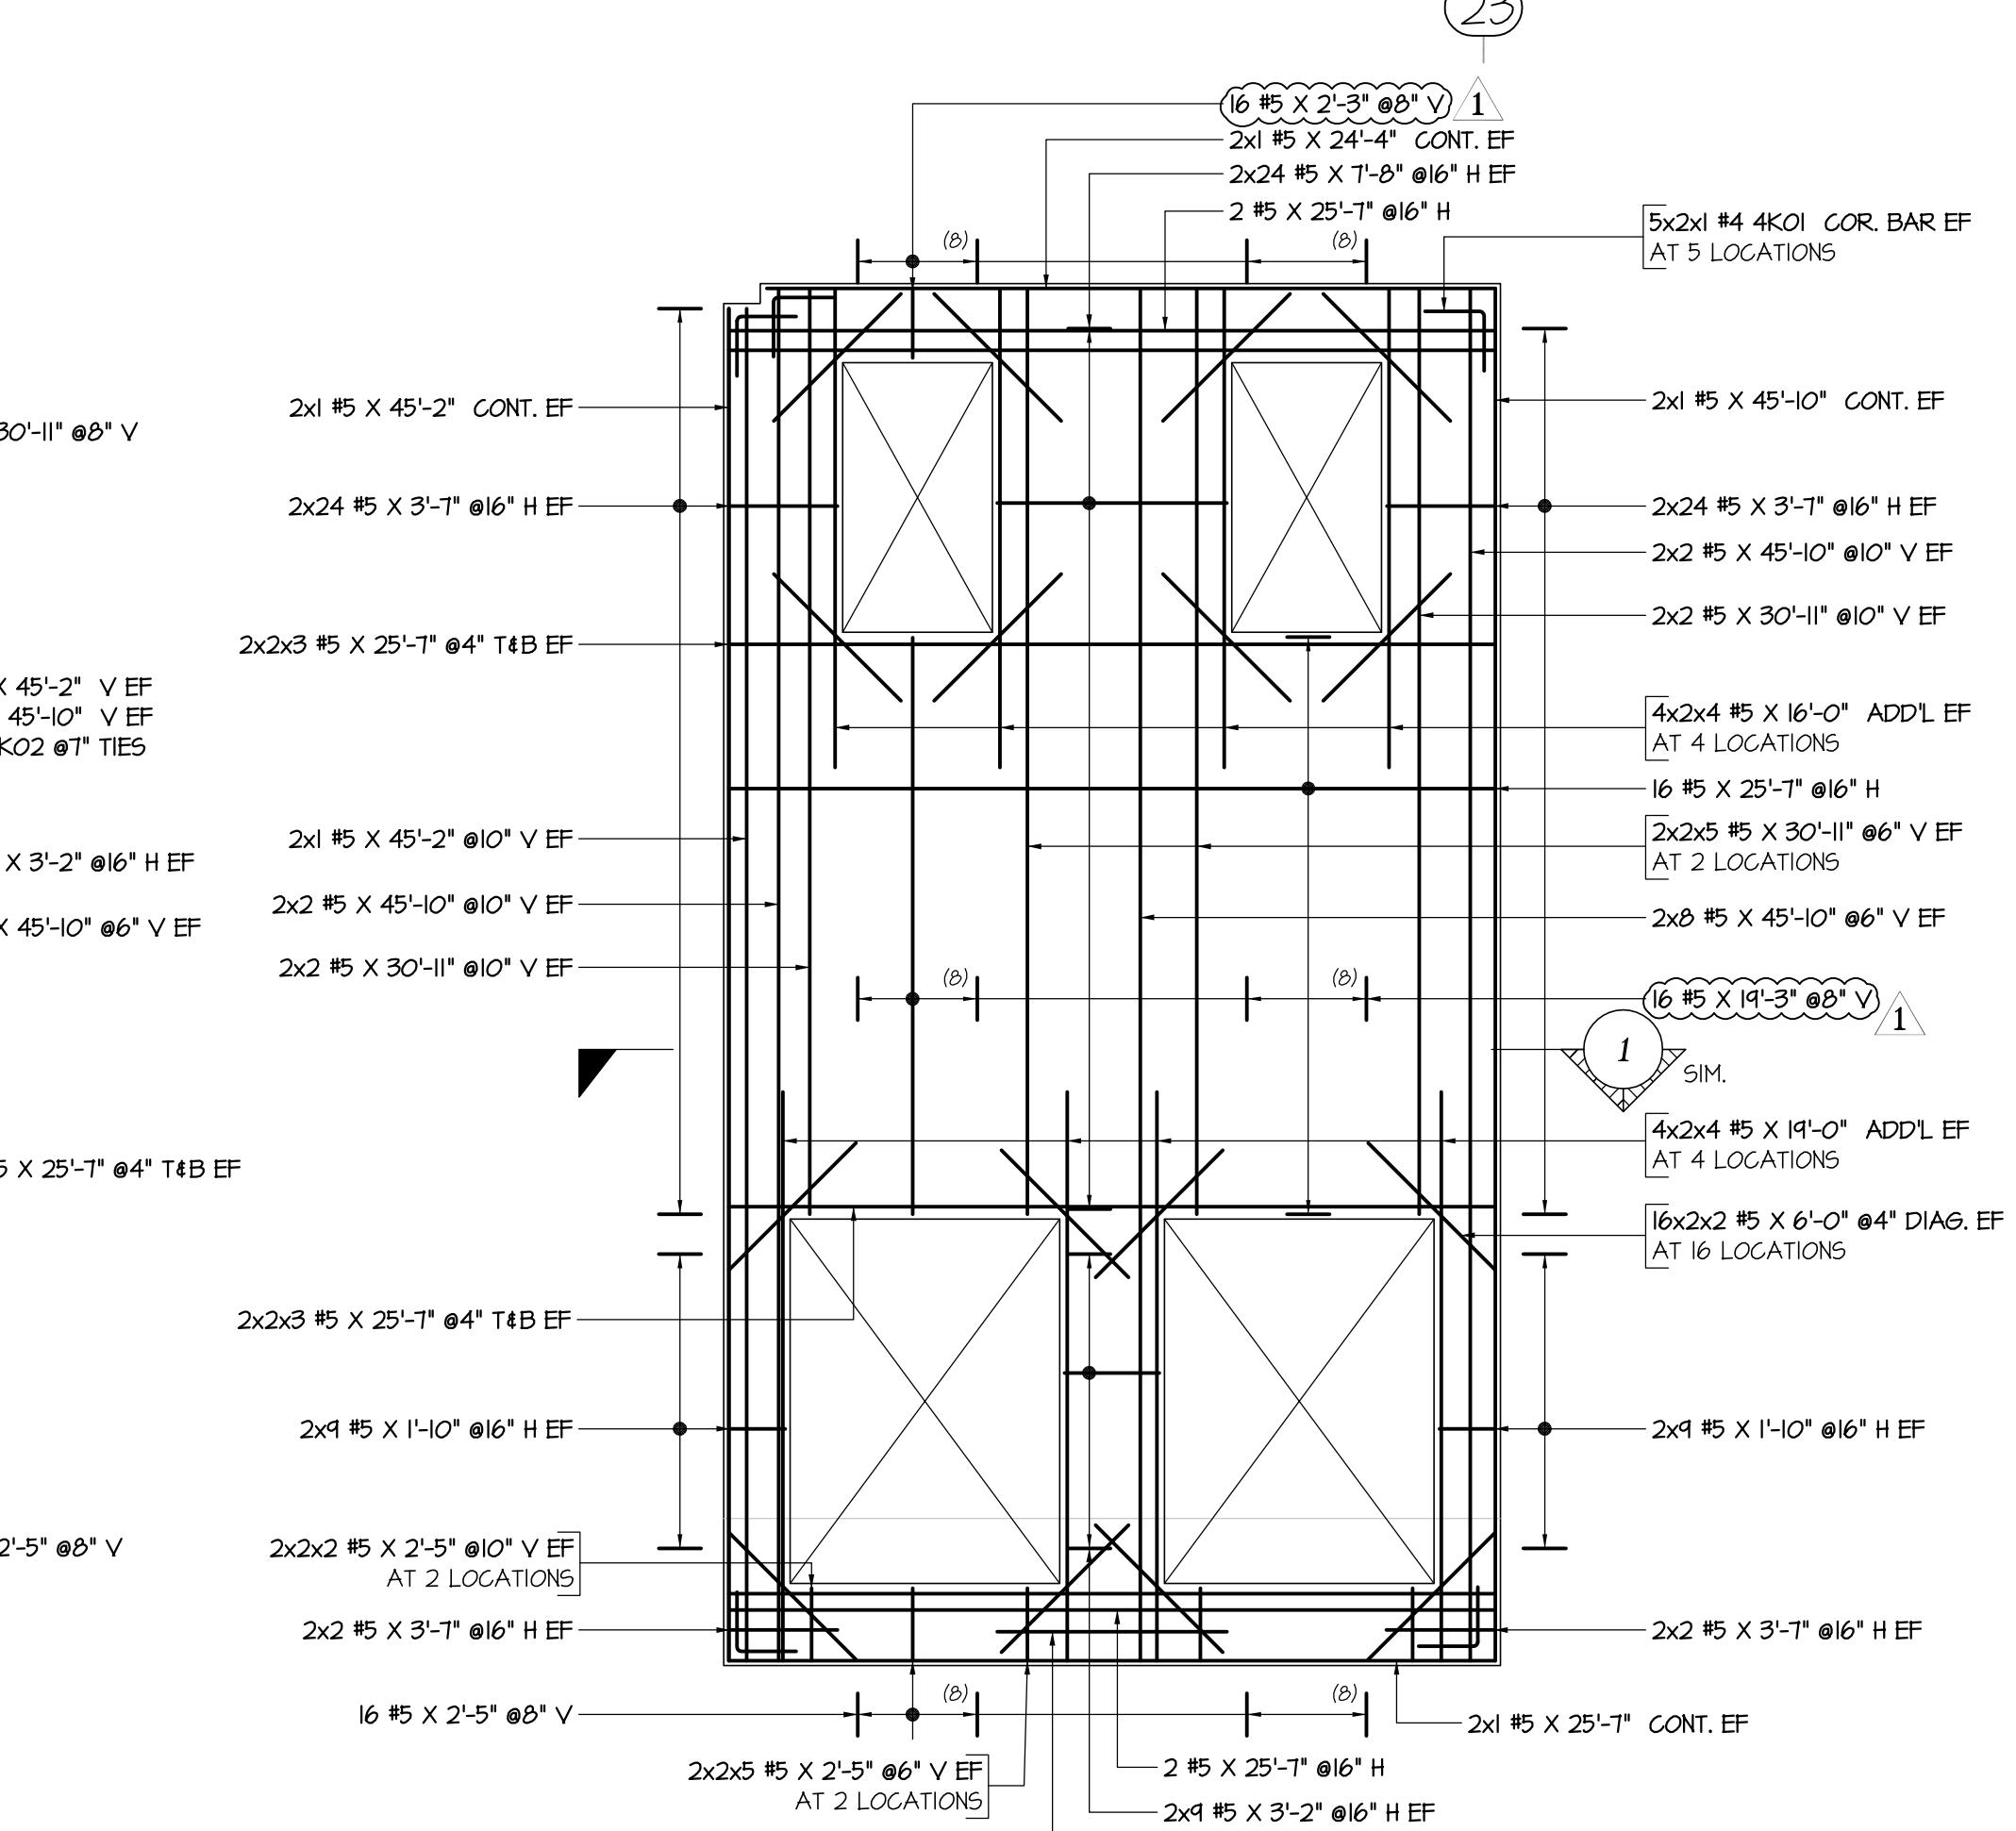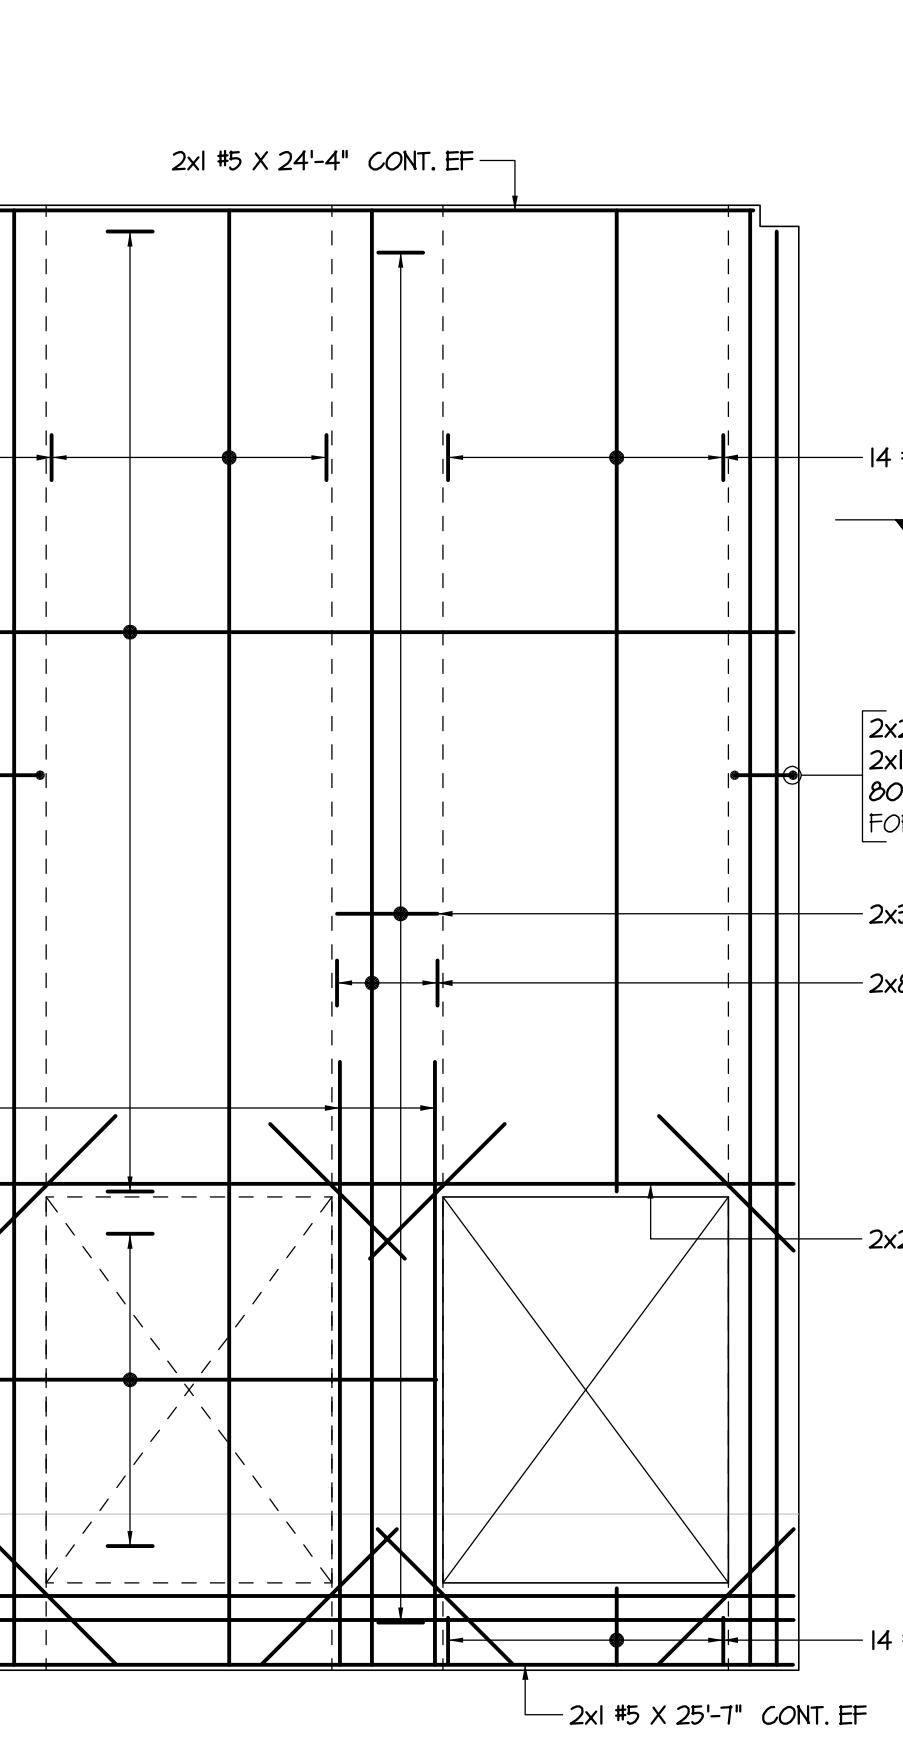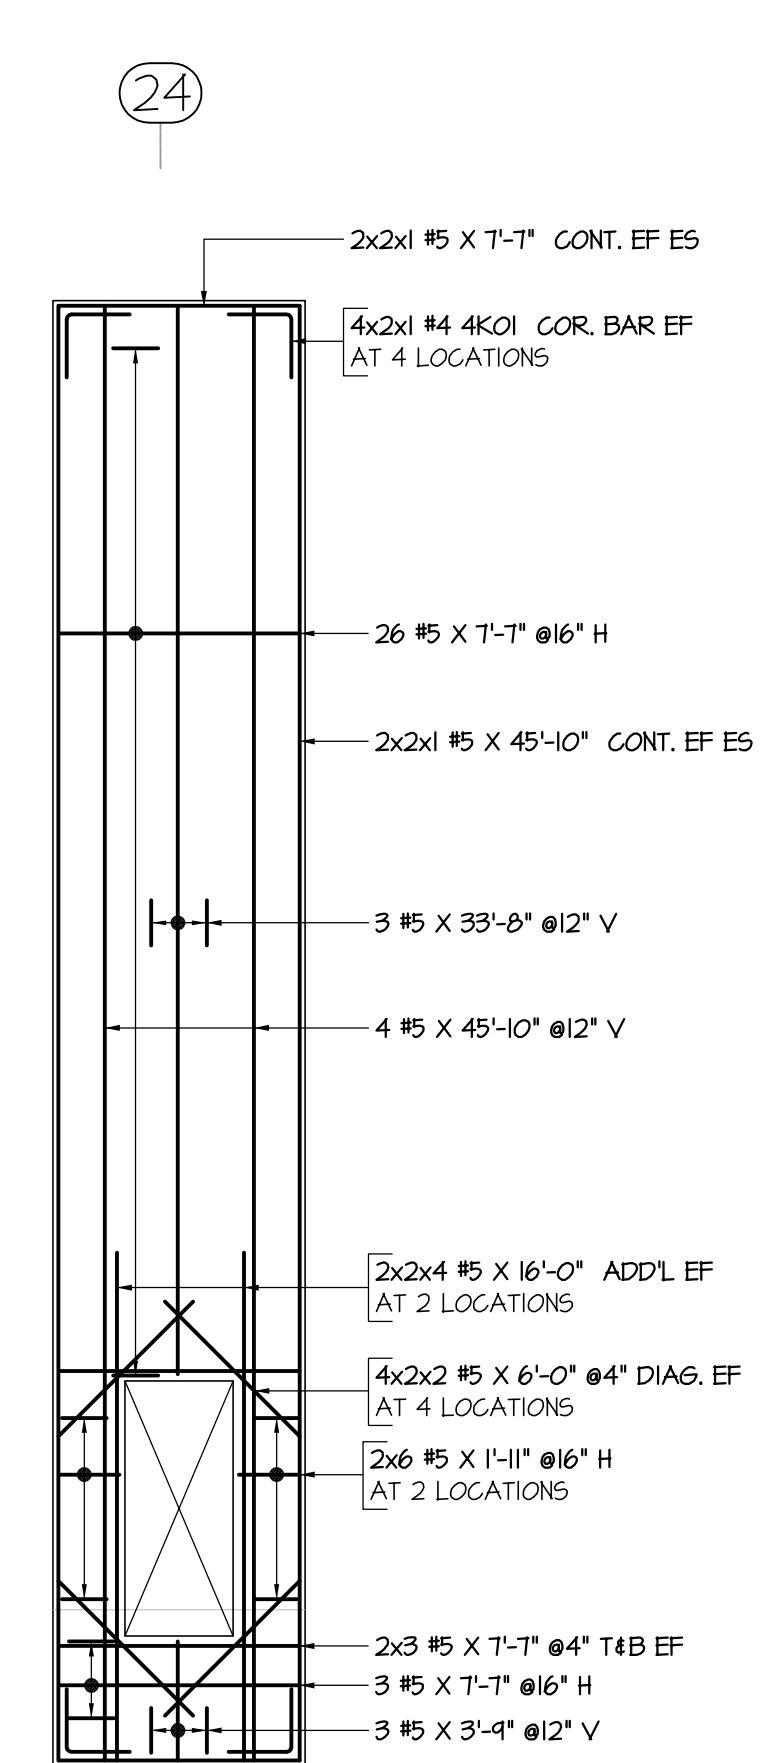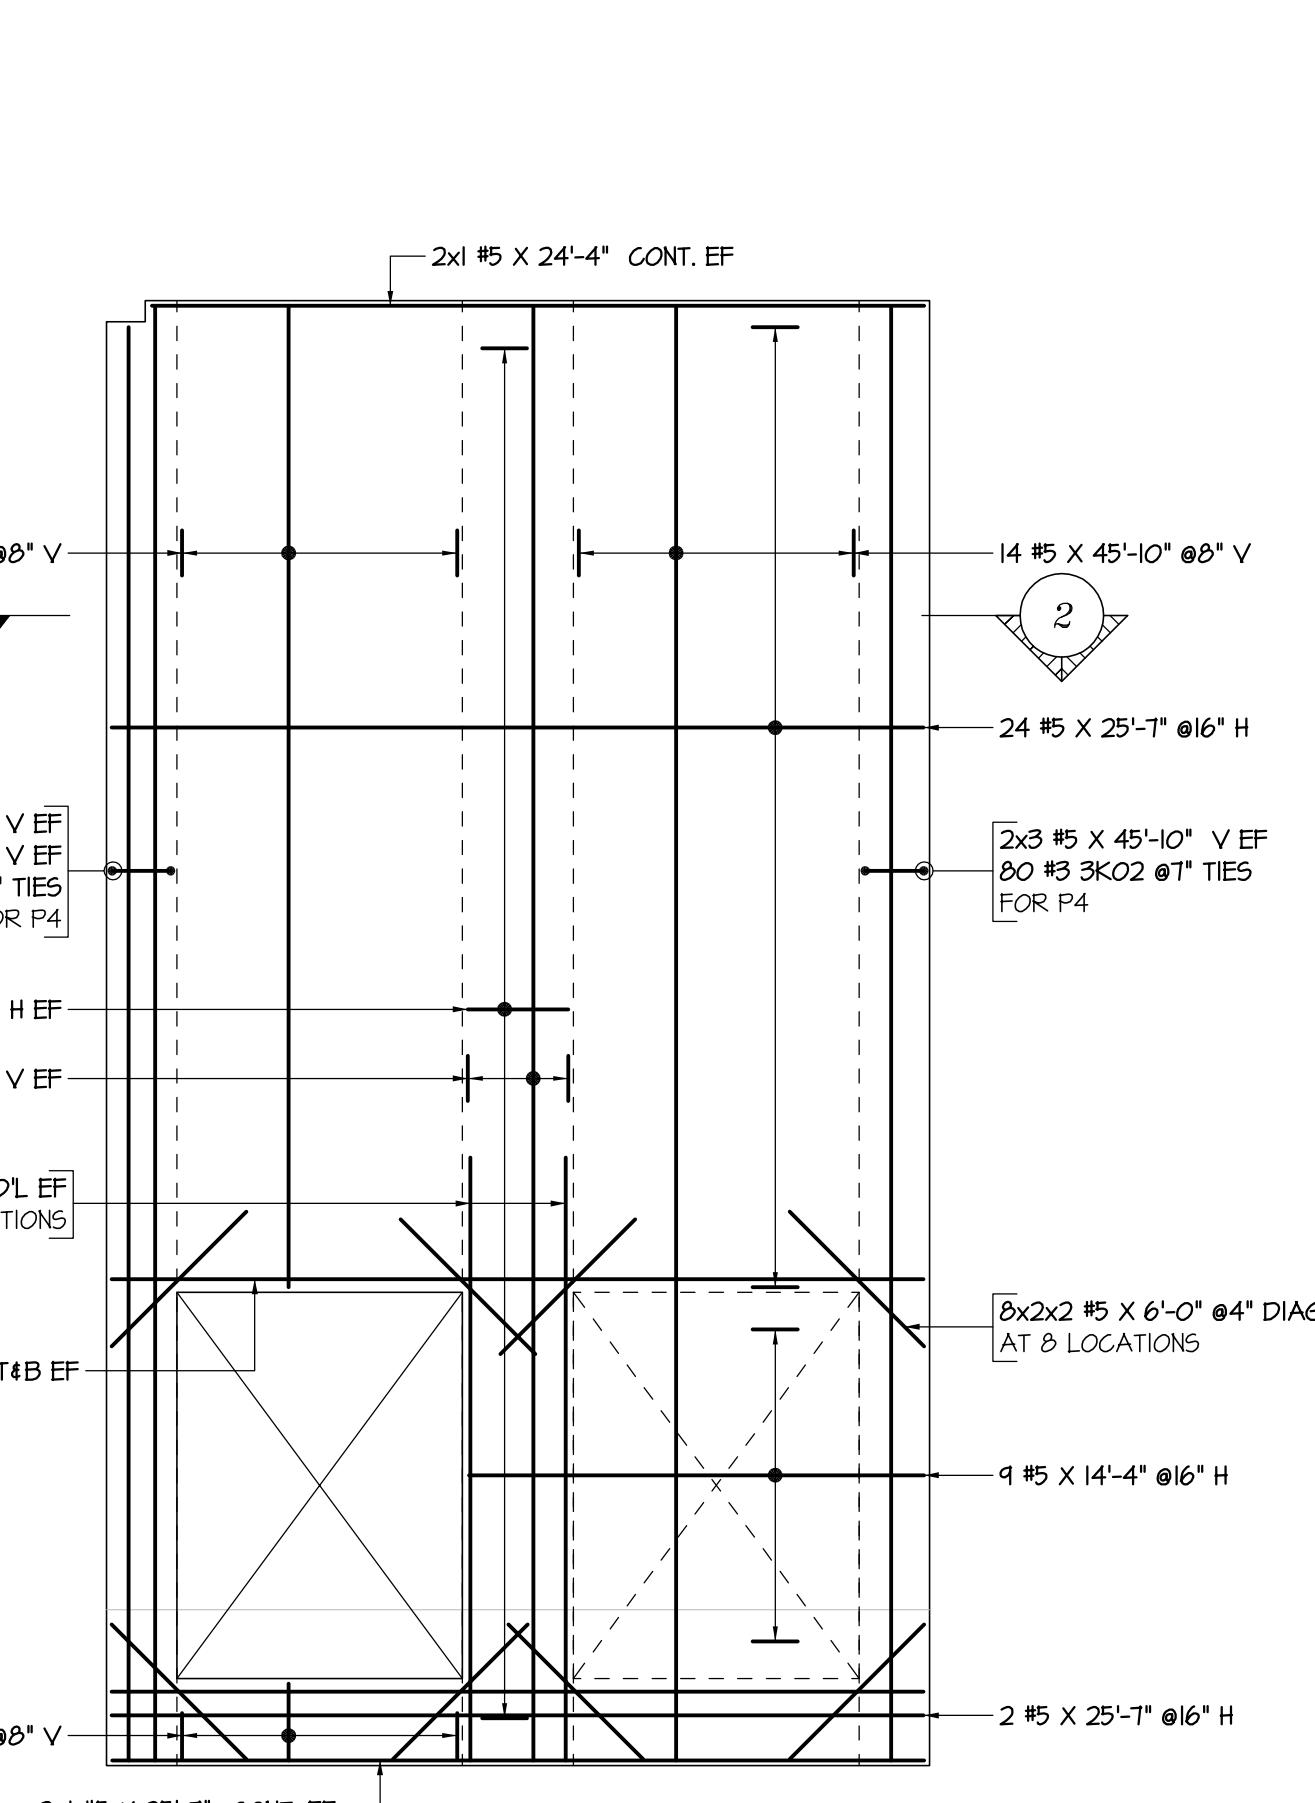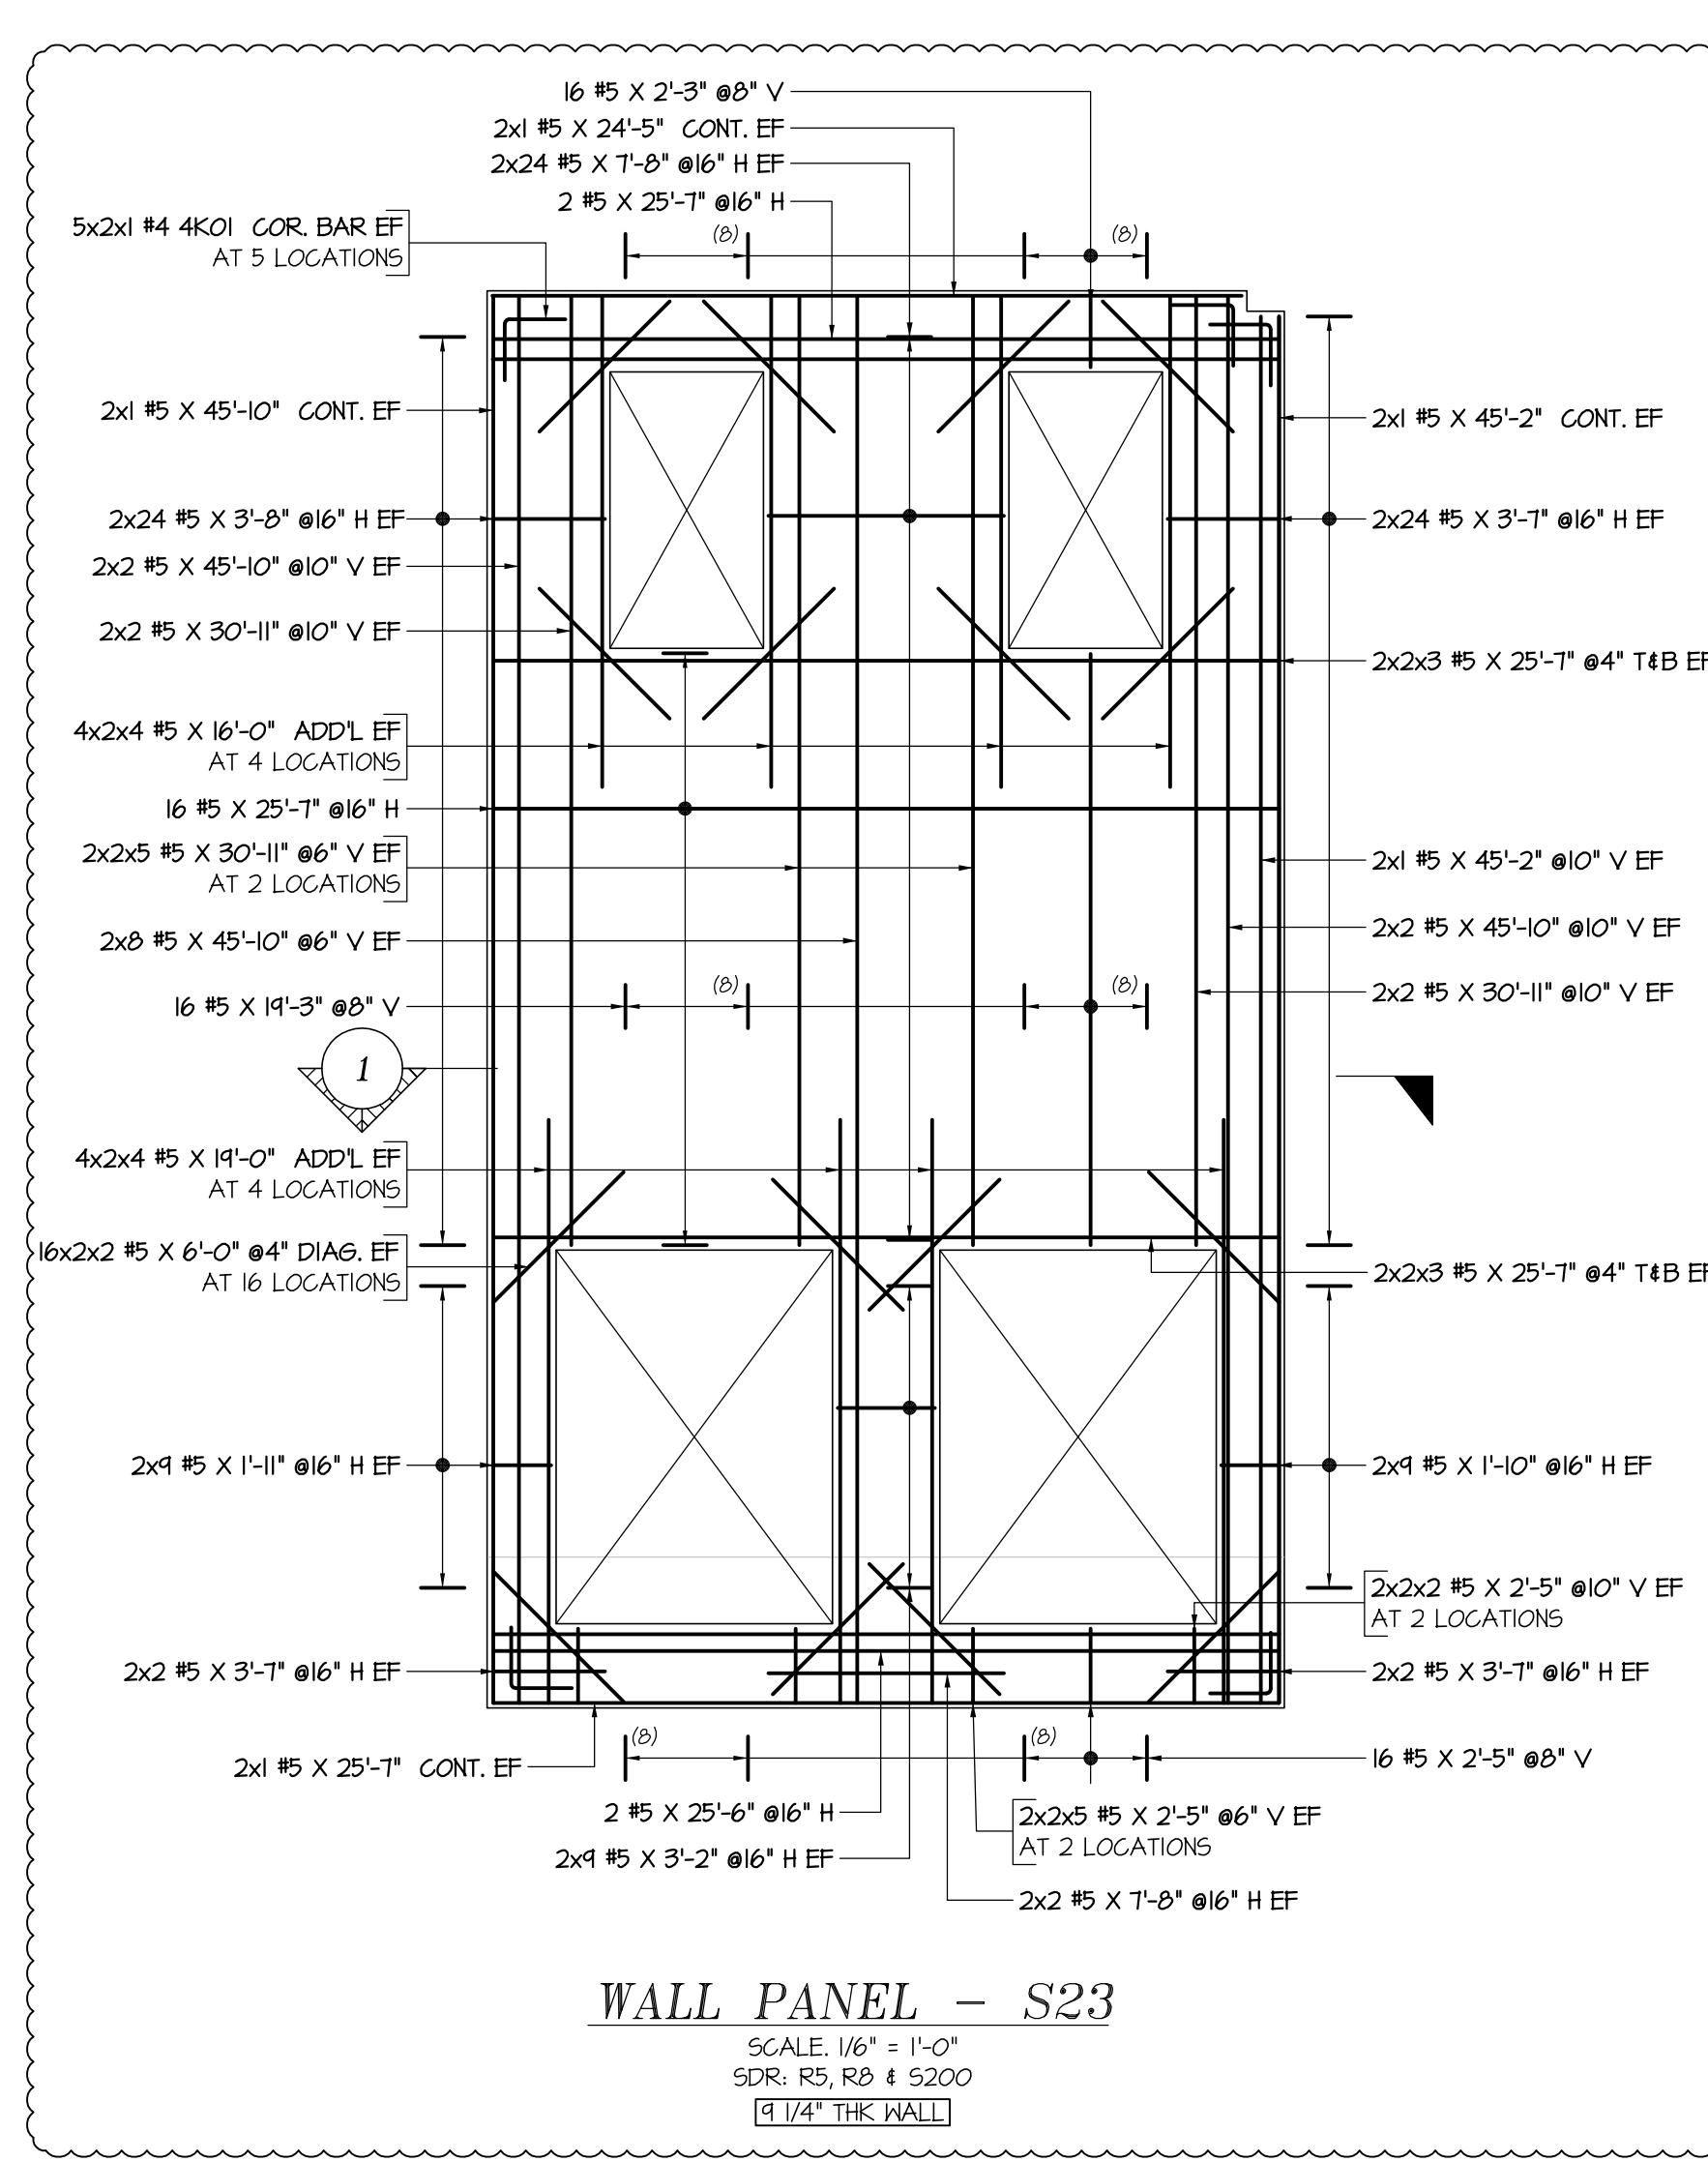



STRUCTURAL NOTES	
LEGENDS	LABEL LEGENDS
T - TOP B - BOTTOM V - VERT H - HORIZ CLR - CLEAR COVER SIM - SIMILAR TYP - TYPICAL T.O.MAT - TOP OF MAT ES - EACH SIDE EF - EACH FACE CONT - CONTINUOUS COR - CORNER THK - THICKNESS ADDL - ADDITIONAL DIAG - DIAGONAL NTS - NOT TO SCALE C - CENTER LINE SDR - STRUCTURAL DRAWING REFERENCE	6x2x6 #4 4C09 @12" B2 NOTES SPACING BAR MARK BAR SIZE NUMBER OF BARS EACH FACE/EACH SIDE NUMBER OF LOCATIONS DENOTES OPENINGS DENOTES KNOCK OUTS CLEAR COVER TO REINFORCEMENT 2" AT ENDS 1 1/2" #5 4 BELOW EXTERIOR FACE 2" #6 4 ABOVE EXTERIOR FACE 3/4" AT INTERIOR FACE
	WALL PANEL
	Drawing Sheet : R-21
	BENDING DETAILS
	Bar Mark Qty Size Total Length Type 'A' 'B' 'C' 'D' 'E' 'F' 'G' 'H' 'I' 'J'
	3K02 48# 3 5'-7" X 11' 0"-4" X 1'-10" X 0'-7" 1'-10" X 0'-7" 0'-4" X
	4K01 4# 4# 4'-0" 17 2'-0" 2'-0"
	T1 Hooks A & G optional 17




SOUTH WALL PANELS PLACING DRAWING REFERENCE	
DWG.NO:	DRAWING DESCRIPTION
R-18	SOUTH WALL PANELS S-1 TO S-8
R-19	SOUTH WALL PANELS S-9 TO S-15
R-20	SOUTH WALL PANELS S-16 TO S-22
R-21	SOUTH WALL PANELS N-23 TO N-30
R-22	SOUTH WALL PANELS N-31 TO N-37
R-23	SOUTH WALL PANELS N-38 TO N-44
R-24	SOUTH WALL PANELS N-45 TO N-51
R-25	SOUTH WALL PANELS N-52 TO N-58
R-26	SOUTH WALL PANELS N-59 TO N-66
R-27	SOUTH WALL PANELS N-67 TO N-73
R-28	SOUTH WALL PANELS N-74 TO N-80

REINFORCING STEEL PLACING DRAWING ONLY. USE IN CONJUNCTION WITH CONTRACT DRAWINGS & SPECIFICATIONS. ELEVATIONS & DIMENSIONS SHOWN ON THIS DRAWING ARE FOR DETAILING PURPOSES ONLY AND SHOULD NOT BE USED FOR CONSTRUCTION UNLESS VERIFIED BY ENGINEER OR CONTRACTOR.

7	
6	
5	
4	
3	
2	06.14.2019 RE SUBMITTED FOR APPROVAL
1	05.29.2019 APPROVAL DATE SENT FOR

RE-STEEL SUPPLY CO., INC. REINFORCING STEEL - WIRE MESH 2000 Eddystone Industrial Park • Eddystone, PA 19022-1588 Phone: 800-876-8216 Fax: 610-876-8428
Structure VALLEY VIEW BUSINESS PARK TILT PANELS
Location JESSUP,PA
Architect KSS ARCHITECTS
Engineer RICHARD ADAMS
Customer T&T CONSTRUCTION
Made by: PRO Date: 05.29.2019 CONTRACT NO. U2524
DRAWING COVERS SOUTH WALL PANELS S-23 TO S-30 DRAWING NO. R-21
REV. NO. DATE DESCRIPTION
06.14.2019 REVISED AS PER LATEST CDS RECEIVED ON 05.31.19

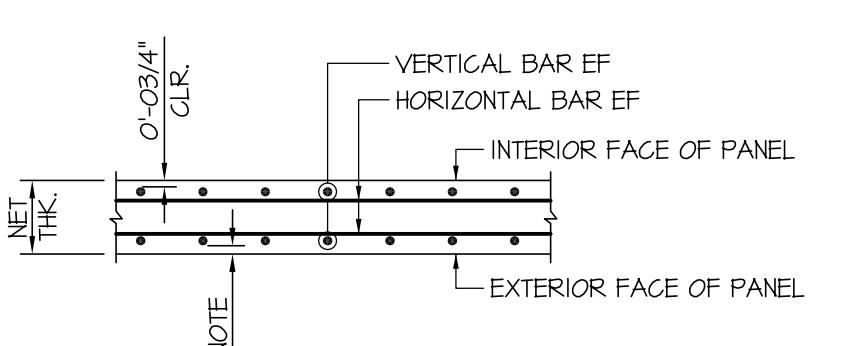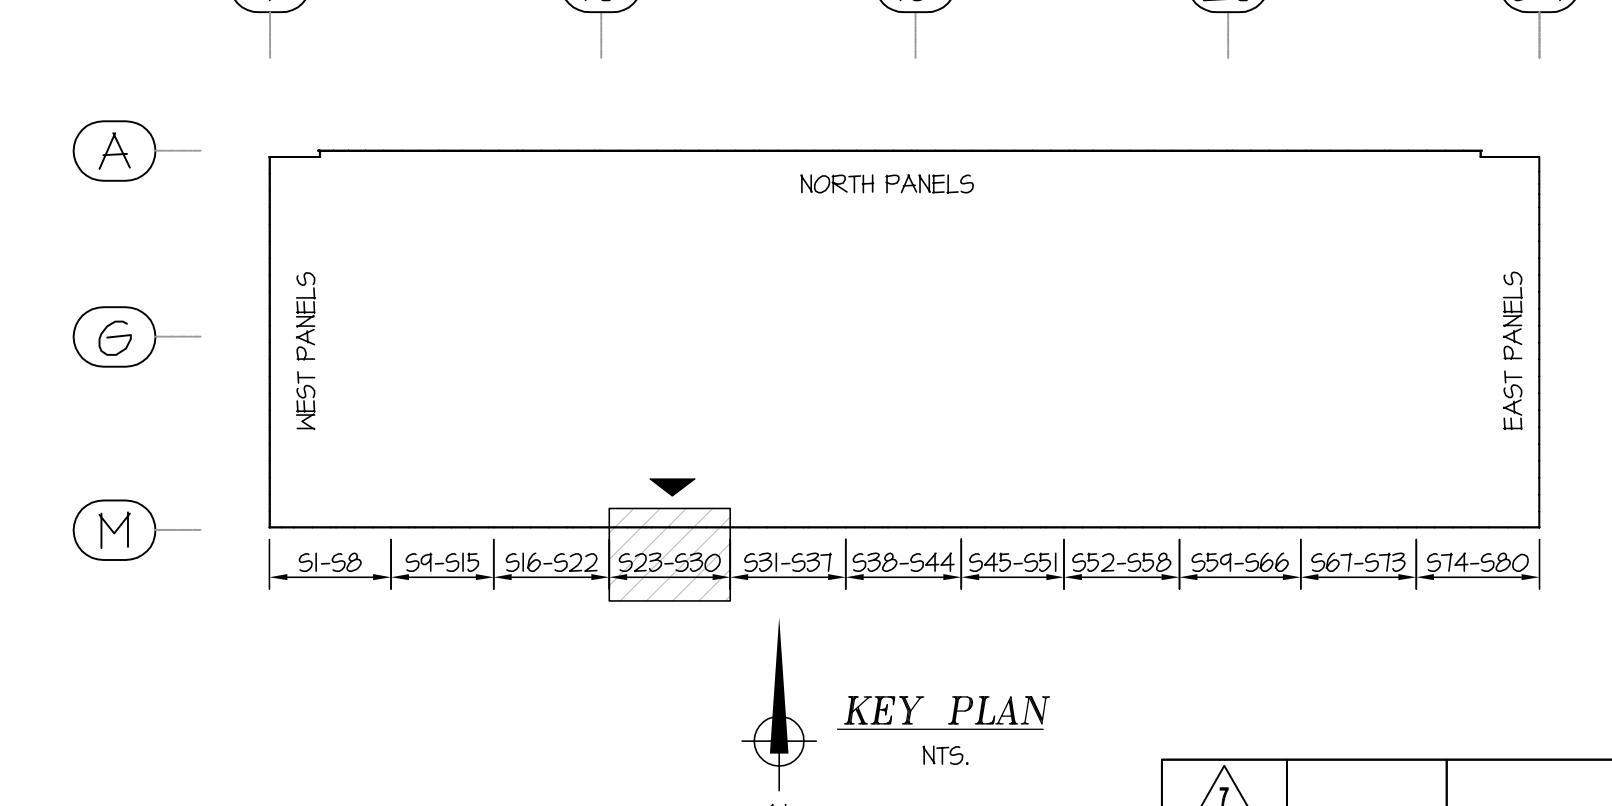

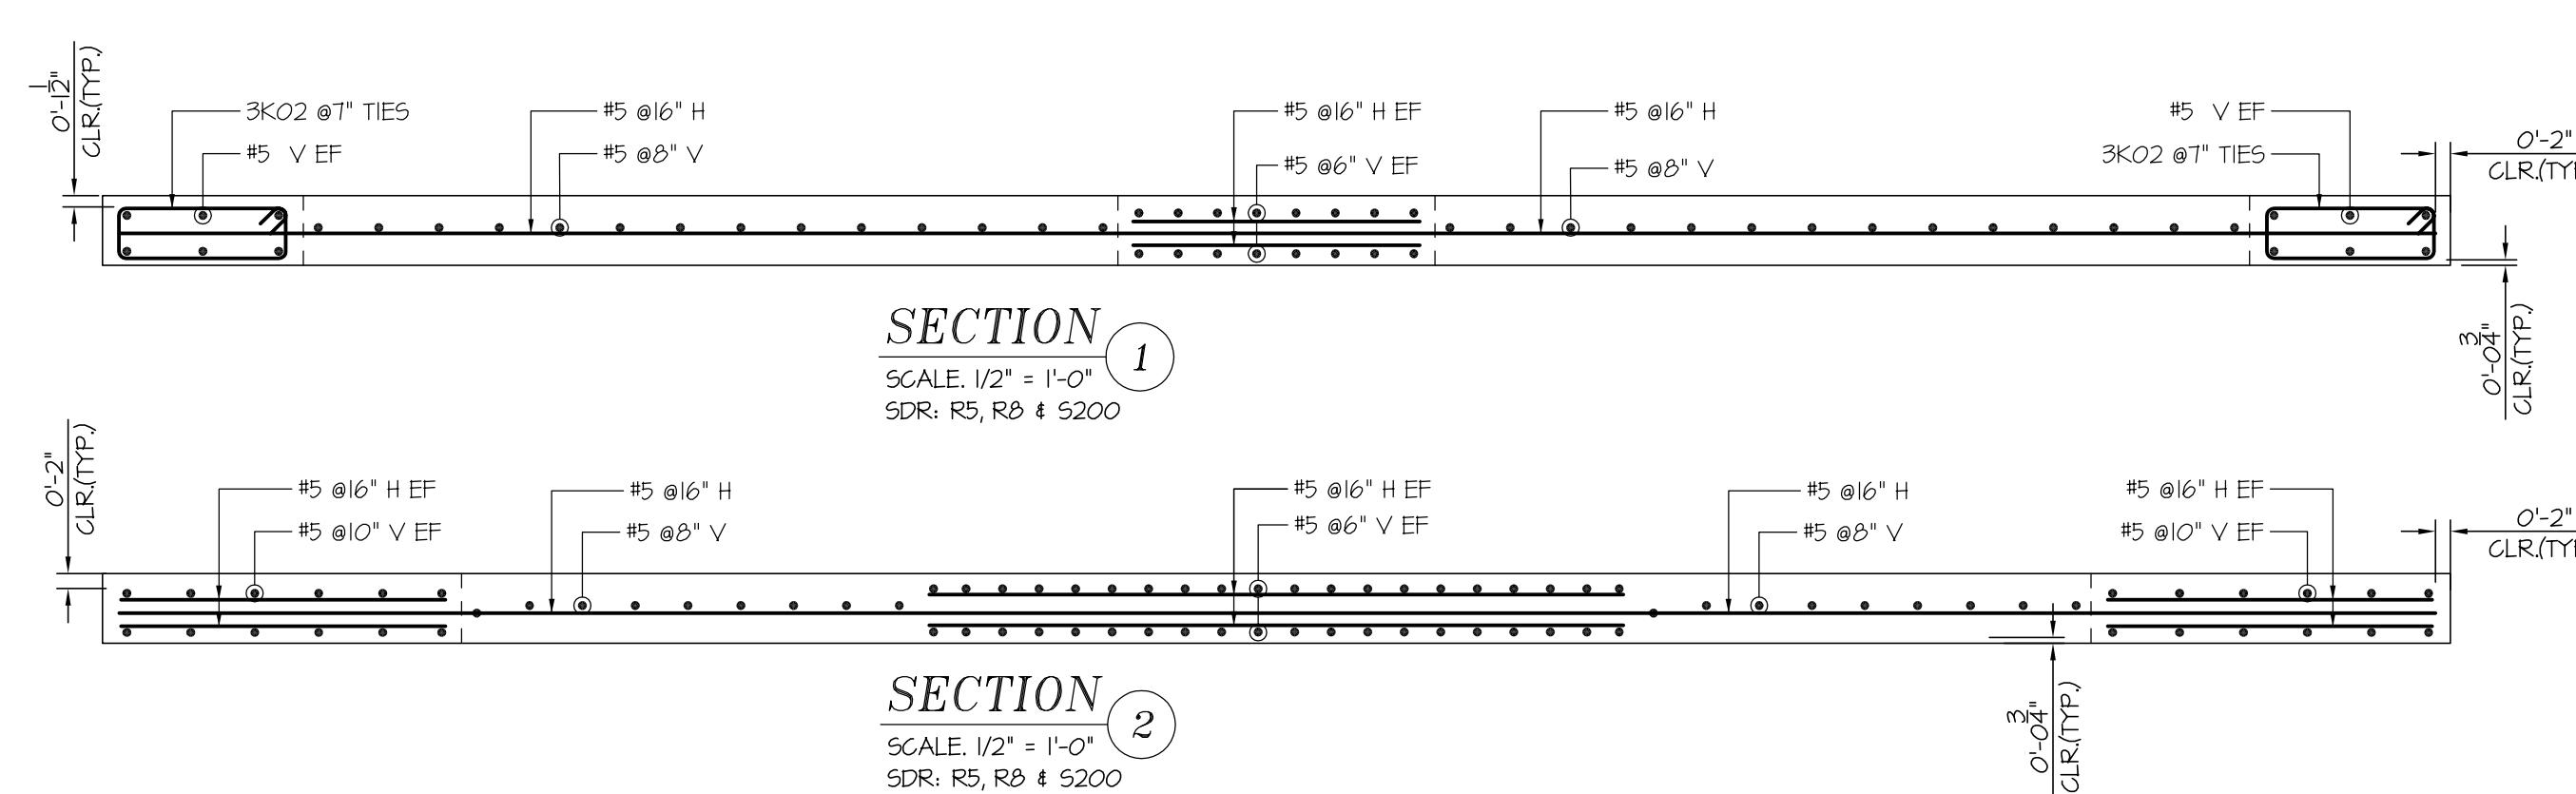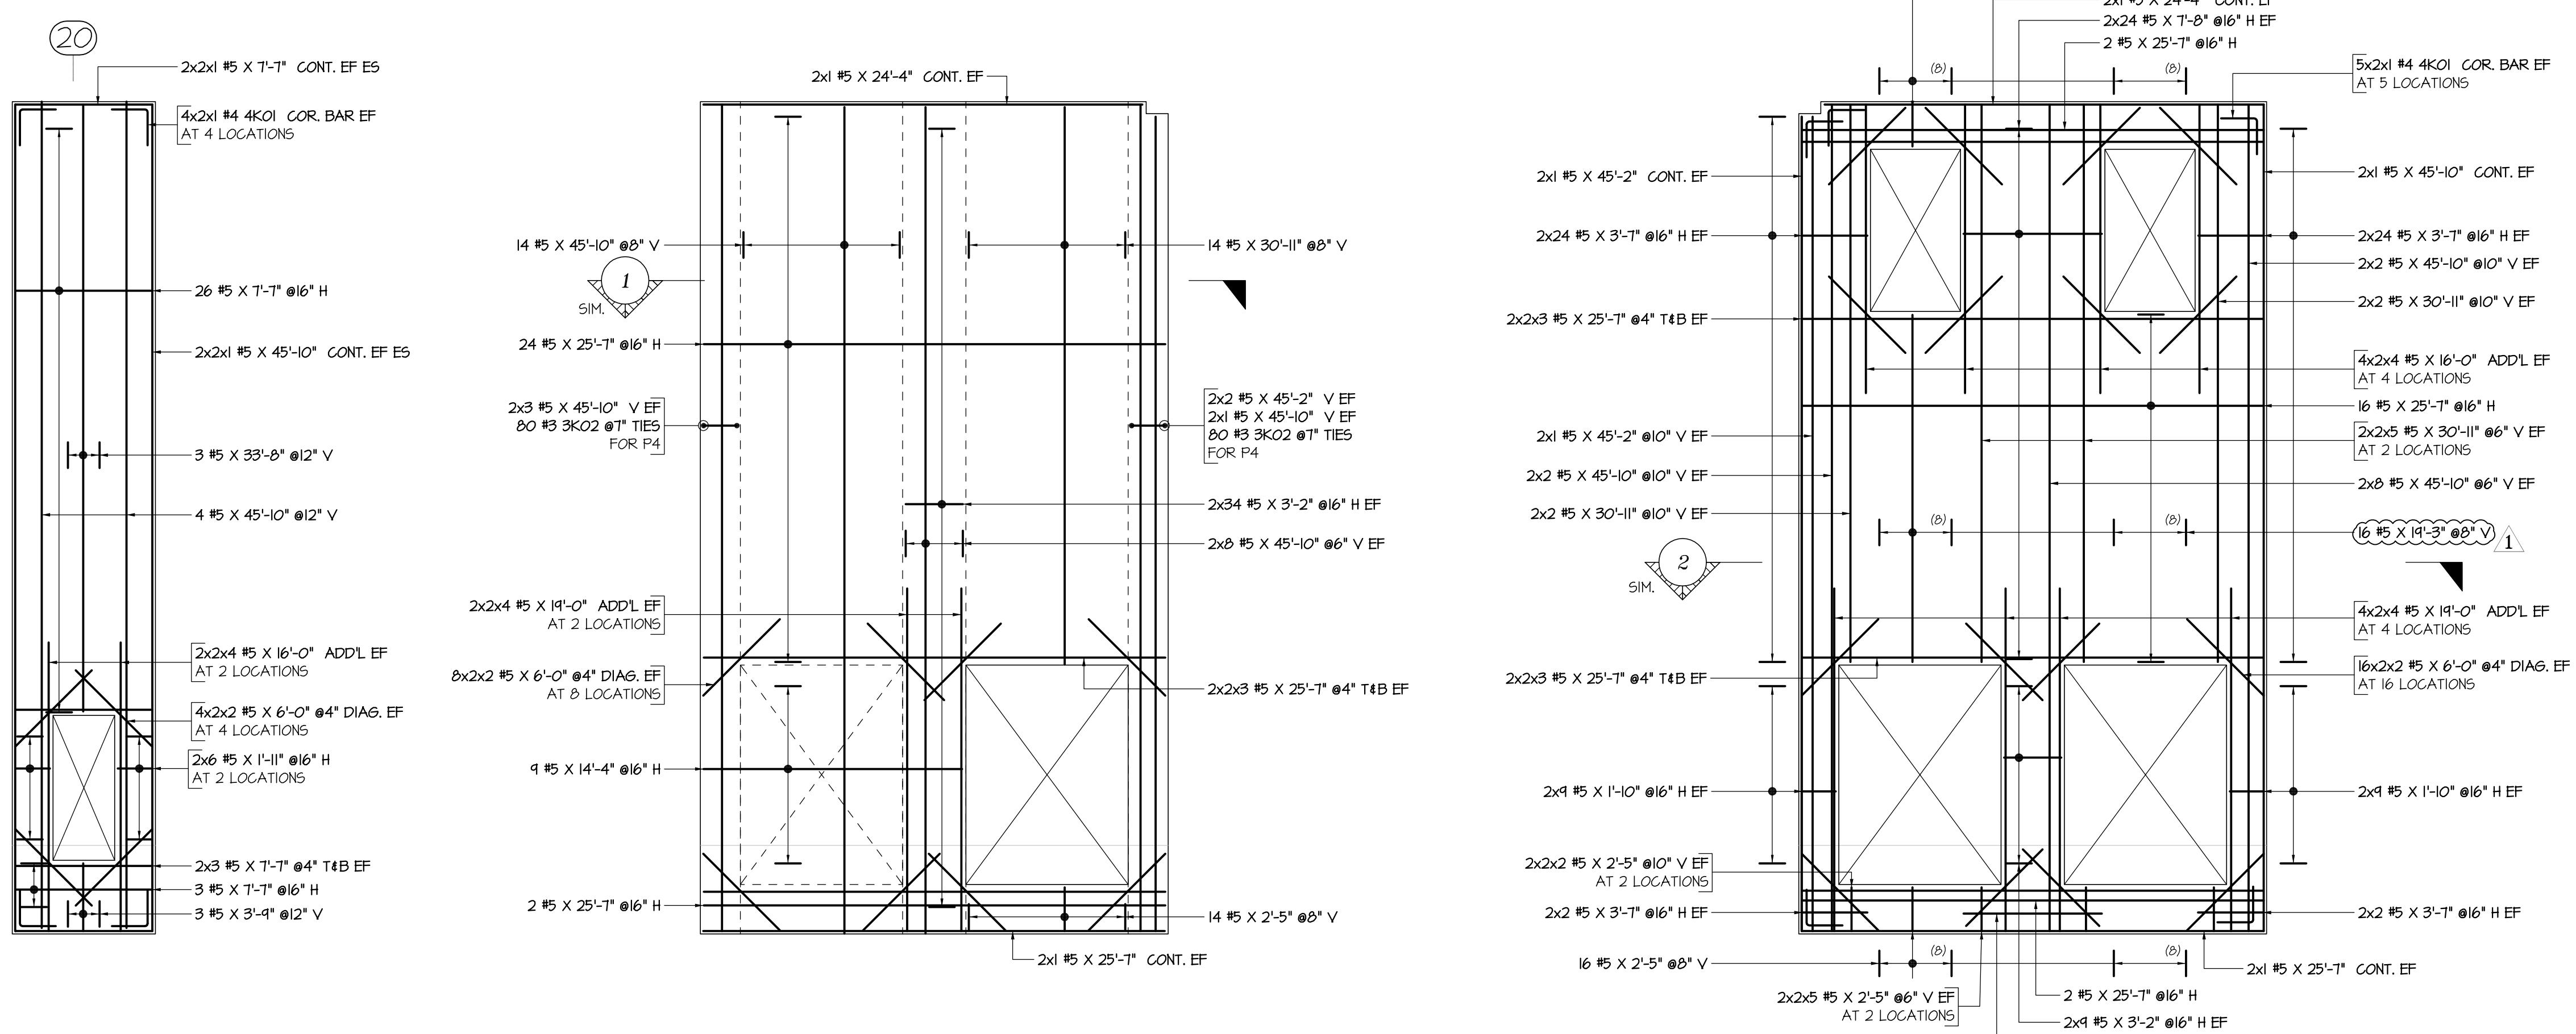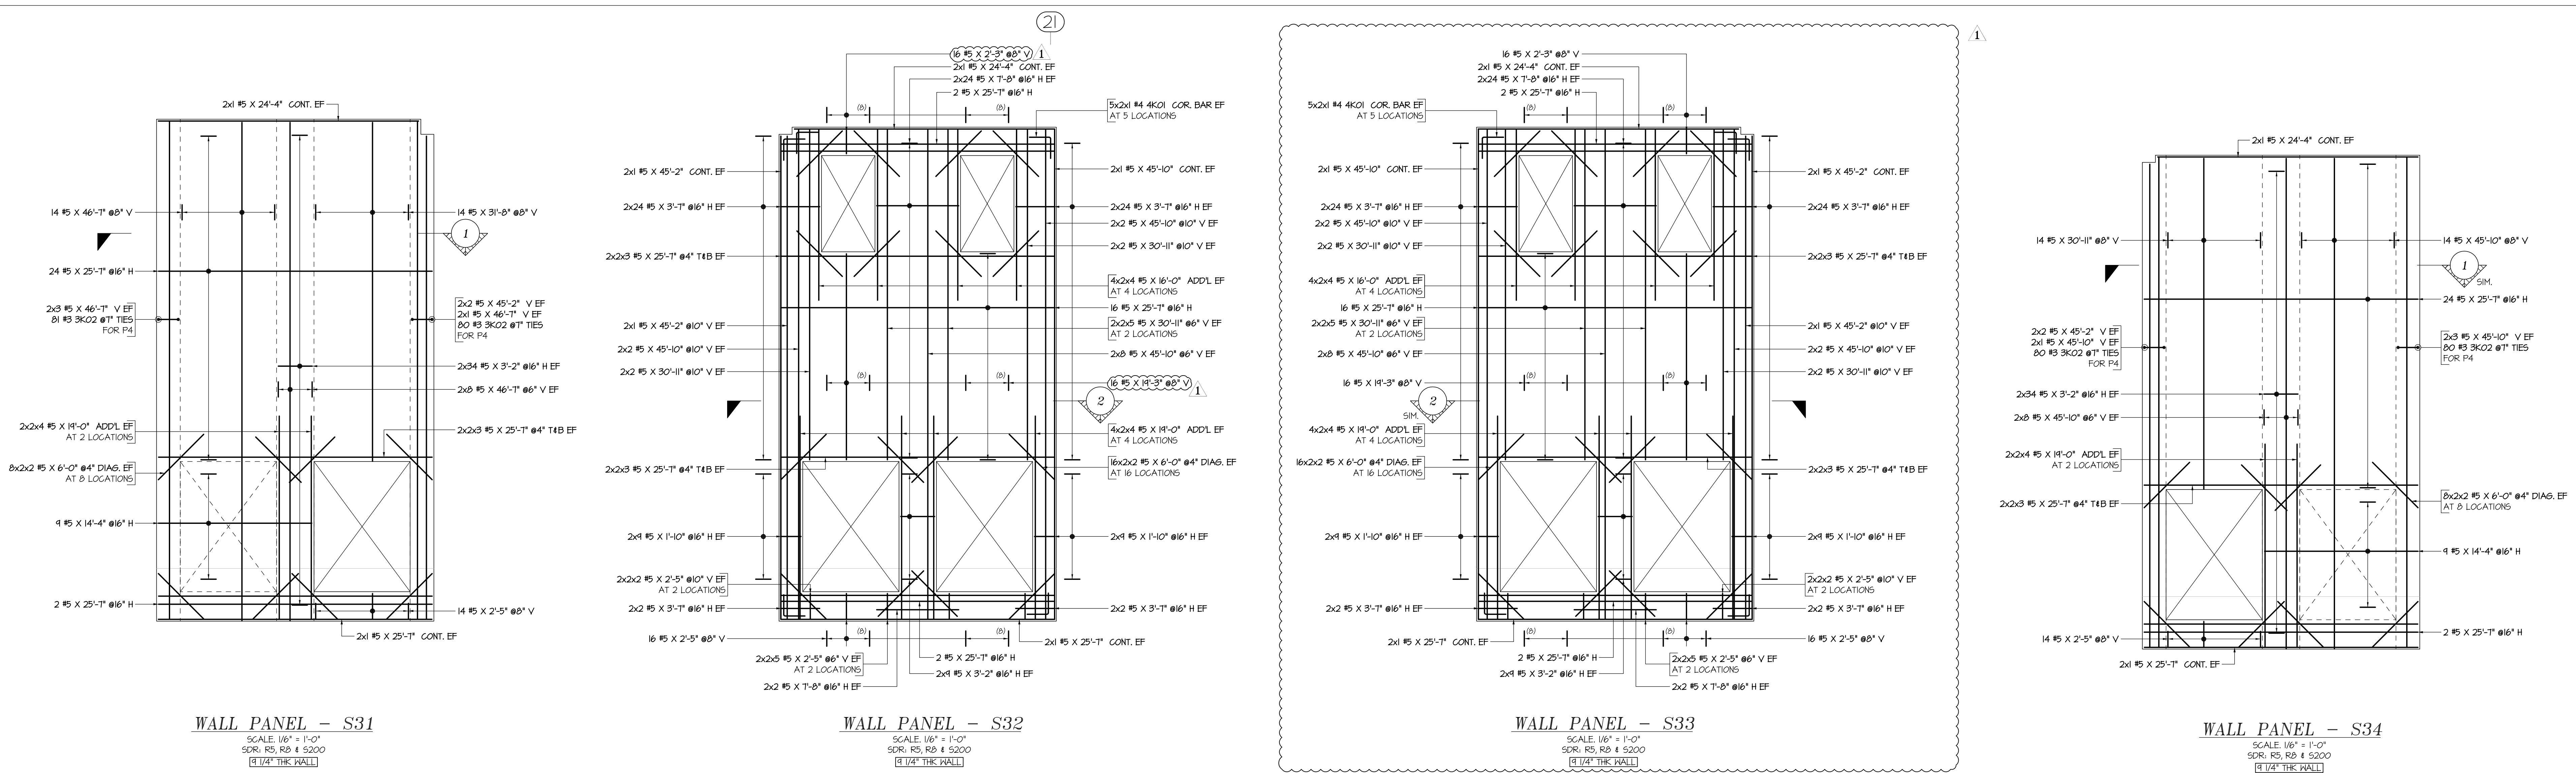

STRUCTURAL NOTES




LEGENDS	LABEL LEGENDS												
T - TOP B - BOTTOM V, VERT - VERTICAL H, HORIZ - HORIZONTAL CLR. - CLEAR COVER SIM. - SIMILAR TYP. - TYPICAL T.O.MAT - TOP OF MAT ES - EACH SIDE EF - EACH FACE CONT - CONTINUOUS COR. - CORNER THK. - THICKNESS ADD'L - ADDITIONAL DIAG. - DIAGONAL NTS - NOT TO SCALE ¢ - CENTER LINE SDR - STRUCTURAL DRAWING REFERENCE	<p>6x2x6 #4 4C09 @12" B2</p> <p>NOTES SPACING BAR MARK BAR SIZE NUMBER OF BARS EACH FACE/EACH SIDE NUMBER OF LOCATION</p> <p>DENOTES OPENINGS</p> <p>DENOTES KNOCK OUTS</p> <p>CLEAR COVER TO REINFORCEMENT</p> <table border="1"> <thead> <tr> <th>WALL PANEL</th> <th>2"</th> <th>AT ENDS</th> </tr> </thead> <tbody> <tr> <td></td> <td>1 1/2"</td> <td>#5 \$ BELOW AT EXTERIOR FACE</td> </tr> <tr> <td></td> <td>2"</td> <td>#6 \$ ABOVE AT EXTERIOR FACE</td> </tr> <tr> <td></td> <td>3 1/4"</td> <td>AT INTERIOR FACE</td> </tr> </tbody> </table>	WALL PANEL	2"	AT ENDS		1 1/2"	#5 \$ BELOW AT EXTERIOR FACE		2"	#6 \$ ABOVE AT EXTERIOR FACE		3 1/4"	AT INTERIOR FACE
WALL PANEL	2"	AT ENDS											
	1 1/2"	#5 \$ BELOW AT EXTERIOR FACE											
	2"	#6 \$ ABOVE AT EXTERIOR FACE											
	3 1/4"	AT INTERIOR FACE											

STRUCTURAL DRAWING SYMBOLS AND TERMS

- Dimensions:** (8) indicates a length of 8 units.
- Reinforcement:**
 - 2x1 #5 X 24'-4" CONT. EF
 - 2x24 #5 X 7'-8" @16" H EF
 - 2 #5 X 25'-7" @16" H
 - 5x2x1 #4 4K01 COR. BAR EF AT 5 LOCATIONS
 - 2x1 #5 X 45'-10" CONT. EF
 - 2x24 #5 X 3'-7" @16" H EF
 - 2x2 #5 X 45'-10" @10" V EF
 - 2x2 #5 X 30'-11" @10" V EF
 - 4x2x4 #5 X 16'-0" ADD'L EF AT 4 LOCATIONS
 - 16 #5 X 25'-7" @16" H
 - 2x2x5 #5 X 30'-11" @6" V EF AT 2 LOCATIONS
 - 2x8 #5 X 45'-10" @6" V EF
 - 16 #5 X 19'-3" @8" V 1
 - 4x2x4 #5 X 19'-0" ADD'L EF AT 4 LOCATIONS
- Openings:** Indicated by a square with diagonal lines.
- Knock Outs:** Indicated by a square with dashed lines.
- Labels:** Indicate specific reinforcement details like "5x2x1 #4 4K01 COR. BAR EF AT 5 LOCATIONS".
- Notes:** Indicate clear cover requirements like "2" at ends, "1 1/2" below exterior face, "2" above exterior face, and "3 1/4" at interior face.
- Spacings:** Indicate the distance between bars like "6x2x6 #4 4C09 @12" B2".
- Bar Marks:** Indicate the type of bar like "T" for top or "EF" for each face.
- Bar Sizes:** Indicate the size of the bars like "#4 4C09".
- Number of Bars:** Indicate the number of bars like "6x2x6".
- Each Face/Each Side:** Indicate the placement of bars like "B2".
- Number of Locations:** Indicate the number of locations for a bar like "5 LOCATIONS".
- Top of Mat:** Indicate the top surface of the concrete mat.
- Each Side:** Indicate the placement of bars on both sides of a vertical element.
- Each Face:** Indicate the placement of bars on both faces of a horizontal element.
- Continuous:** Indicate bars that span multiple sections.
- Corner:** Indicate corner reinforcement.
- Thickness:** Indicate the thickness of the concrete.
- Additional:** Indicate extra reinforcement.
- Diagonal:** Indicate diagonal reinforcement.
- Not to Scale:** Indicate the drawing is not to scale.
- Center Line:** Indicate a center line for symmetry.
- Structural Drawing Reference:** Indicate reference to structural drawing SDR.

<u>SOUTH WALL PANELS</u> <u>PLACING DRAWING REFERENCE</u>	
DWG.NO:	DRAWING DESCRIPTION
R-18	SOUTH WALL PANELS S-1 TO S-8
R-19	SOUTH WALL PANELS S-9 TO S-15
R-20	SOUTH WALL PANELS S-16 TO S-22
R-21	SOUTH WALL PANELS N-23 TO N-30
R-22	SOUTH WALL PANELS N-31 TO N-37
R-23	SOUTH WALL PANELS N-38 TO N-44
R-24	SOUTH WALL PANELS N-45 TO N-51
R-25	SOUTH WALL PANELS N-52 TO N-58
R-26	SOUTH WALL PANELS N-59 TO N-66
R-27	SOUTH WALL PANELS N-67 TO N73
R-28	SOUTH WALL PANELS N-74 TO N-80

REINFORCING STEEL PLACING DRAWING ONLY. USE IN CONJUNCTION WITH CONTRACT DRAWINGS & SPECIFICATIONS. ELEVATIONS & DIMENSIONS SHOWN ON THIS DRAWING ARE FOR DETAILING PURPOSES ONLY AND SHOULD NOT BE USED FOR CONSTRUCTION UNLESS VERIFIED BY ENGINEER OR CONTRACTOR.

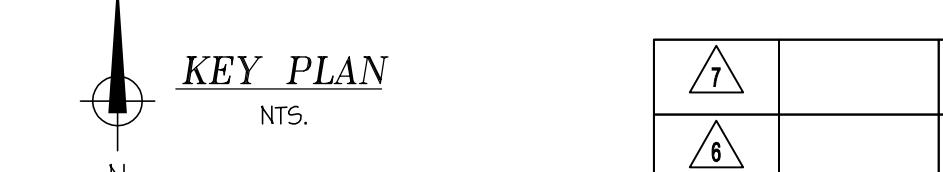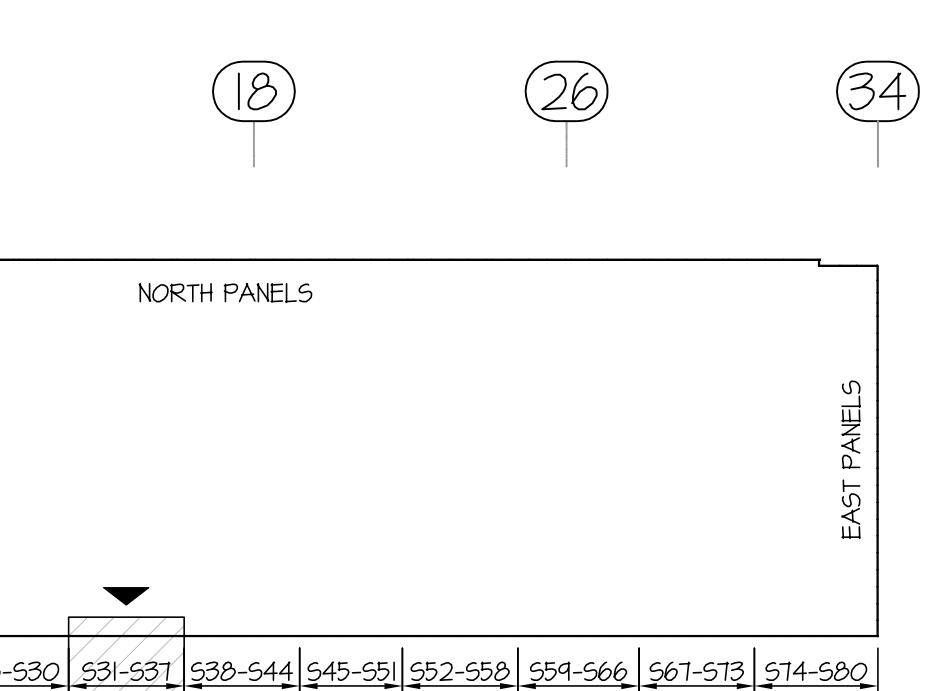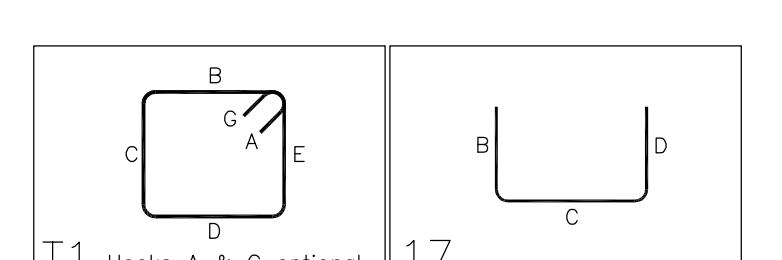


06.14.2019	RE SUBMITTED FOR APPROVAL
05.29.2019	APPROVAL

2000 Eddystone Industrial Park • Eddystone, PA 19022-1588
Phone: 800-876-8216 • Fax: 610-876-8428

Location	JESSUP,PA
Architect	KSS ARCHITECTS
Engineer	RICHARD ADAMS

Customer	RICHARD ADAMS T&T CONSTRUCTION
Created by:	Date: 05.29.2019

DRAWING COVERS SOUTH WALL PANELS S-31 TO S-37	DRAWING NO. R-22 □
--	------------------------------

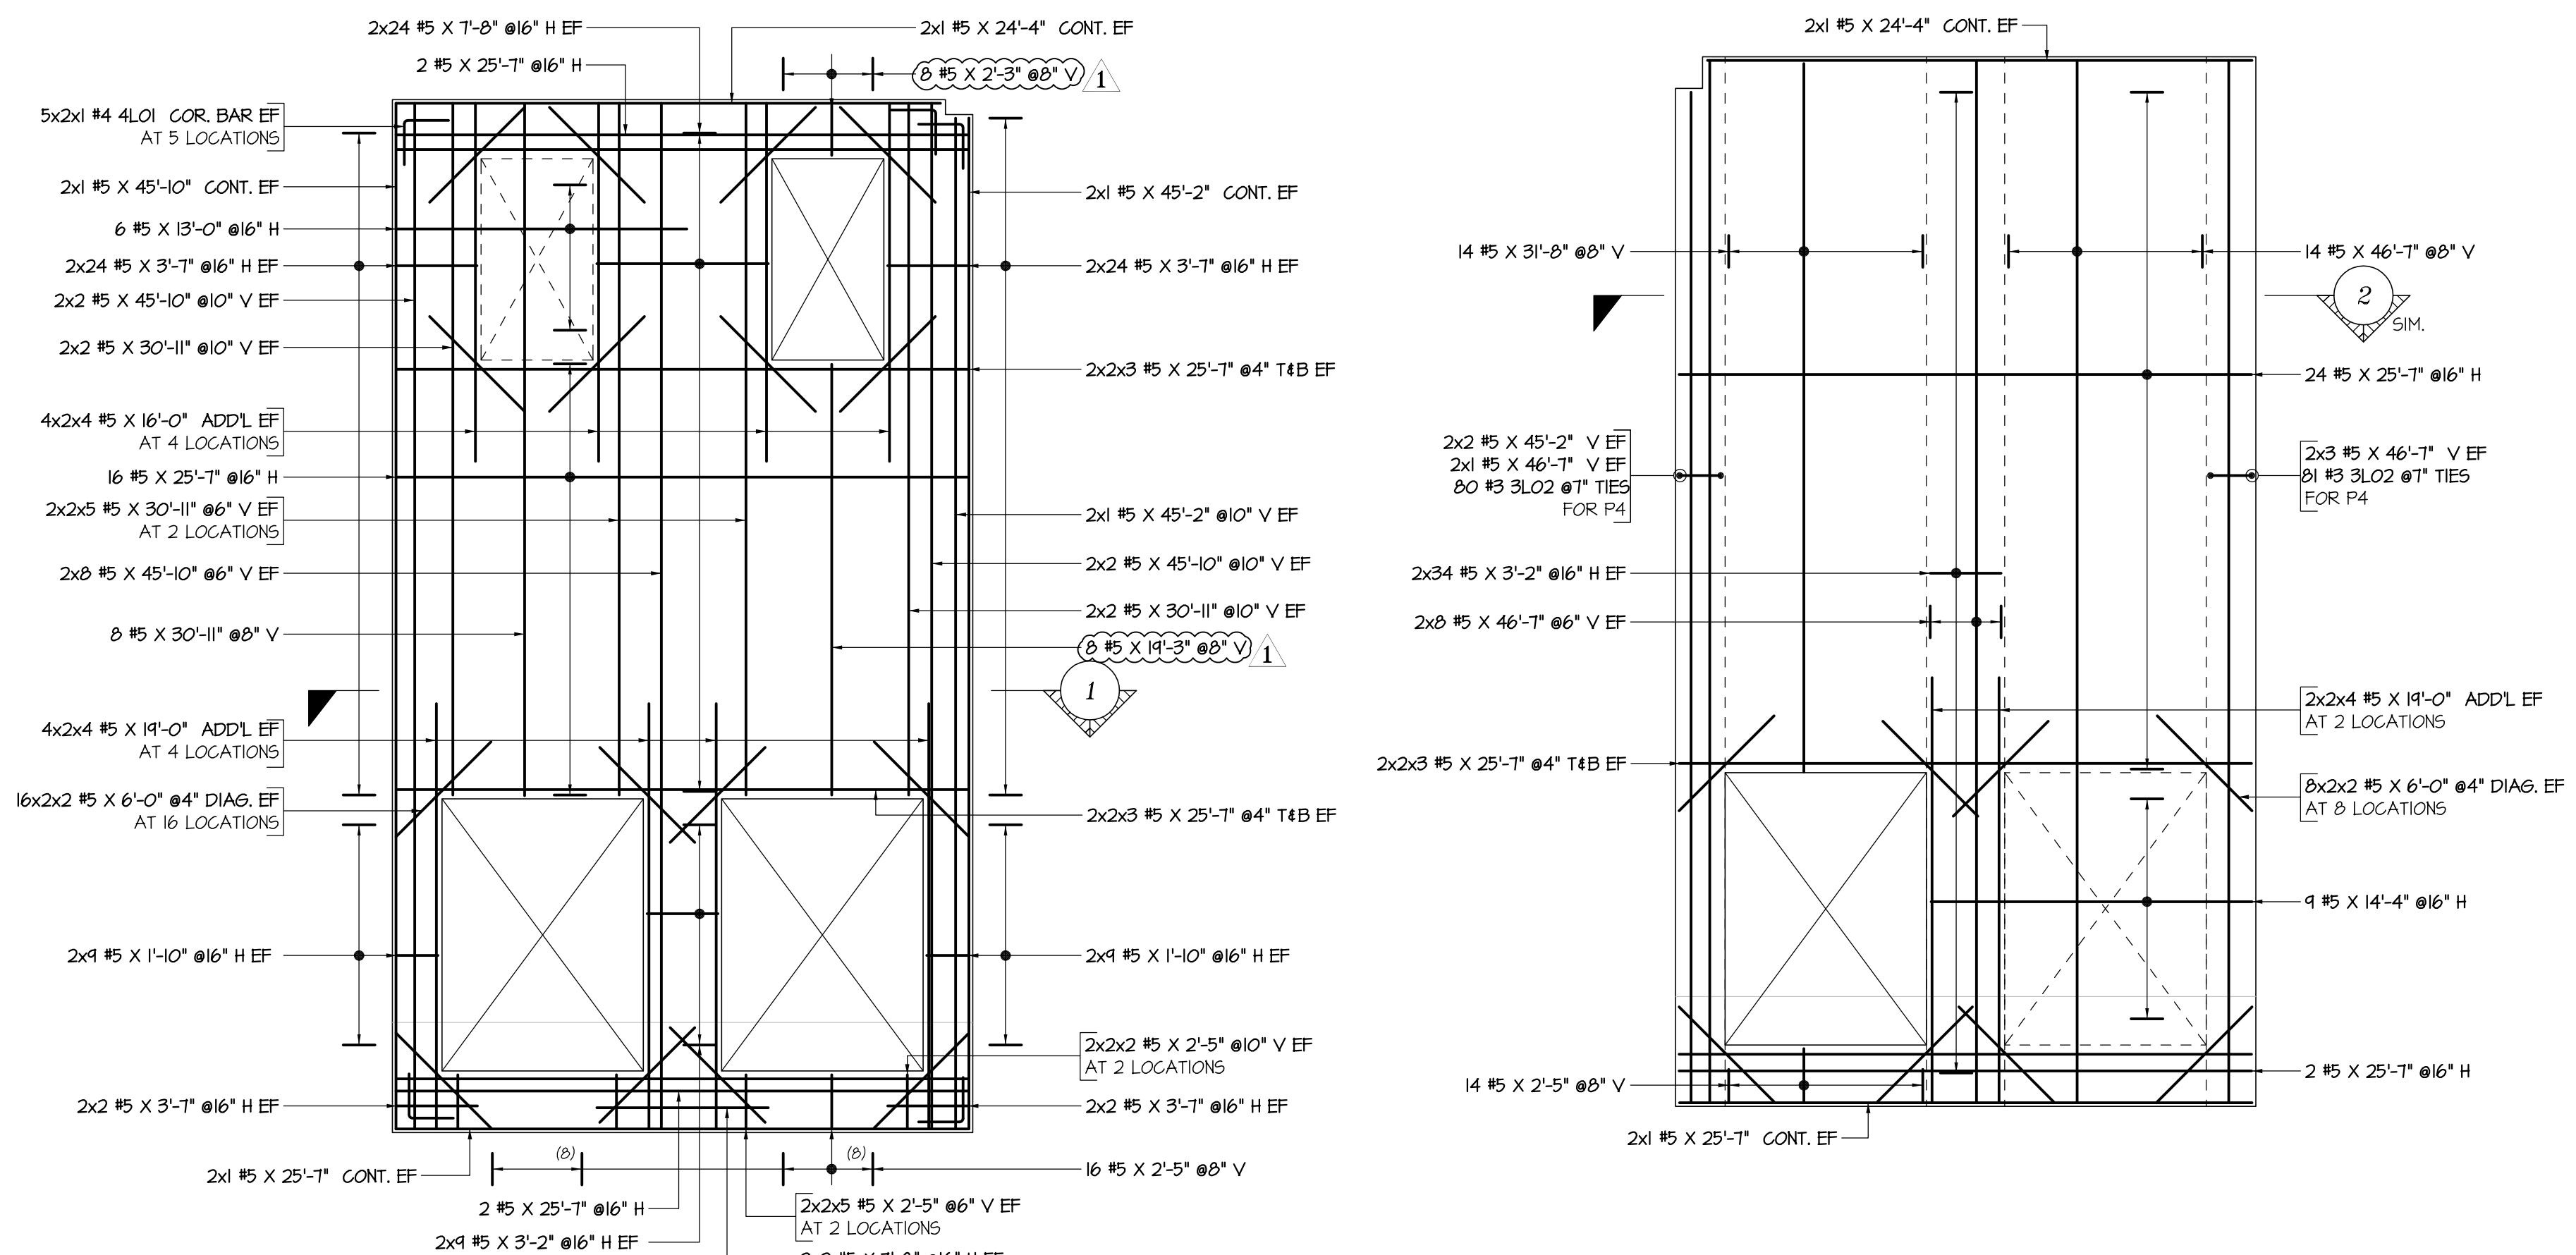


WALL PANEL - S39

SCALE: 1/6" = 1'-0"
SDR: R5, R8 & S200
4 1/4" THK WALL

WALL PANEL - S40


WALL PANEL - S41

SCALE: 1/6" = 1'-0"
SDR: R5, R8 & S200
4 1/4" THK WALL

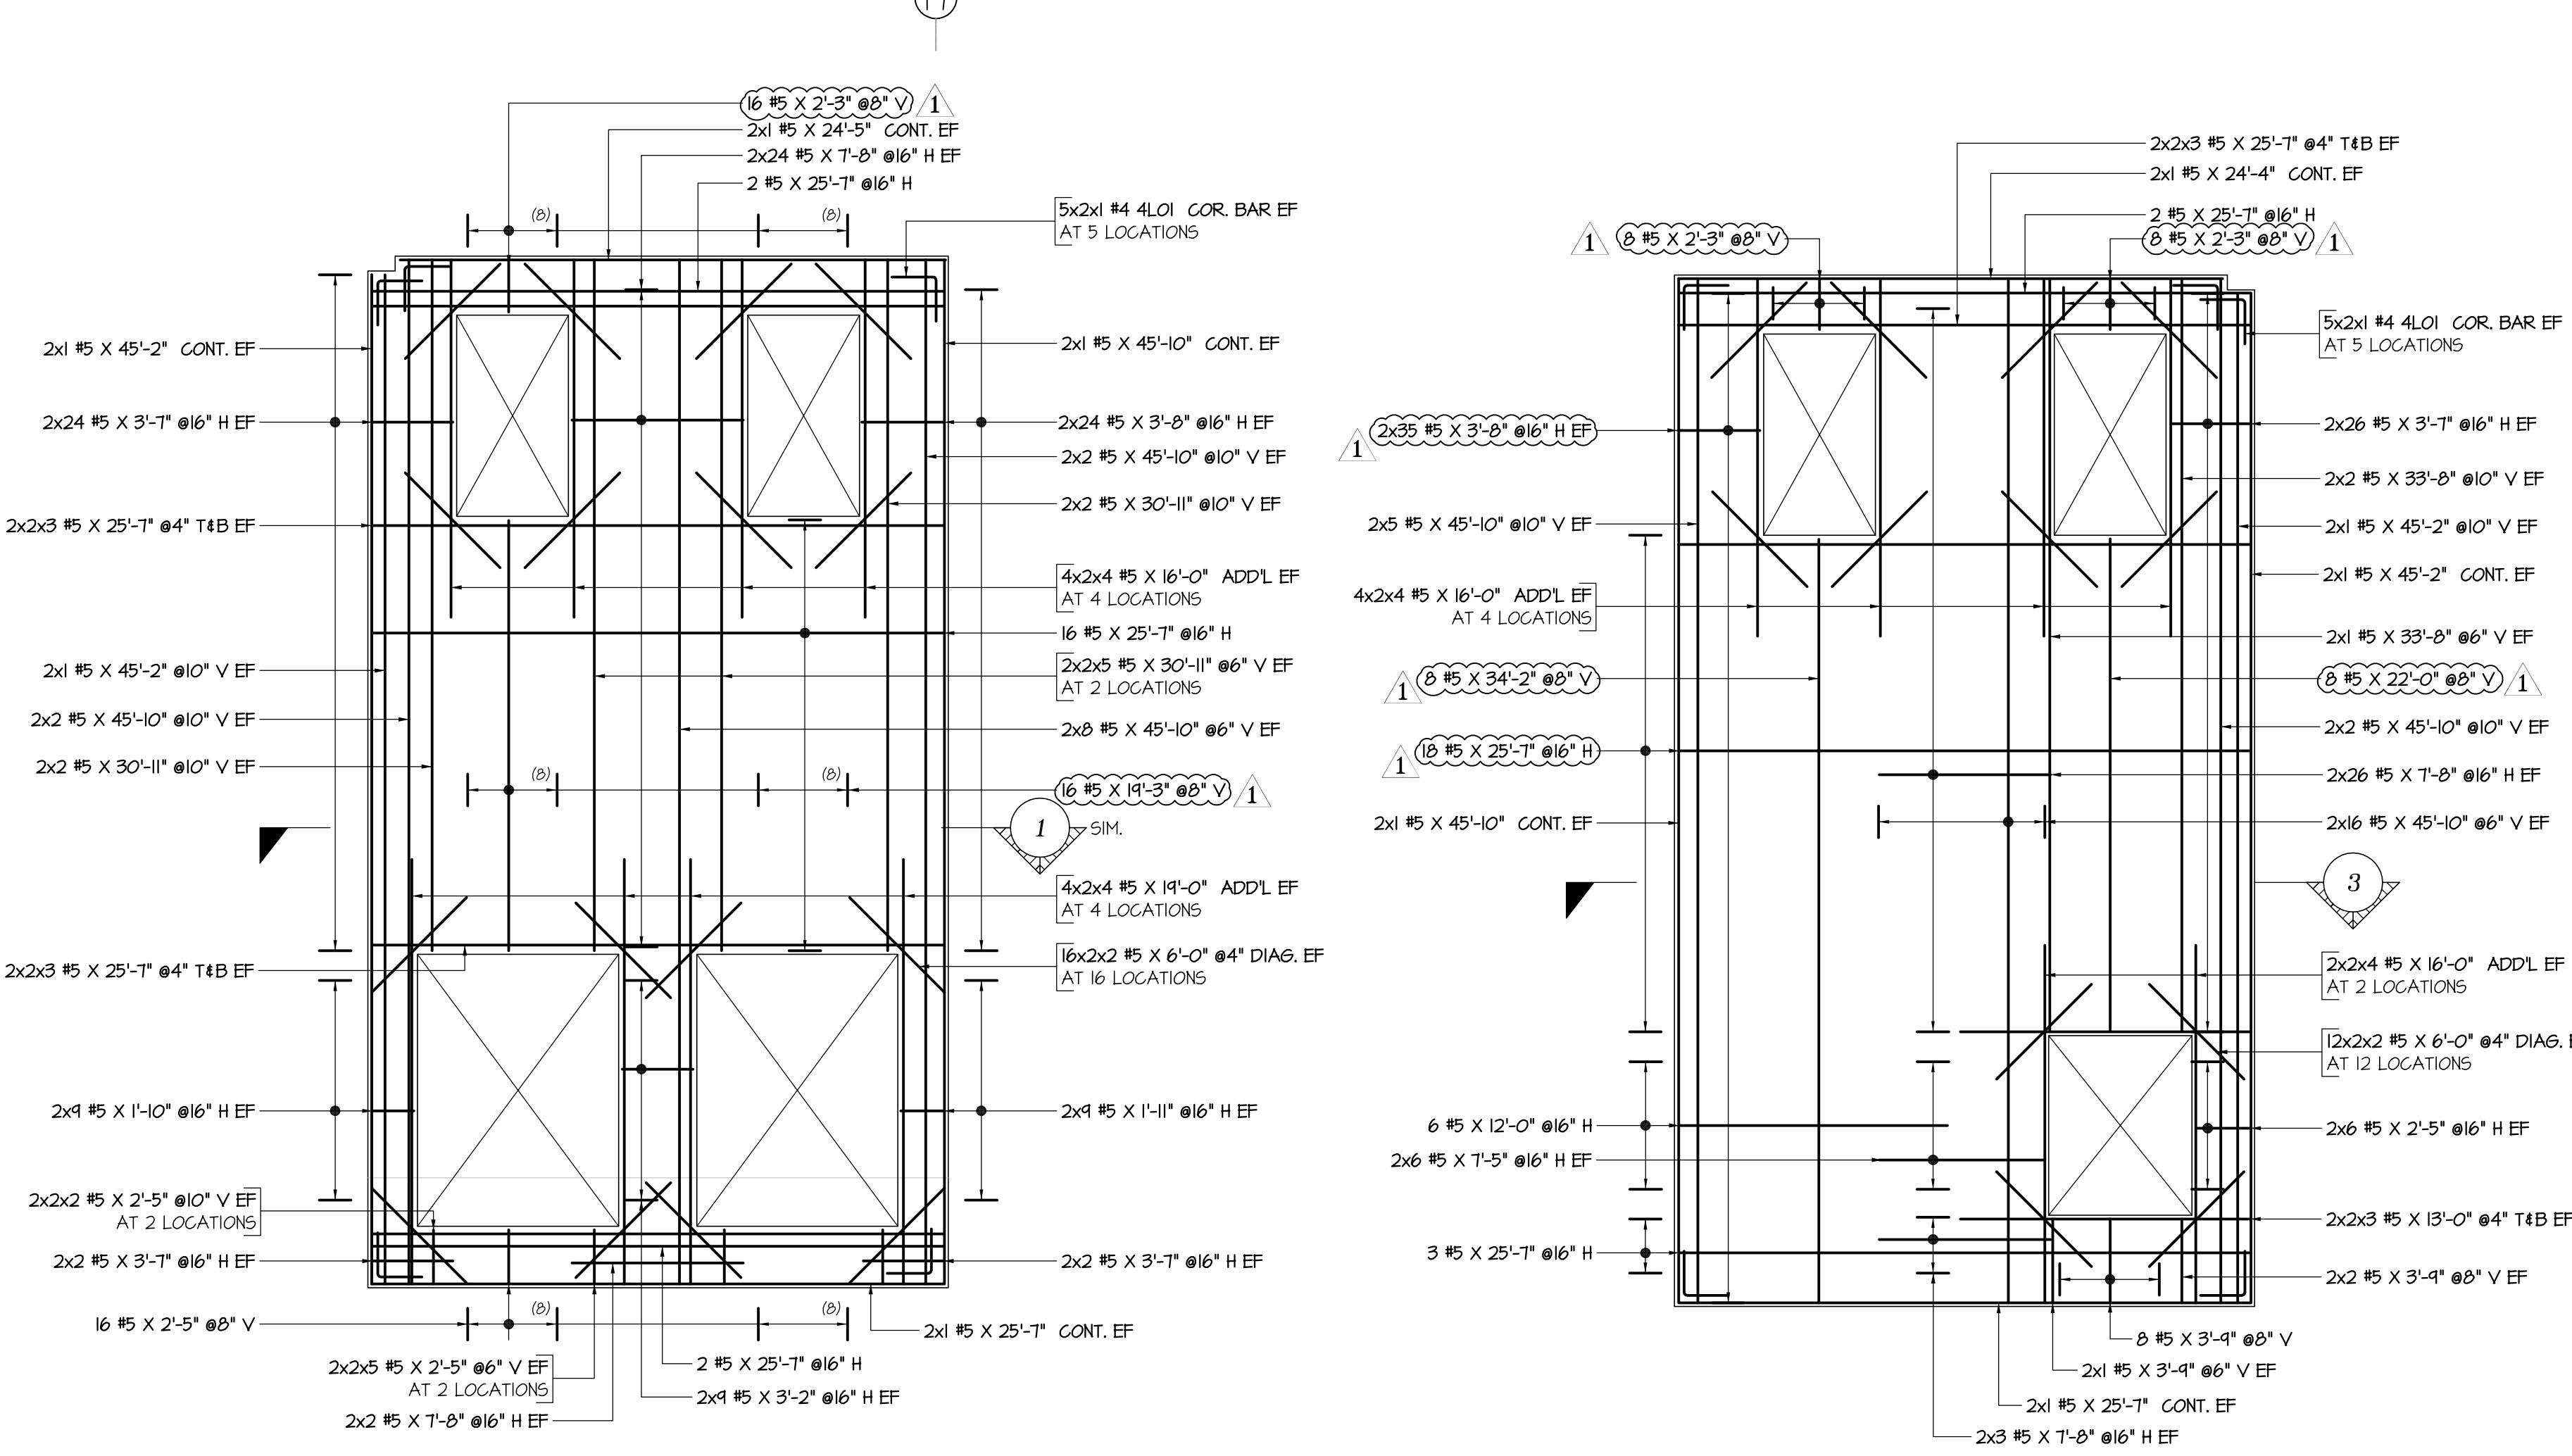

WALL PANEL - S43

SCALE: 1/2" = 1'-0"
SDR: R4, R8 & S200
4 1/4" THK WALL

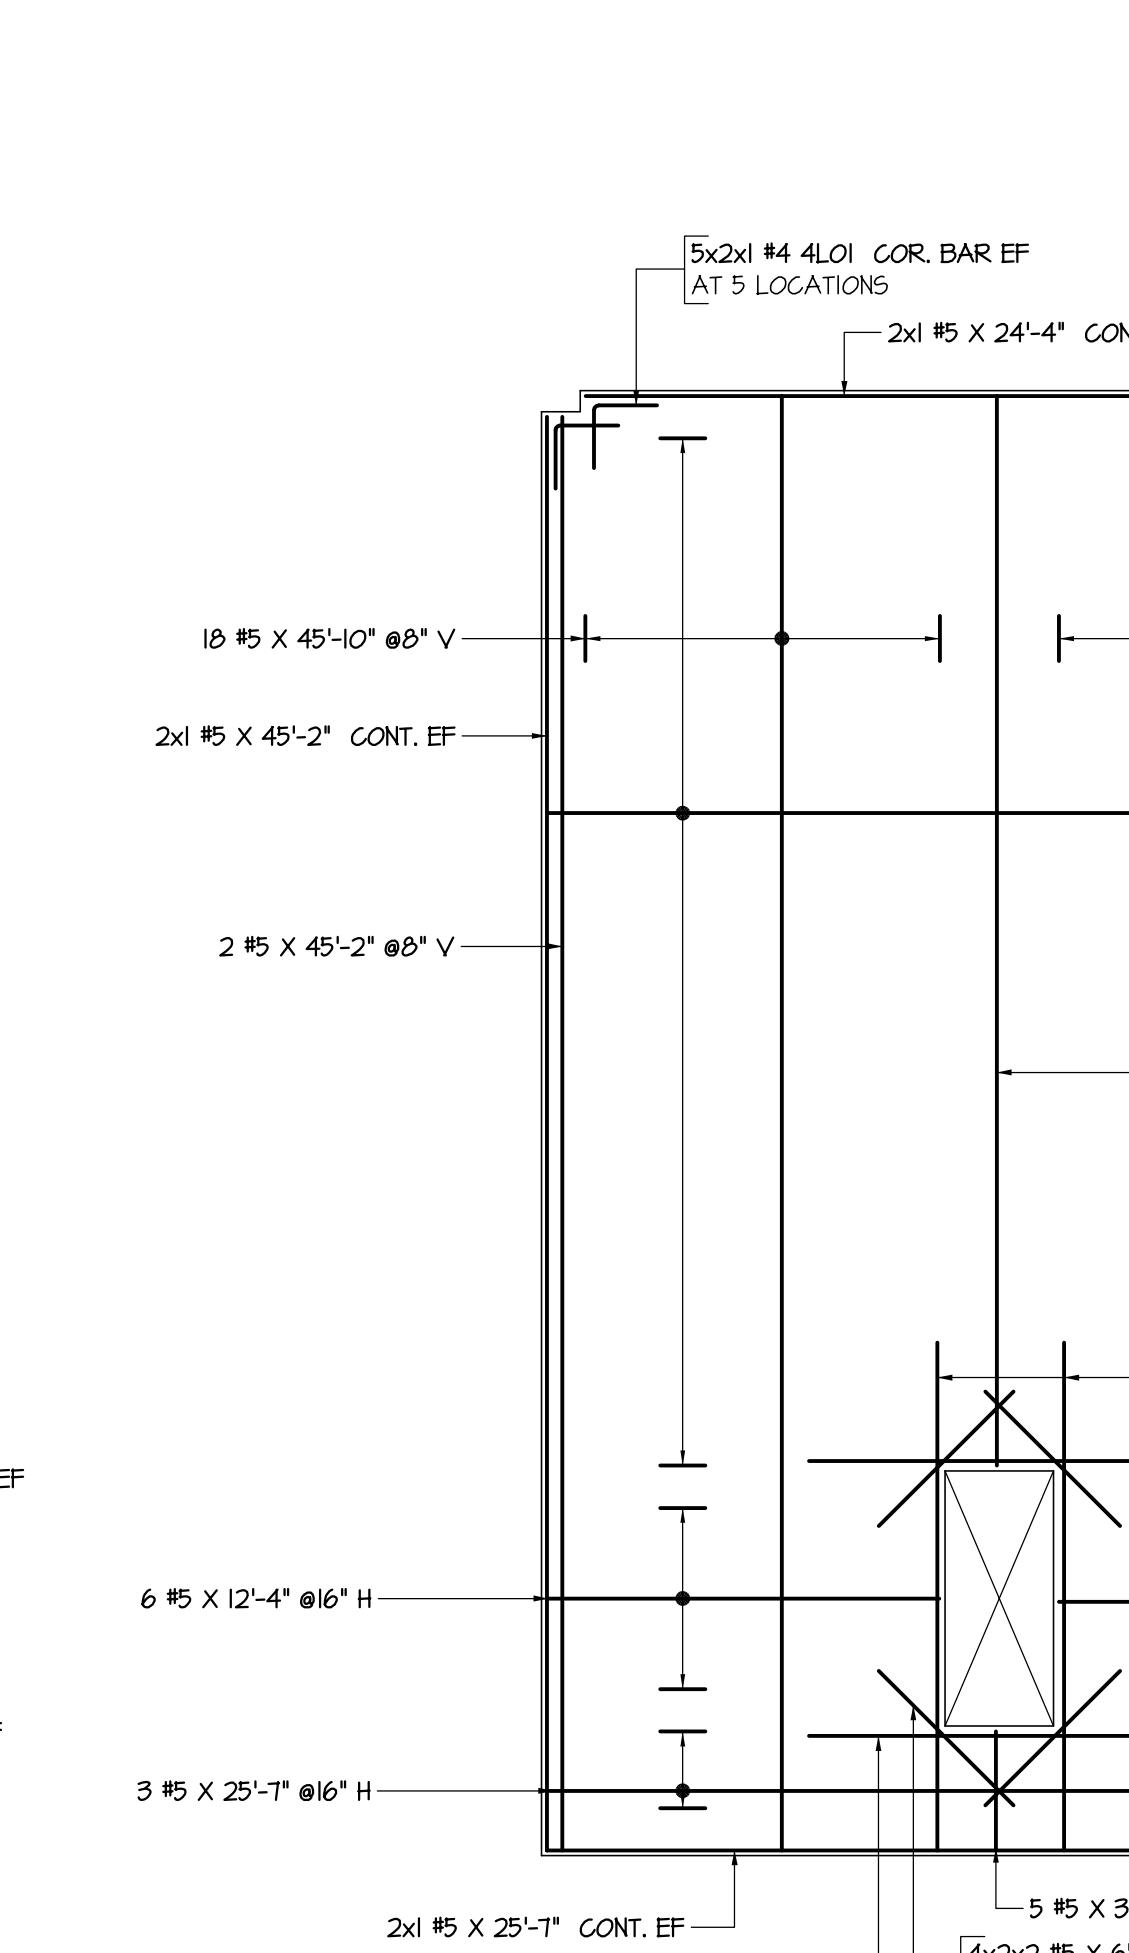

SECTION 1

SCALE: 1/2" = 1'-0"
SDR: R5, R8 & S200

SECTION 10

SCALE: 1/2" = 1'-0"
SDR: R5, R8 & S200

SECTION 12

SCALE: 1/2" = 1'-0"
SDR: R5, R8 & S200

SECTION 20

SCALE: 1/2" = 1'-0"
SDR: R5, R8 & S200

SECTION 34

SCALE: 1/2" = 1'-0"
SDR: R5, R8 & S200

SECTION 2

SCALE: 1/2" = 1'-0"
SDR: R5, R8 & S200

SECTION 3

SCALE: 1/2" = 1'-0"
SDR: R5, R8 & S200

SECTION 3

SCALE: 1/2" = 1'-0"
SDR: R5, R8 & S200

REBAR PLACEMENT FOR SINGLE LAYERS

SCALE: 1/2" = 1'-0"
SDR: R8

REBAR PLACEMENT FOR DOUBLE LAYERS

SCALE: 1/2" = 1'-0"
SDR: R8

KEY PLAN

N

NOTES


REV. NO.

DATE

DESCRIPTION

SOUTH WALL PANELS	
PLACING DRAWING REFERENCE	
DWG.NO:	DRAWING DESCRIPTION
R-18	SOUTH WALL PANELS S-1 TO S-8
R-19	SOUTH WALL PANELS S-9 TO S-15
R-20	SOUTH WALL PANELS S-16 TO S-22
R-21	SOUTH WALL PANELS S-23 TO S-30
R-22	SOUTH WALL PANELS S-31 TO S-31
R-23	SOUTH WALL PANELS S-38 TO S-44
R-24	SOUTH WALL PANELS S-45 TO S-51
R-25	SOUTH WALL PANELS S-52 TO S-58
R-26	SOUTH WALL PANELS S-59 TO S-66
R-27	SOUTH WALL PANELS S-67 TO S-73
R-28	SOUTH WALL PANELS S-74 TO S-80

Drawing Sheet : R-23											
Bending Details											
Bar Mark	Oy	Size	Total Length	Type	X'	Y'	Z'	Y'	Z'	Y'	Z'
3L02	32#	#3	3'-7 1/2"	T1	0'-4 X'	1'-10 X'	0'-7"	1'-10 X'	0'-7"	0'-4 X'	0'-4 X'
4L01	48#	#4	4'-0"	T17	2'-0"	2'-0"	2'-0"	2'-0"	2'-0"	2'-0"	2'-0"

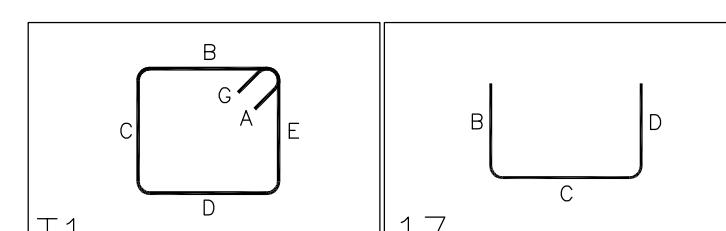

STRUCTURAL NOTES	
LEGENDS	LABEL LEGENDS
T	TOP
B	BOTTOM
V	VERTICAL
H	HORIZONTAL
CLR	CLEAR COVER
SIM	SIMILAR
TYP.	Typical
T.O.MAT	- TOP OF MAT
E5	- EACH SIDE
EF	- EACH FACE
CONT	- CONTINUOUS
COR	- CORNER
THK	- THICKNESS
ADDL	- ADDITIONAL
DIAG	- DIAGONAL
NTS	- NOT TO SCALE
€	- CENTER LINE
SDR	- STRUCTURAL DRAWING
	REFERENCE
CLEAR COVER TO REINFORCEMENT	
2"	AT ENDS
1 1/2"	#5 @ BELOW EXTERIOR FACE
2"	#6 @ ABOVE EXTERIOR FACE
3/4"	AT INTERIOR FACE
WALL PANEL	

REINFORCING STEEL PLACING DRAWING ONLY. USE IN CONJUNCTION WITH CONTRACT DRAWINGS & SPECIFICATIONS. ELEVATIONS & DIMENSIONS SHOWN ON THIS DRAWING ARE FOR DETAILING PURPOSES ONLY AND SHOULD NOT BE USED FOR CONSTRUCTION UNLESS VERIFIED BY ENGINEER OR CONTRACTOR.

7	
6	
5	
4	
3	
2	06.14.2019
1	05.29.2019

RE SUBMITTED FOR APPROVAL

APPROVAL

SENT FOR

DATE

05.29.2019

RECEIVED AS PER LATEST C.D.'S

05.31.19

RE-STEEL SUPPLY CO., INC.

REINFORCING STEEL - WIRE MESH

2000 Eddystone Industrial Park • Eddystone, PA 19022-1588

Phone: 800-876-8216 Fax: 610-876-8428

Structure: VALLEY VIEW BUSINESS PARK TILT PANELS

Location: JESSUP, PA

Architect: KSS ARCHITECTS


Engineer: RICHARD ADAMS

Customer: T&T CONSTRUCTION

Made by: PRO Date: 05.29.2019 Contract No. U2524

Drawing Covers: SOUTH WALL PANELS S-38 TO S-44 Drawing No. R-23

Rev. No. Date Description

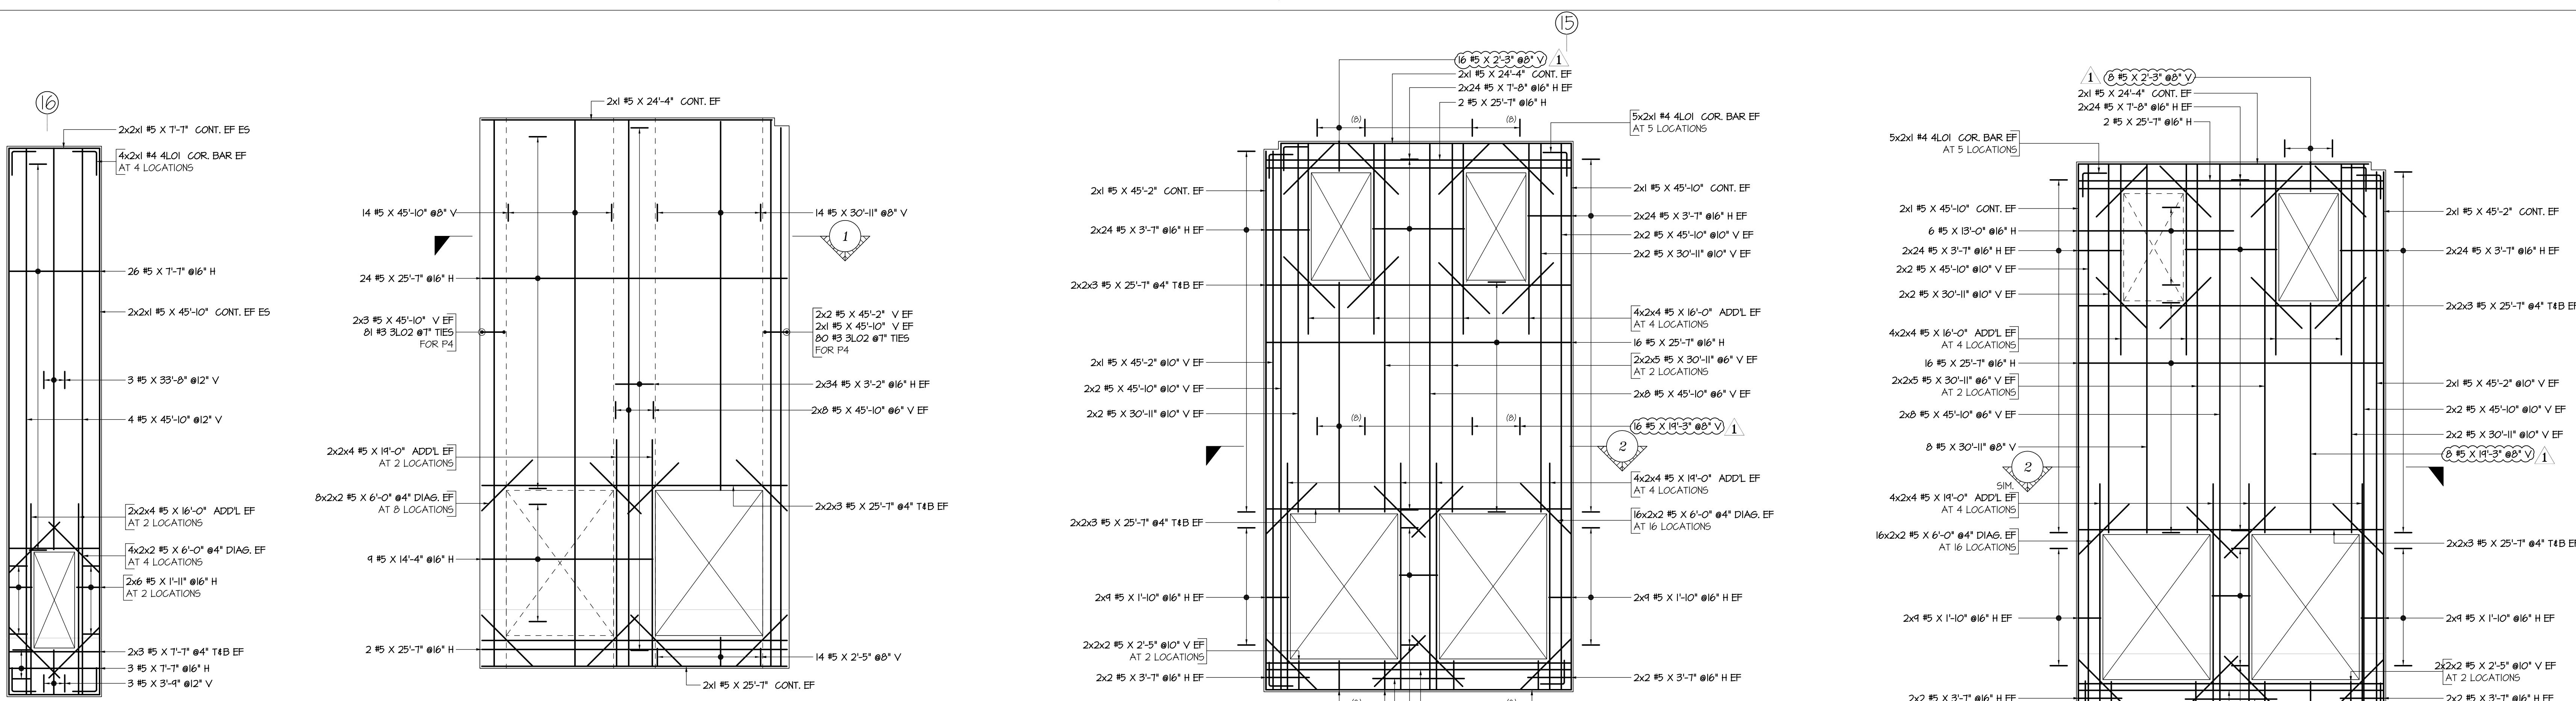


WALL PANEL - S45
SCALE: 1/8" = 1'-0"
SDR: R5, R24 & 5200
(1/4" THK WALL)

WALL PANEL - S46
SCALE: 1/8" = 1'-0"
SDR: R5, R24 & 5200
(1/4" THK WALL)

WALL PANEL - S47
SCALE: 1/8" = 1'-0"
SDR: R5, R24 & 5200
(1/4" THK WALL)



WALL PANEL - S48
SCALE: 1/8" = 1'-0"
SDR: R5, R24 & 5200
(1/4" THK WALL)

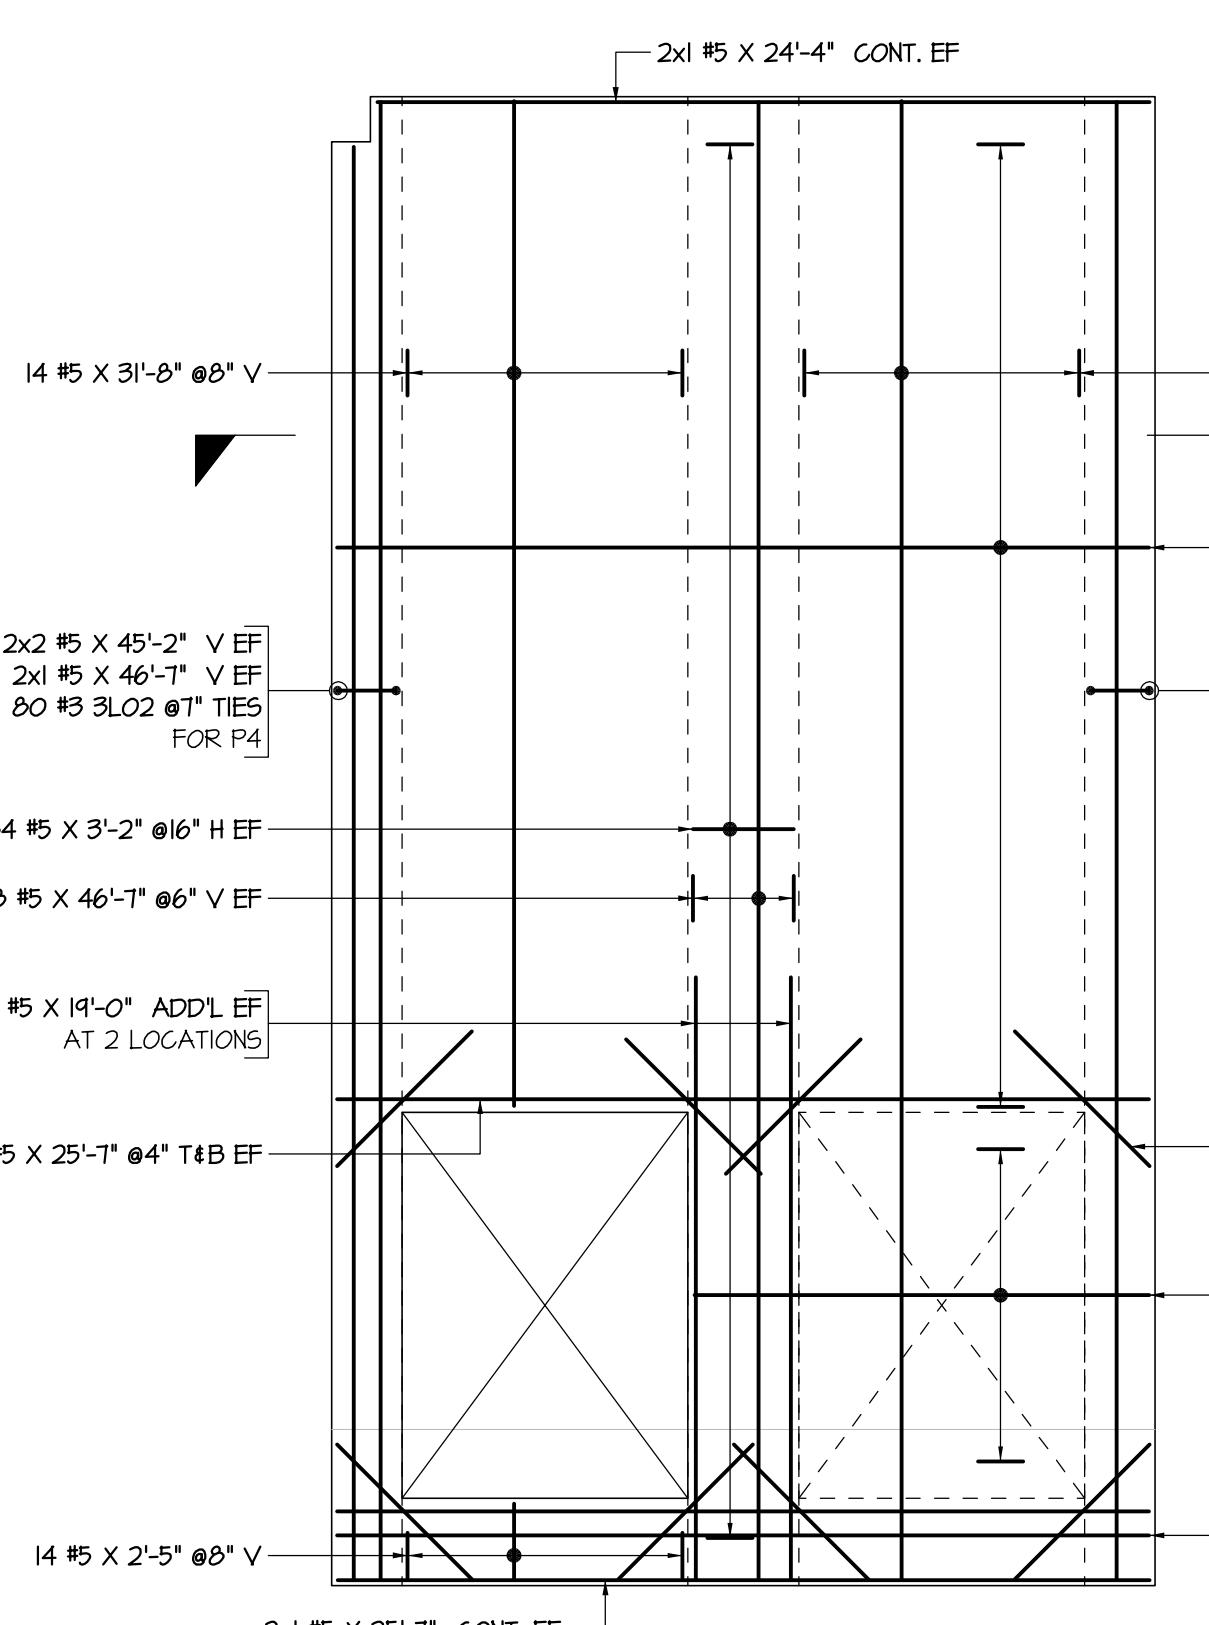


WALL PANEL - S49
SCALE: 1/8" = 1'-0"
SDR: R5, R24 & 5200
(1/4" THK WALL)

WALL PANEL - S50
SCALE: 1/8" = 1'-0"
SDR: R6, R24 & 5200
(1/4" THK WALL)

WALL PANEL - S51
SCALE: 1/8" = 1'-0"
SDR: R6, R24 & 5200
(1/4" THK WALL)

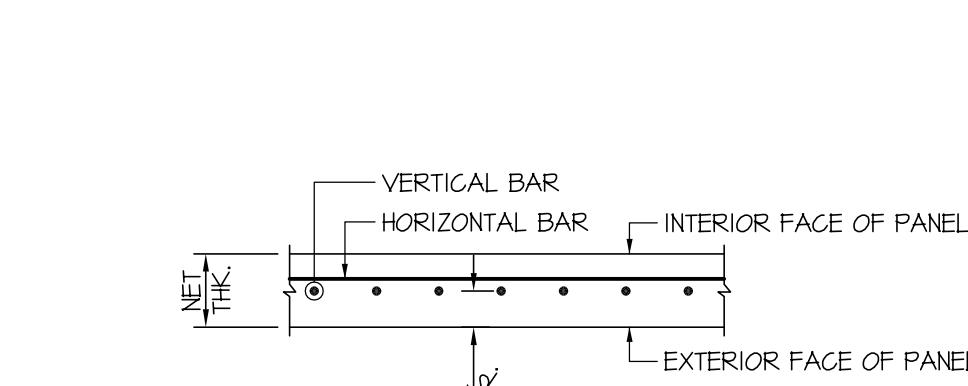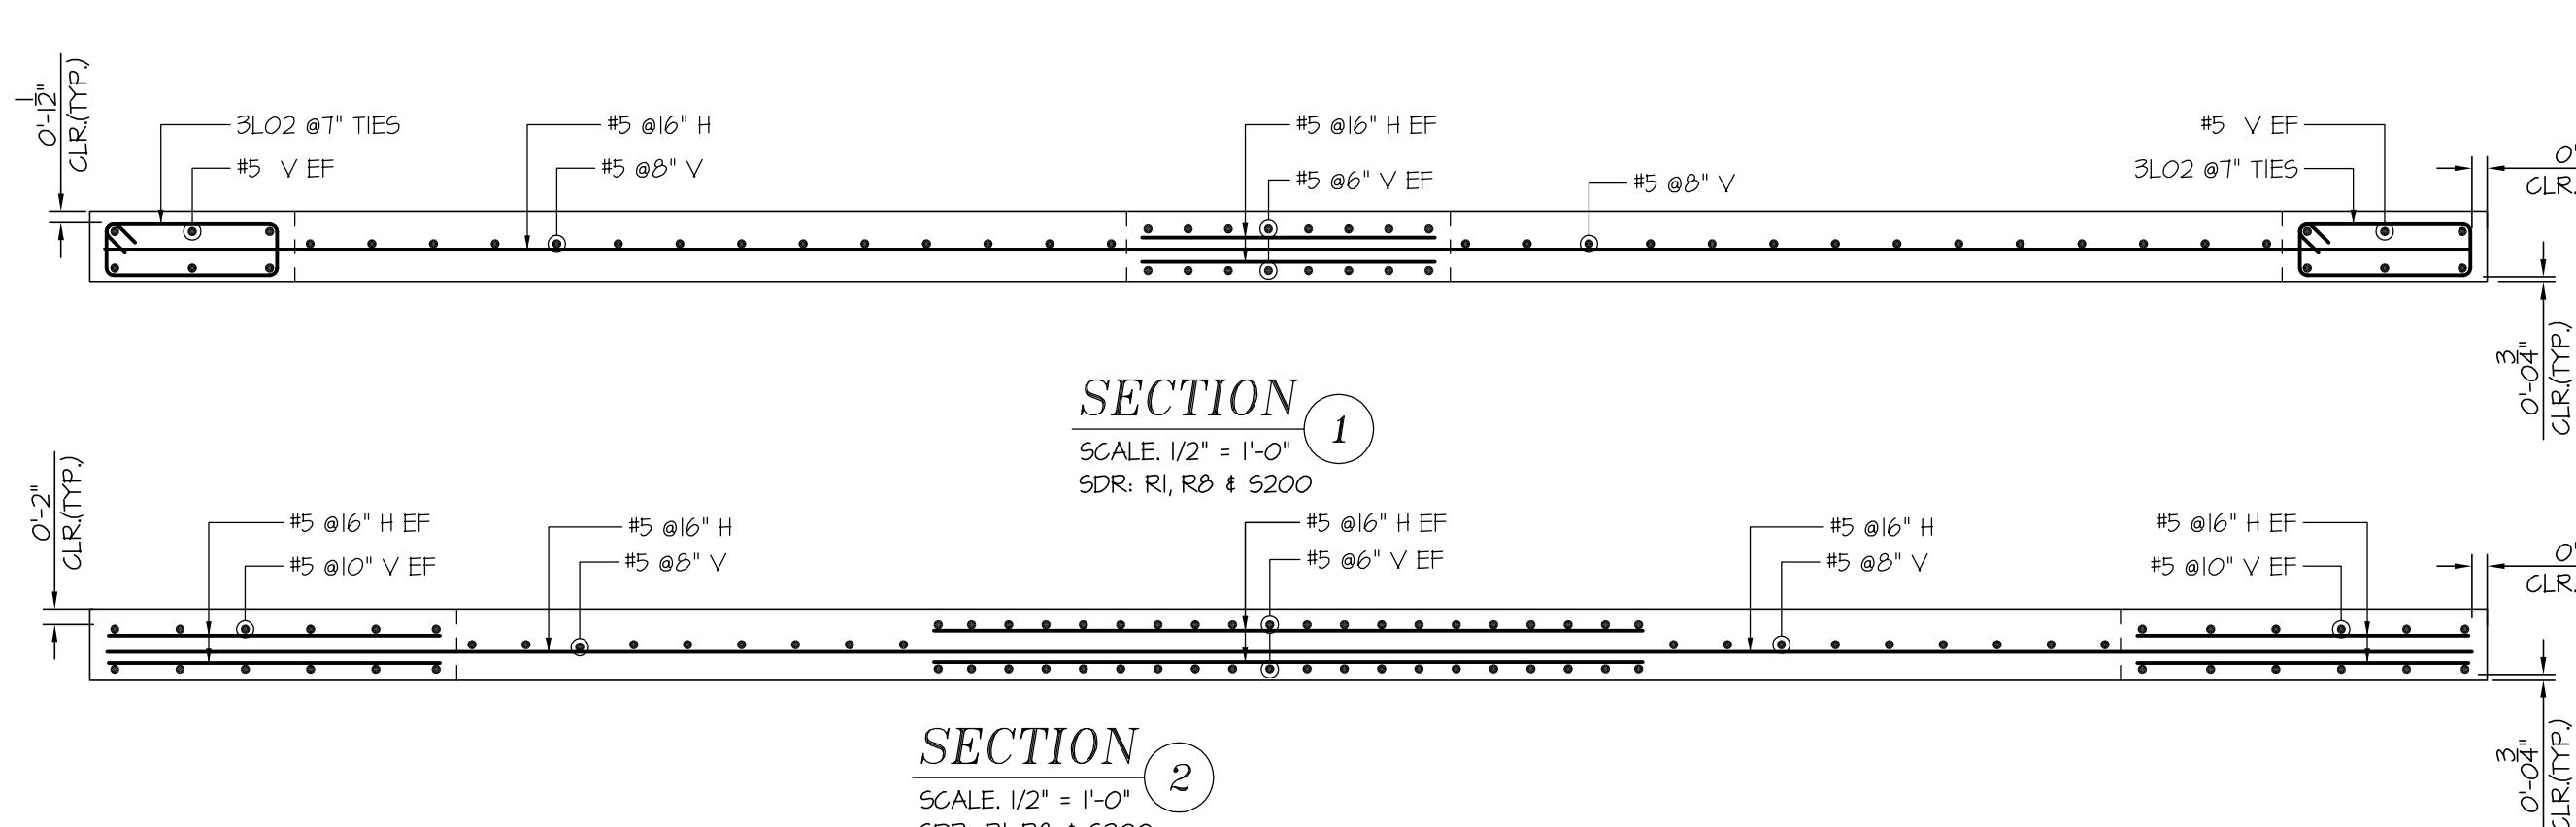

REBAR PLACEMENT FOR SINGLE LAYERS

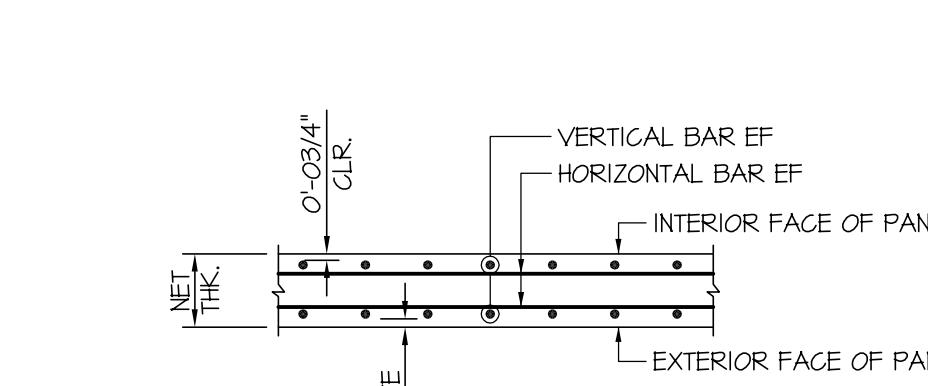

REBAR PLACEMENT FOR DOUBLE LAYERS



Drawing Sheet : R-24										BENDING DETAILS									
Bar Mark	Qty	Size	Total Length	Type	X'	X"	Y'	Y"	Z'	Z"	Y'	Y"	X'	X"	Y'	Y"	Z'	Z"	
3L02	483	#3	5'-7 1/2"	11	0'-4 X"	1'-10 X"	0'-7"	1'-10 X"	0'-7"	1'-7"	0'-4 X"	1'-4 X"							
4L01	35	#4	4'-0"	17	2'-0"	2'-0"	2'-0"	2'-0"	2'-0"	2'-0"	2'-0"	2'-0"	2'-0"	2'-0"	2'-0"	2'-0"	2'-0"	2'-0"	

SOUTH WALL PANELS PLACING DRAWING REFERENCE									
DWG.NO:	DRAWING DESCRIPTION								
R-18	SOUTH WALL PANELS S-1 TO S-8								
R-19	SOUTH WALL PANELS S-9 TO S-15								
R-20	SOUTH WALL PANELS S-16 TO S-22								
R-21	SOUTH WALL PANELS S-23 TO S-30								
R-22	SOUTH WALL PANELS S-31 TO S-37								
R-23	SOUTH WALL PANELS S-38 TO S-44								
R-24	SOUTH WALL PANELS S-45 TO S-51								
R-25	SOUTH WALL PANELS S-52 TO S-58								
R-26	SOUTH WALL PANELS S-59 TO S-66								
R-27	SOUTH WALL PANELS S-67 TO S-73								
R-28	SOUTH WALL PANELS S-74 TO S-80								





LEGENDS		LABEL LEGENDS	
T	- TOP	b2x6	#4 4C01 @12" B2
B	- BOTTOM		NOTES
V	- VERTICAL		SPACING
H	- HORIZONTAL		BAR MARK
CLR.	- CLEAR COVER		BAR SIZE
SLIM.	- SIMILAR		NUMBER OF BARS
TYP.	- TYPICAL		EACH FACE
T.MAT.	- TOP OF MAT		NUMBER OF LOCATION
ES	- EACH SIDE		NUMBER OF LOCATIONS
EF	- EACH FACE		OPENINGS
CONT	- CONTINUOUS		KNOCK OUTS
COR.	- CORNER		
THK.	- THICKNESS		
ADDL.	- ADDITIONAL		
DIAG.	- DIAGONAL		
NTS	- NOT TO SCALE		
€	- CENTER LINE		
SDR	- STRUCTURAL DRAWING		
	- REFERENCE		

CLEAR COVER TO REINFORCEMENT	
2"	AT ENDS
1 1/2"	#5 4 below at EXTERIOR FACE
2"	#6 6 above at EXTERIOR FACE
3/4"	AT INTERIOR FACE

REINFORCING STEEL PLACING DRAWING ONLY. USE IN CONJUNCTION WITH CONTRACT DRAWINGS & SPECIFICATIONS. ELEVATIONS & DIMENSIONS SHOWN ON THIS DRAWING ARE FOR DETAILED PURPOSES ONLY AND SHOULD NOT BE USED FOR CONSTRUCTION UNLESS VERIFIED BY ENGINEER OR CONTRACTOR.



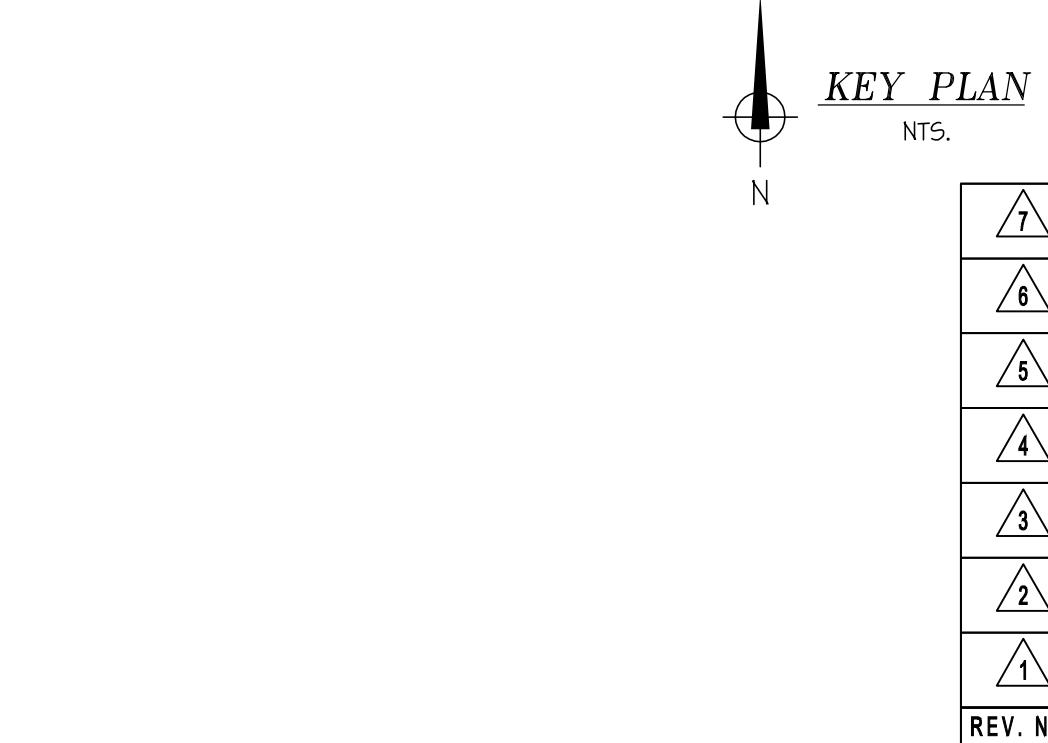
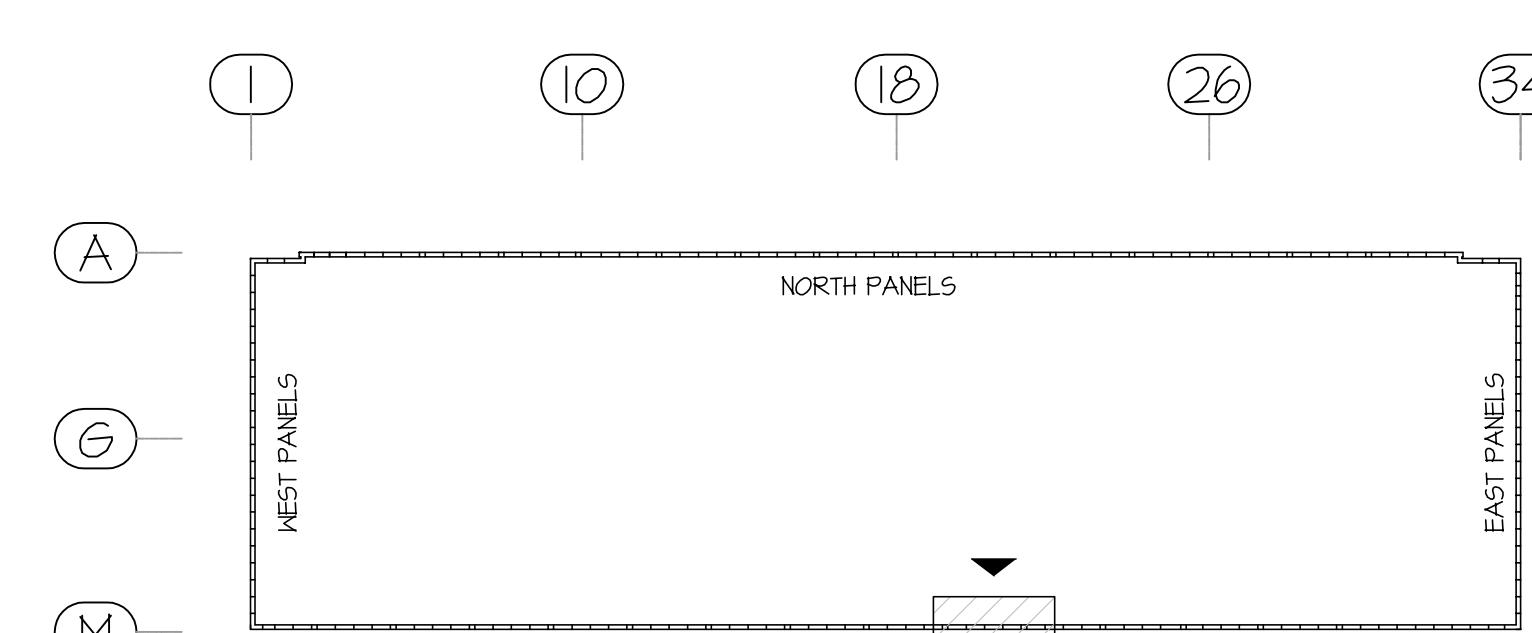


7	
6	
5	
4	
3	
2	06.14.2019
1	RE SUBMITTED FOR APPROVAL
	APPROVAL DATE
	SENT FOR
	05.29.2019
	DATE
	RE-STEEL SUPPLY CO., INC.
	REINFORCING STEEL - WIRE MESH
	2000 Eddystone Industrial Park • Eddystone, PA 19022-1588
	Phone: 800-876-8216 • Fax: 610-876-8428
	Structure: VALLEY VIEW BUSINESS PARK TILT PANELS
	Location: JESSUP, PA
	Architect: KSS ARCHITECTS
	Engineer: RICHARD ADAMS
	Customer: T&T CONSTRUCTION
	Made by: PRO Date: 05.29.2019 CONTRACT NO. U2524
	DRAWING COVERS: SOUTH WALL PANELS S-45 TO S-51
	REV. NO. DATE DESCRIPTION
	06.14.2019 REVISED AS PER LATEST CDS RECEIVED ON 05.31.19
	DRAWING NO. R-24

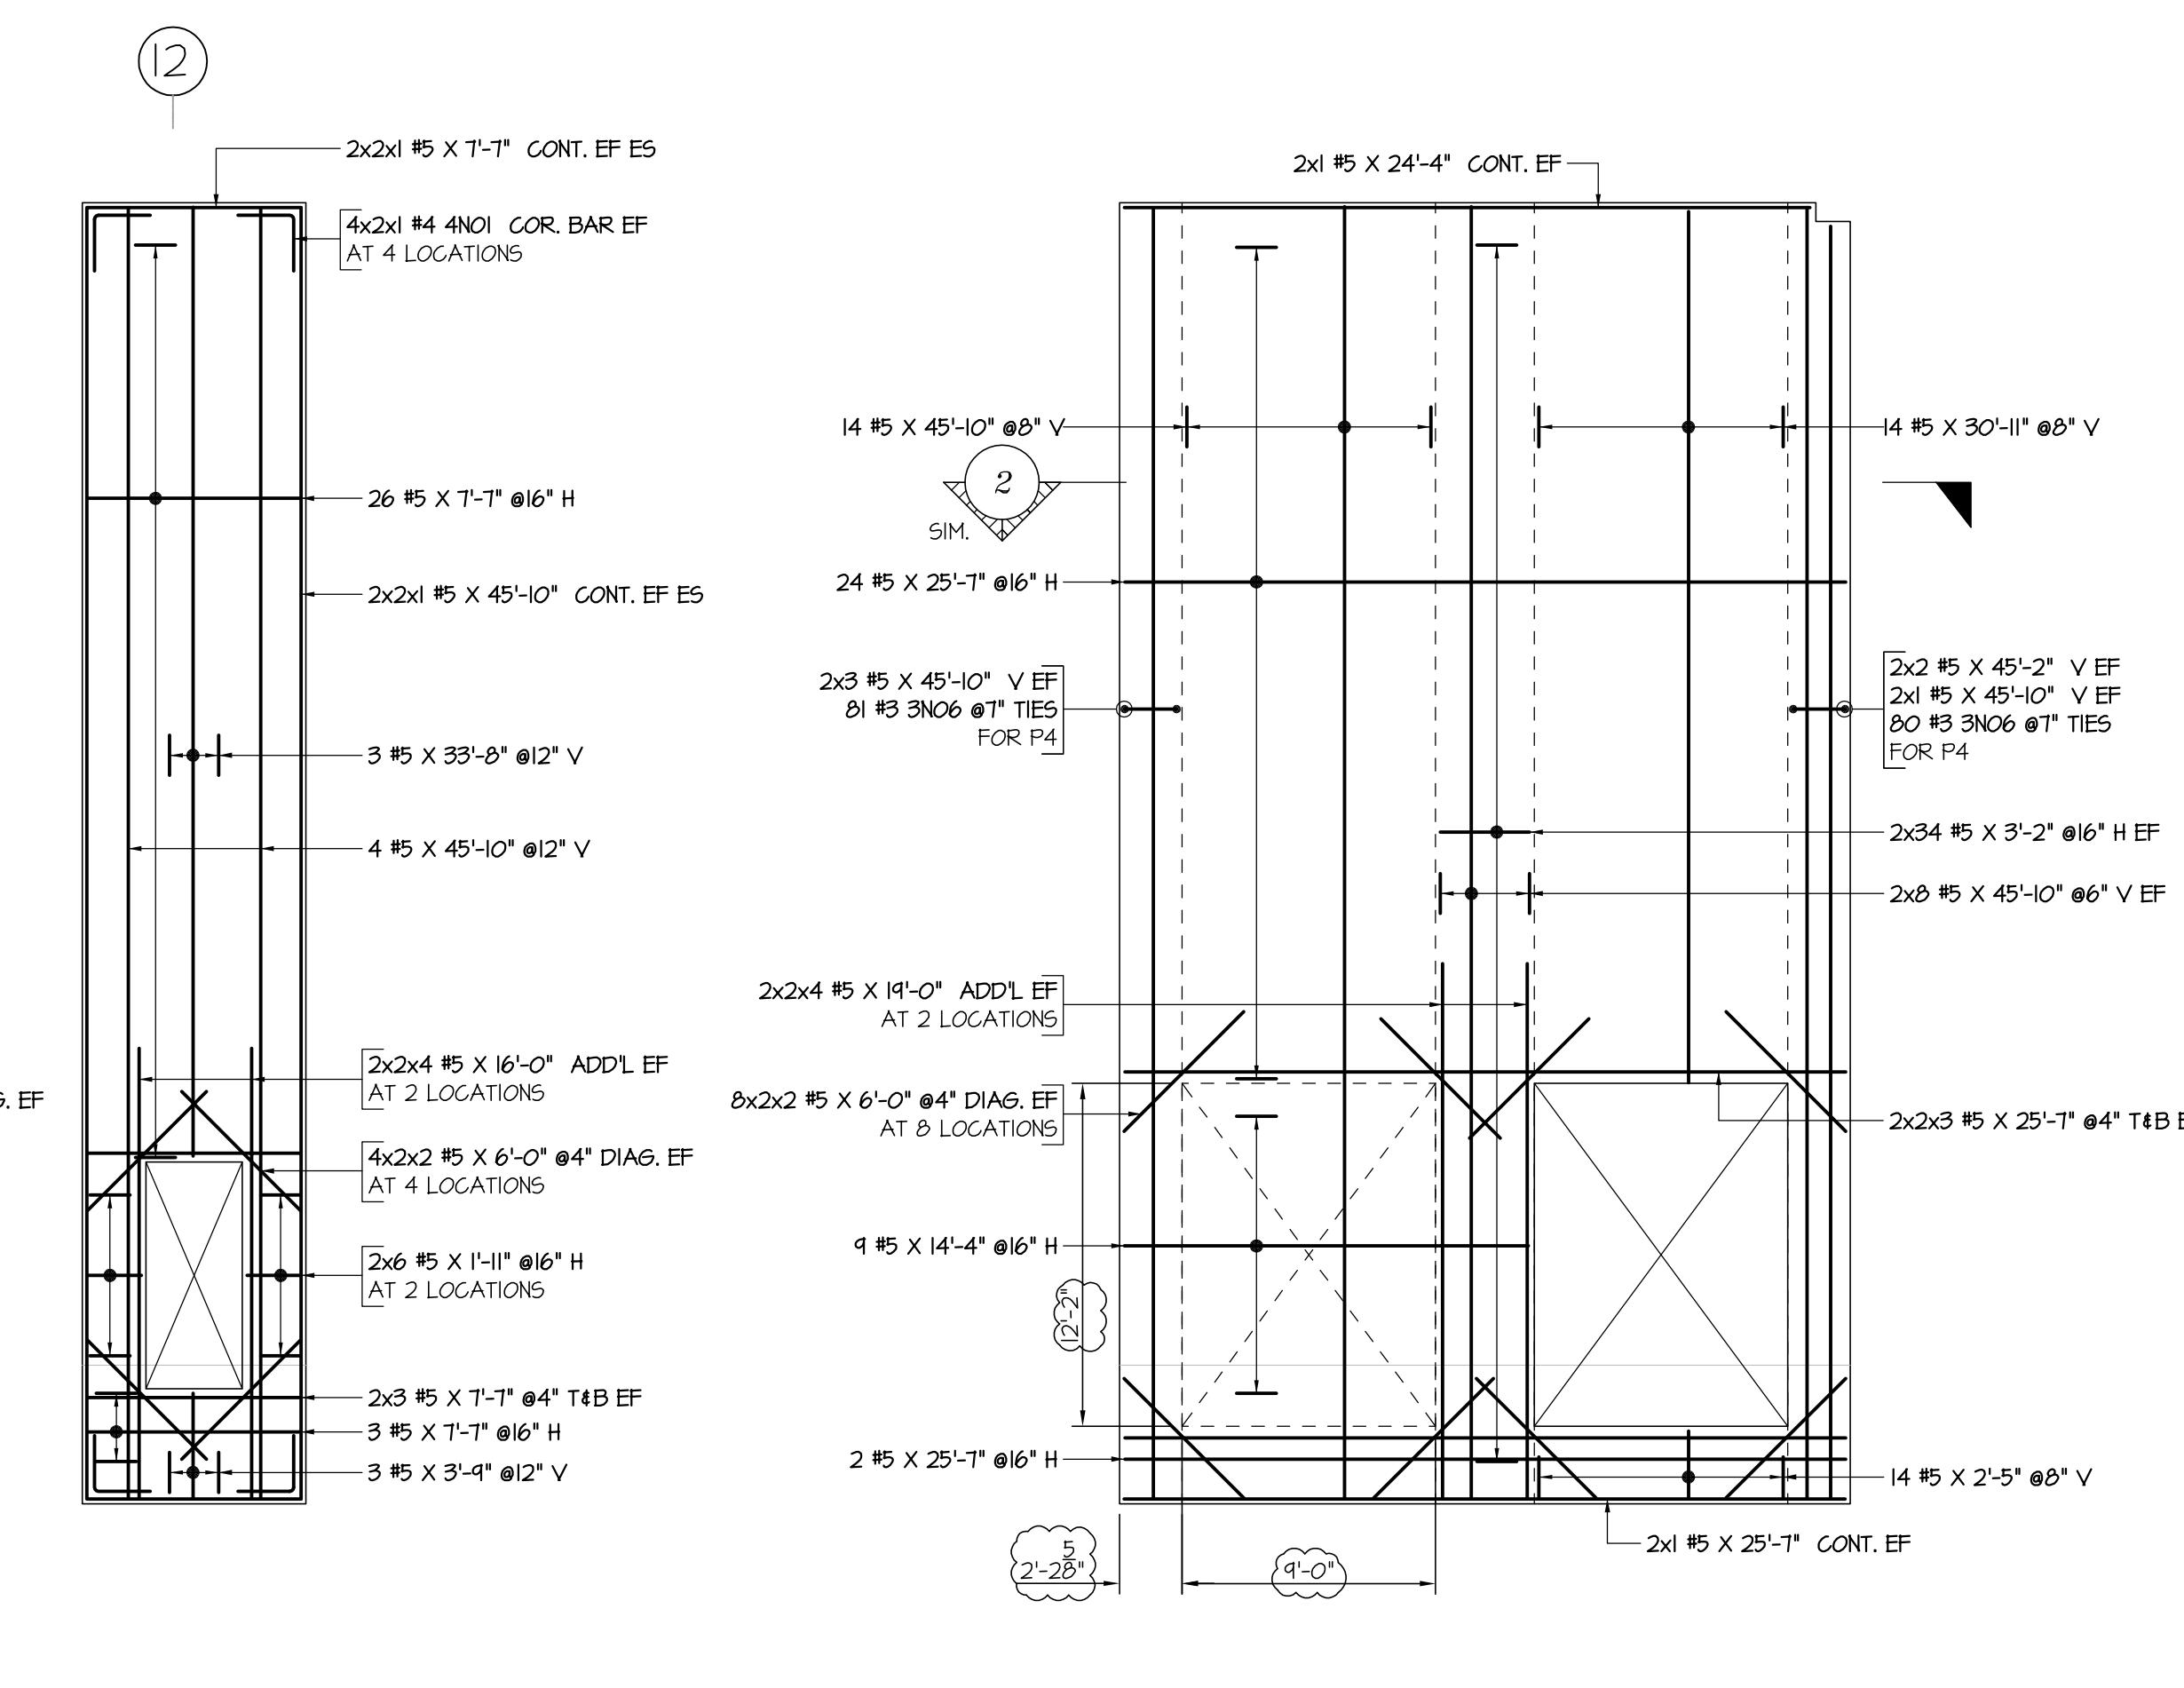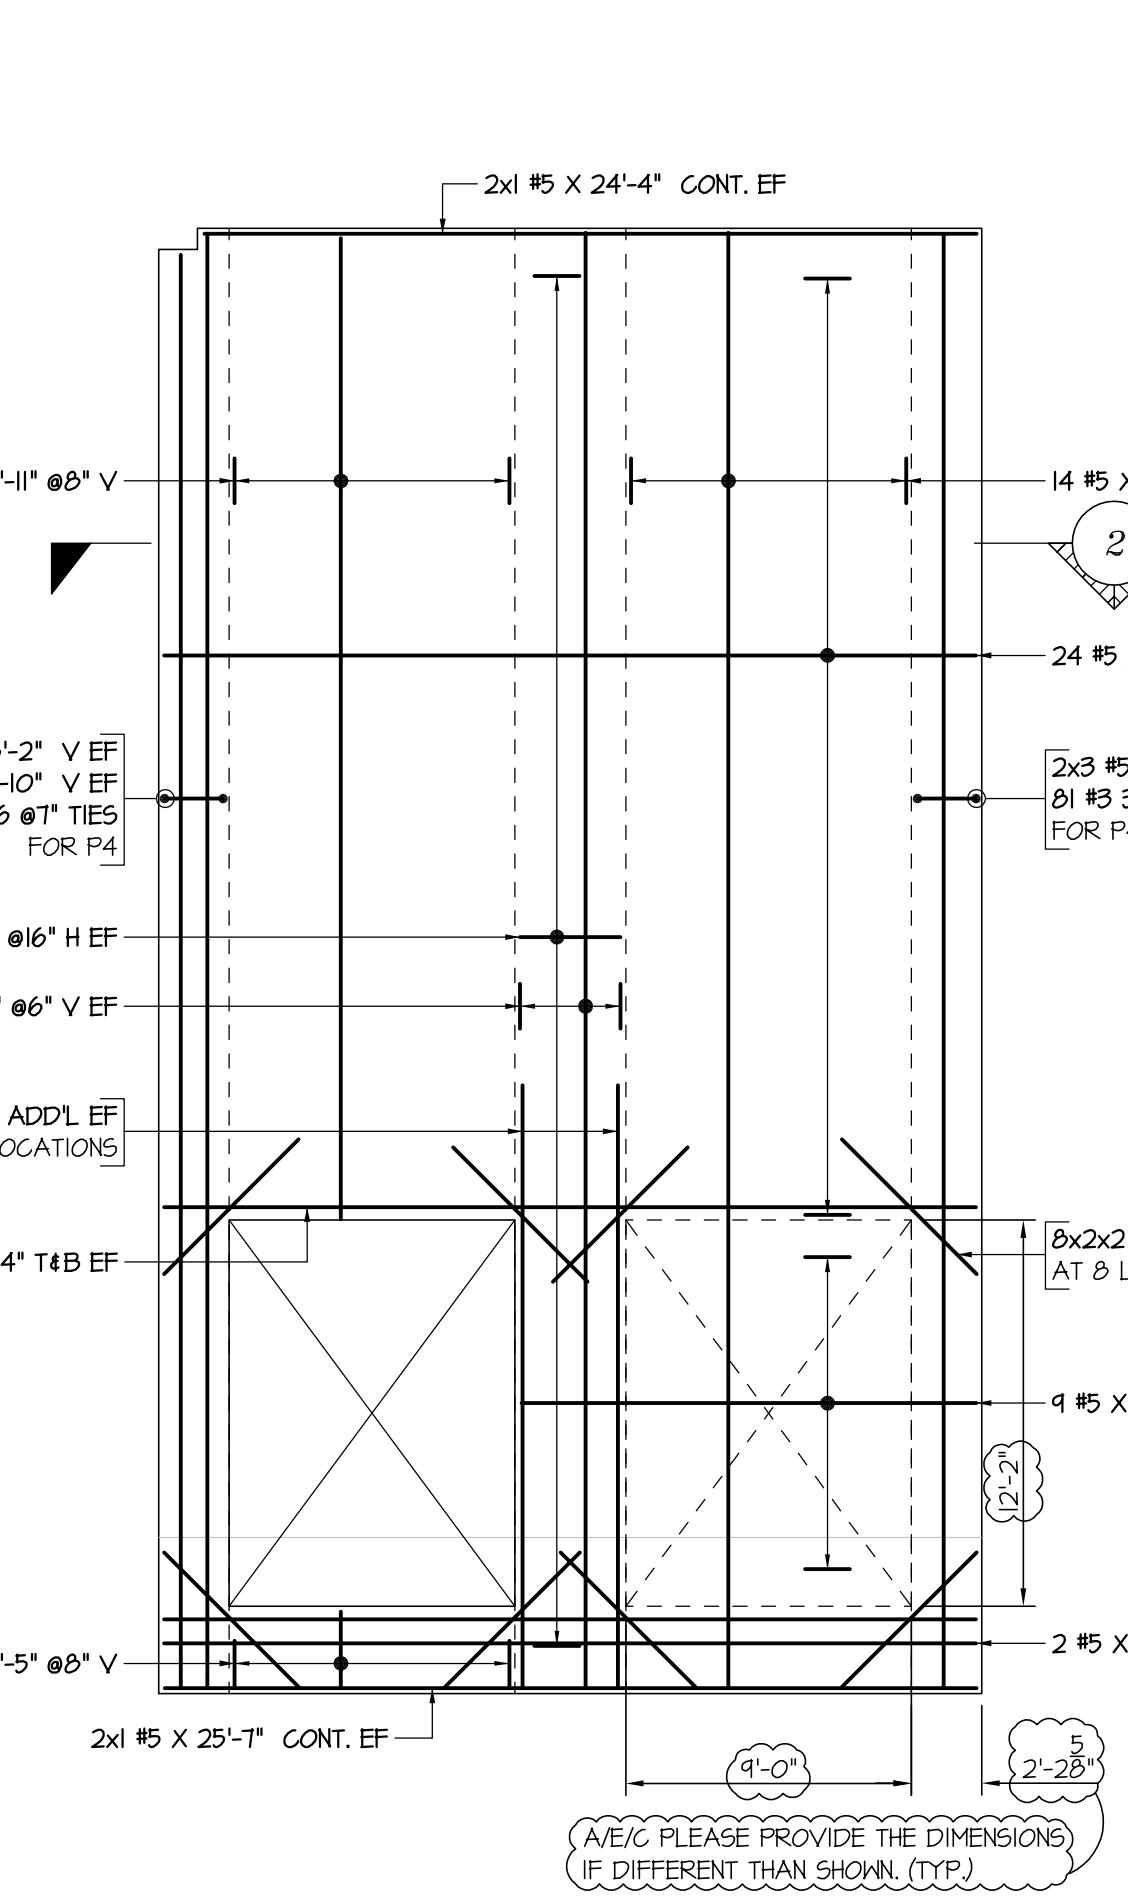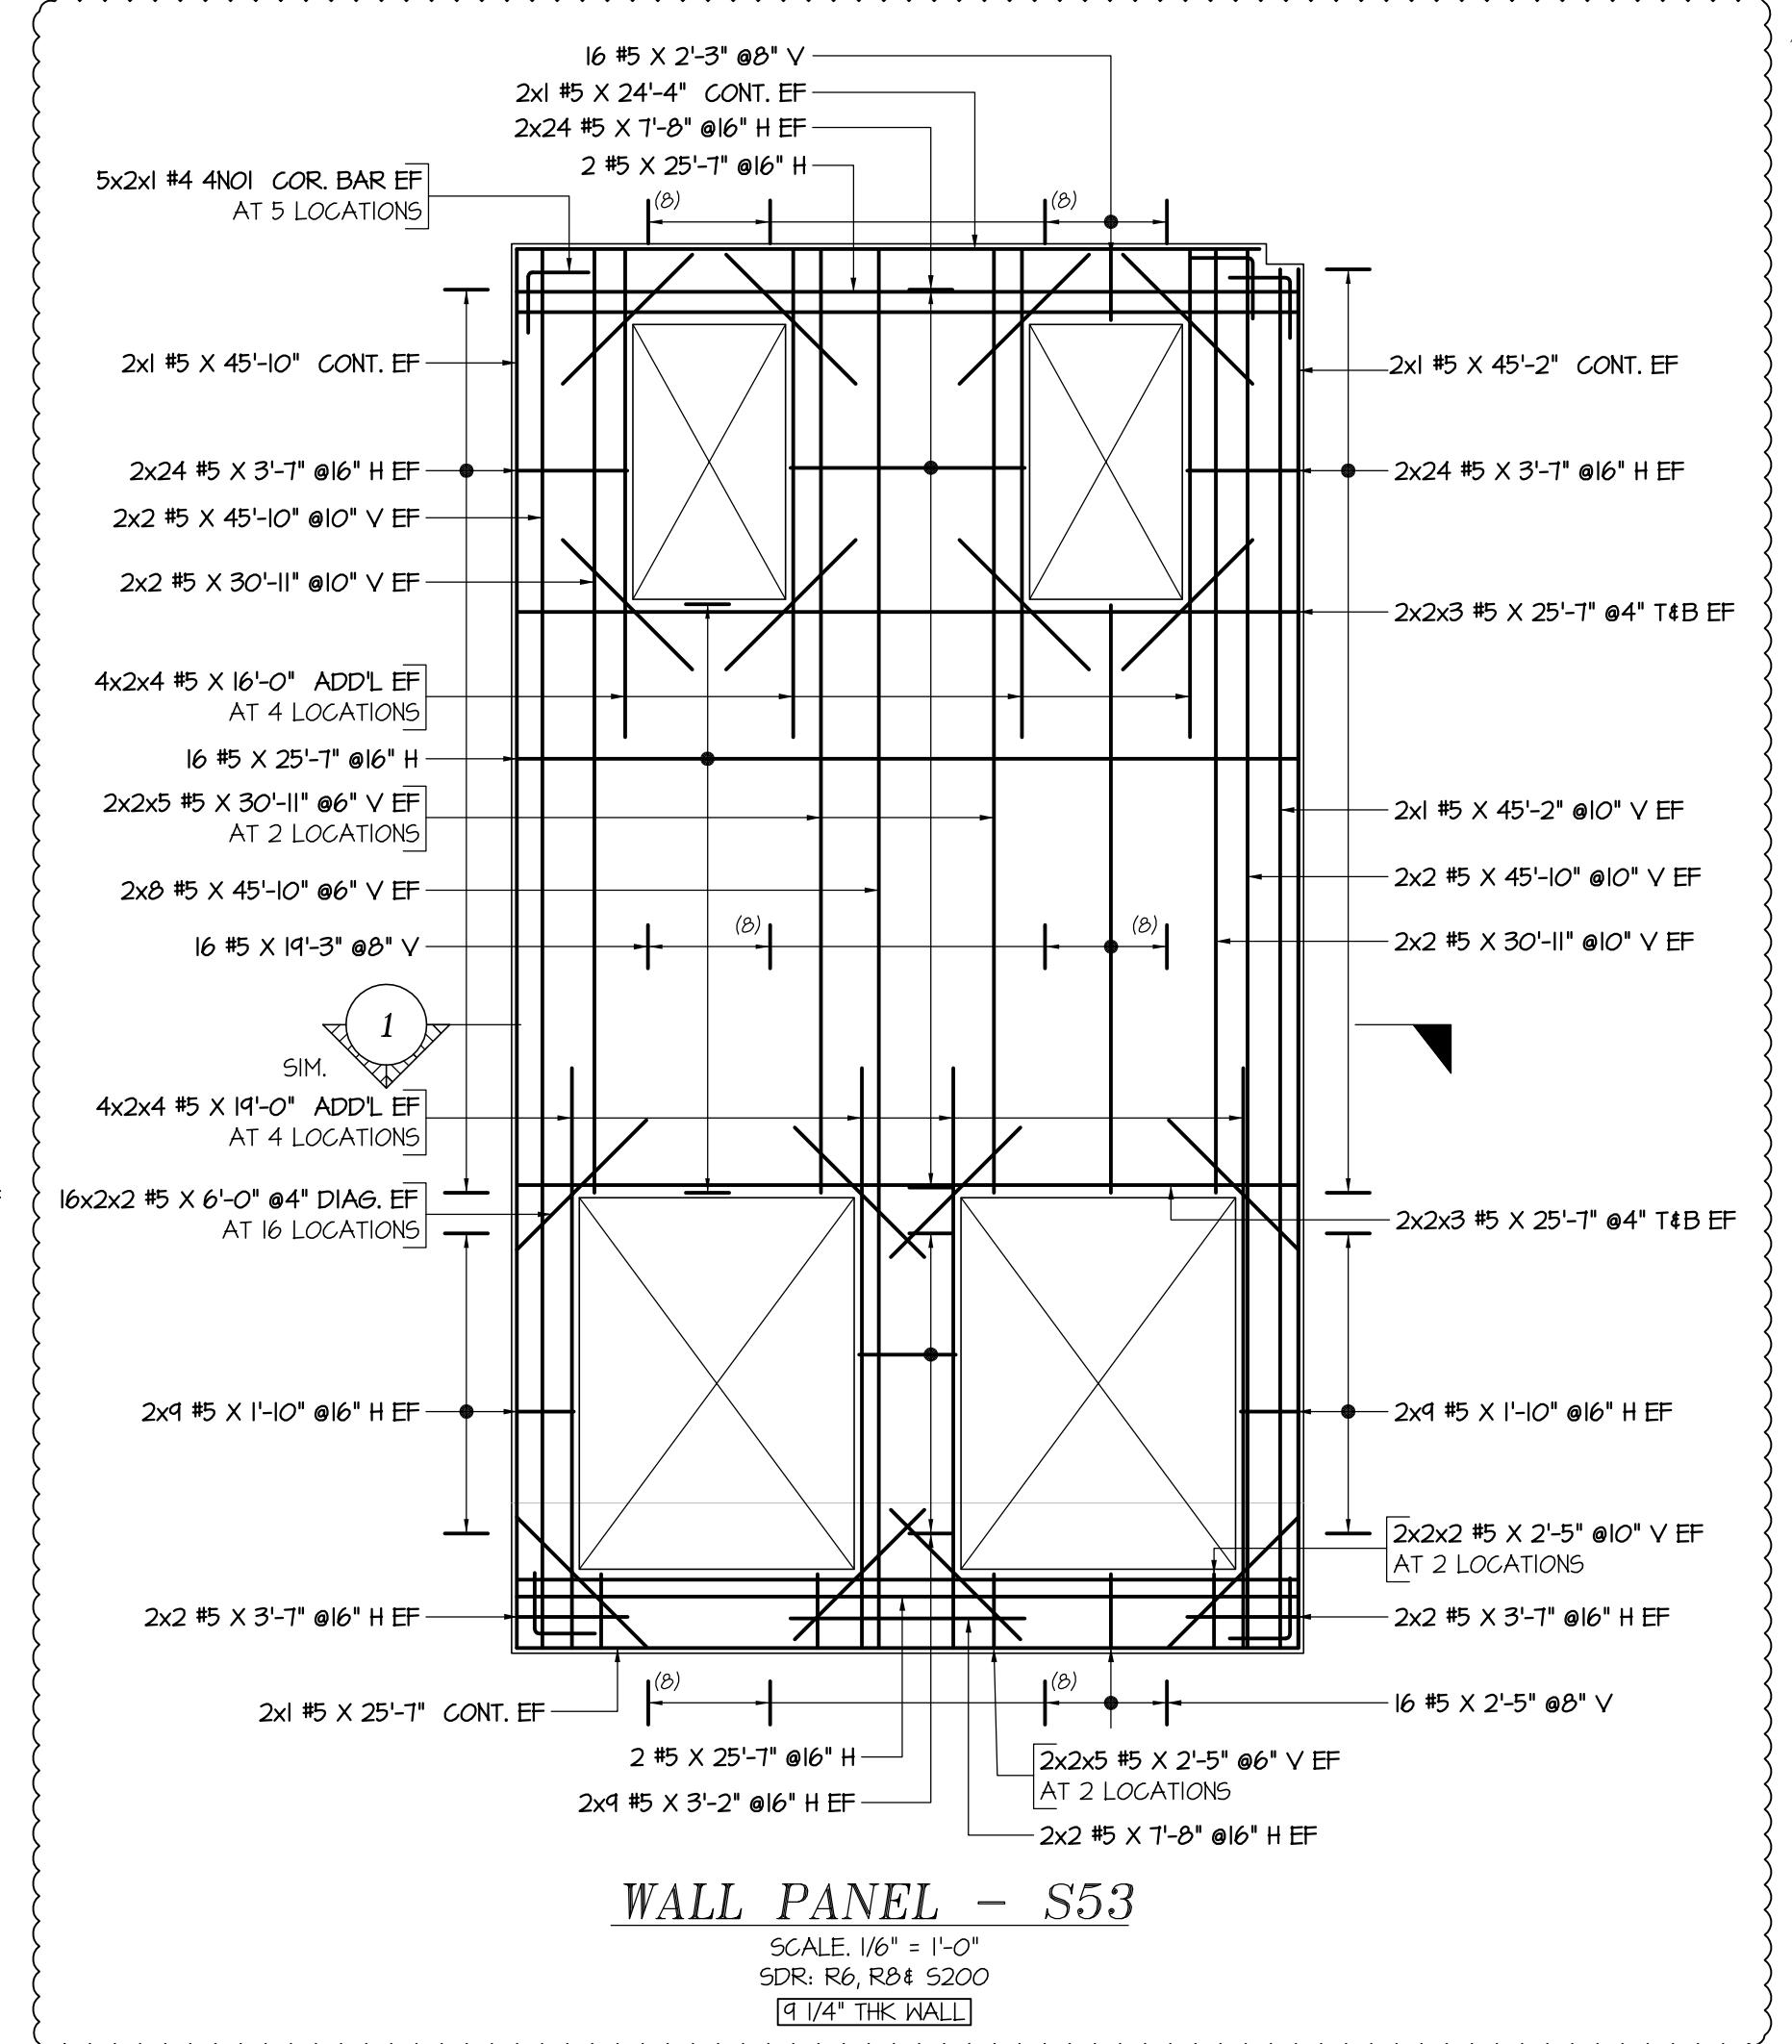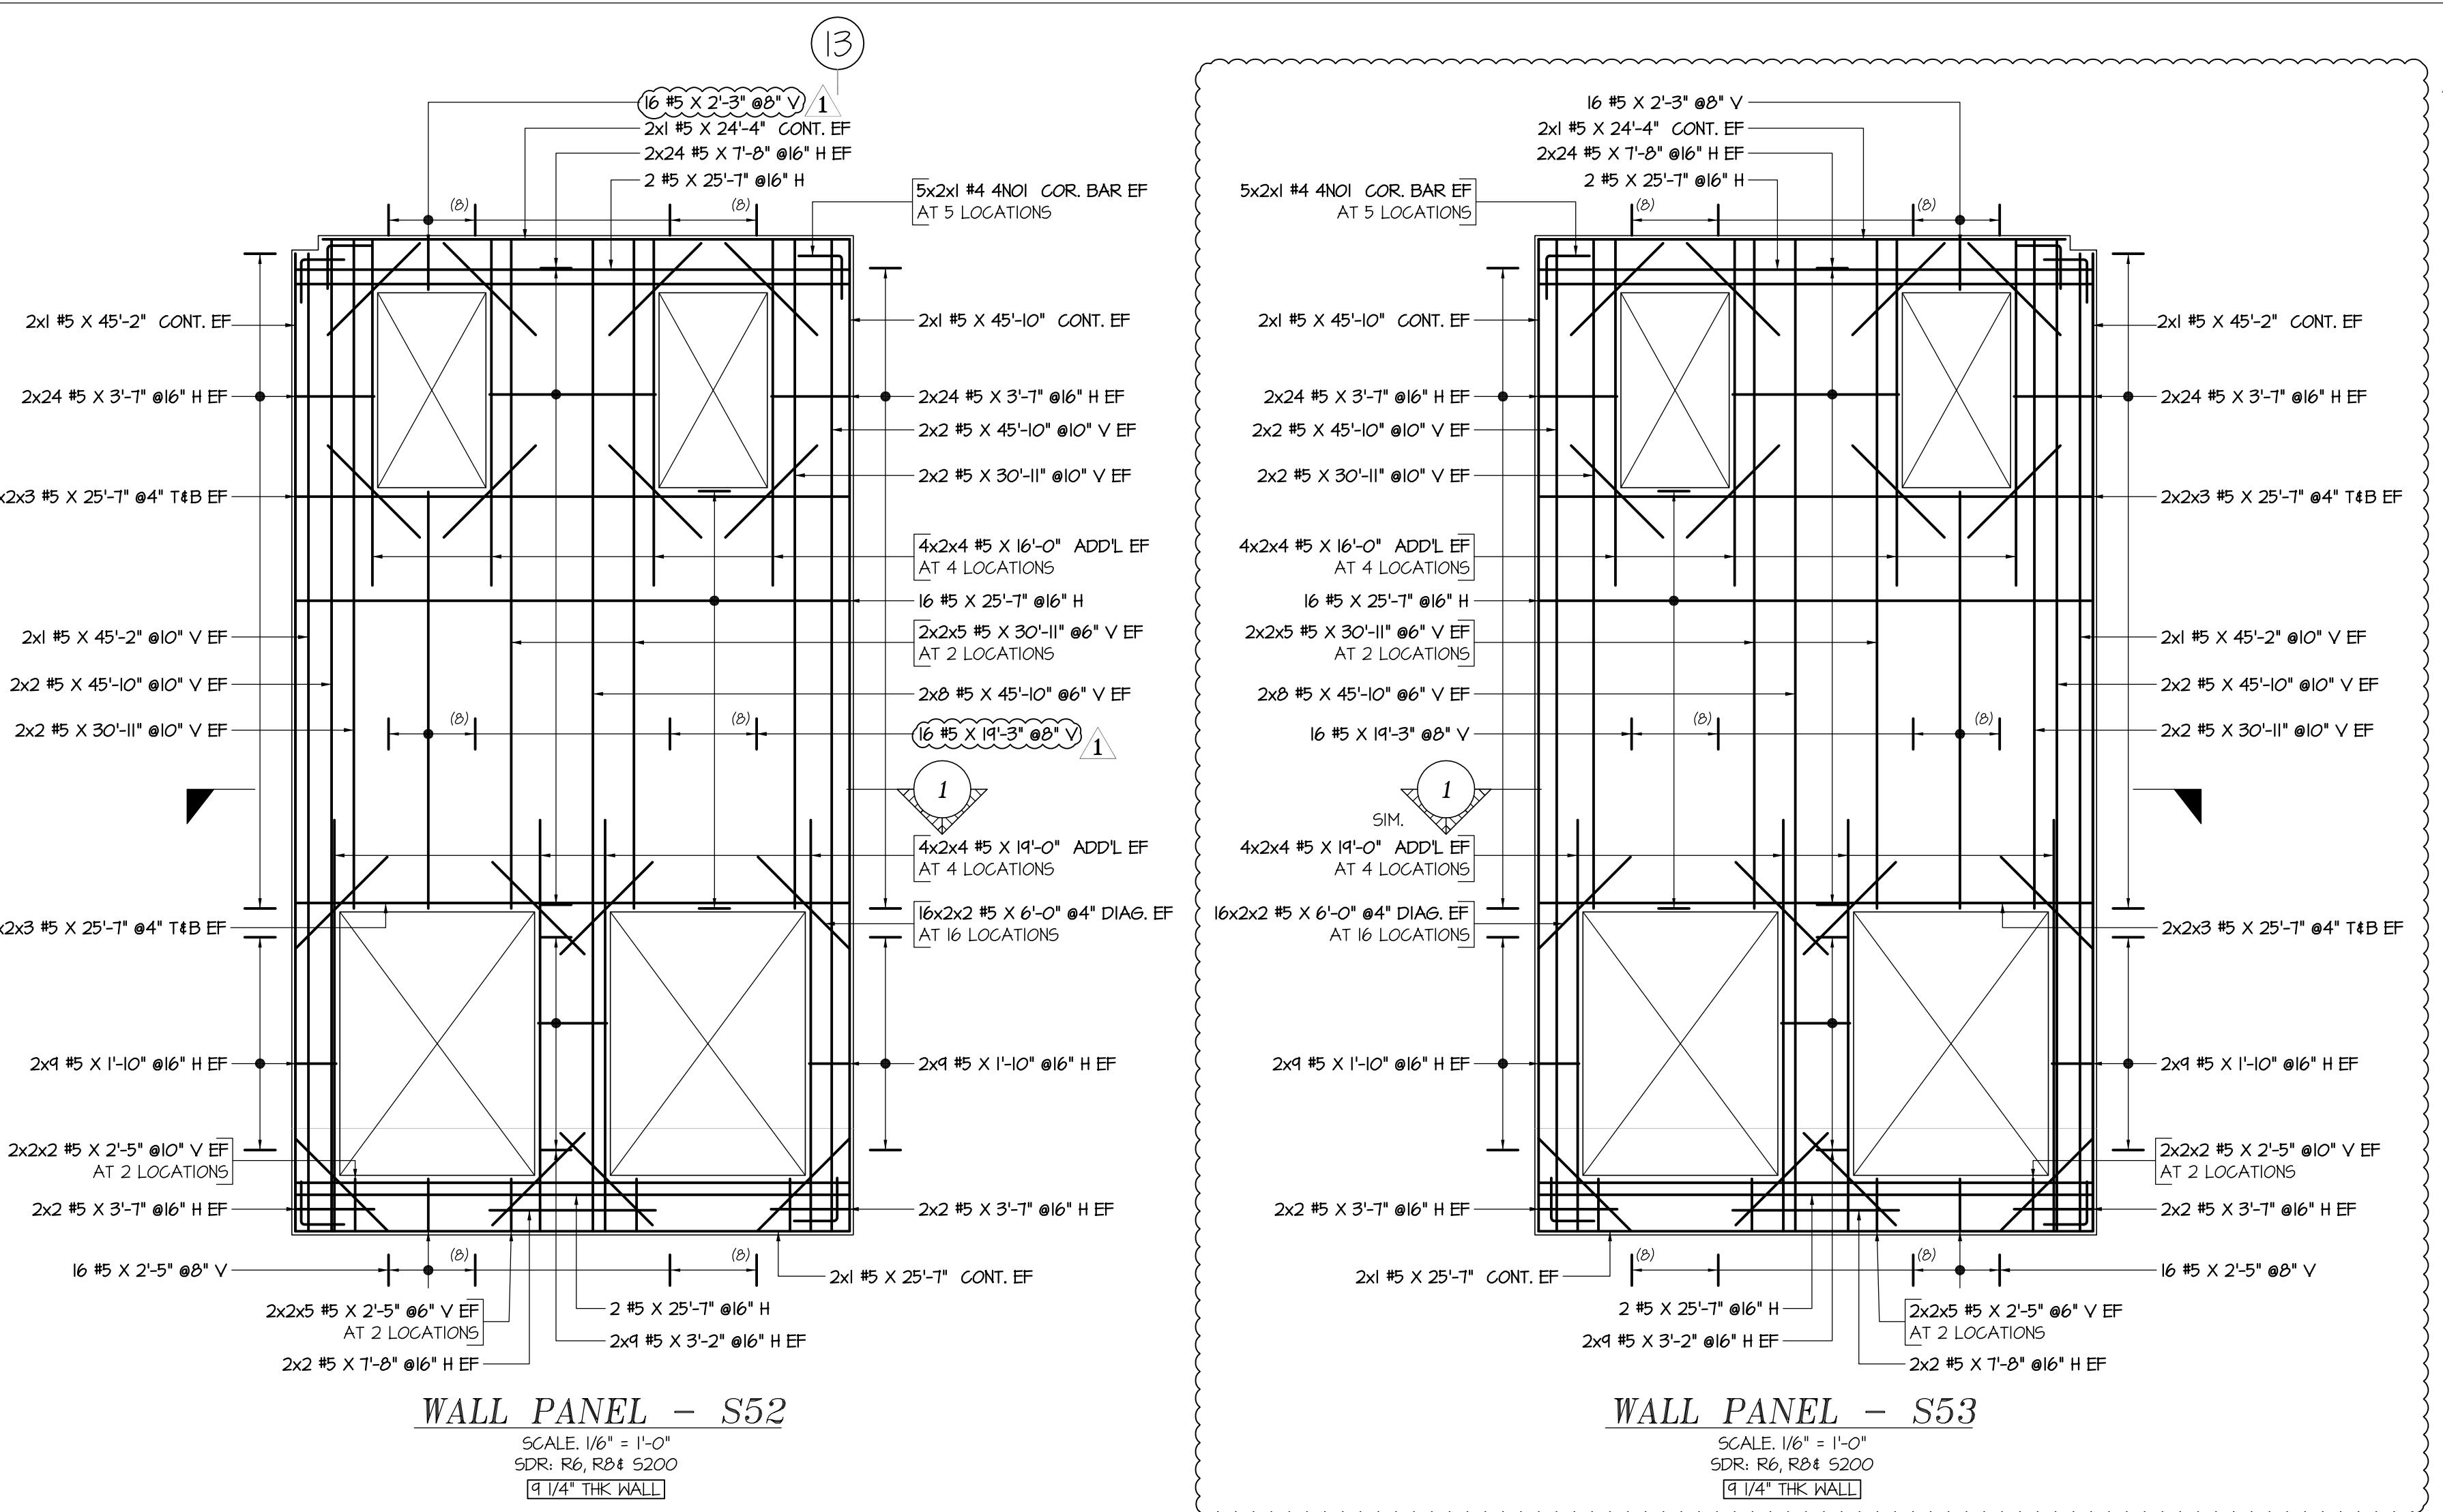


WALL PANEL - S56

SCALE: 1/8" = 1'-0"
SDR: R6, R8, R4 5200
(1/4" THK WALL)

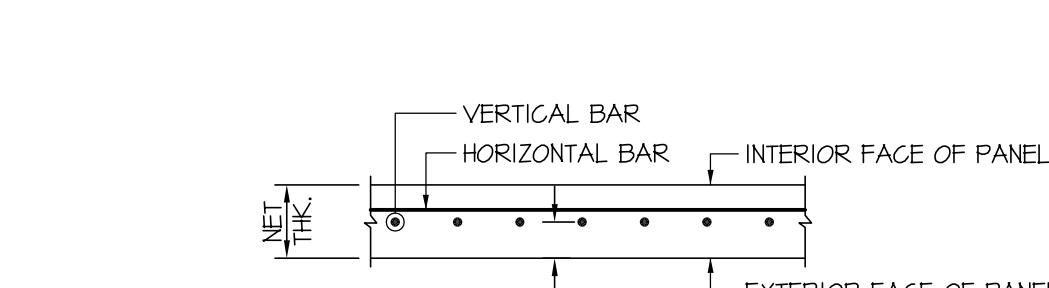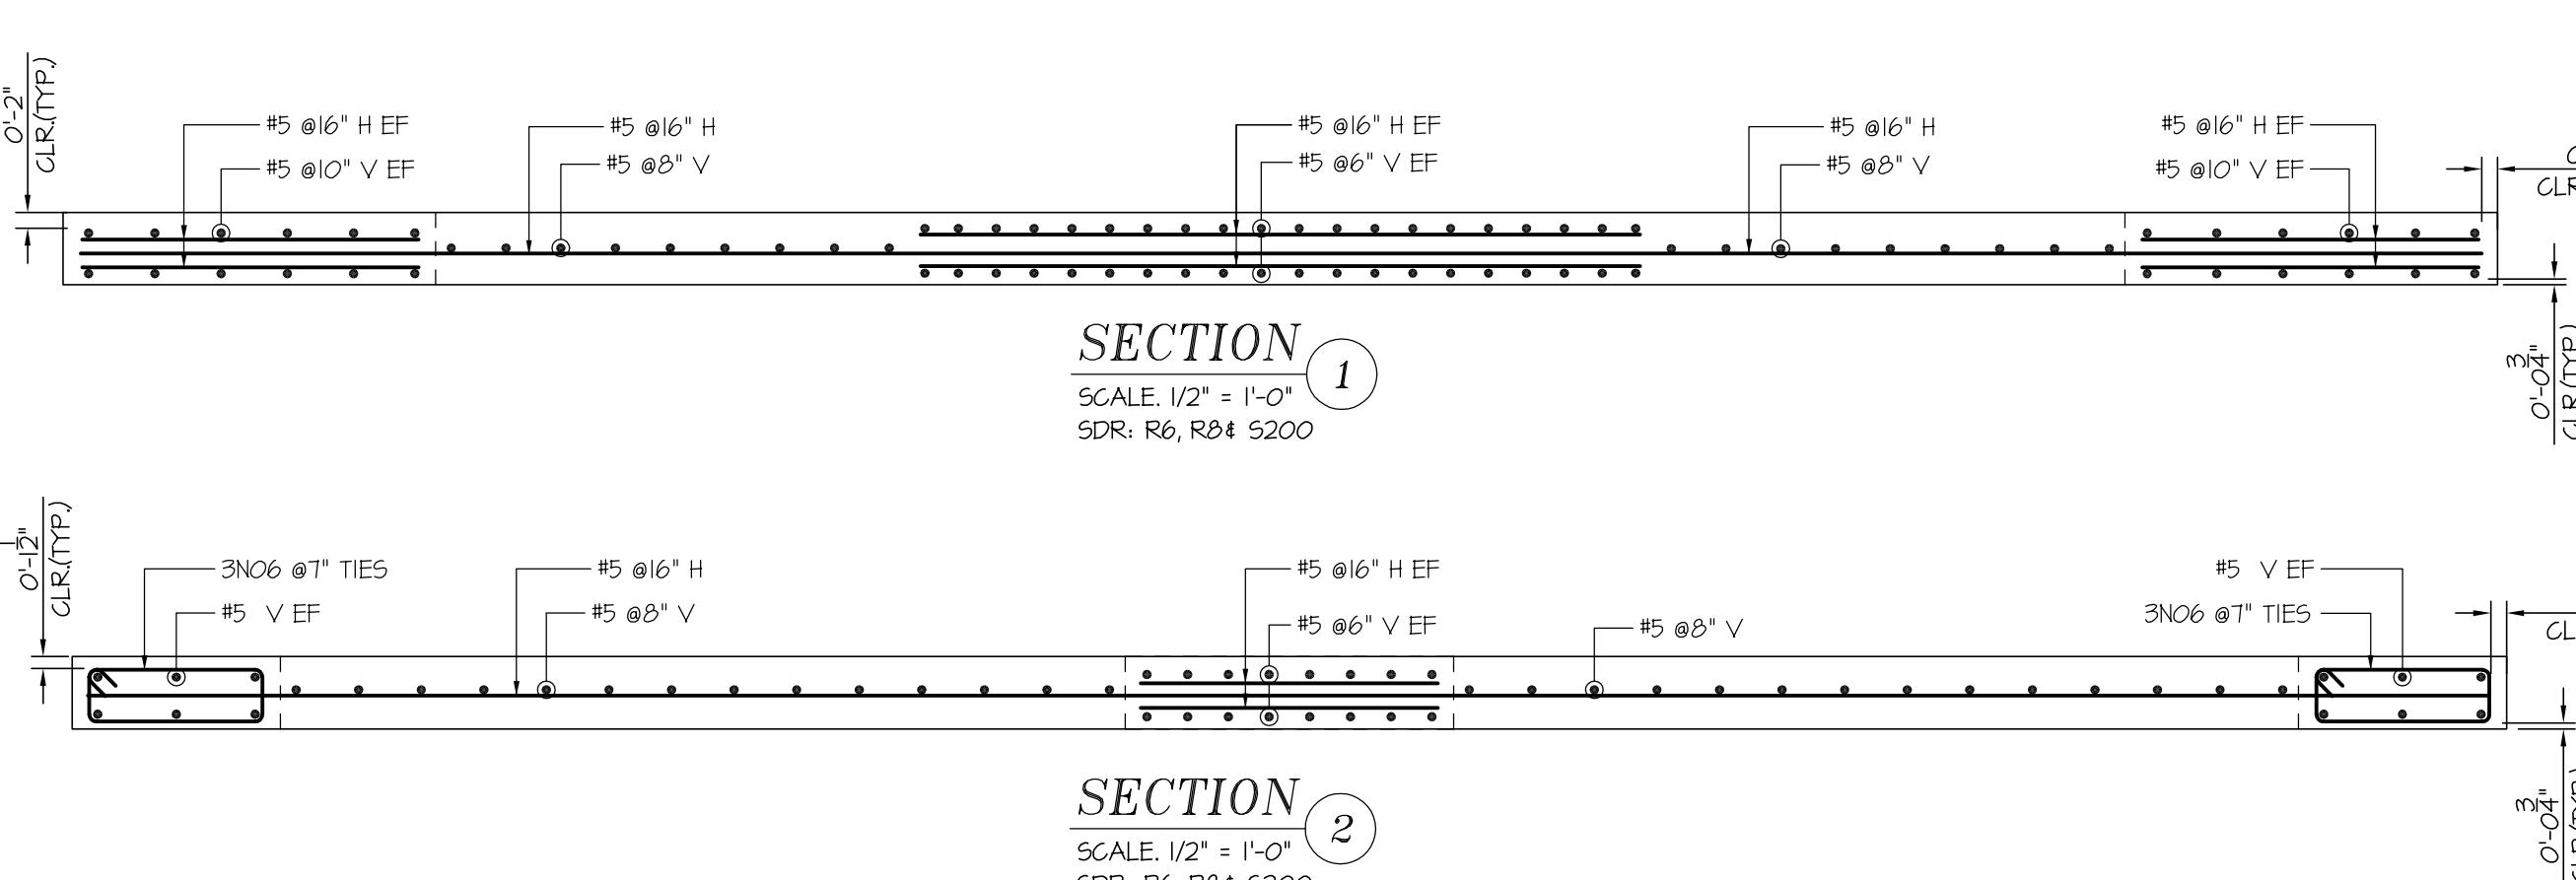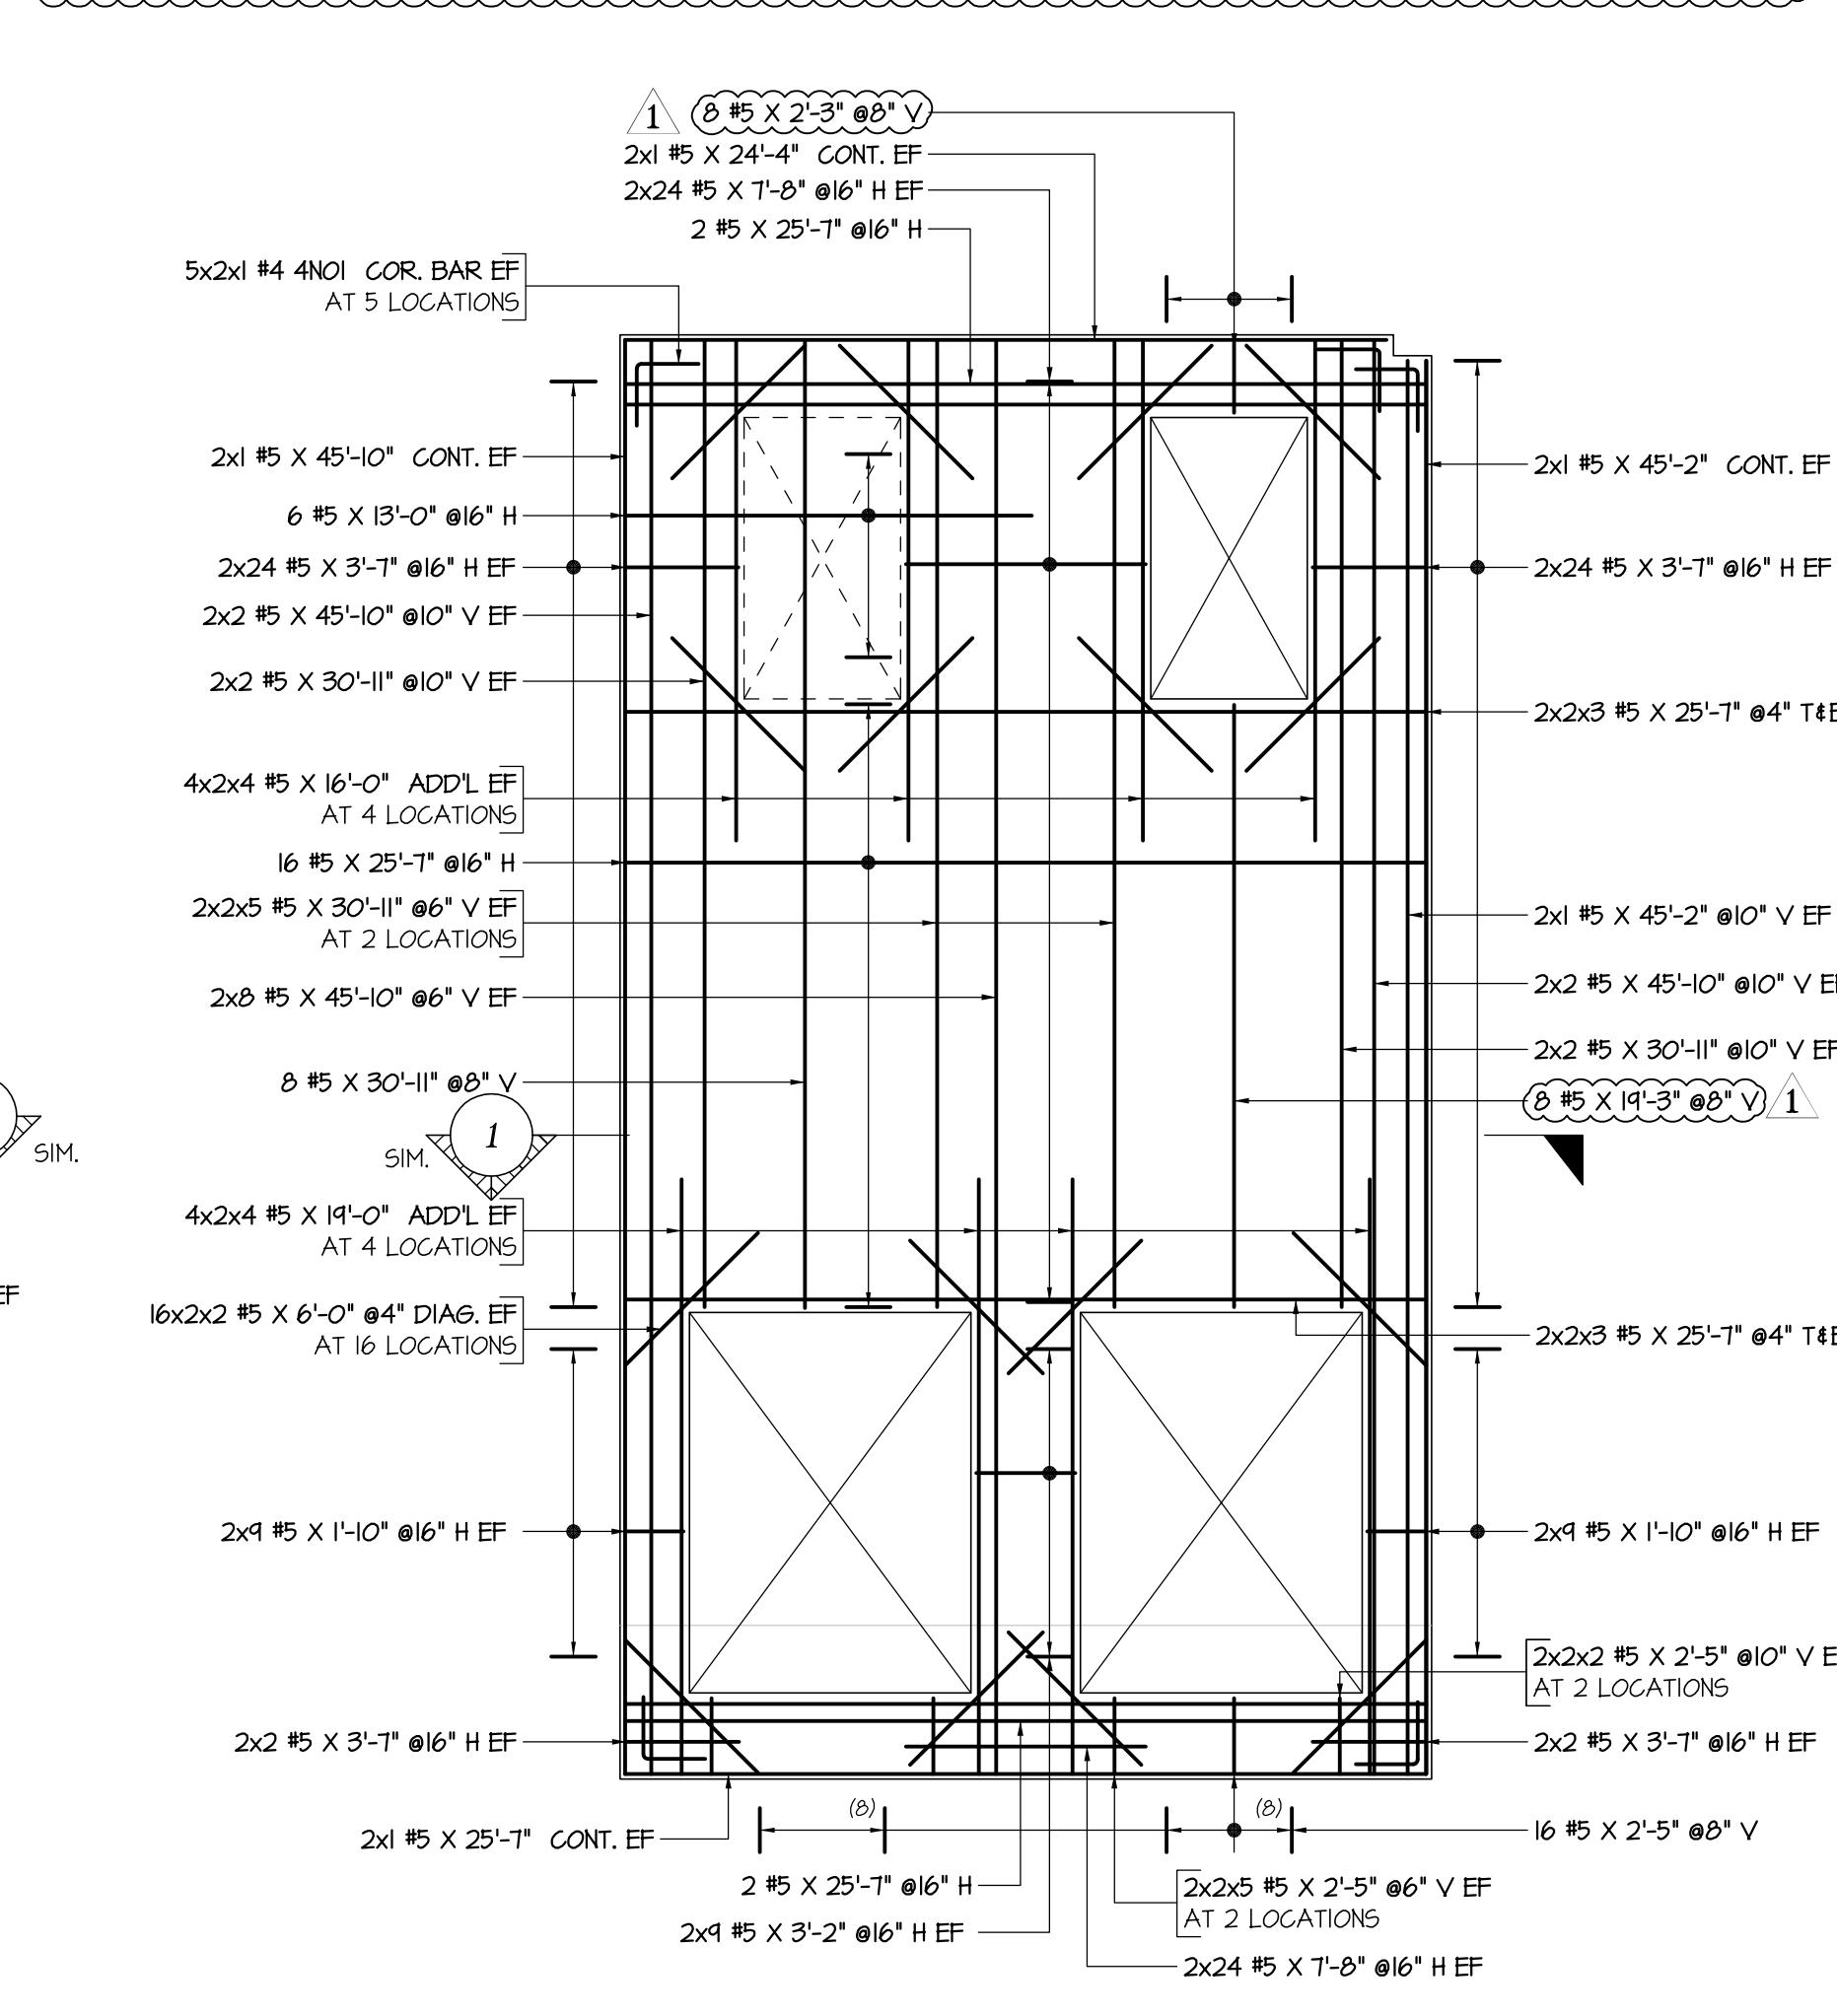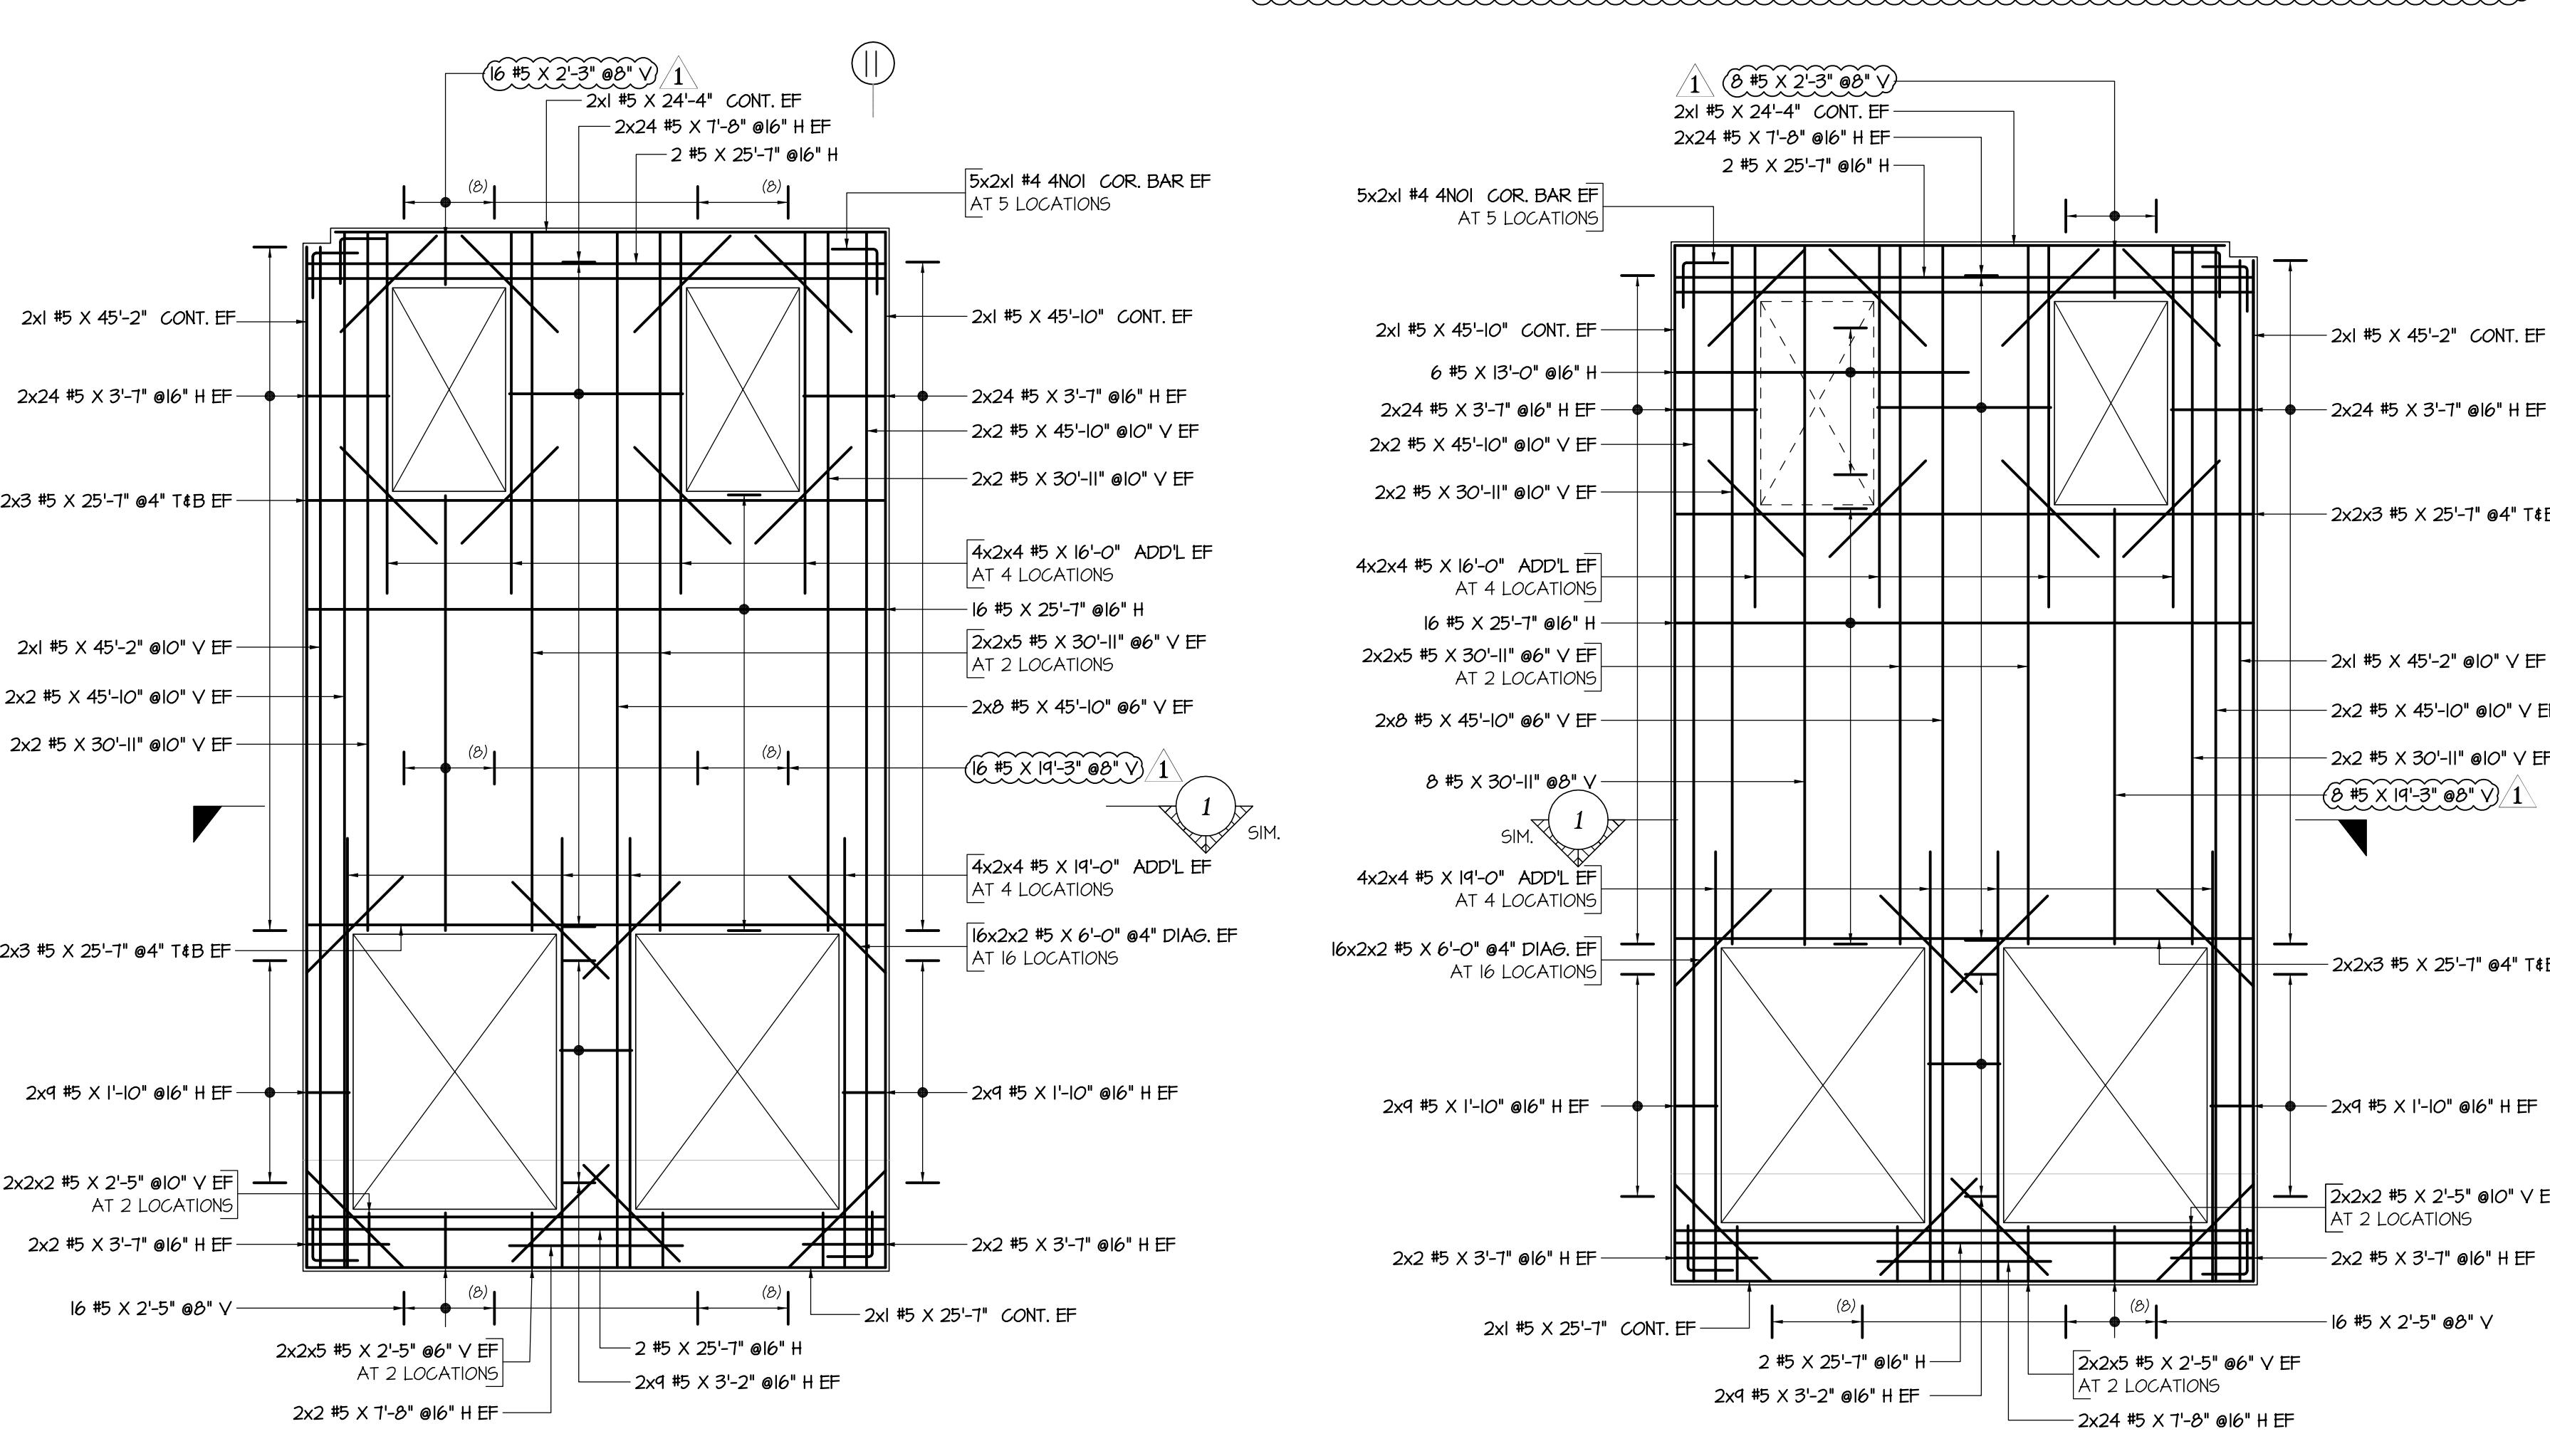

REBAR PLACEMENT FOR SINGLE LAYERS

SCALE: 1/2" = 1'-0"
SDR: R8

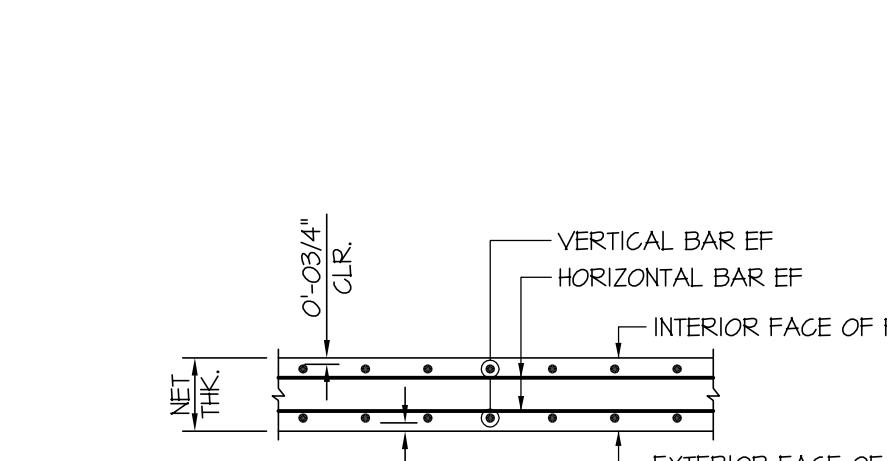



REBAR PLACEMENT FOR DOUBLE LAYERS

SCALE: 1/2" = 1'-0"
SDR: R8

Drawing Sheet: R-25										BENDING DETAILS									
Bar Mark	Oy	Size	Total Length	Type	X'	Y'	Z'	Y'	Z'	Bar Mark	Oy	Size	Total Length	Type	X'	Y'	Z'	Y'	Z'
SN06	32	#3	5'-7 1/2"	T1	0'-4 X'	1'-10 X'	0'-7"	1'-10 X'	0'-7"	AN01	48	#4	4'-0"	T17	2'-0"	2'-0"	2'-0"	2'-0"	2'-0"

SOUTH WALL PANELS PLACING DRAWING REFERENCE									
DWG.NO:	DRAWING DESCRIPTION								
R-18	SOUTH WALL PANELS S-1 TO S-8								
R-19	SOUTH WALL PANELS S-9 TO S-15								
R-20	SOUTH WALL PANELS S-16 TO S-22								
R-21	SOUTH WALL PANELS S-23 TO S-30								
R-22	SOUTH WALL PANELS S-31 TO S-37								
R-23	SOUTH WALL PANELS S-38 TO S-44								
R-24	SOUTH WALL PANELS S-45 TO S-51								
R-25	SOUTH WALL PANELS S-52 TO S-58								
R-26	SOUTH WALL PANELS S-59 TO S-66								
R-27	SOUTH WALL PANELS S-67 TO S-73								
R-28	SOUTH WALL PANELS S-74 TO S-80								

STRUCTURAL NOTES									
LEGENDS					LABEL LEGENDS				
T - TOP					B - BOTTOM				
V - VERT - VERTICAL					H - HORIZ - HORIZONTAL				
CLR - CLEAR COVER					SPAC - SPACING				
SIM - SIMILAR					BAR MARK - BAR MARK				
TYP. - TYPICAL					BAR SIZE - BAR SIZE				
T.MAT - TOP OF MAT					NUMBER OF BARS - EACH SIDE				
EF - EACH FACE					COR - CORNER				
CONT - CONTINUOUS					THICK - THICKNESS				
ADDL - ADDITIONAL					DIAG - DIAGONAL				
NTS - NOT TO SCALE					CL - CENTER LINE				
SDR - STRUCTURAL DRAWING					REFERENCE - REFERENCE				
WALL PANEL					2" - AT ENDS				
					1 1/2" - #4 BELOW EXTERIOR FACE				
					2" - #6 ABOVE EXTERIOR FACE				
					3/4" - AT INTERIOR FACE				
REINFORCING STEEL PLACING DRAWING ONLY. USE IN CONJUNCTION WITH CONTRACT DRAWINGS & SPECIFICATIONS. ELEVATIONS & DIMENSIONS SHOWN ON THIS DRAWING ARE FOR DETAILING PURPOSES ONLY AND SHOULD NOT BE USED FOR CONSTRUCTION UNLESS VERIFIED BY ENGINEER OR CONTRACTOR.									

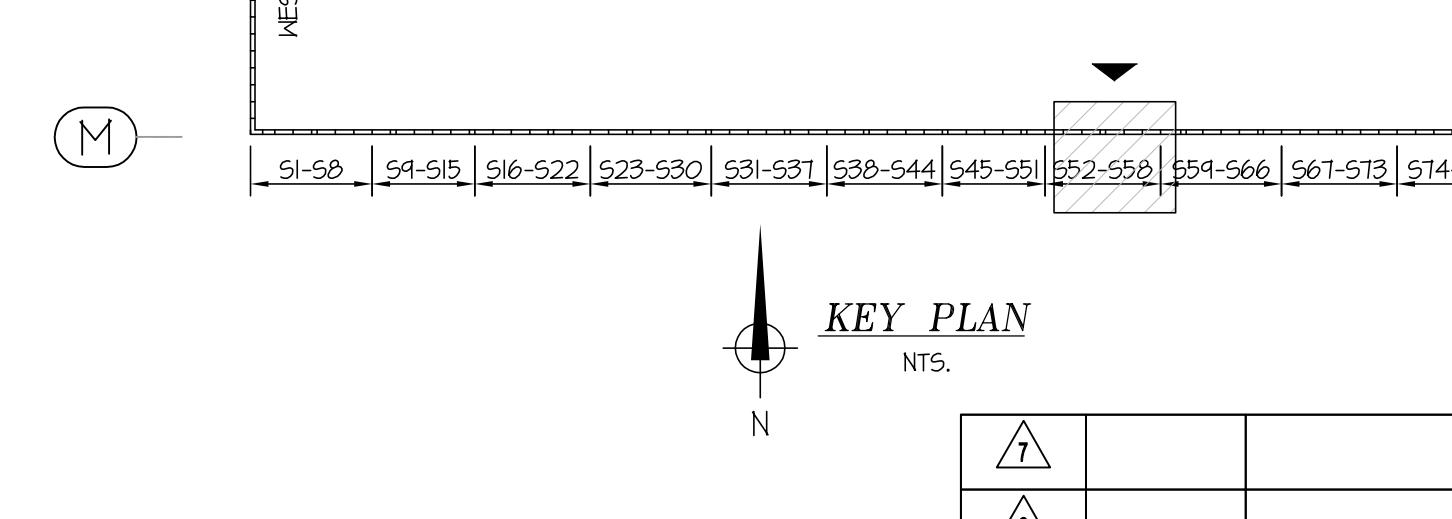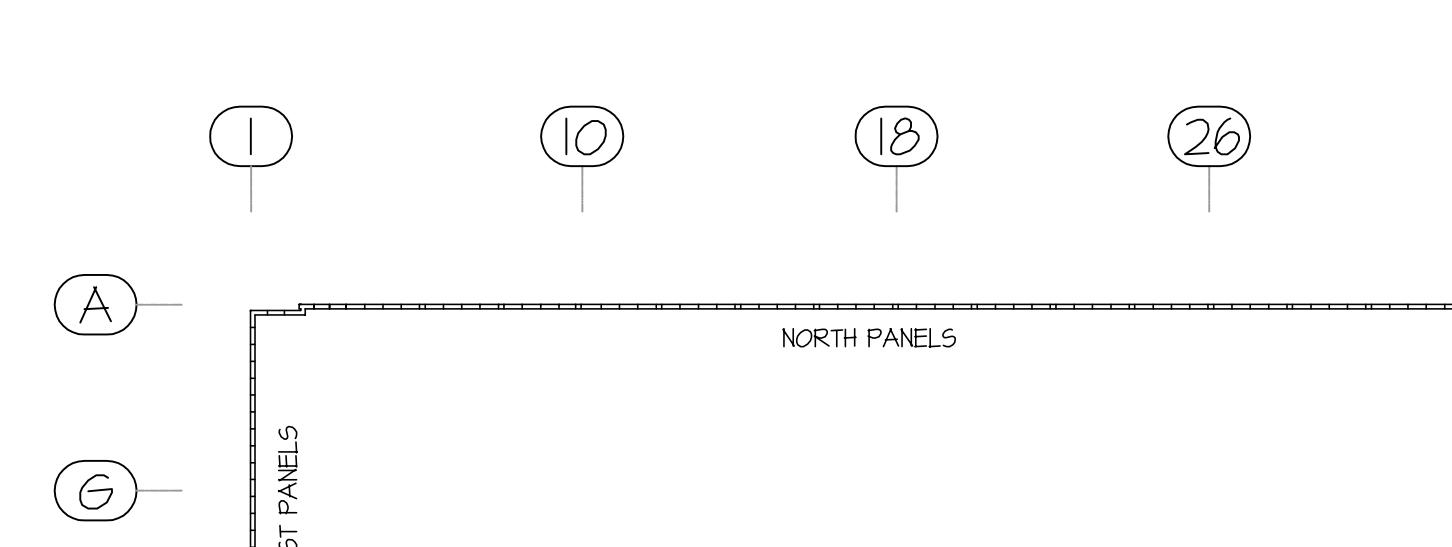

7	6	5	4	3	2	06.14.2019	RE SUBMITTED FOR APPROVAL
6	5	4	3	2	06.29.2019	APPROVAL DATE	SENT FOR
5	4	3	2	06.29.2019	DATE		
4	3	2	06.29.2019				
3	2	06.29.2019					
2	06.29.2019						
1	05.29.2019						

RE-STEEL SUPPLY CO., INC.
REINFORCING STEEL - WIRE MESH
2000 Eddystone Industrial Park • Eddystone, PA 19022-1588
Phone: 800-876-8216 • Fax: 610-876-8428

STRUCTURE: VALLEY VIEW BUSINESS PARK TILT PANELS

Location: JESSUP, PA

Architect: KSS ARCHITECTS

Engineer: RICHARD ADAMS

Customer: T&T CONSTRUCTION



Made by: PRO

Date: 05.29.2019

CONTRACT NO.: U2524

DRAWING COVERS: SOUTH WALL PANELS S-52 TO S-58

DRAWING NO.: R-25

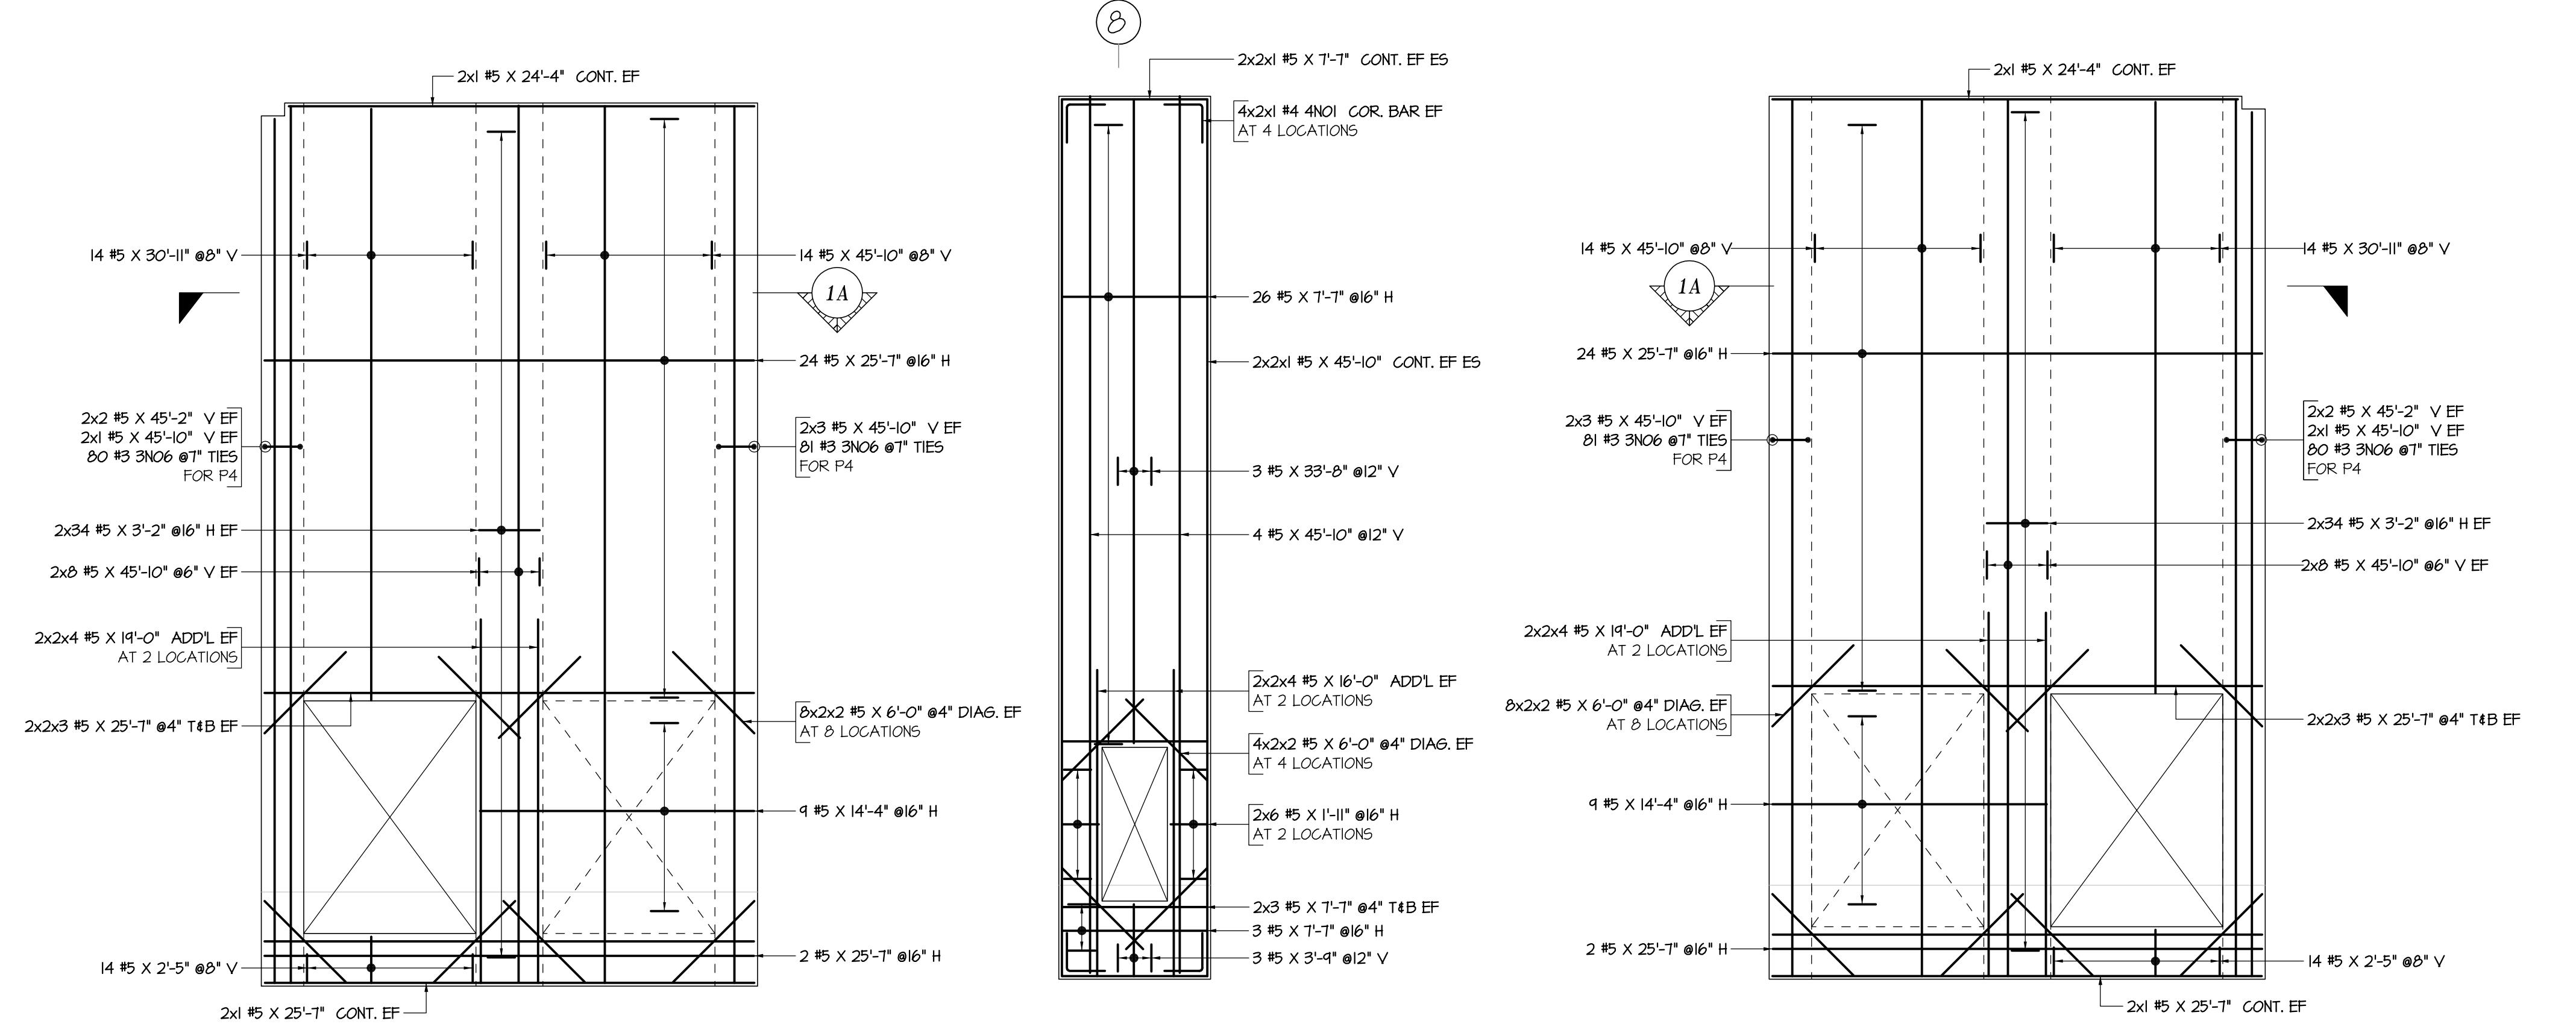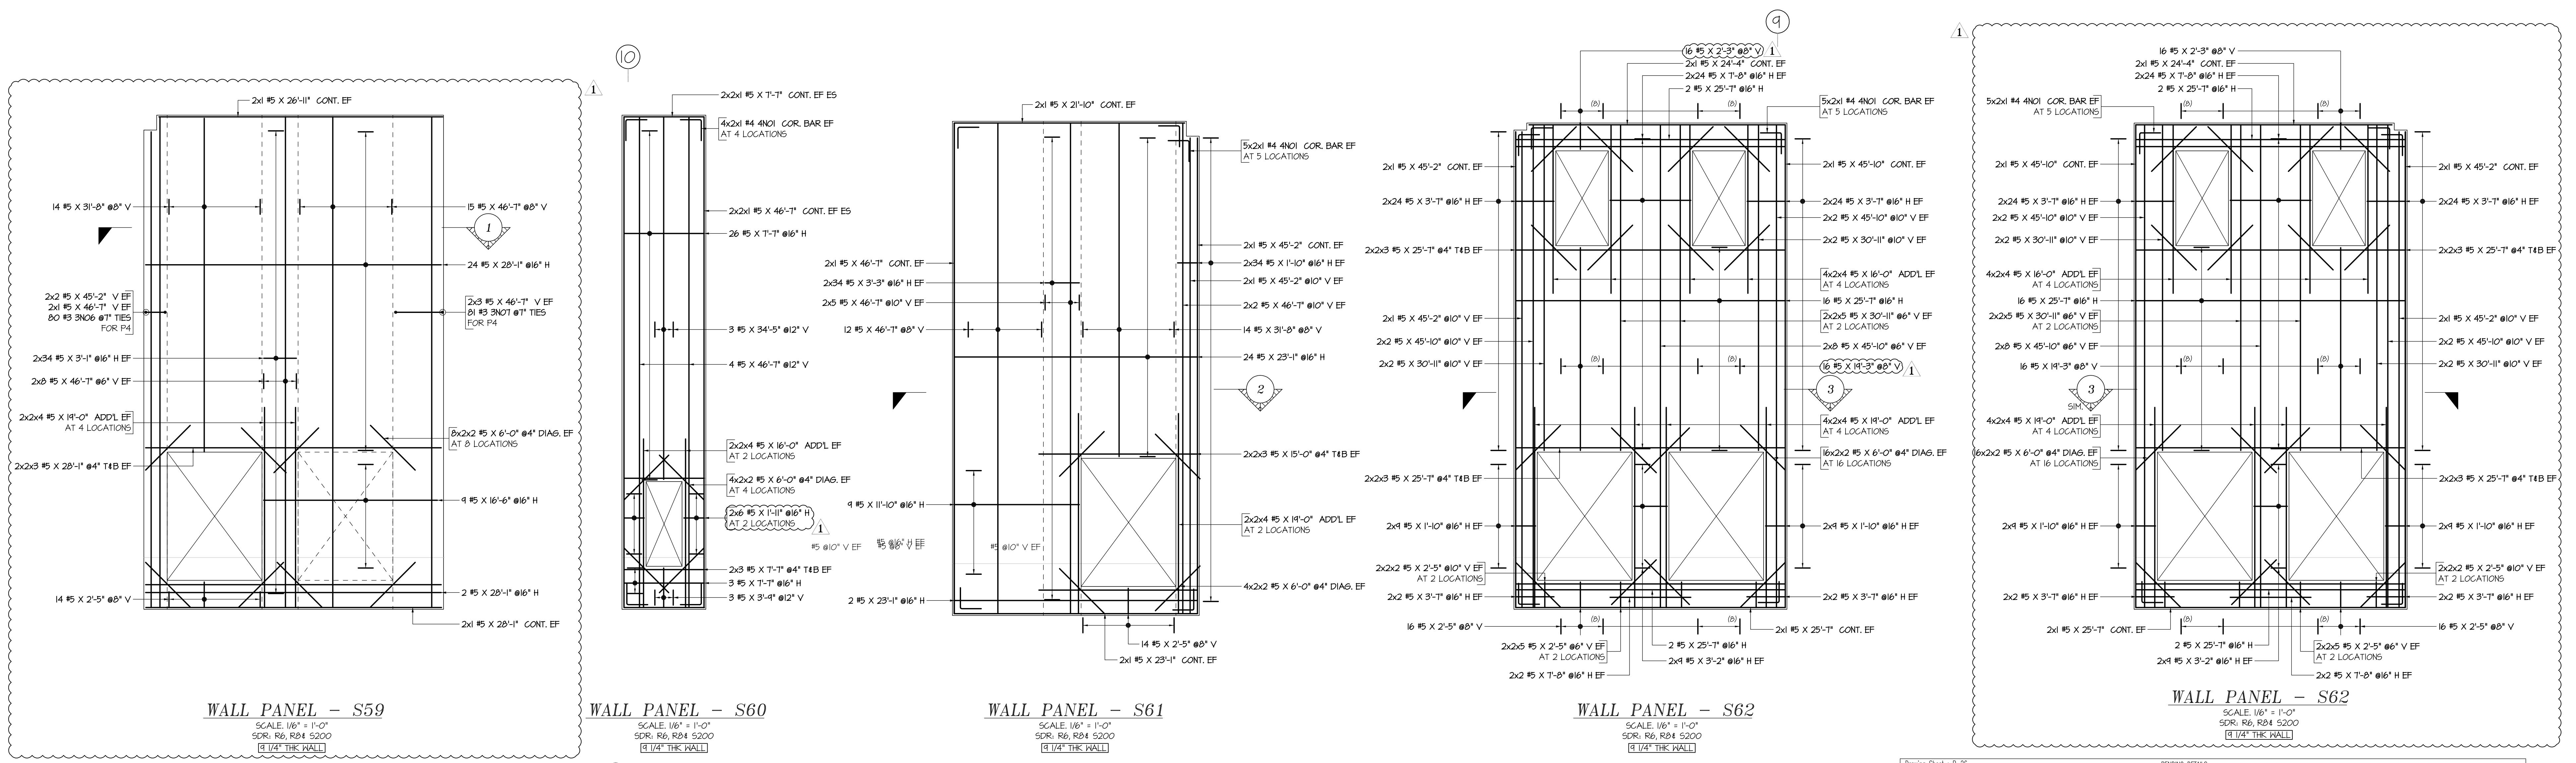


Drawing Sheet : R-76									
BENDING DETAILS									
Bir. Mark	Oy	Size	Total Length	Type	X'	Y'	Z'	T'	V'
SN06	402	#3	5'-7 1/2"	T1	0'-4 1/2"	1'-10 1/2"	0'-7"	1'-10 1/2"	0'-7"
SN07	81	#3	10'-10"	T1	0'-4 1/2"	4'-5 1/2"	0'-7"	4'-5 1/2"	0'-7"
4N01	46	#4	4'-0"	L7	2'-0"	2'-0"	2'-0"	2'-0"	2'-0"

Drawing Sheet : R-76									
BENDING DETAILS									
Bir. Mark	Oy	Size	Total Length	Type	X'	Y'	Z'	T'	V'
SN06	402	#3	5'-7 1/2"	T1	0'-4 1/2"	1'-10 1/2"	0'-7"	1'-10 1/2"	0'-7"
SN07	81	#3	10'-10"	T1	0'-4 1/2"	4'-5 1/2"	0'-7"	4'-5 1/2"	0'-7"
4N01	46	#4	4'-0"	L7	2'-0"	2'-0"	2'-0"	2'-0"	2'-0"

SOUTH WALL PANELS PLACING DRAWING REFERENCE									
DWG.NO:	DRAWING DESCRIPTION	NOTES							
R-18	SOUTH WALL PANELS S-1 TO S-8								
R-19	SOUTH WALL PANELS S-9 TO S-15								
R-20	SOUTH WALL PANELS S-16 TO S-22								
R-21	SOUTH WALL PANELS S-23 TO S-30								
R-22	SOUTH WALL PANELS S-31 TO S-37								
R-23	SOUTH WALL PANELS S-38 TO S-44								
R-24	SOUTH WALL PANELS S-45 TO S-51								
R-25	SOUTH WALL PANELS S-52 TO S-58								
R-26	SOUTH WALL PANELS S-59 TO S-66								
R-27	SOUTH WALL PANELS S-67 TO S-73								
R-28	SOUTH WALL PANELS S-74 TO S-80								


STRUCTURAL NOTES									
LABEL LEGENDS									
T	- TOP	6x2x6 #4 4C04 @12" B2							
B	- BOTTOM								
V	VERT.								
H	HORIZ.								
CLR.	CLEAR COVER								
SIM.	SIMILAR								
TYP.	— TYPICAL								
T.MAT.	- TOP OF MAT								
E5	- EACH SIDE								
EF	- EACH FACE								
CONT	- CONTINUOUS								
COR.	- CORNER								
THK.	- THICKNESS								
ADDL.	- ADDITIONAL								
DIAG.	- DIAGONAL								
N.T.S.	- NOT TO SCALE								
C.E.	- CENTER LINE								
SDR.	- STRUCTURAL DRAWING								
	REFERENCE								
CLEAR COVER TO REINFORCEMENT									
WALL PANEL	2"	AT ENDS							
	1 1/2"	#5 @ 6" BELOW EXTERIOR FACE							
	2"	#6 @ 6" ABOVE EXTERIOR FACE							
	3/4"	AT INTERIOR FACE							

REINFORCING STEEL PLACING DRAWING ONLY. USE IN CONJUNCTION WITH CONTRACT DRAWINGS & SPECIFICATIONS. ELEVATIONS & DIMENSIONS SHOWN ON THIS DRAWING ARE FOR DETAILING PURPOSES ONLY AND SHOULD NOT BE USED FOR CONSTRUCTION UNLESS VERIFIED BY ENGINEER OR CONTRACTOR.

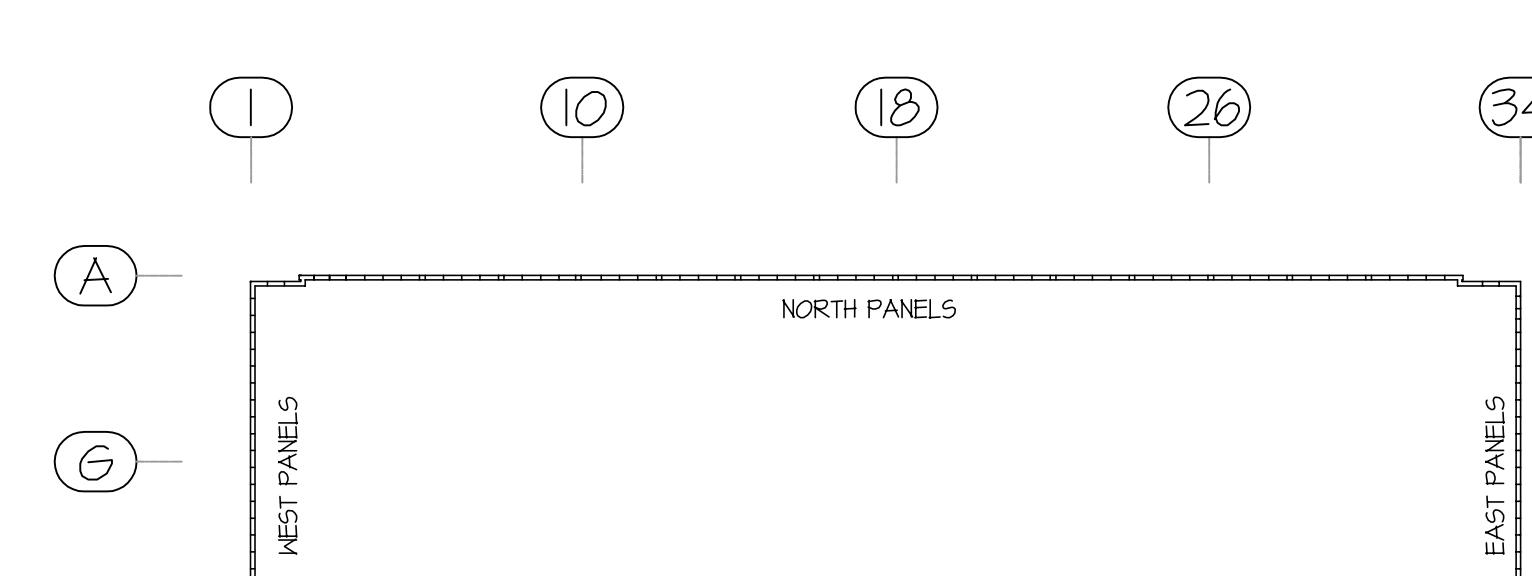

KEY PLAN	
1	10
2	18
3	26
4	34
A	North Panels
G	West Panels
M	East Panels
N	

7	6	5	4	3	2	06.14.2019	RE SUBMITTED FOR APPROVAL				
1	05.29.2019	APPROVAL DATE	SENT FOR								
RE-STEEL SUPPLY CO., INC. REINFORCING STEEL - WIRE MESH 2000 Eddystone Industrial Park • Eddystone, PA 19022-1588 Phone: 800-876-8216 • Fax: 610-876-8428						CONTRACT NO. U2524					
Location	JESSUP,PA	Architect	KSS ARCHITECTS	Engineer	RICHARD ADAMS	Customer	T&T CONSTRUCTION	Made by:	PRO	Date:	05.29.2019
REV. NO.	DATE	DESCRIPTION	REVISIONS	06.14.2019	REVISED AS PER LATEST C.D.'S RECEIVED ON 05.31.19	RECEIVED ON	05.31.19	DRAWING NO.	R-26		
DRAWING COVERS						SOUTH WALL PANELS S-59 TO S-66					

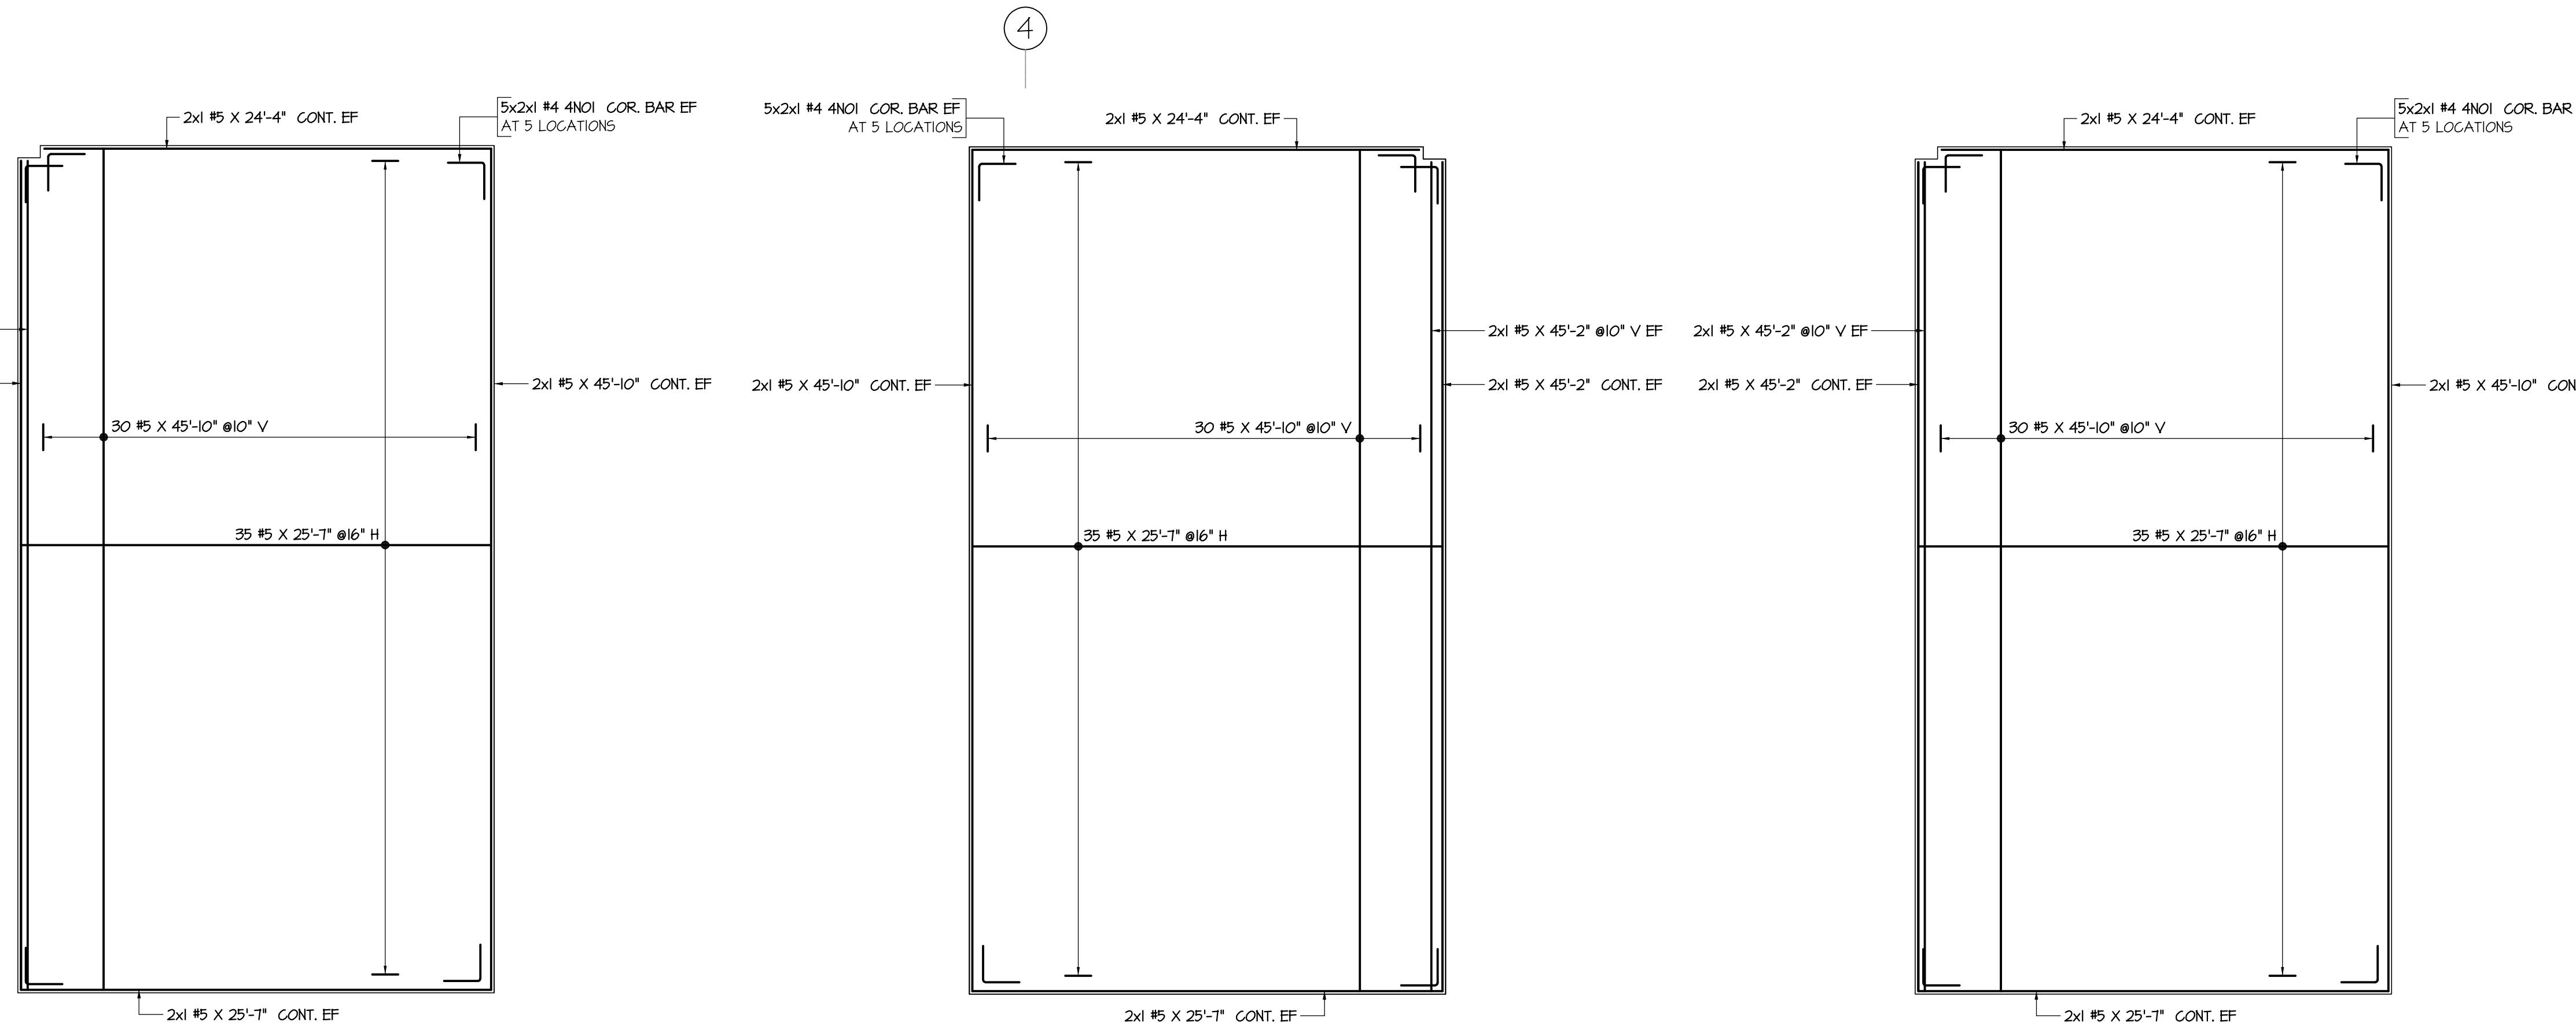

WALL PANEL - S74

SCALE: 1/6" = 1'-0"
SDR: R3, R8 & 5200
4 1/4" THK WALL

WALL PANEL - S75


SCALE: 1/6" = 1'-0"
SDR: R3, R8 & 5200
4 1/4" THK WALL

WALL PANEL - S76

SCALE: 1/6" = 1'-0"
SDR: R3, R8 & 5200
4 1/4" THK WALL

WALL PANEL - S77

SCALE: 1/6" = 1'-0"
SDR: R3, R8 & 5200
4 1/4" THK WALL

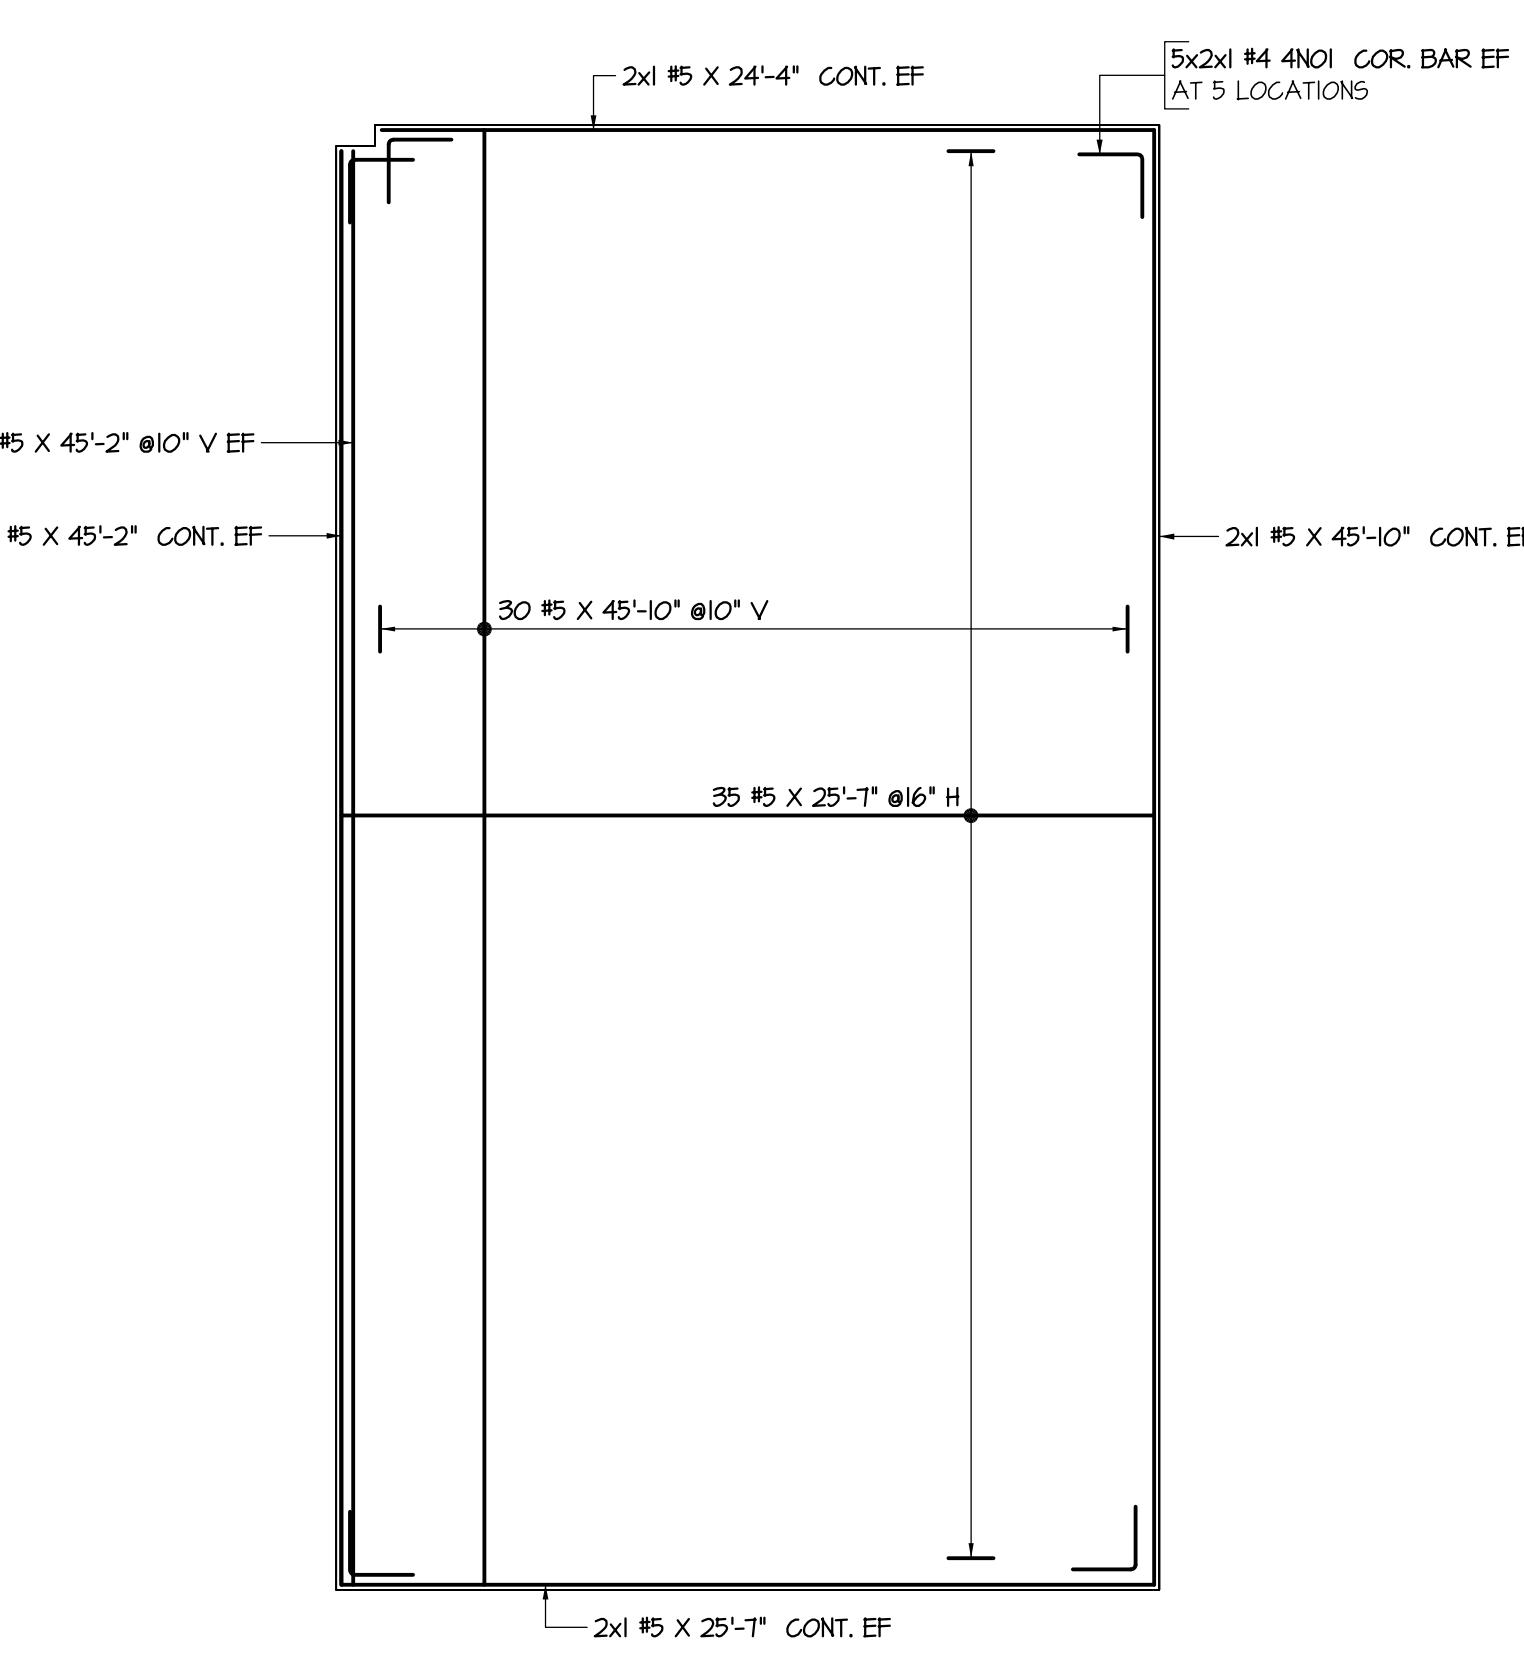

WALL PANEL - S78


SCALE: 1/6" = 1'-0"
SDR: R3, R8 & 5200
4 1/4" THK WALL

WALL PANEL - S79

SCALE: 1/6" = 1'-0"
SDR: R3, R8 & 5200
4 1/4" THK WALL


WALL PANEL - S80

SCALE: 1/6" = 1'-0"
SDR: R3, R8 & 5200
4 1/4" THK WALL

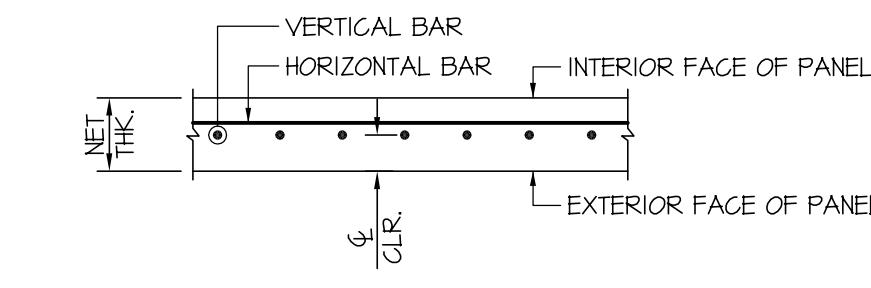

REBAR PLACEMENT FOR SINGLE LAYERS

SCALE: 1/2" = 1'-0"
SDR: R8

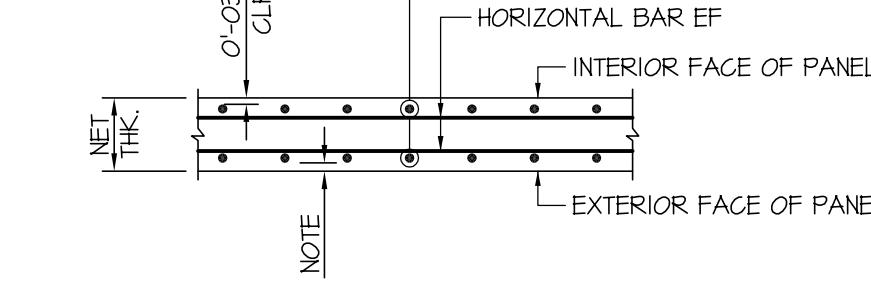

REBAR PLACEMENT FOR DOUBLE LAYERS

SCALE: 1/2" = 1'-0"
SDR: R8

Drawing Sheet : R-28		BENDING DETAILS																		
Bar Mark	Qty	Size	Total Length	Type	'A'	'B'	'C'	'D'	'E'	'F'	'G'	'H'	'I'	'J'	'K'	'L'	'M'	'N'	'O'	'P'
4NOL	68	#4	4'-0"	17																

SOUTH WALL PANELS PLACING DRAWING REFERENCE	
DWG.NO:	DRAWING DESCRIPTION
R-18	SOUTH WALL PANELS S-1 TO S-8
R-19	SOUTH WALL PANELS S-9 TO S-15
R-20	SOUTH WALL PANELS S-16 TO S-22
R-21	SOUTH WALL PANELS S-23 TO S-30
R-22	SOUTH WALL PANELS S-31 TO S-37
R-23	SOUTH WALL PANELS S-38 TO S-44
R-24	SOUTH WALL PANELS S-45 TO S-51
R-25	SOUTH WALL PANELS S-52 TO S-58
R-26	SOUTH WALL PANELS S-59 TO S-66
R-27	SOUTH WALL PANELS S-67 TO S-73
R-28	SOUTH WALL PANELS S-74 TO S-80



STRUCTURAL NOTES	
LEGENDS	LABEL LEGENDS
T - TOP	6x2x6 #4 4C09 @12' B2
B - BOTTOM	NOTES SPACING
V. VERT - VERTICAL	BAR MARK
H. HORIZ - HORIZONTAL	BAR SIZE
CLR - CLEAR COVER	NUMBER OF BARS
SM - SIMILAR	EACH FACE EACH SIDE
TYP. - TYPICAL	NUMBER OF LOCATION
T.O.MAT - TOP OF MAT	
ES - EACH SIDE	
EF - EACH FACE	
CONT - CONTINUOUS	
COR - CORNER	
THK. - THICKNESS	
ADDL - ADDITIONAL	
DIAG. - DIAGONAL	
NTS - NOT TO SCALE	
C - CENTER LINE	
SDR - STRUCTURAL DRAWING	
REFERENCE	
	DENOTES OPENINGS
	DENOTES KNOCK OUTS
CLEAR COVER TO REINFORCEMENT	
WALL PANEL	2" AT ENDS
	1 1/2" #6 & BELOW AT EXTERIOR FACE
	2" #6 & ABOVE AT EXTERIOR FACE
	3/4" AT INTERIOR FACE





REINFORCING STEEL PLACING DRAWING ONLY. USE IN CONJUNCTION WITH CONTRACT DRAWINGS & SPECIFICATIONS. ELEVATIONS & DIMENSIONS SHOWN ON THIS DRAWING ARE FOR DETAILING PURPOSES ONLY AND SHOULD NOT BE USED FOR CONSTRUCTION UNLESS VERIFIED BY ENGINEER OR CONTRACTOR.

7	
6	
5	
4	
3	
2	06.14.2019 RE SUBMITTED FOR APPROVAL
1	05.29.2019 APPROVAL DATE SENT FOR

RE-STEEL SUPPLY CO., INC.
REINFORCING STEEL - WIRE MESH
2000 Eddystone Industrial Park • Eddystone, PA 19022-1588
Phone: 800-876-8216 • Fax: 610-876-8428










Structure	VALLEY VIEW BUSINESS PARK TILT PANELS
Location	JESSUP,PA
Architect	KSS ARCHITECTS
Engineer	RICHARD ADAMS
Customer	T&T CONSTRUCTION
Made by:	Date: PRO 05.29.2019
REV. NO.	CONTRACT NO. U2524
DRAWING COVERS	
SOUTH WALL PANELS S-74 TO S-80	
REV. NO.	DRAWING NO. R-28
DATE	
DESCRIPTION	

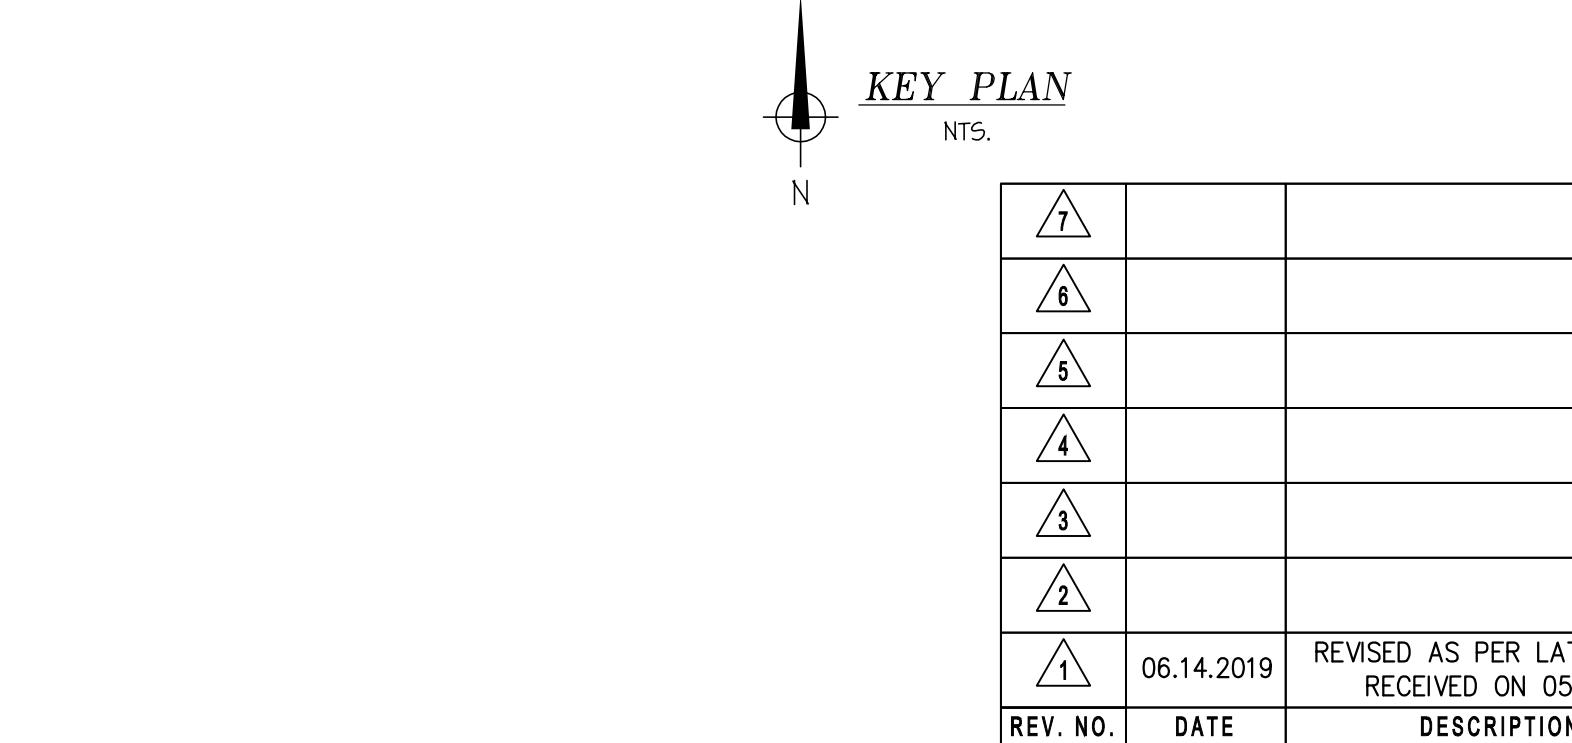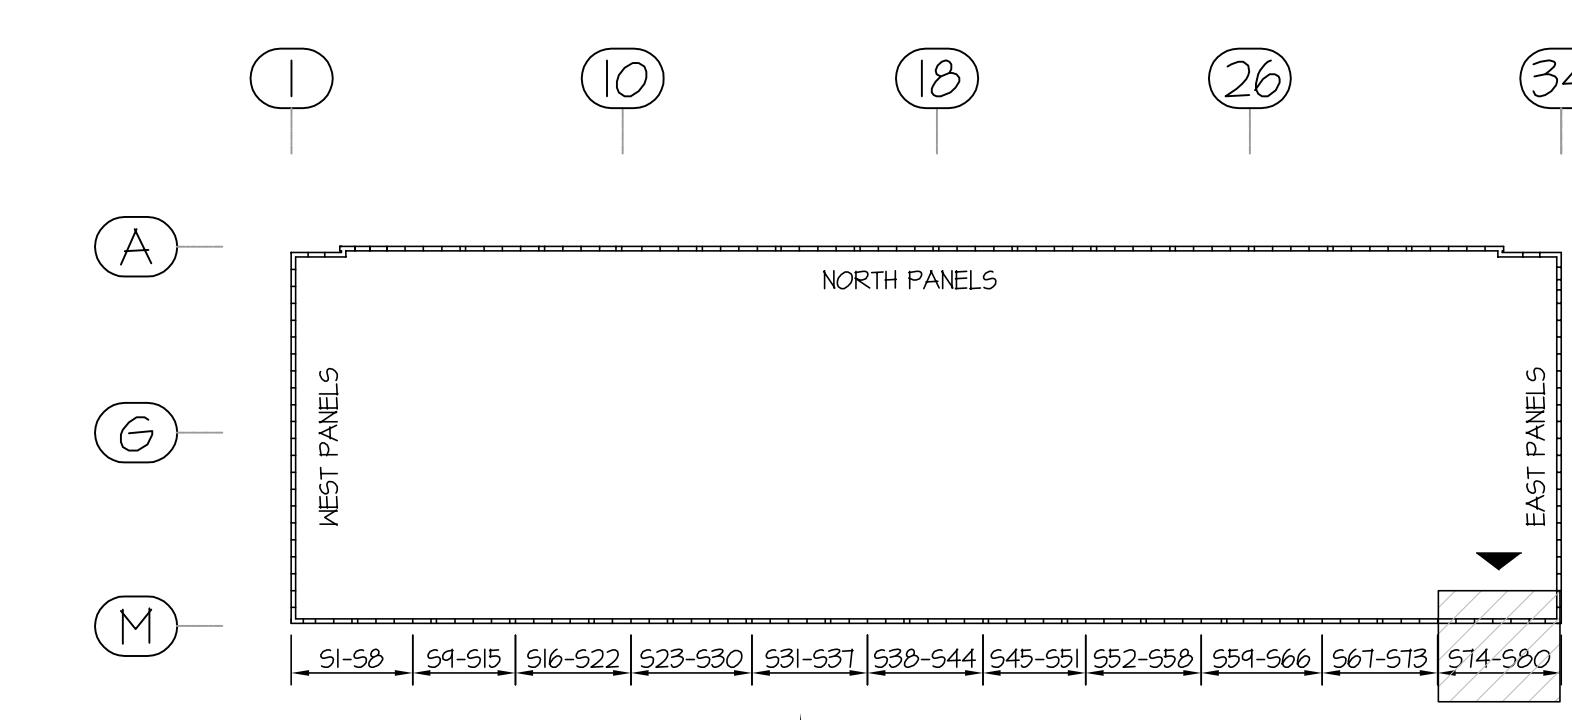

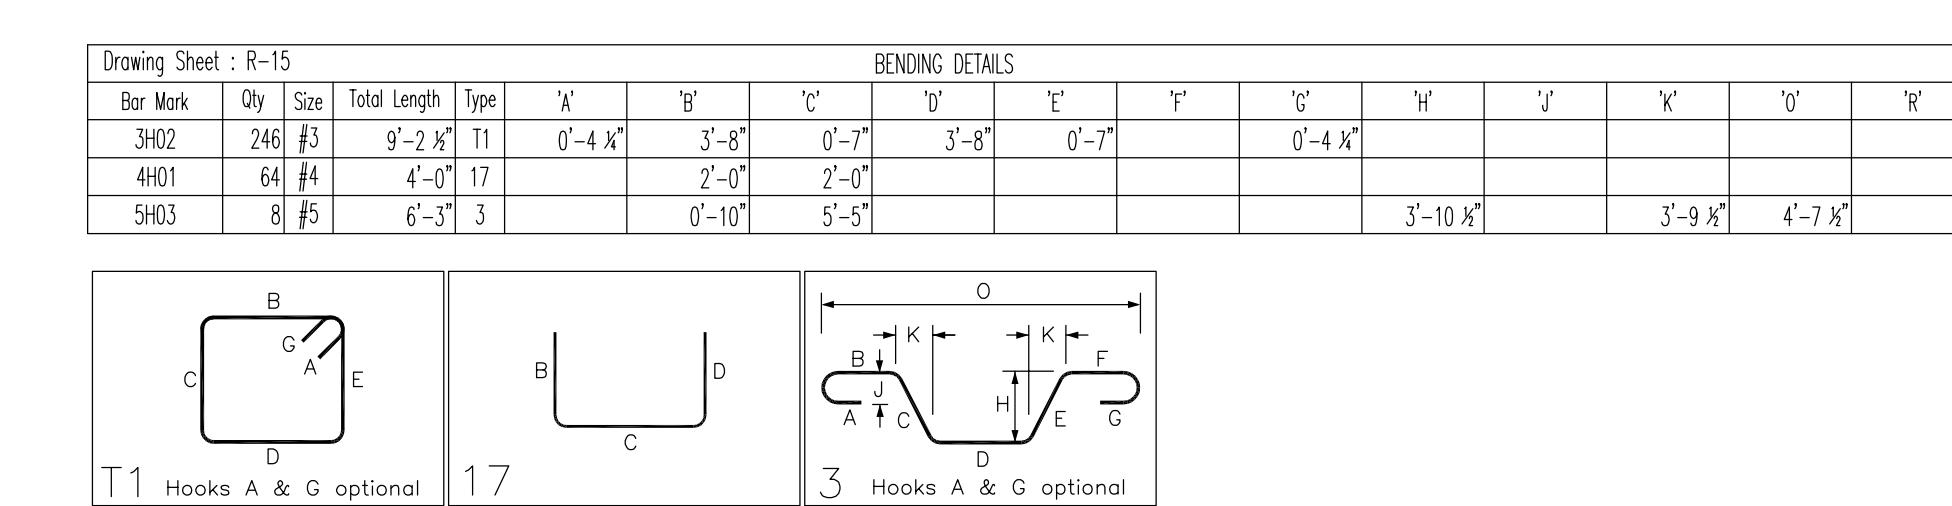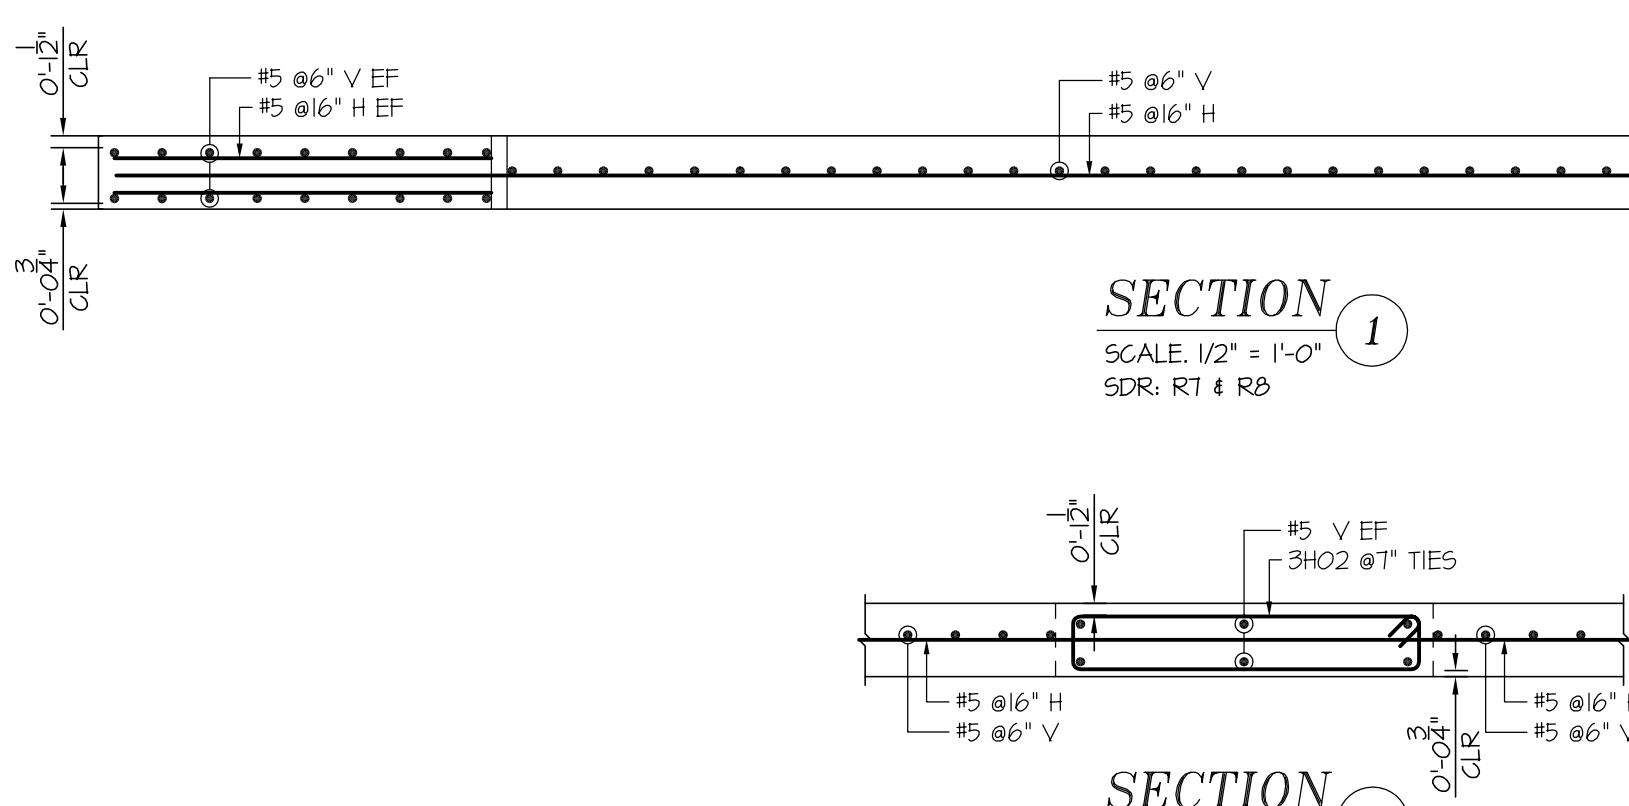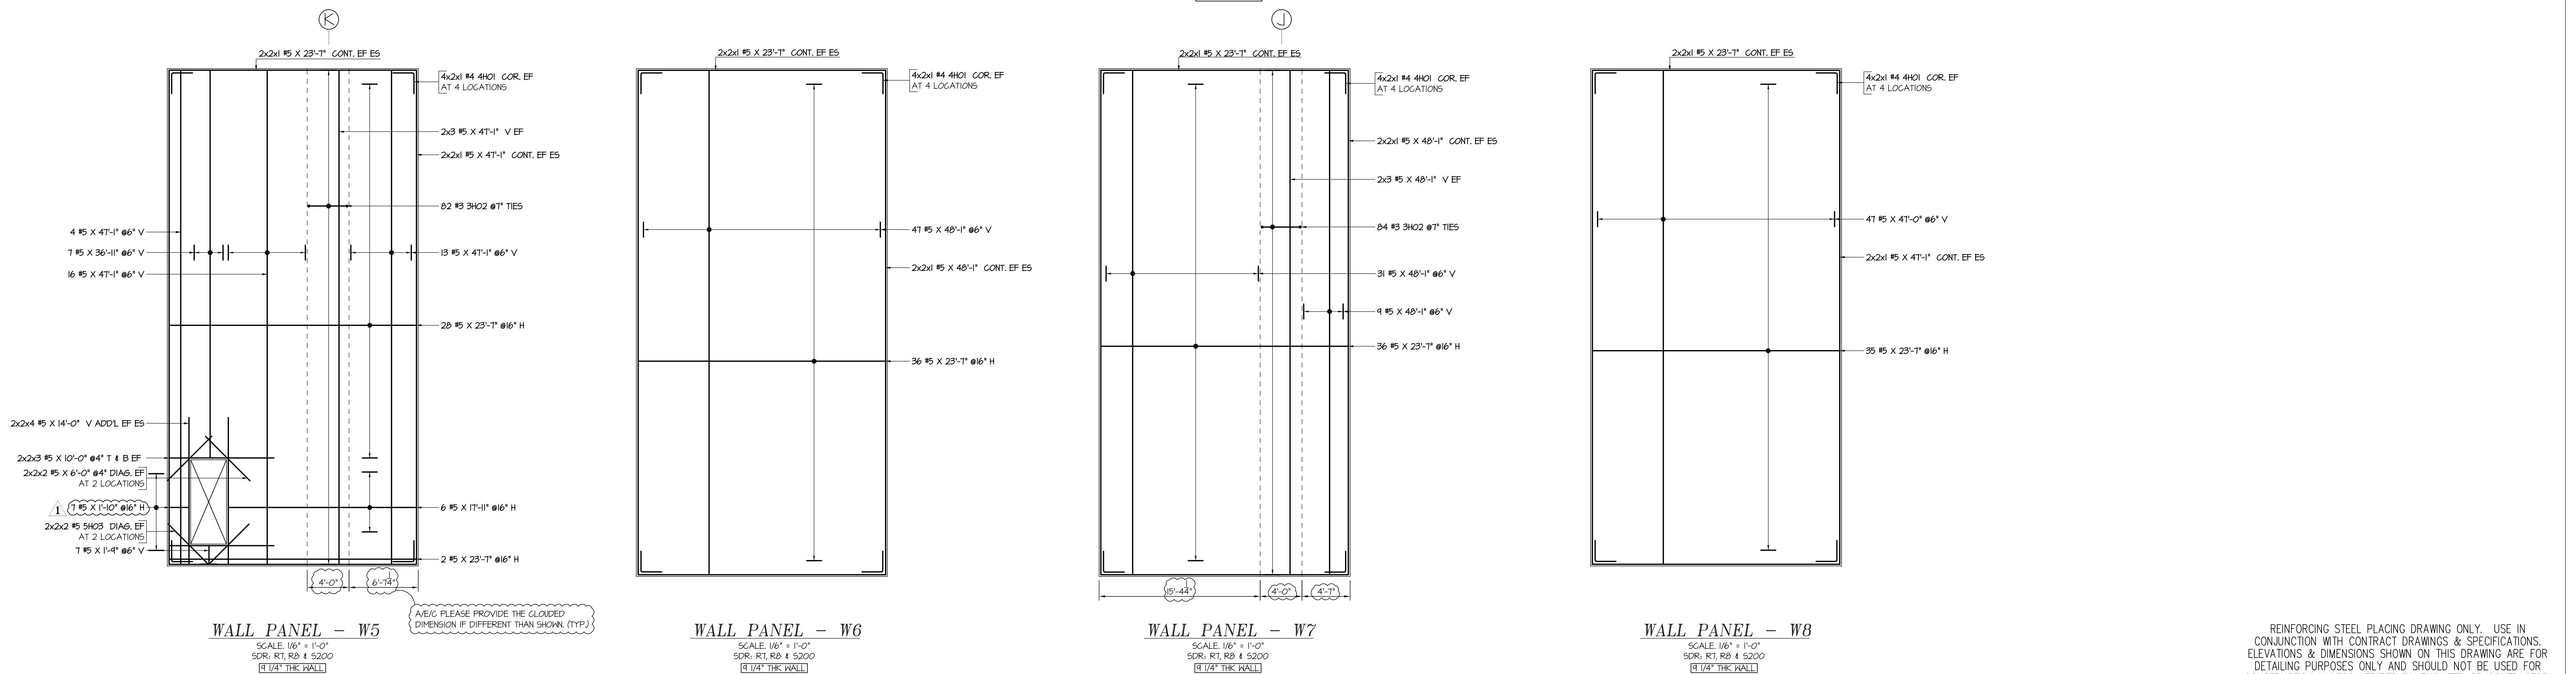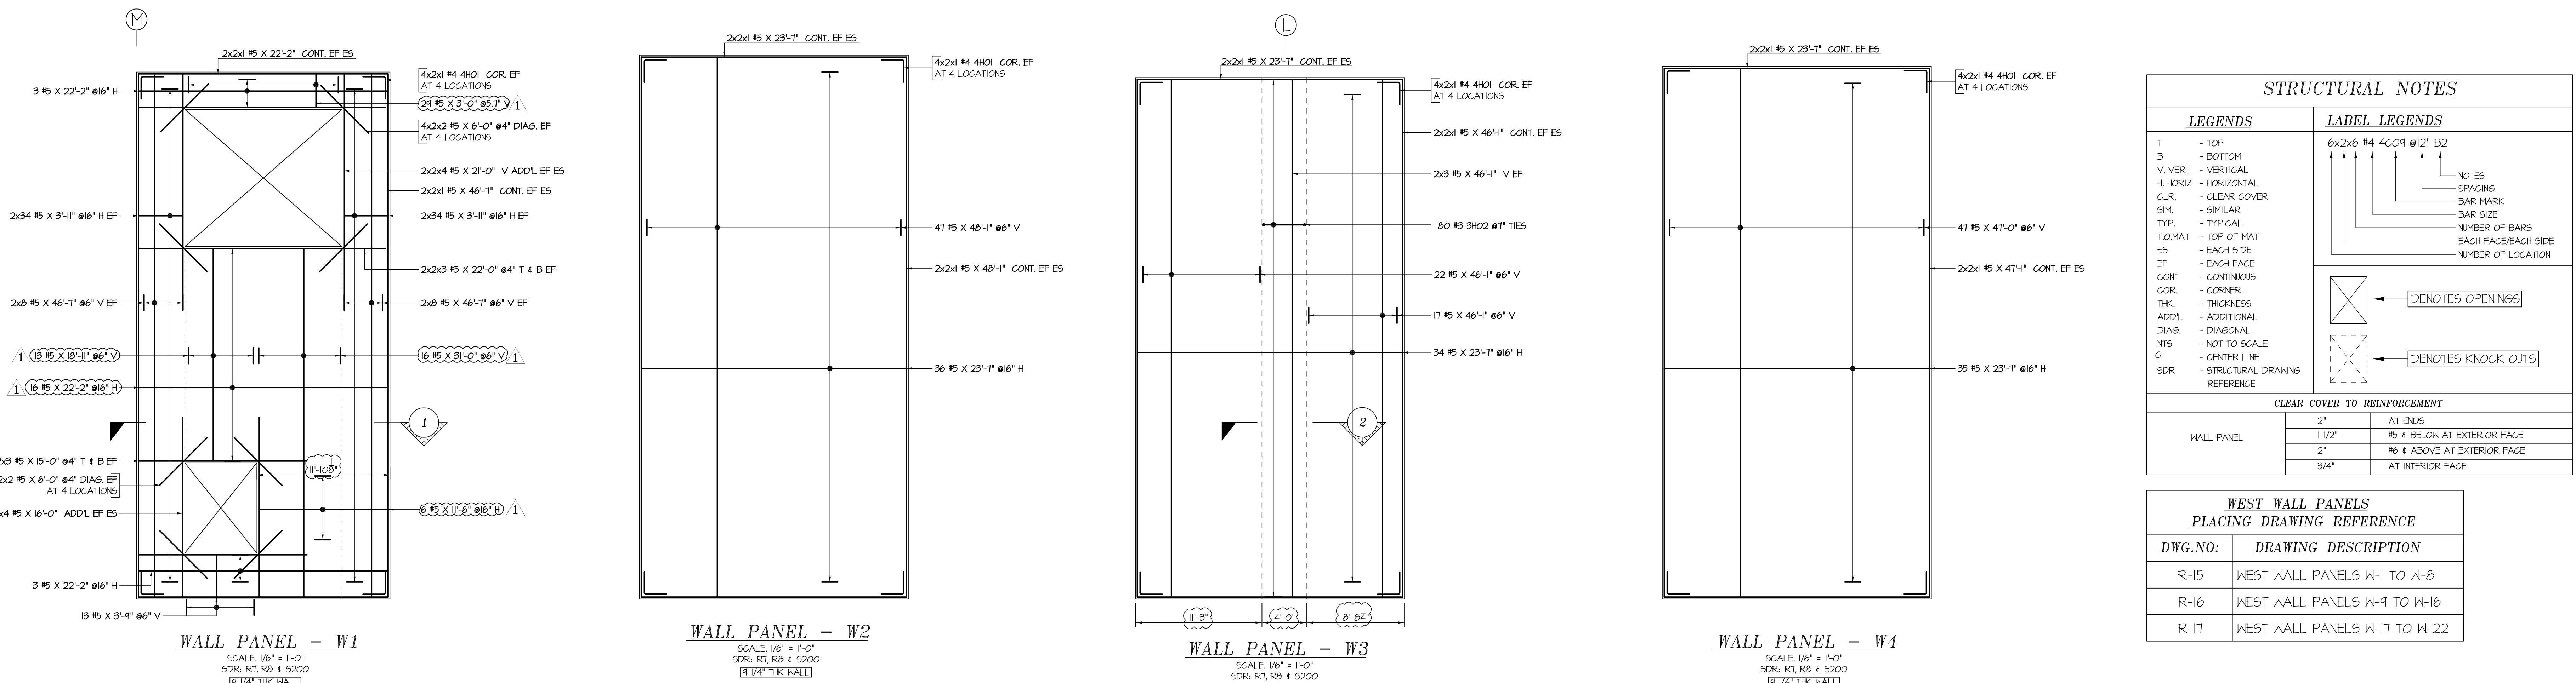

REINFORCING STEEL PLACING DRAWING ONLY. USE IN CONJUNCTION WITH CONTRACT DRAWINGS & SPECIFICATIONS. ELEVATIONS & DIMENSIONS SHOWN ON THIS DRAWING ARE FOR DETAILING PURPOSES ONLY AND SHOULD NOT BE USED FOR CONSTRUCTION UNLESS VERIFIED BY ENGINEER OR CONTRACTOR.


7		
6		
5		
4		
3		
2	06.11.2019	RESUBMITTED FOR APPROVAL
1	05.28.2019	APPROVAL DATE SENT FOR
RE-STEEL SUPPLY CO., INC.		
REINFORCING STEEL - WIRE MESH		
2000 Eddystone Industrial Park • Eddystone, PA 19022-1588		
Phone: 800-876-8216 • Fax: 610-876-8428		
Structure	VALLEY VIEW BUSINESS PARK TILT PANELS	
Location	JESSUP, PA	
Architect	KSS ARCHITECTS	
Engineer	RICHARD ADAMS	
Customer	T&T CONSTRUCTION	
Made by:	Date:	CONTRACT NO.
PRO	05.28.2019	U2524
DRAWING COVERS		
WEST WALL PANELS W-1 TO W-8		
REV. NO.	DATE	DESCRIPTION
R-15		

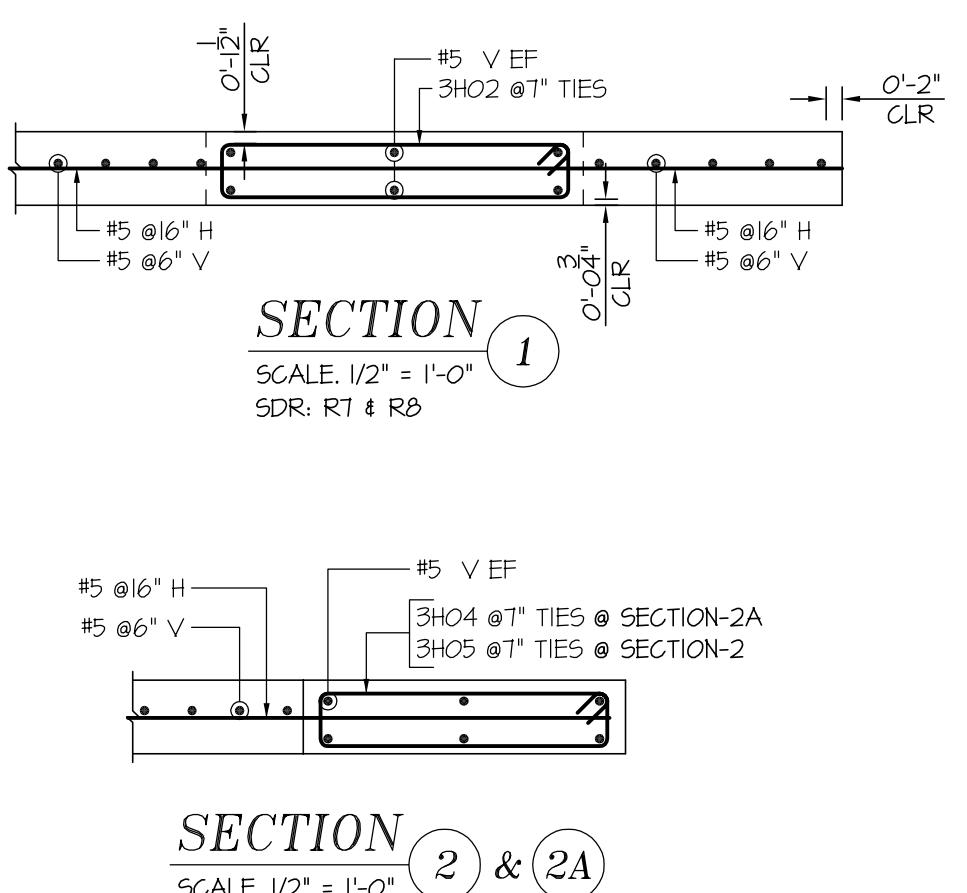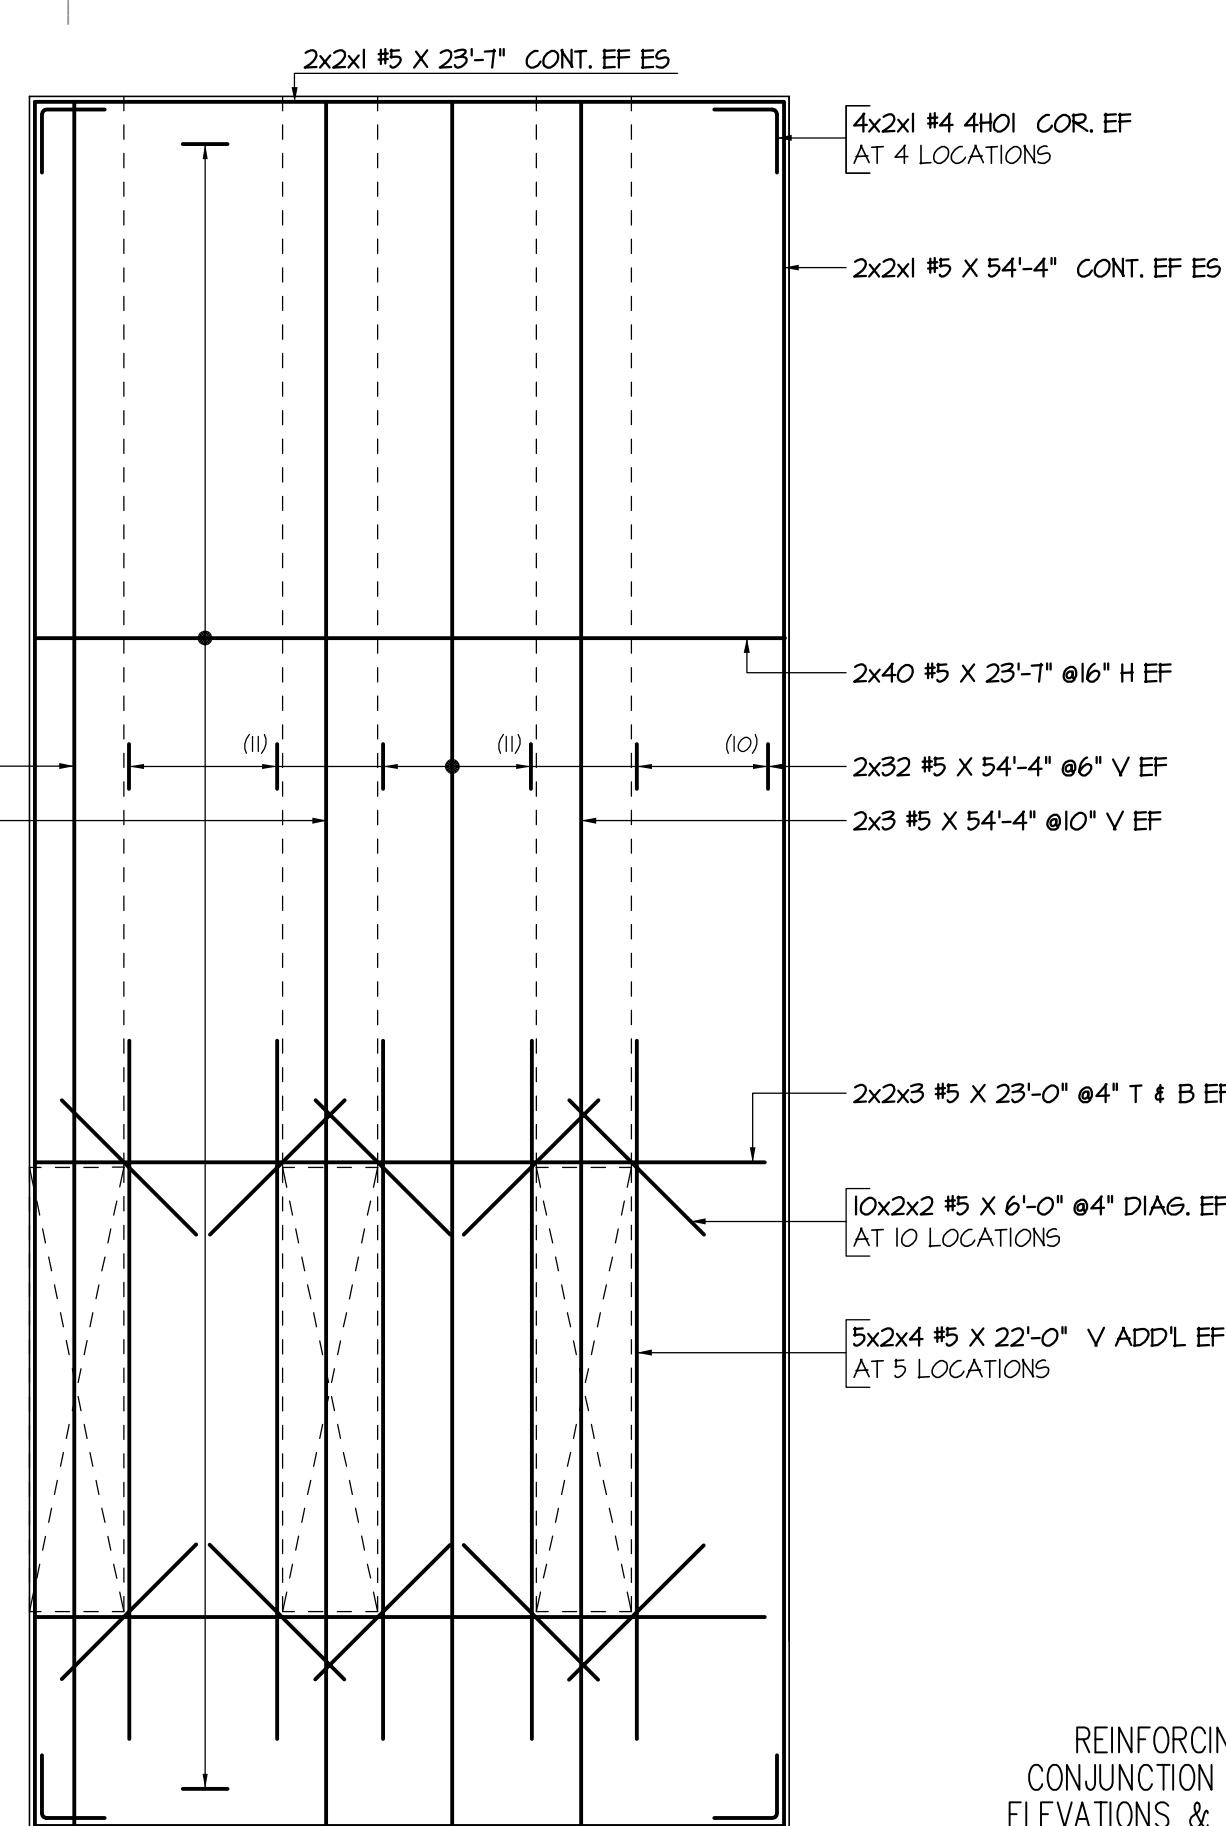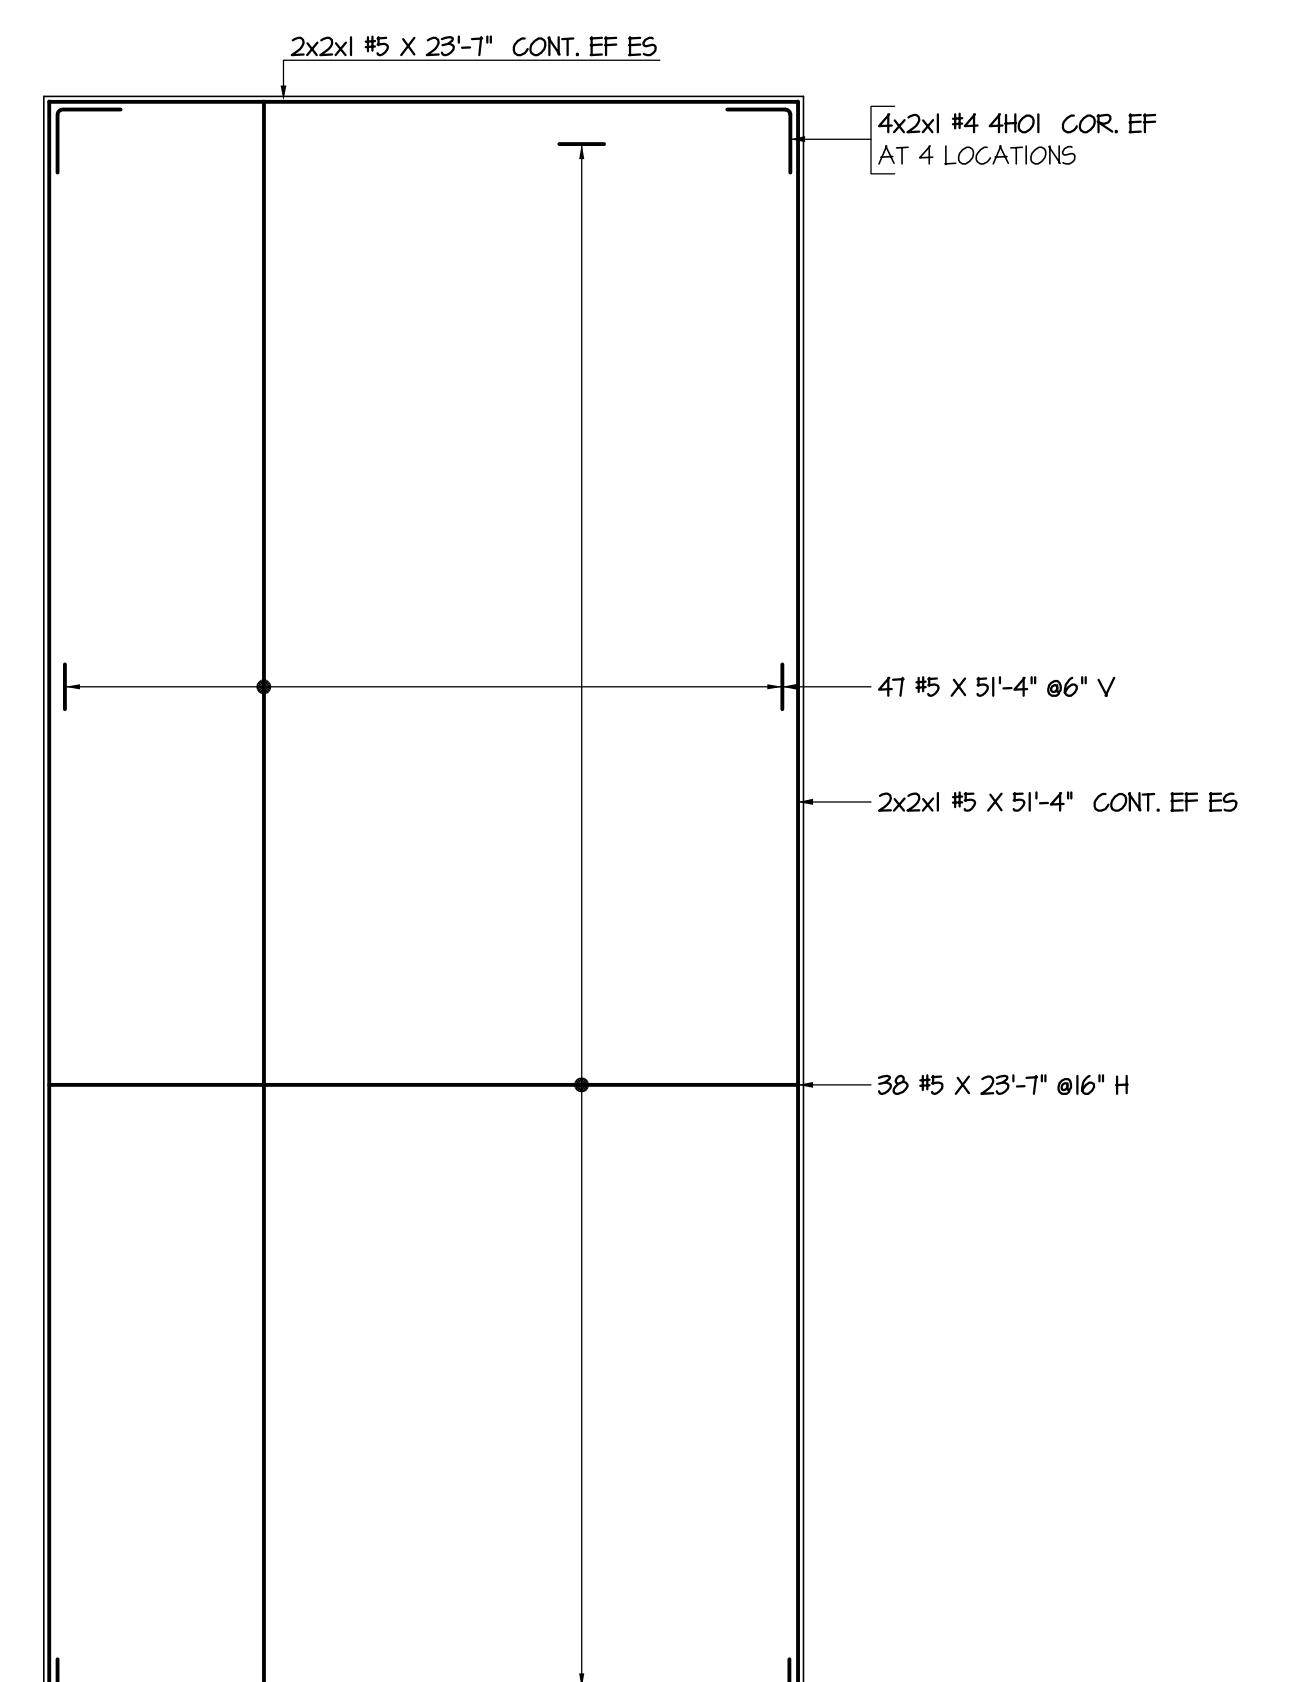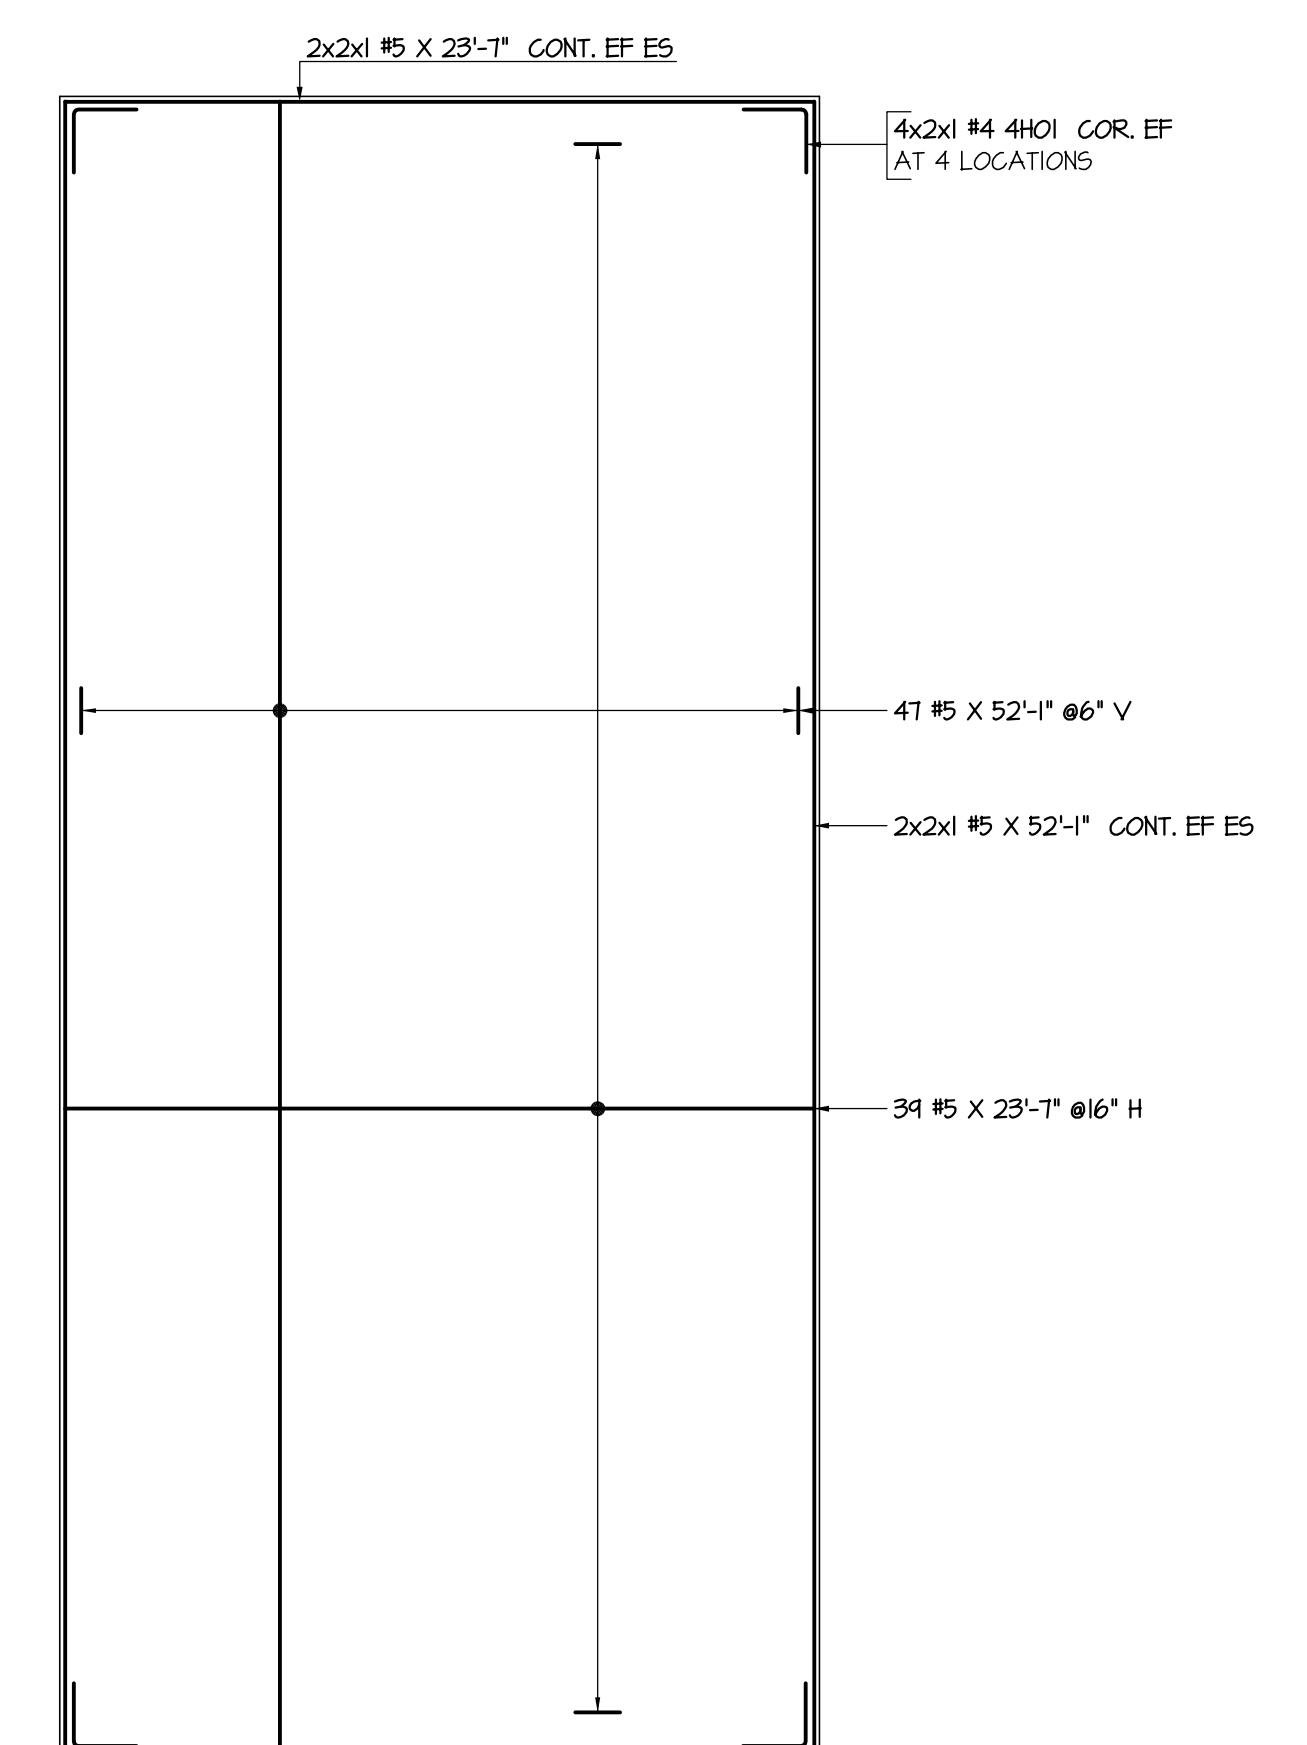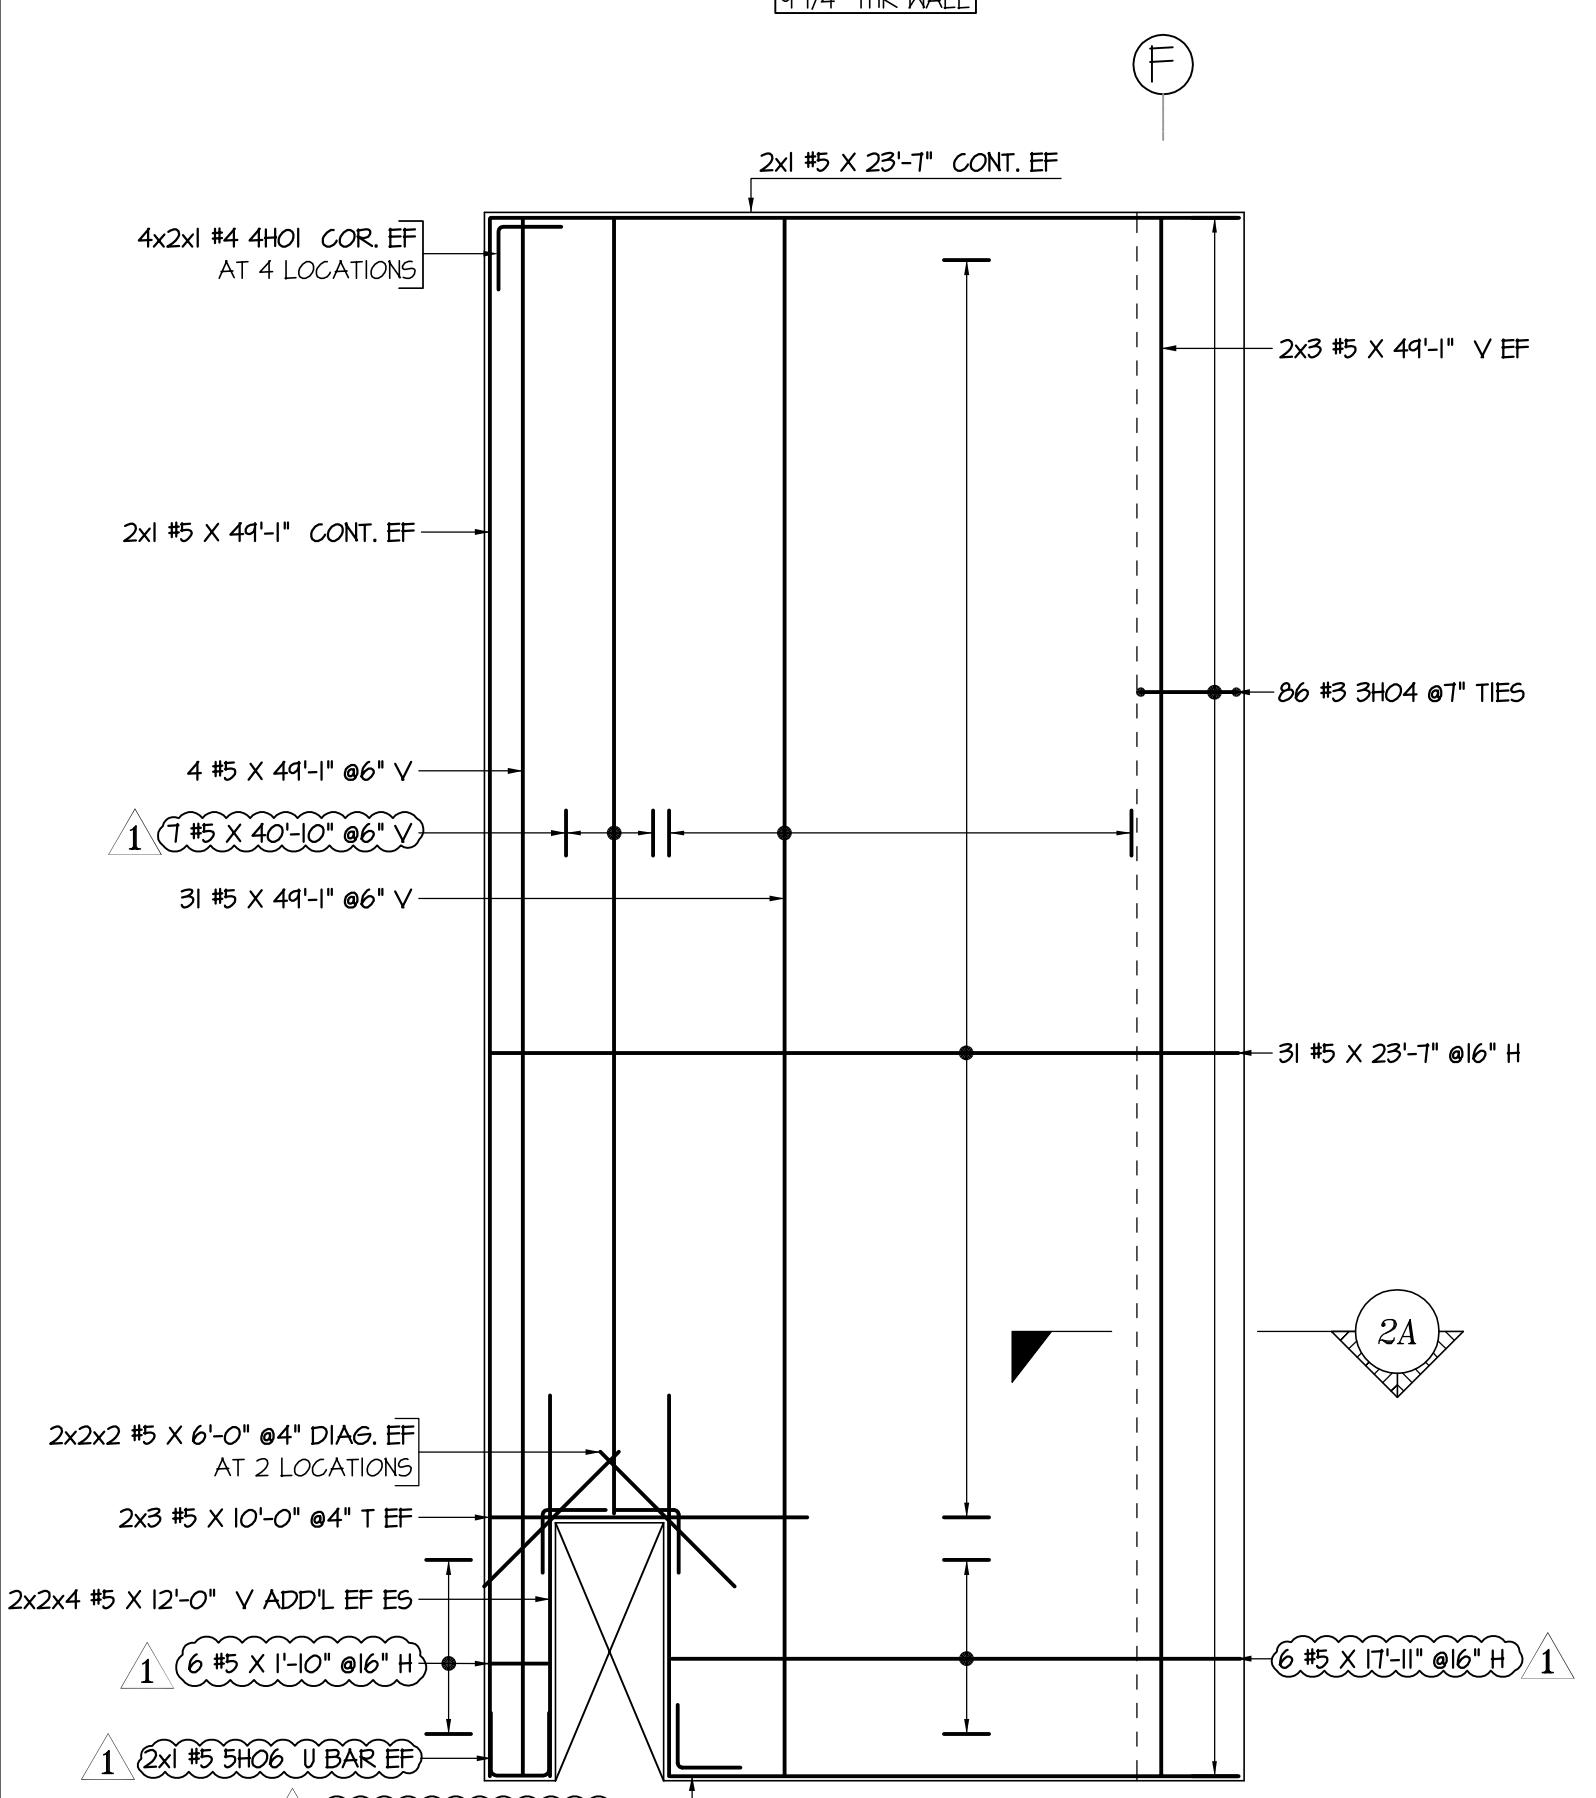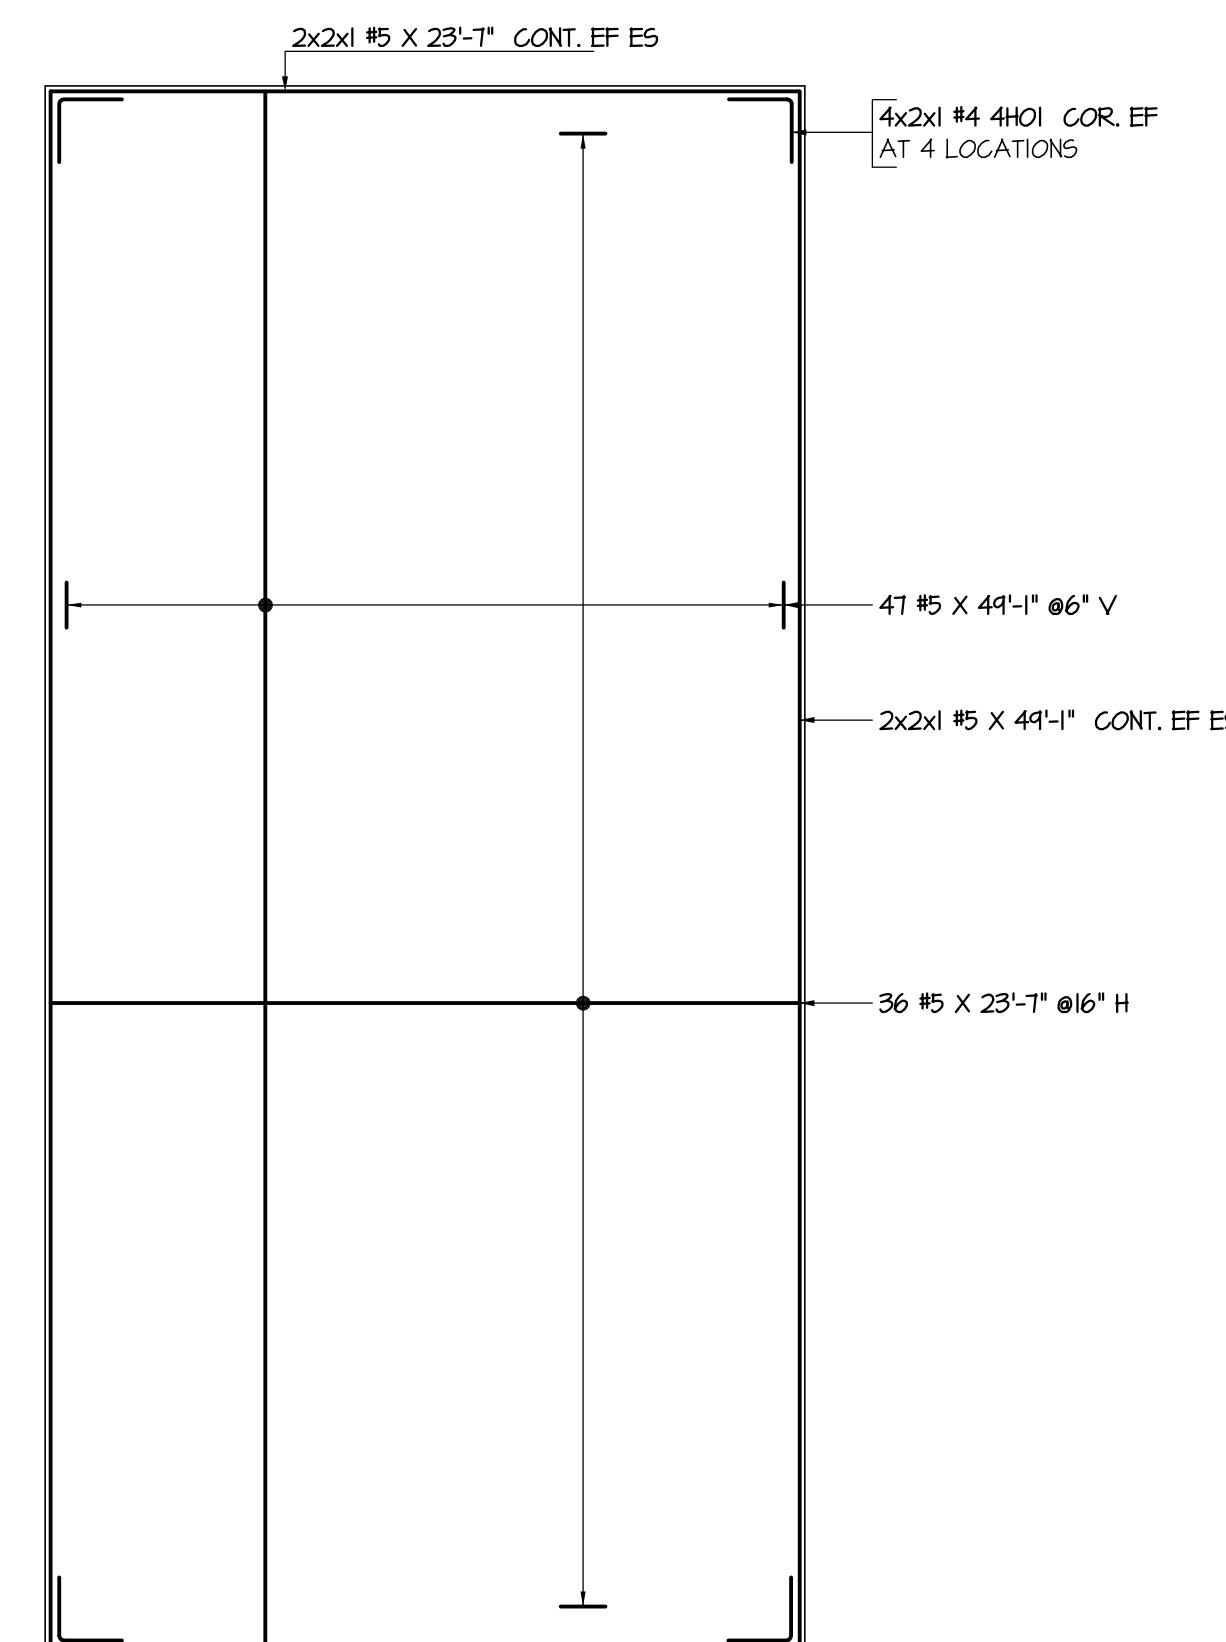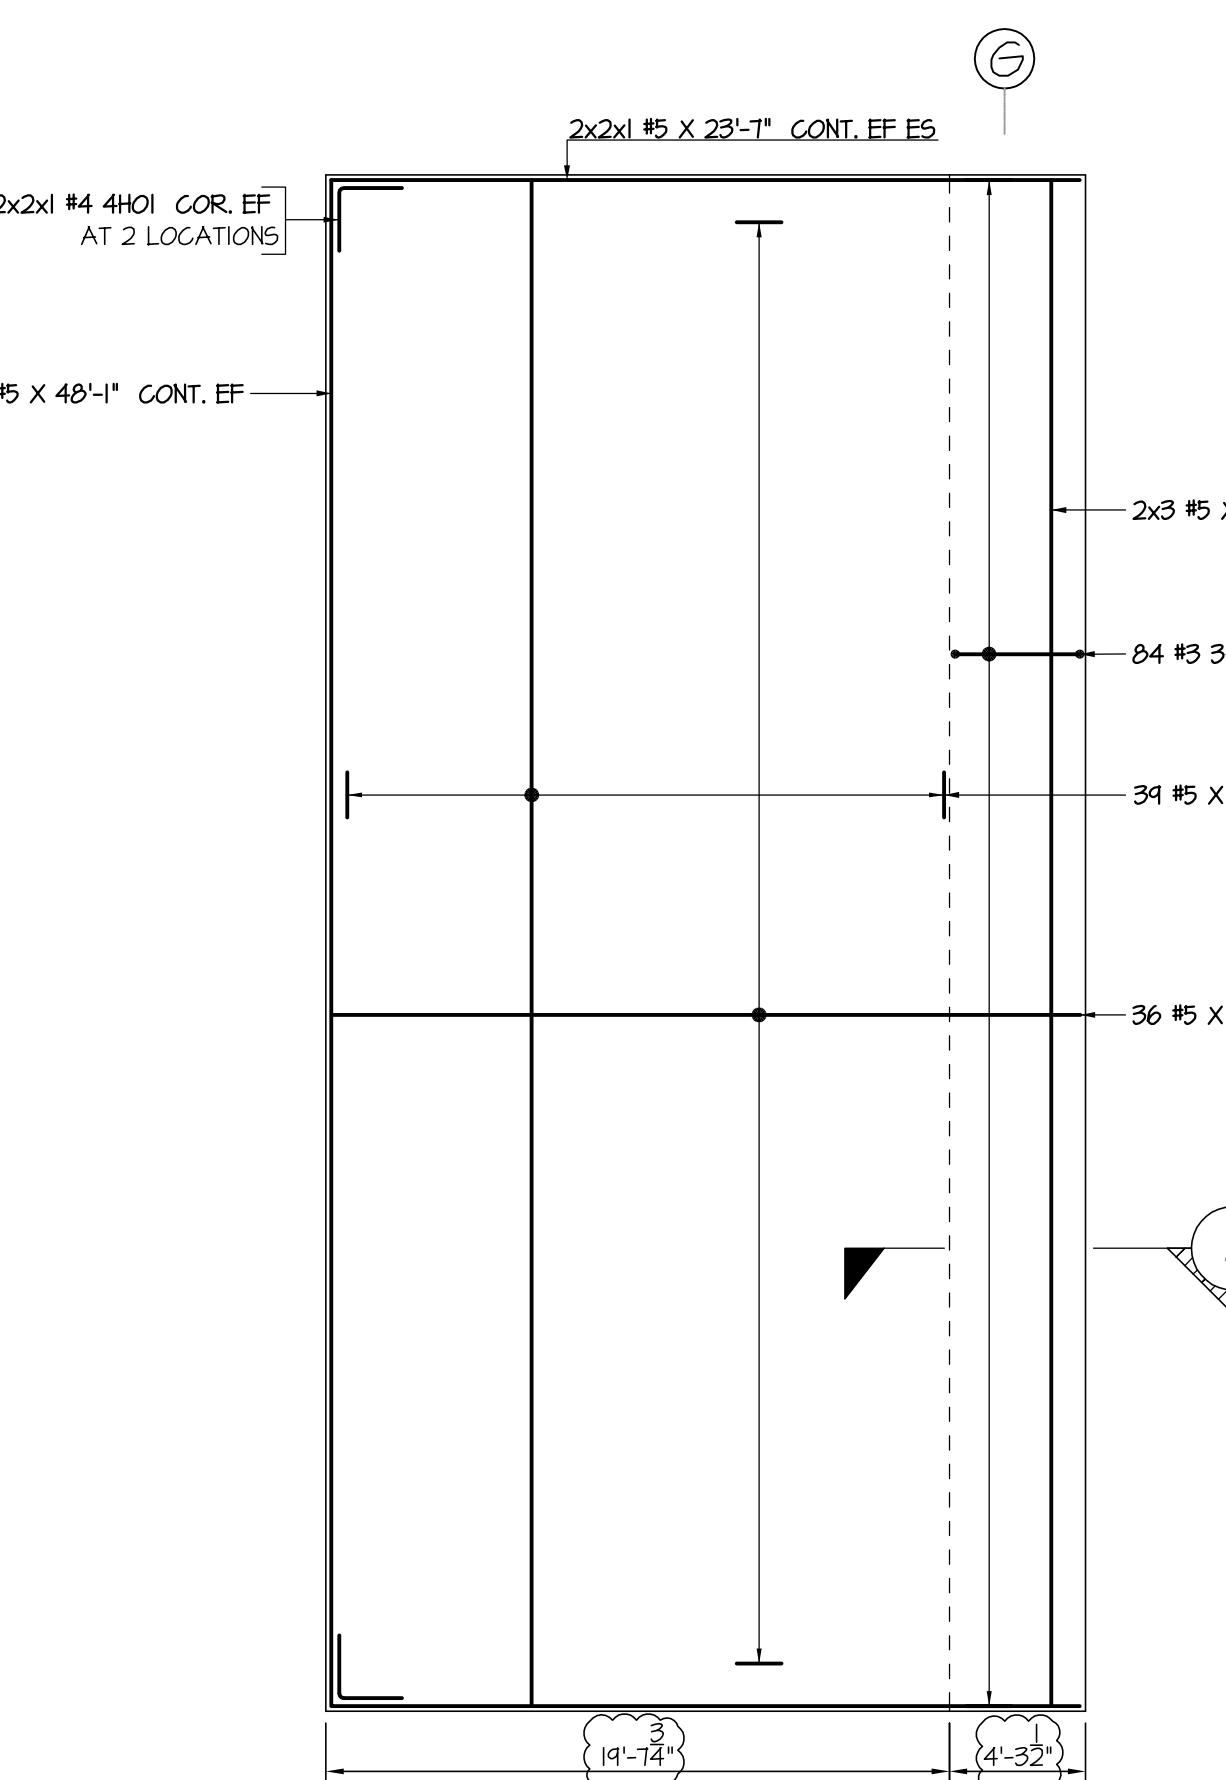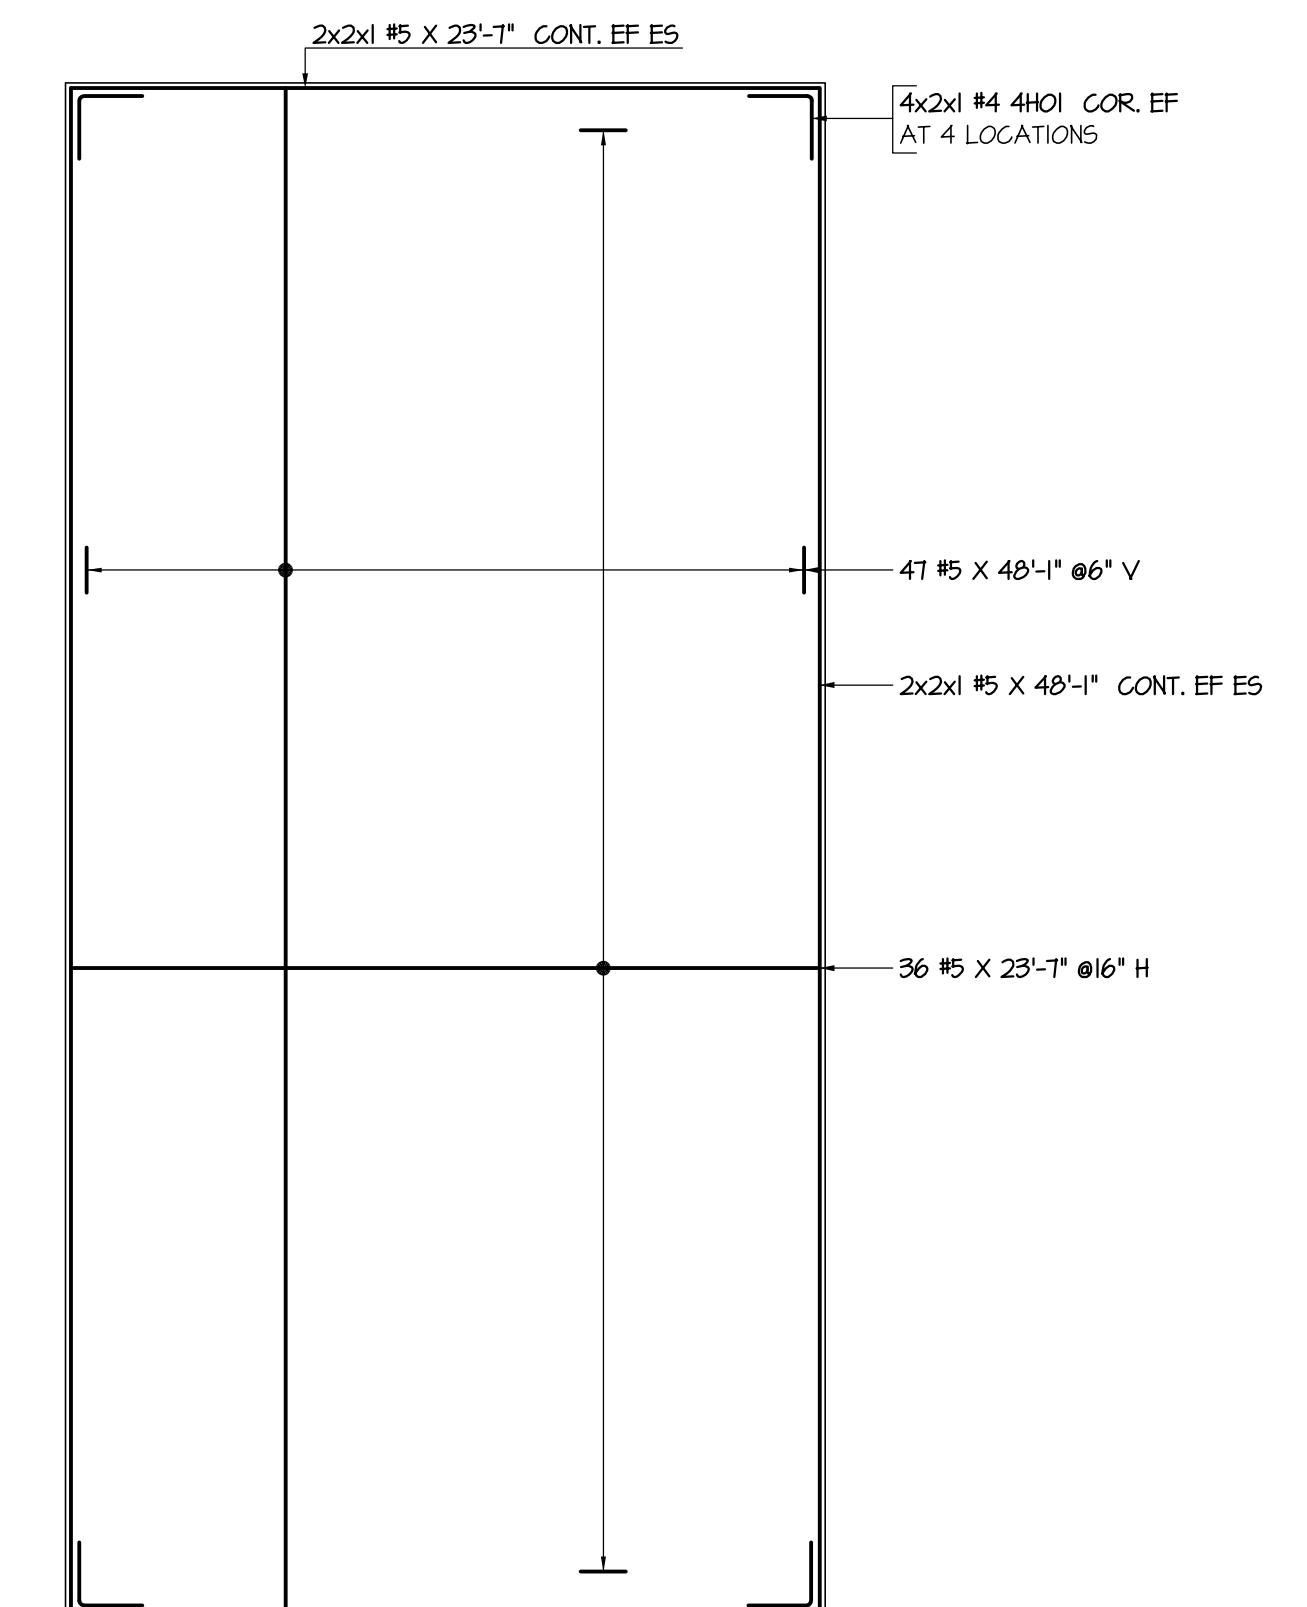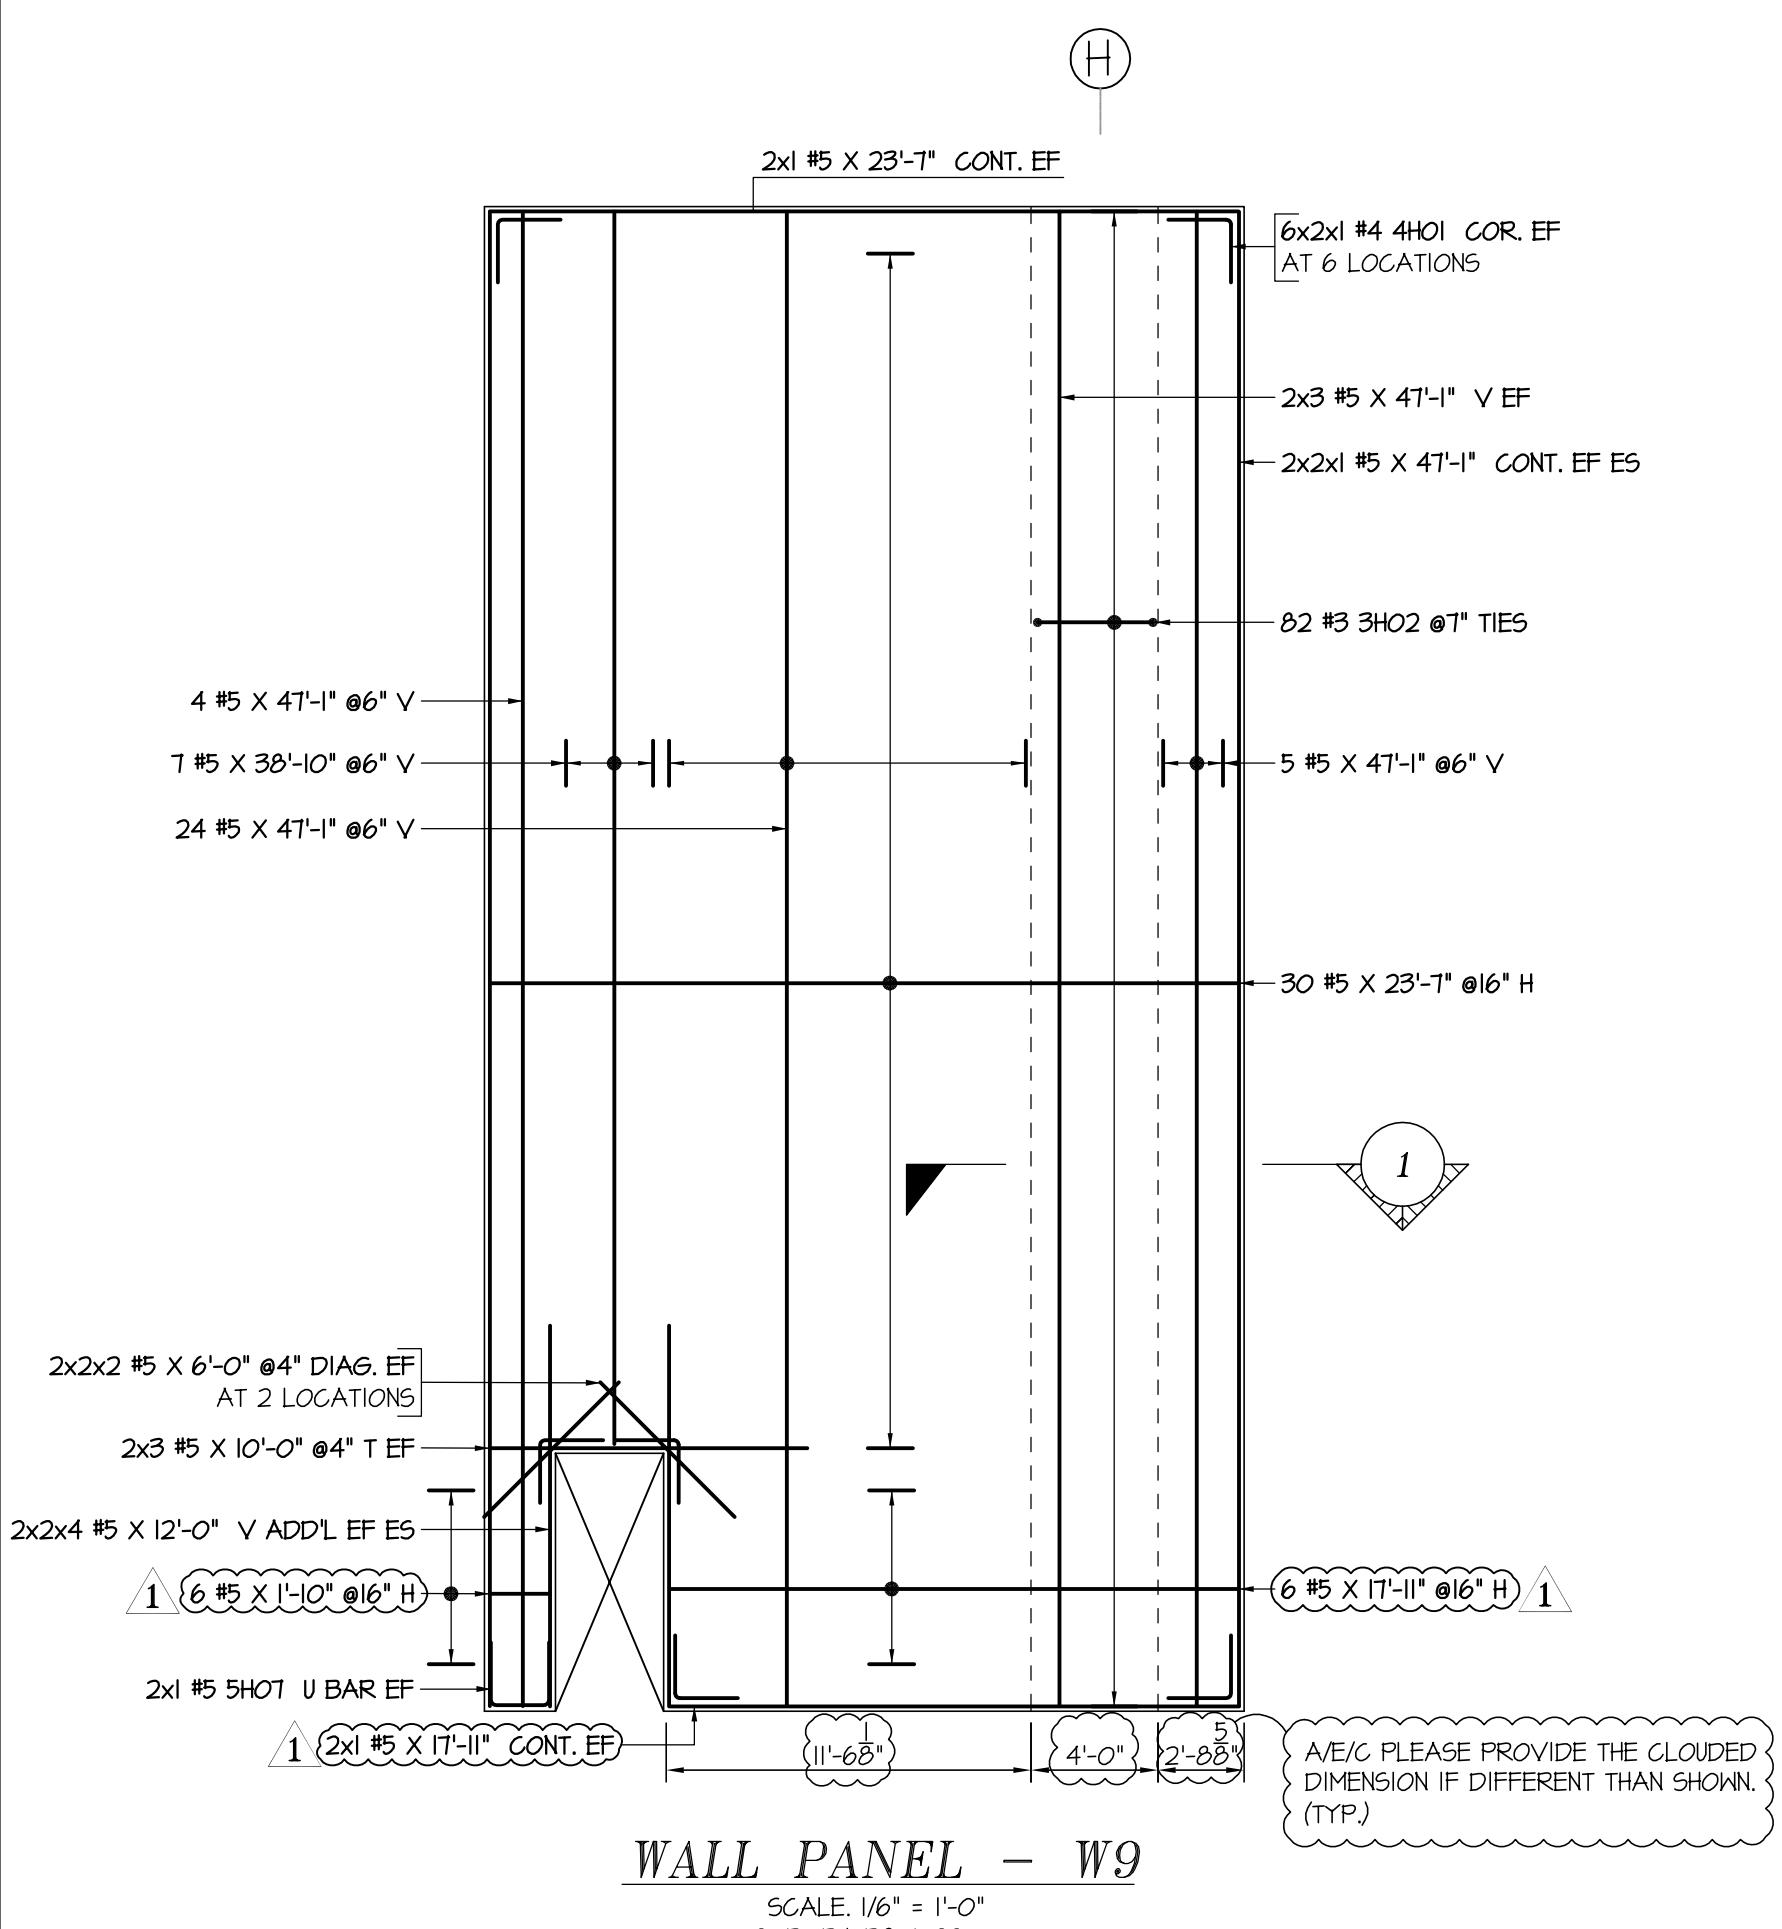

STRUCTURAL NOTES	
LEGENDS	LABEL LEGENDS
T - TOP B - BOTTOM V - VERT H - HORIZ CLR - CLEAR COVER SIM - SIMILAR TYP - TYPICAL TOP.MAT - TOP OF MAT ES - EACH SIDE EF - EACH FACE CONT - CONTINUOUS COR - CORNER THK - THICKNESS ADDL - ADDITIONAL DIAG - DIAGONAL NTS - NOT TO SCALE CEN - CENTER LINE SDR - STRUCTURAL DRAWING REFERENCE	<p>NOTES SPACING BAR MARK BAR SIZE NUMBER OF BARS EACH FACE/EACH SIDE NUMBER OF LOCATION</p> <p>T1 Hooks A & G optional</p> <p>DENOTES OPENINGS</p> <p>DENOTES KNOCK OUTS</p>
6x2x6 #4 4C09 @12' B2	BENDING DETAILS
SH02 82 #3 9'-2" T1	'A' 'B' 'C' 'D' 'E' 'F' 'G' 'H'
SH04 86 #3 7'-11" T1	'0'-4" '3'-8" '0'-7" '3'-8" '0'-7"
SH04 84 #3 9'-9" T1	'0'-4" '3'-11" '0'-7" '3'-11" '0'-7"
SH01 64 #4 4'-0" T1	'2"-0" '2"-0"
SH06 2 #5 5'-10" X17	'2"-0" '1'-10" '2"-0"
SH07 2 #5 5'-10" X17	'2"-0" '1'-10" '2"-0"



WEST WALL PANELS	
PLACING DRAWING REFERENCE	
DWG.NO:	DRAWING DESCRIPTION
R-15	WEST WALL PANELS W-1 TO W-8
R-16	WEST WALL PANELS W-9 TO W-16
R-17	WEST WALL PANELS W-17 TO W-22

WALL PANEL	CLEAR COVER TO REINFORCEMENT	
	2"	AT ENDS
	1 1/2"	#5 & BELOW AT EXTERIOR FACE
	2"	#6 & ABOVE AT EXTERIOR FACE
	3/4"	AT INTERIOR FACE

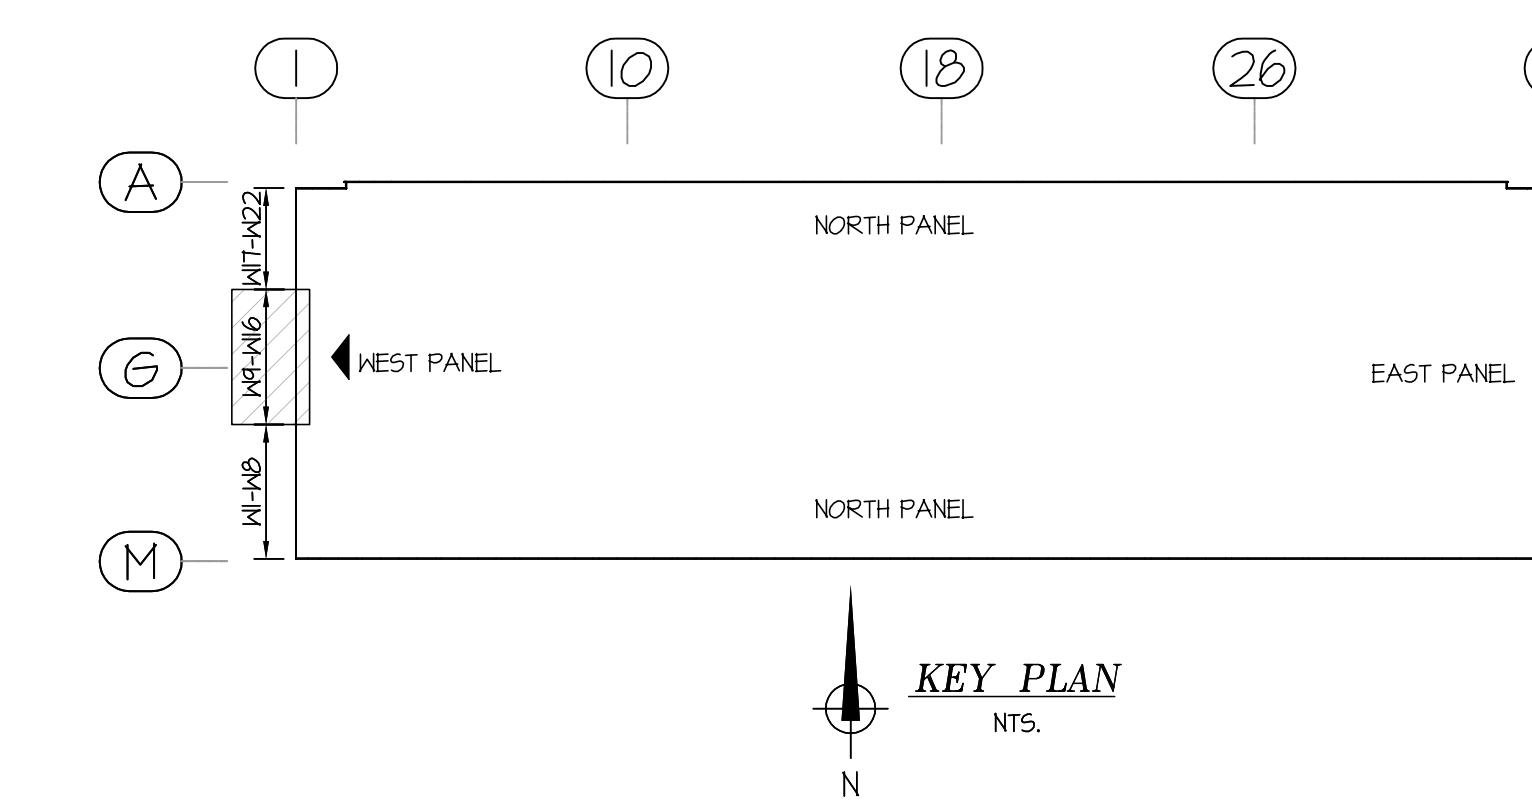

7	
6	
5	
4	
3	
2	06.11.2019
1	05.28.2019
	RESUBMITTED FOR APPROVAL
	APPROVAL
	DATE SENT FOR
RE-STEEL SUPPLY CO., INC.	
REINFORCING STEEL - WIRE MESH	
2000 Eddystone Industrial Park • Eddystone, PA 19022-1588	
Phone: 800-876-8216 • Fax: 610-876-8428	
Structure	VALLEY VIEW BUSINESS PARK TILT PANELS
Location	JESSUP, PA
Architect	KSS ARCHITECTS
Engineer	RICHARD ADAMS
Customer	T&T CONSTRUCTION
Made by	PRO Date: 05.28.2019
Contract No.	U2524
DRAWING COVERS	
WEST WALL PANELS	
W-9 TO W-16	
Rev. No.	Date
DESCRIPTION	


REINFORCING STEEL PLACING DRAWING ONLY. USE IN CONJUNCTION WITH CONTRACT DRAWINGS & SPECIFICATIONS. ELEVATIONS & DIMENSIONS SHOWN ON THIS DRAWING ARE FOR DETAILING PURPOSES ONLY AND SHOULD NOT BE USED FOR CONSTRUCTION UNLESS VERIFIED BY ENGINEER OR CONTRACTOR.

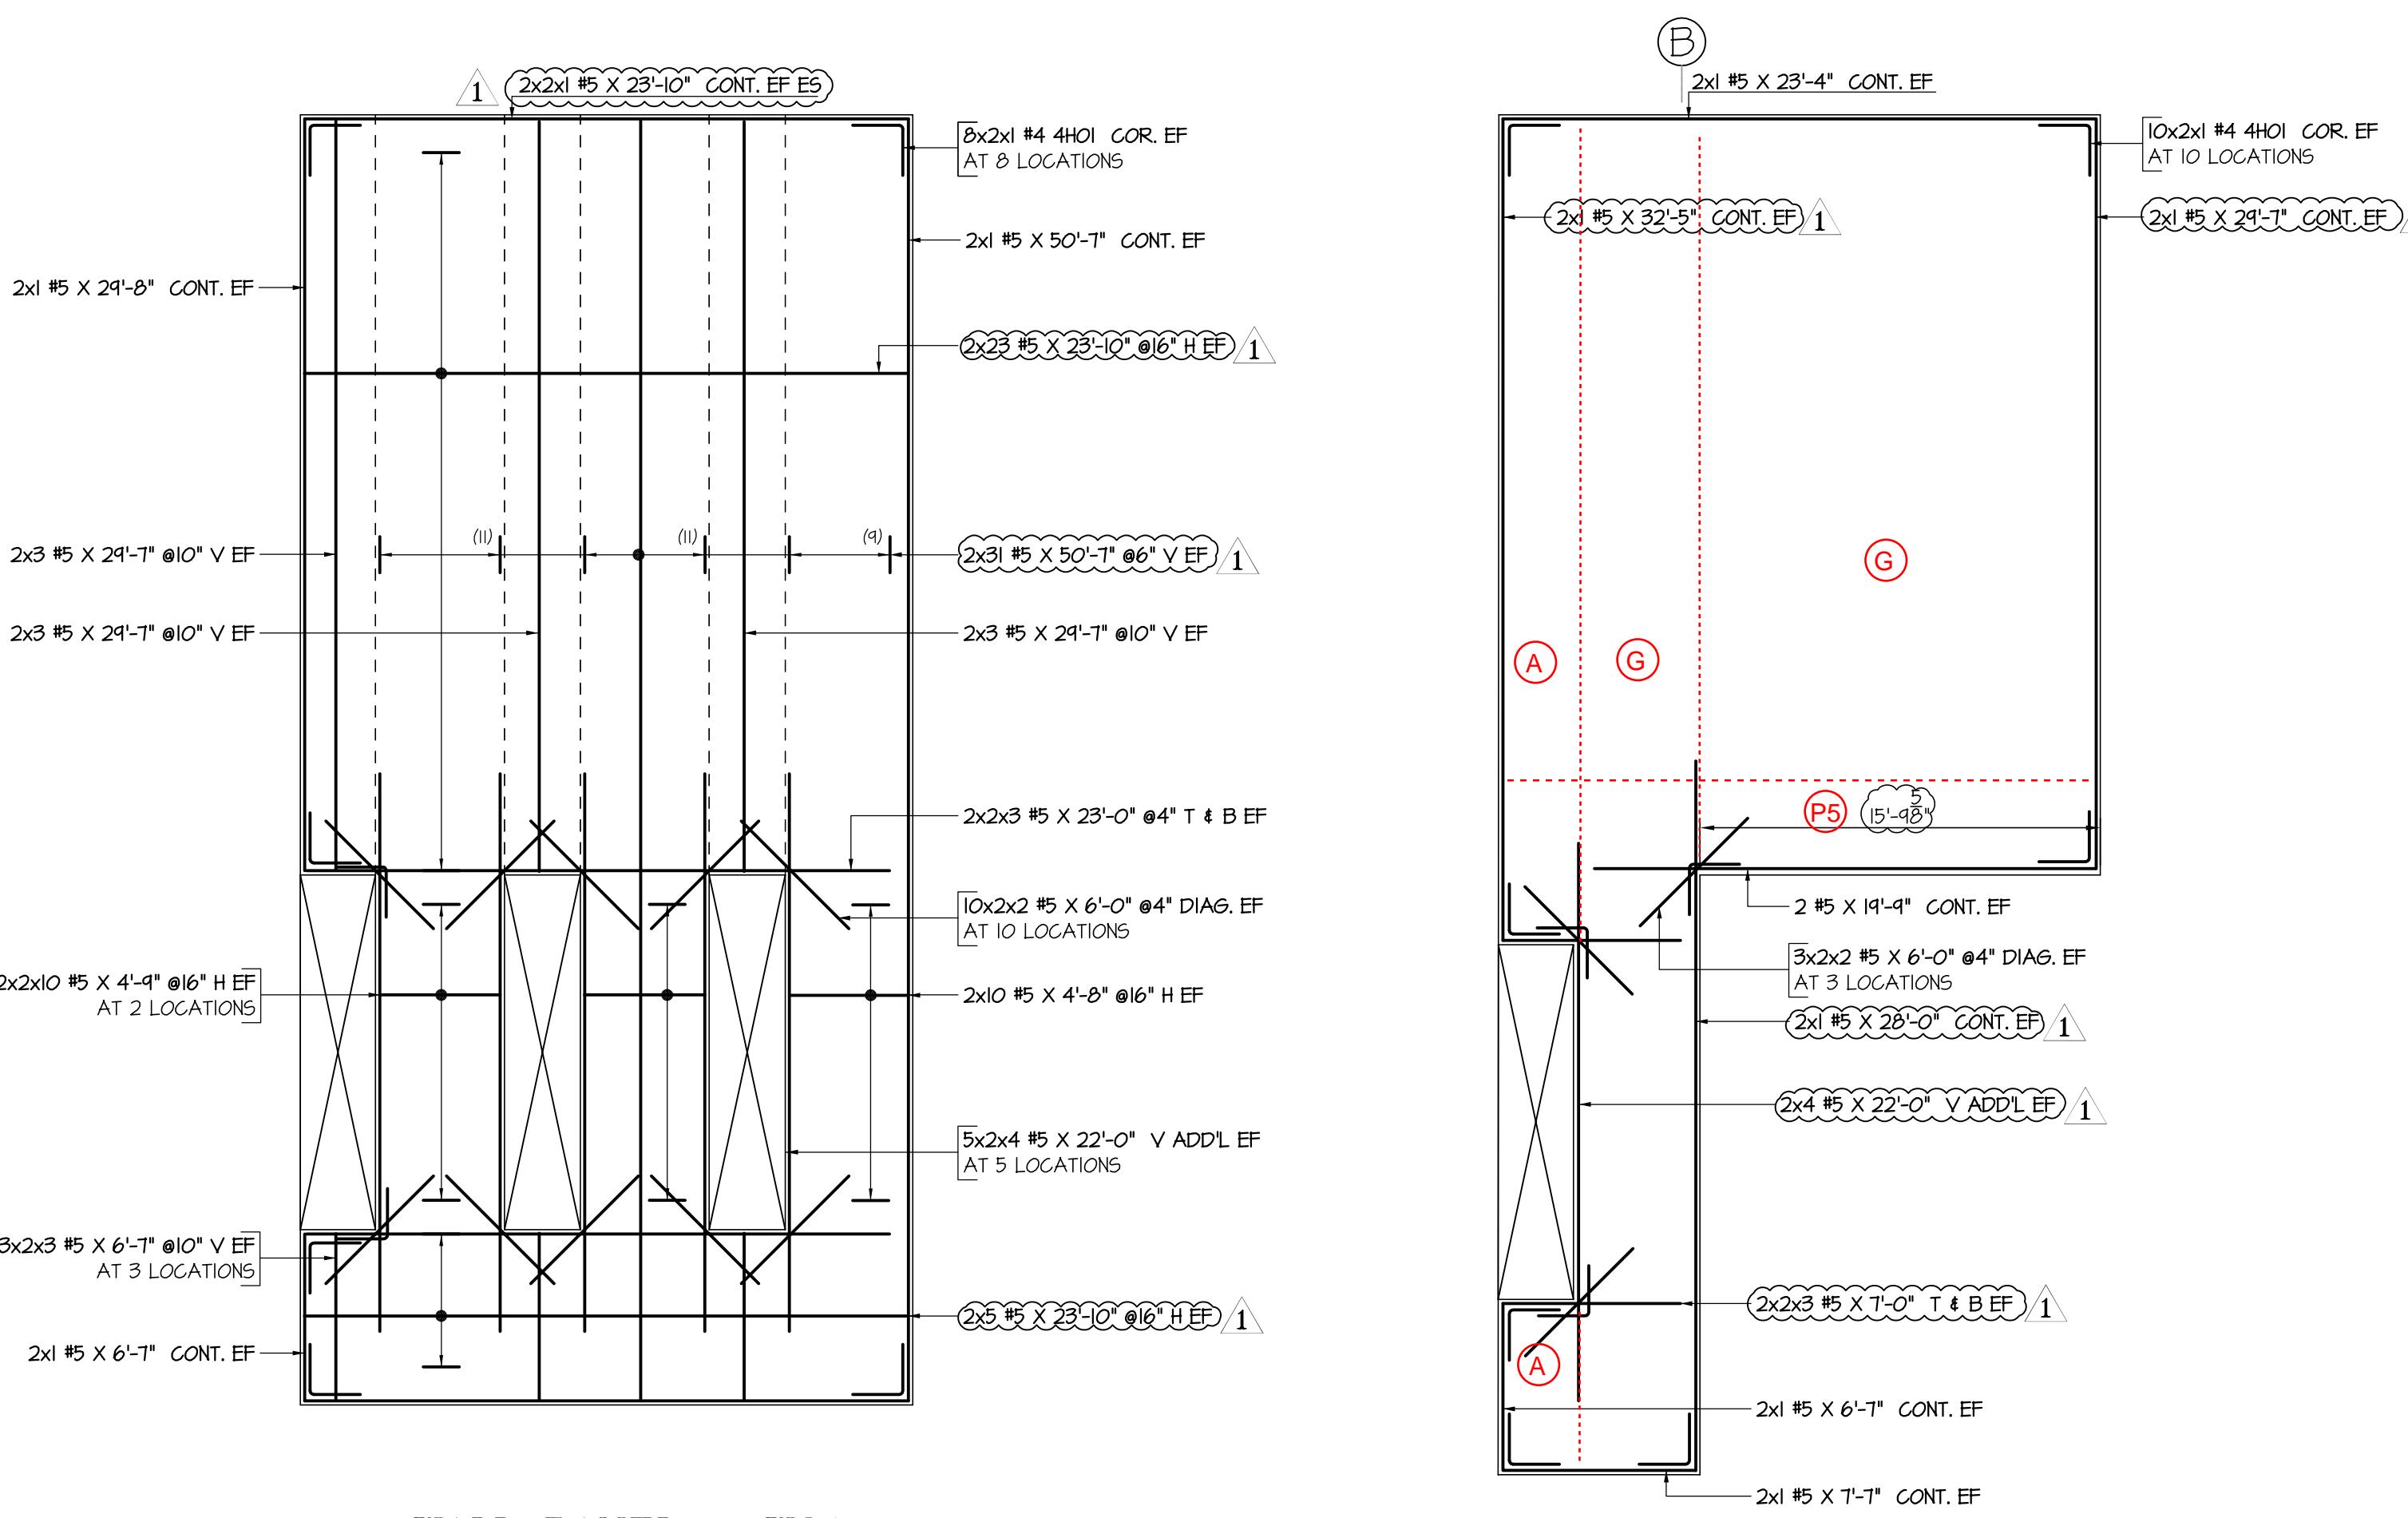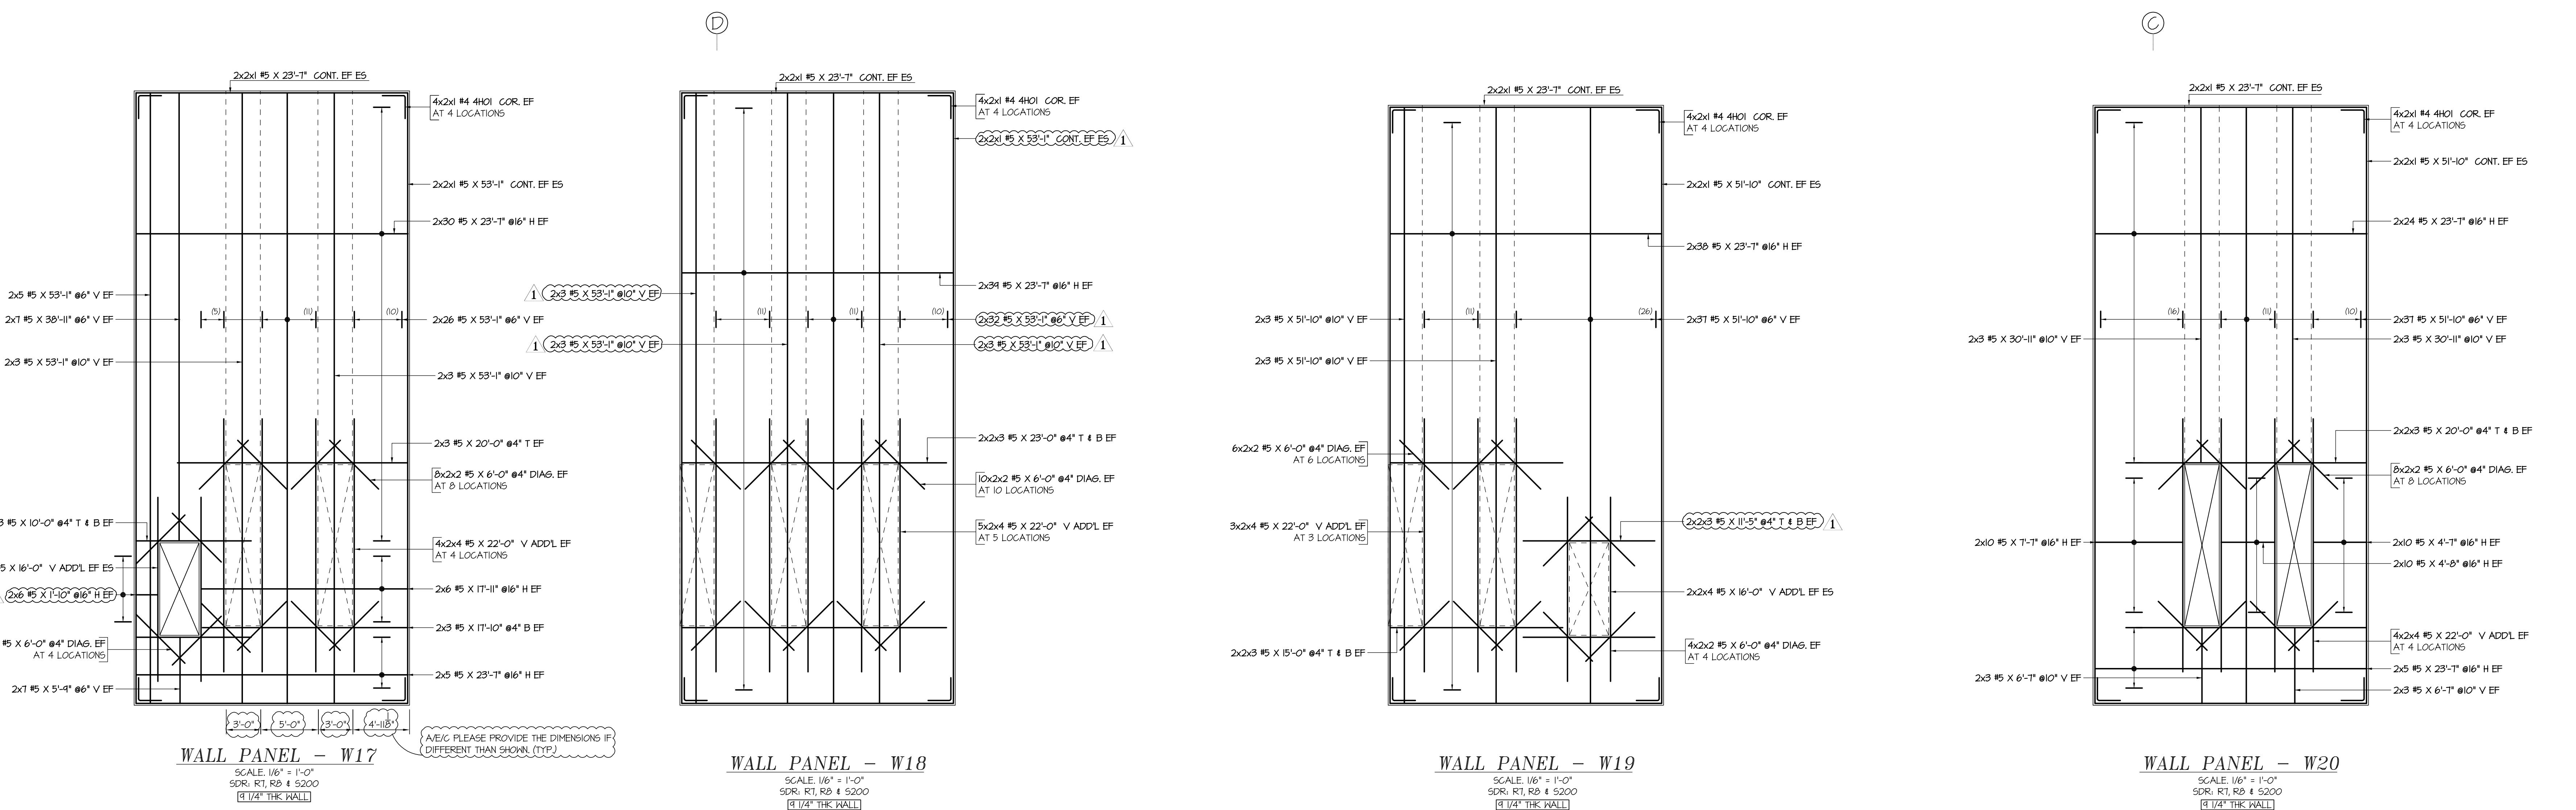

REBAR PLACEMENT FOR SINGLE LAYERS
SCALE: 1/2" = 1'-0"
SDR: RD

REBAR PLACEMENT FOR DOUBLE LAYERS
SCALE: 1/2" = 1'-0"
SDR: RD

STRUCTURAL NOTES	
LEGENDS	LABEL LEGENDS
T - TOP B - BOTTOM V, VERT - VERTICAL H, HORIZ - HORIZONTAL CLR - CLEAR COVER SIM - SIMILAR TYP. - TYPICAL TOMAT - TOP OF MAT ES - EACH SIDE EF - EACH FACE CONT - CONTINUOUS COR - CORNER THK - THICKNESS ADDL - ADDITIONAL DIAG. - DIAGONAL NTS - NOT TO SCALE C - CENTER LINE SDR - STRUCTURAL DRAWING REFERENCE	BENDING DETAILS
WALL PANEL	CLEAR COVER TO REINFORCEMENT
	2" AT ENDS
	1 1/2" #6 BELOW AT EXTERIOR FACE
	2" #6 ABOVE AT EXTERIOR FACE
	3/4" AT INTERIOR FACE

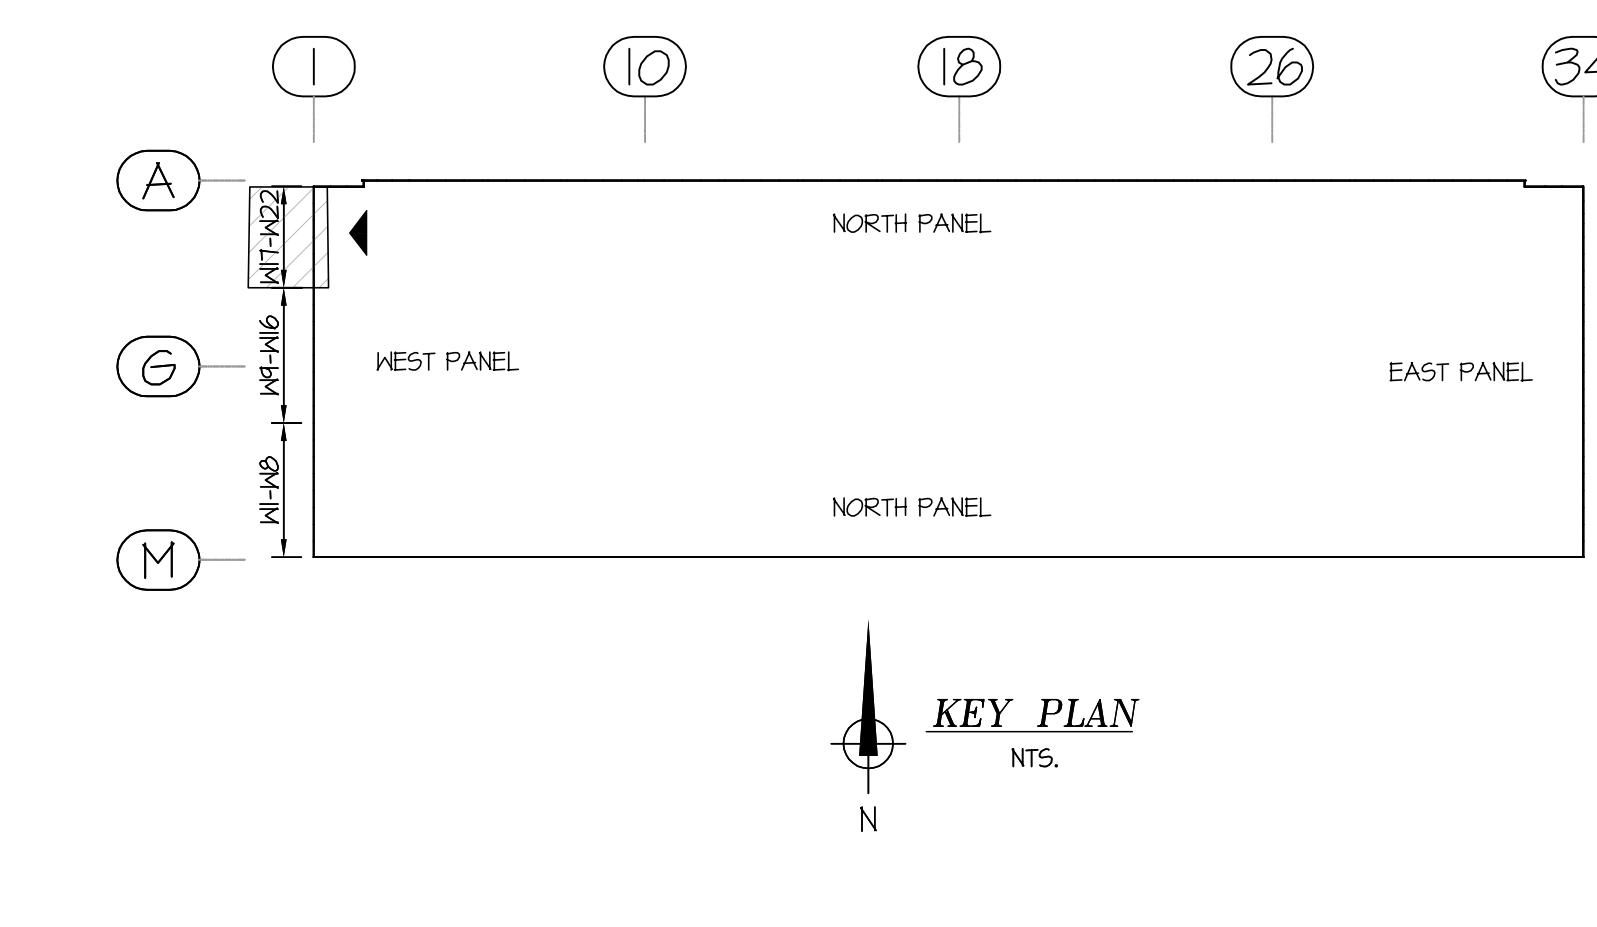

REINFORCING STEEL PLACING DRAWING ONLY. USE IN CONJUNCTION WITH CONTRACT DRAWINGS & SPECIFICATIONS. ELEVATIONS & DIMENSIONS SHOWN ON THIS DRAWING ARE FOR DETAILING PURPOSES ONLY AND SHOULD NOT BE USED FOR CONSTRUCTION UNLESS VERIFIED BY ENGINEER OR CONTRACTOR.

7	
6	
5	
4	
3	
2	06.11.2019 RESUBMITTED FOR APPROVAL
1	05.28.2019 APPROVAL DATE SENT FOR

RE-STEEL SUPPLY CO., INC. REINFORCING STEEL - WIRE MESH 2000 Eddystone Industrial Park • Eddystone, PA 19022-1588 Phone: 800-876-8216 • Fax: 610-876-8428
Structure VALLEY VIEW BUSINESS PARK TILT PANELS
Location JESSUP, PA
Architect KSS ARCHITECTS
Engineer RICHARD ADAMS
Customer T&T CONSTRUCTION
Made by: PRO Date: 05.28.2019
DRAWING COVERS WEST WALL PANELS W-17 TO W-22
CONTRACT NO. U2524
REV. NO. DATE 06.11.2019 REVISED AS PER LATEST CDS RECEIVED ON 03.31.19
DESCRIPTION
DRAWING NO. R-17